



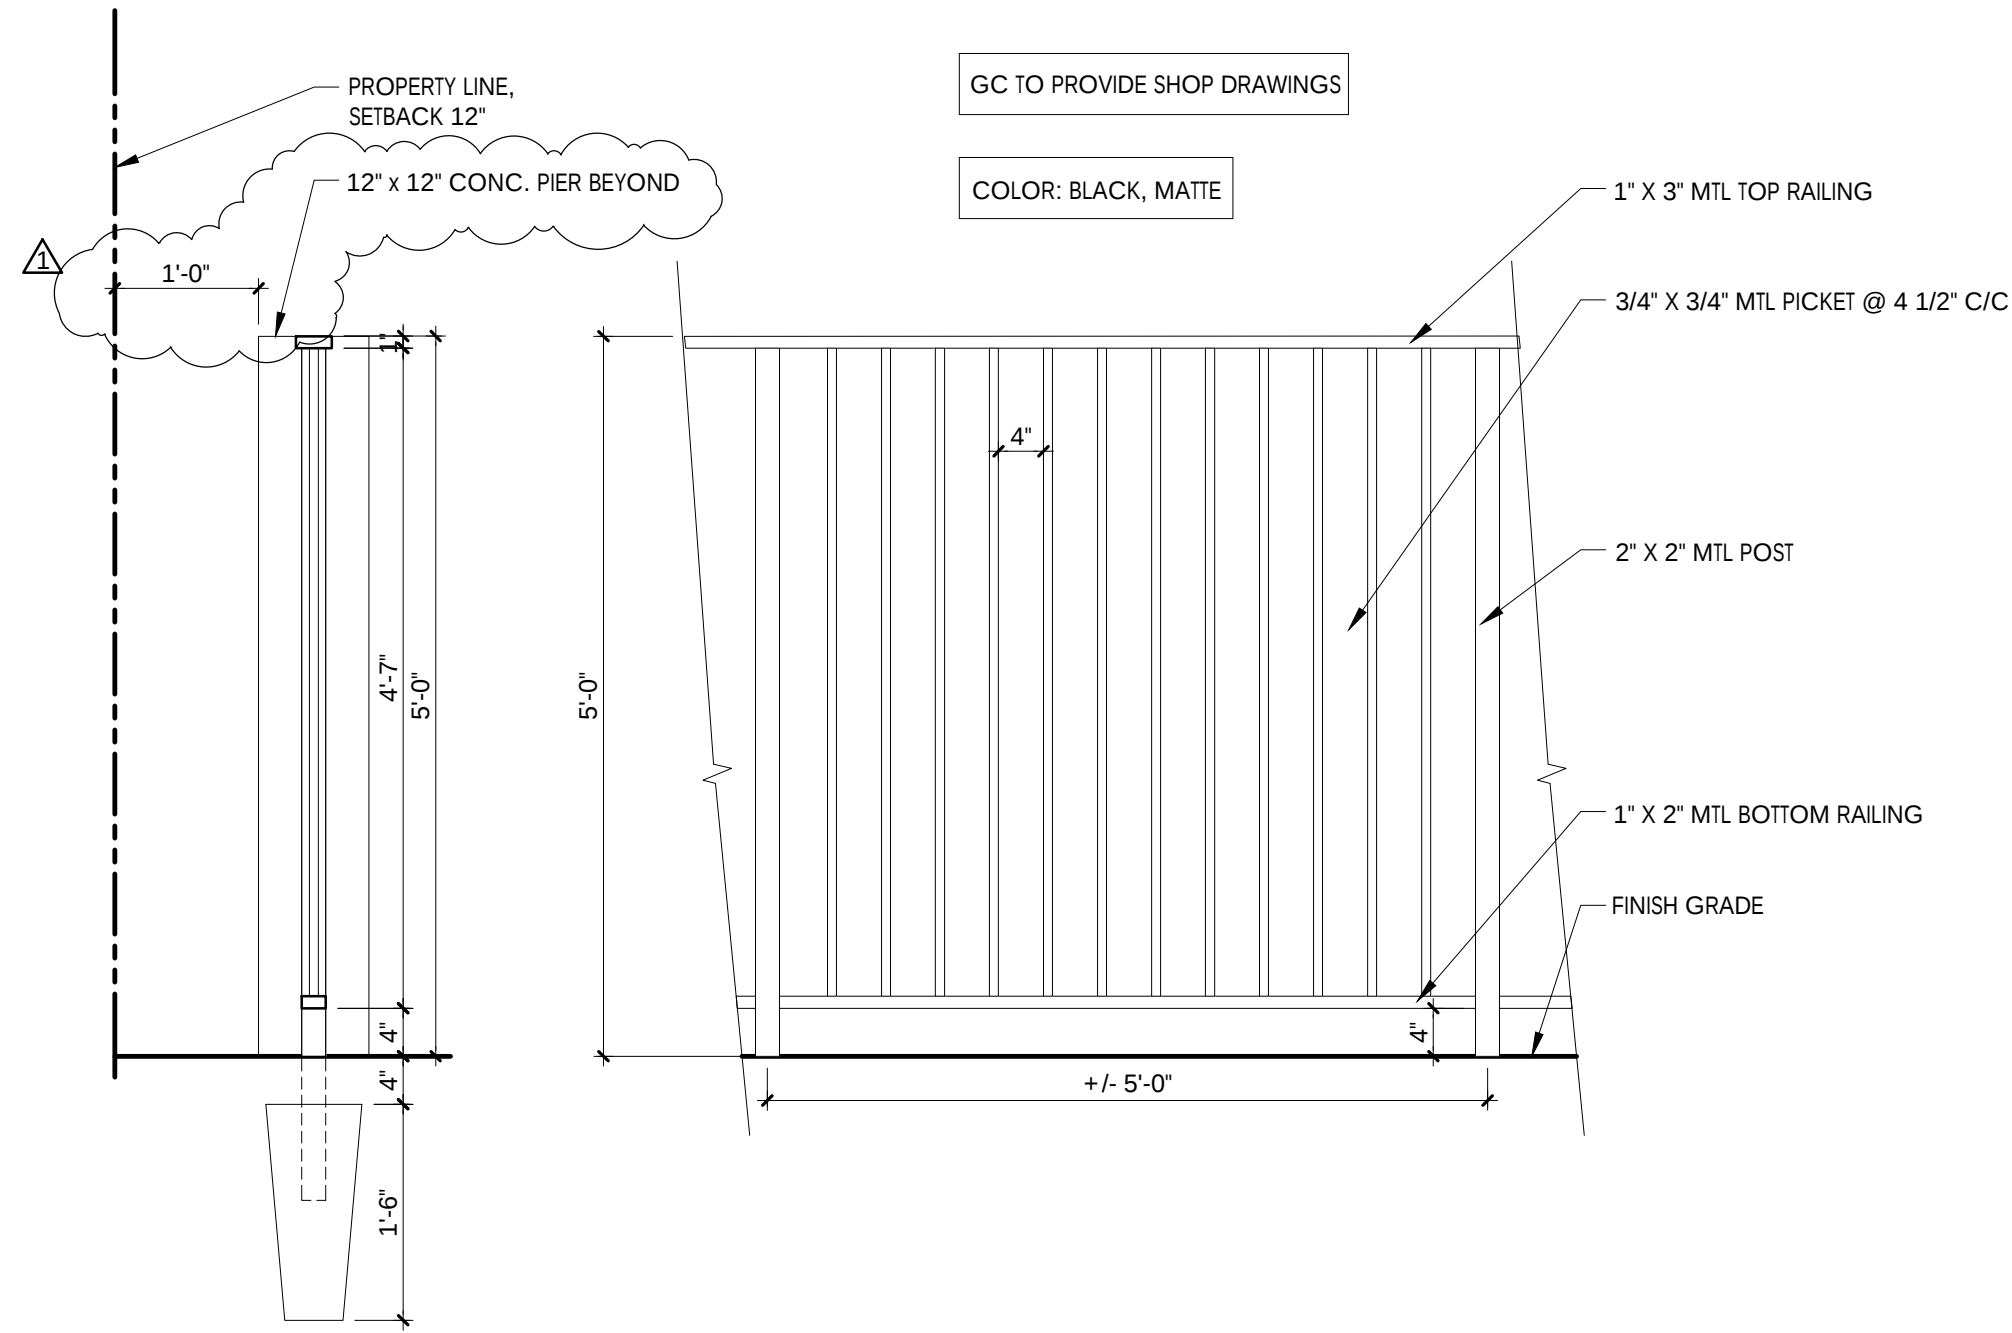

METAL FENCE DETAIL

SCALE: 3/4"=1'-0"


C

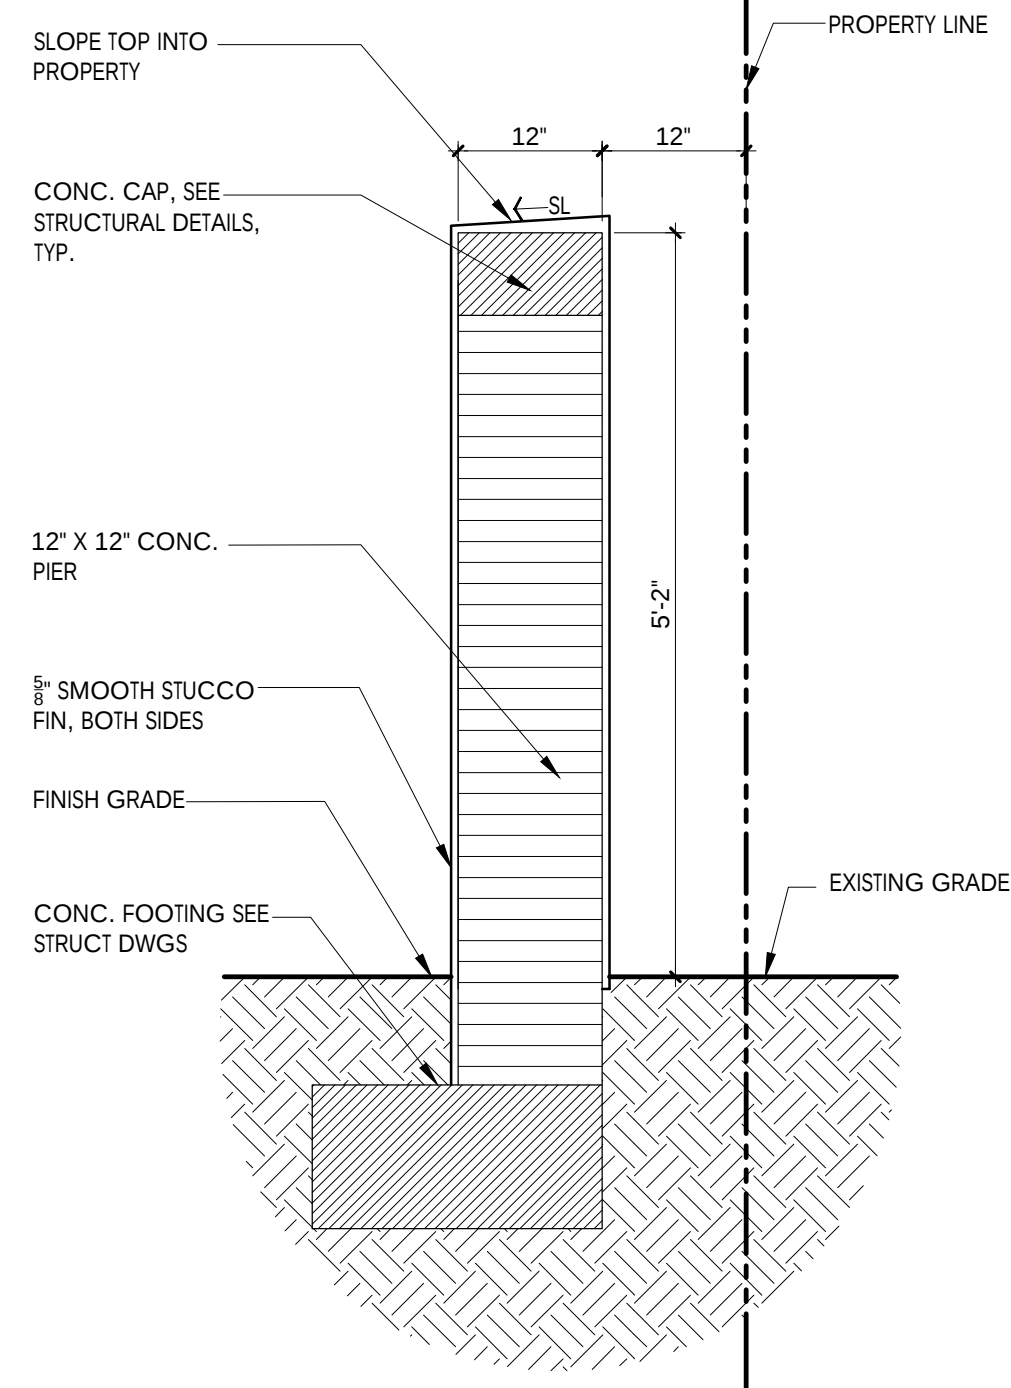

SITE WALL DETAIL

SCALE: 3/4"=1'-0"


B

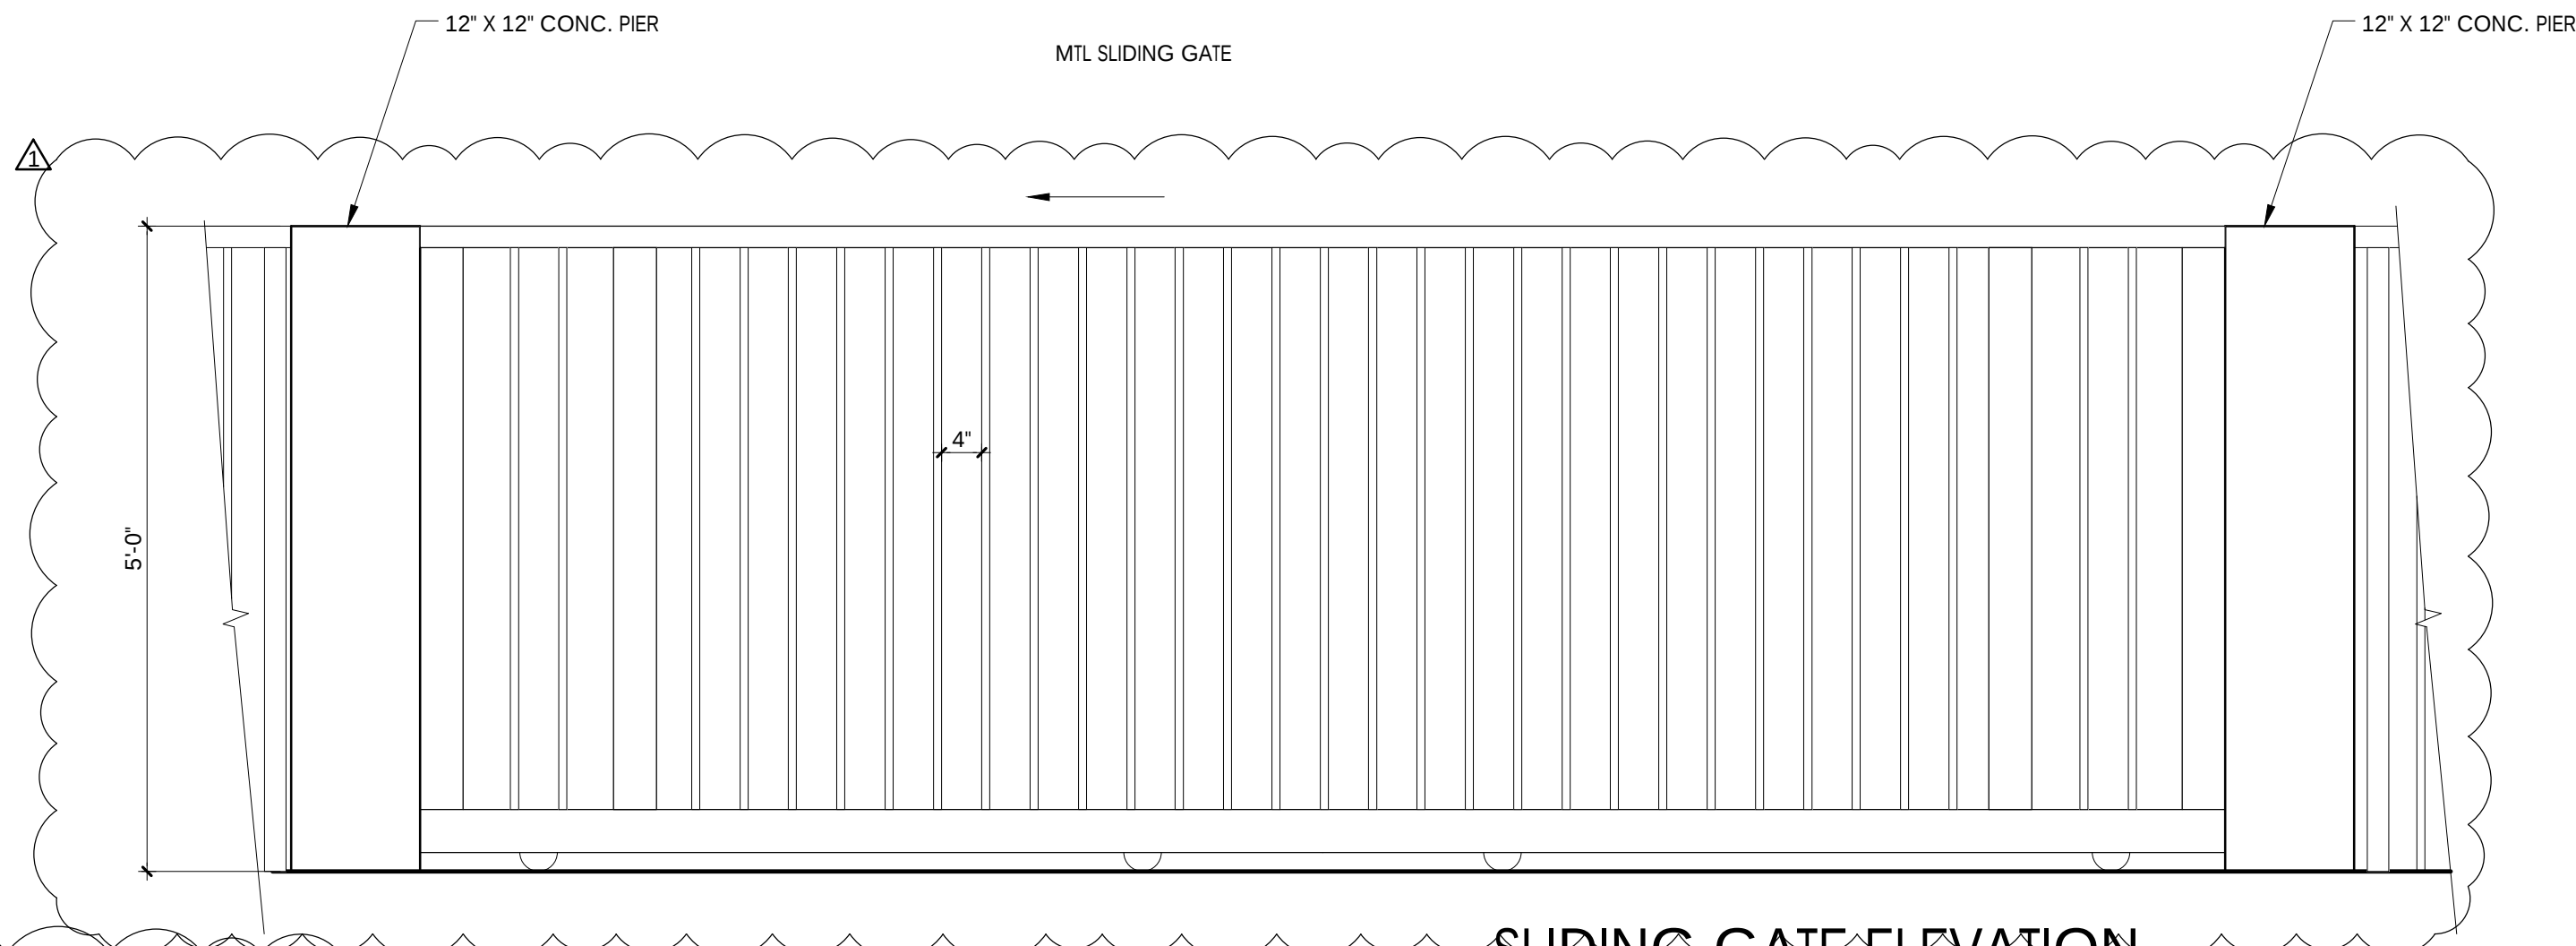

SLIDING GATE ELEVATION

SCALE: 3/4"=1'-0"


4

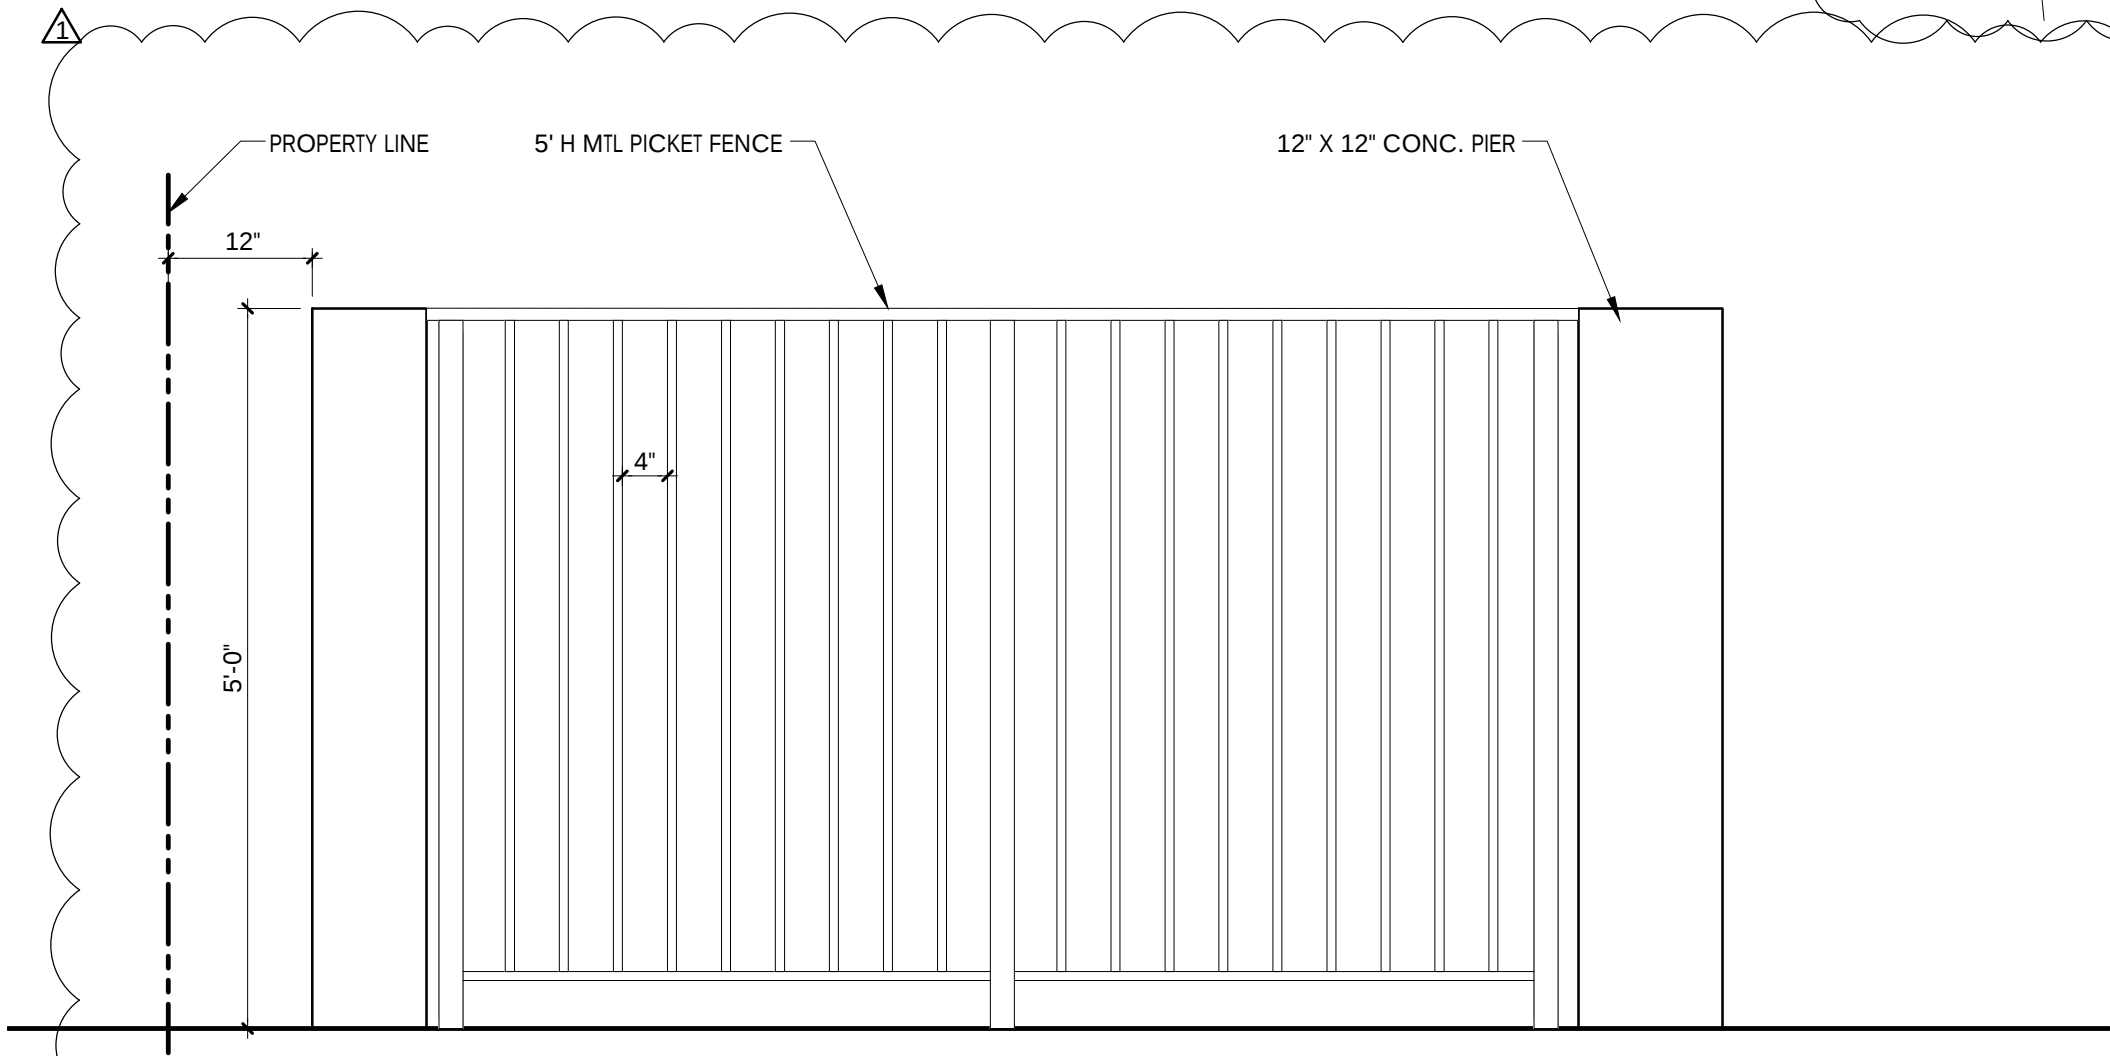

SITE WALL ELEVATION: DRIVEWAY EAST

SCALE: 3/4"=1'-0"


3

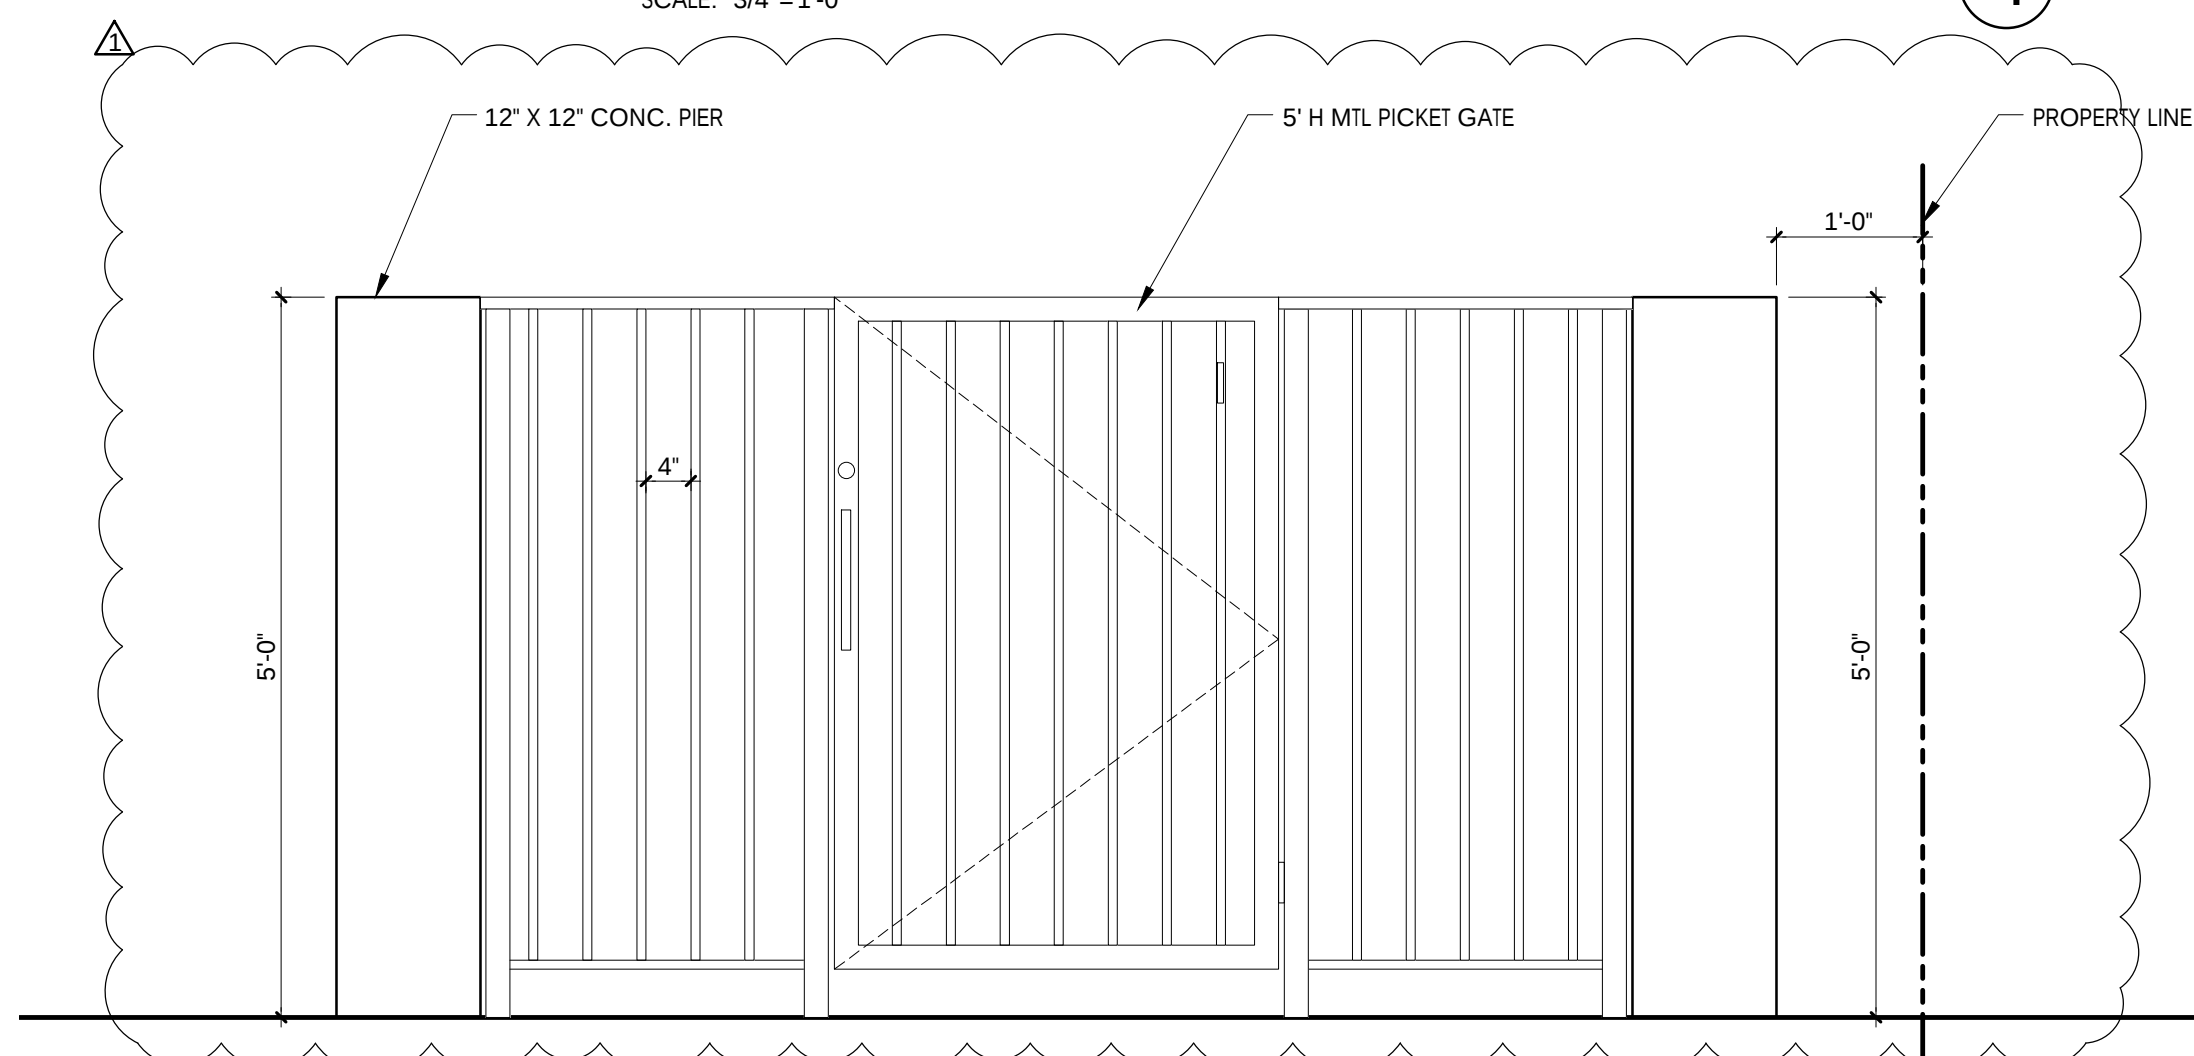

ENTRY GATE ELEVATION

SCALE: 3/4"=1'-0"

2

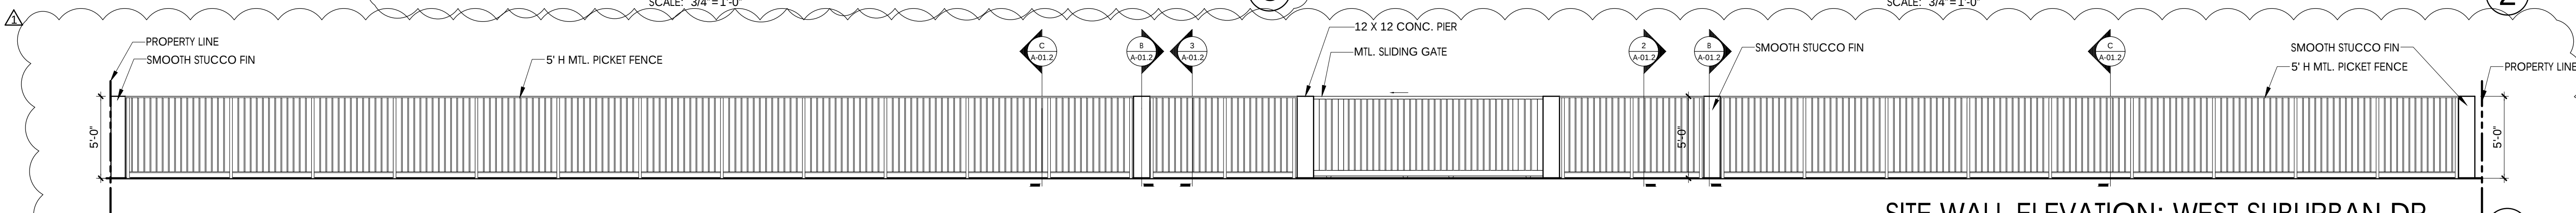

SITE WALL ELEVATION: WEST SUBURBAN DR

SCALE: 3/16"=1'-0"

1

NOTES

LOCUS
ARCHITECTURE
INCORPORATED
500 South Dixie Highway, Suite 307
Coral Gables, Florida 33146
Tel: (305) 740-0120
Email: locus@locusarchitecture.net
License: AR 13937

CONSULTANT(S)

NO.	REVISION/SUBMISSION	DATE
	OWNER REVIEW	04-08-24
	PERMIT SUBMITTAL	06-07-24
	REVIEW COMMENT	08-19-24

PROJECT

New 2-Story Residence:
6100 W Suburban Dr, Pinecrest, FL 33156

DRAWING

Site Walls & Details

SEAL



Nelson de Leon
AR 13937

SHEET NO.

A-01.2

SCALE

DRAWN

REVIEWED

NDL

PROJ. NO.

351