



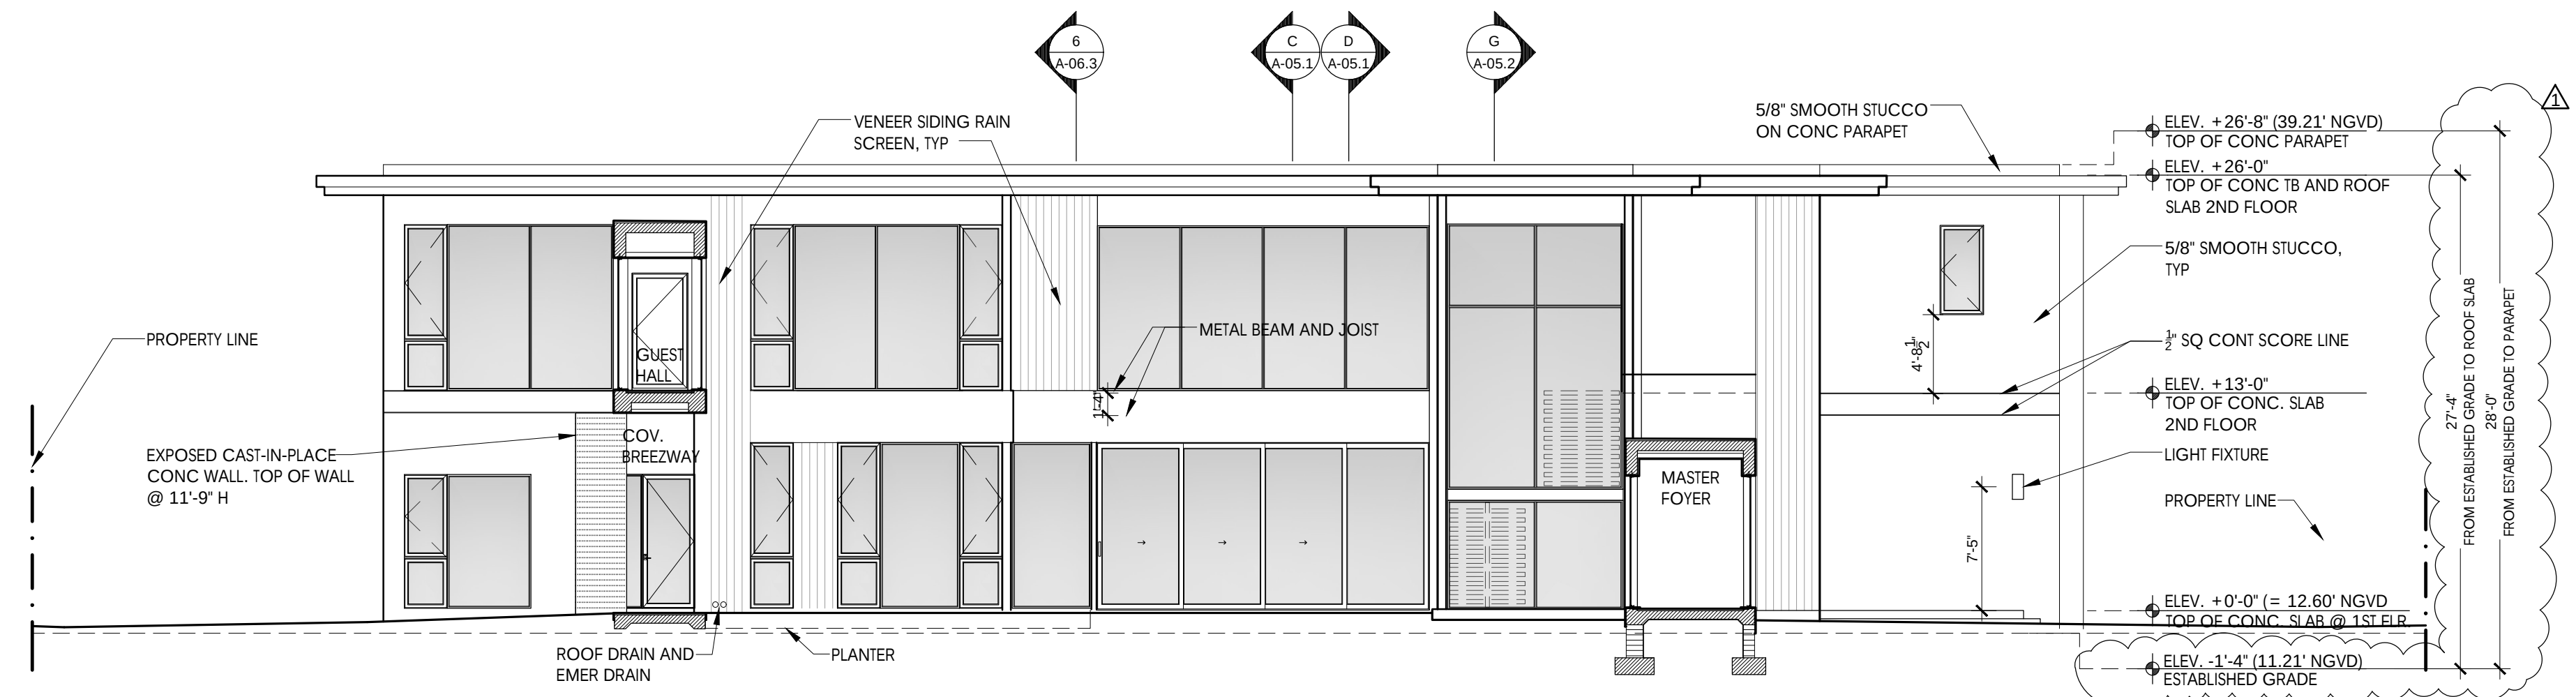


REAR-SOUTH SECTION-ELEVATION: B-B

SCALE: 1/8" = 1'-0"

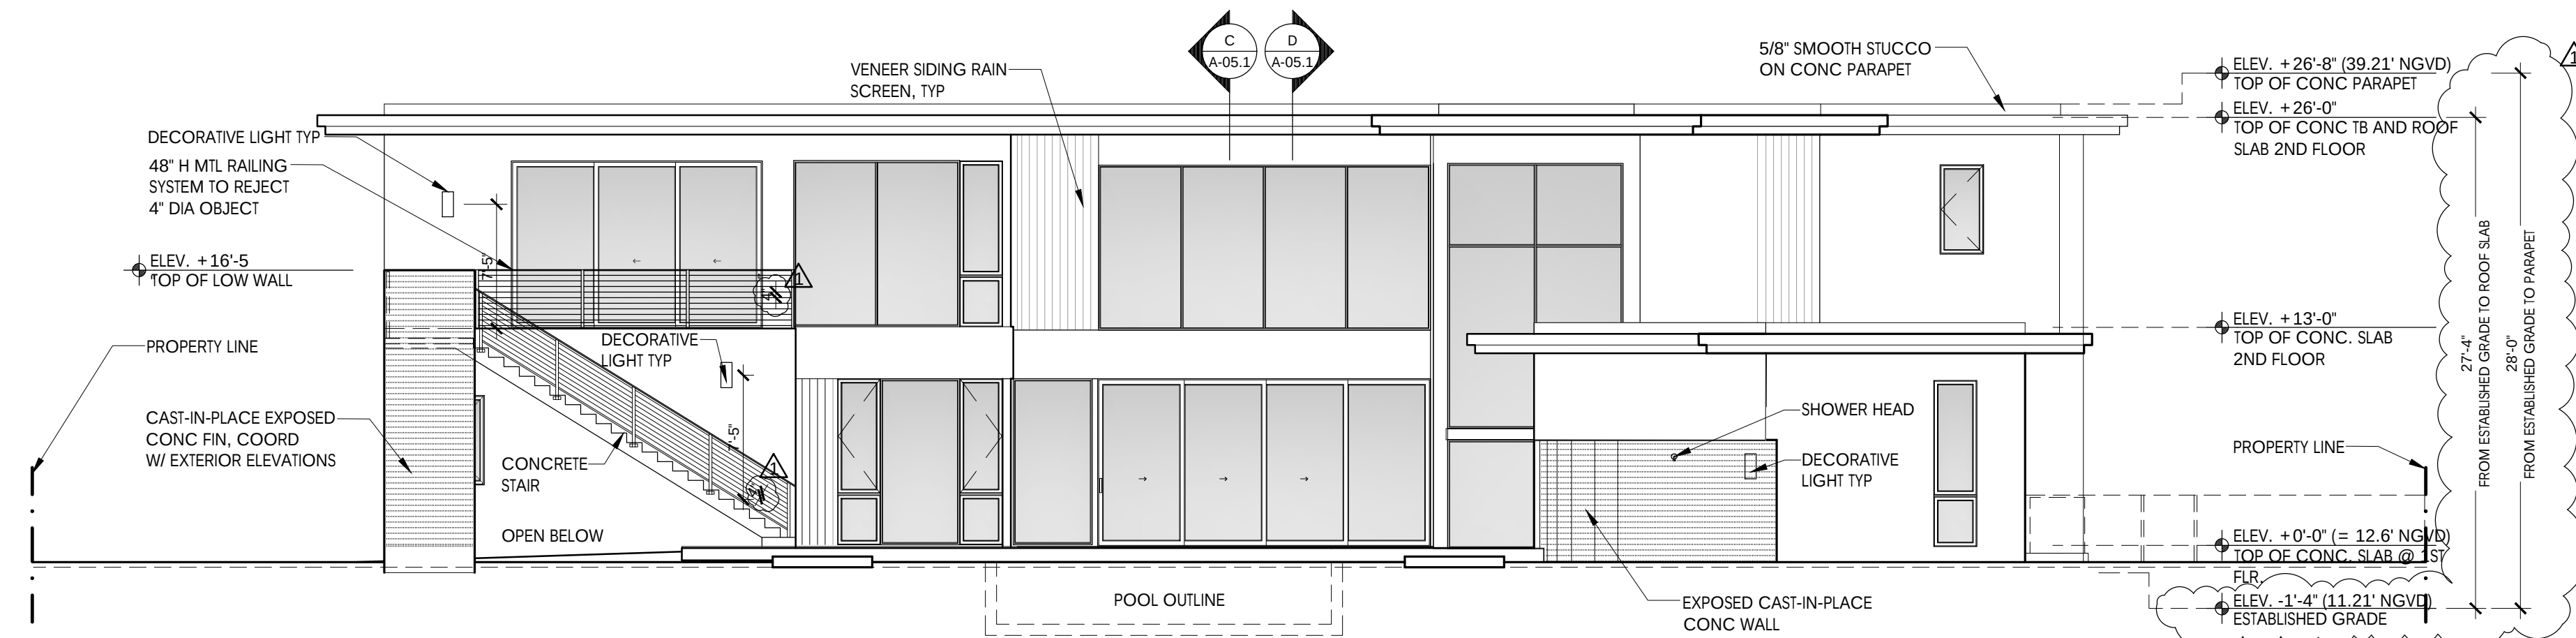


REAR-SOUTH EXTERIOR ELEVATION

SCALE: 1/8" = 1'-0"

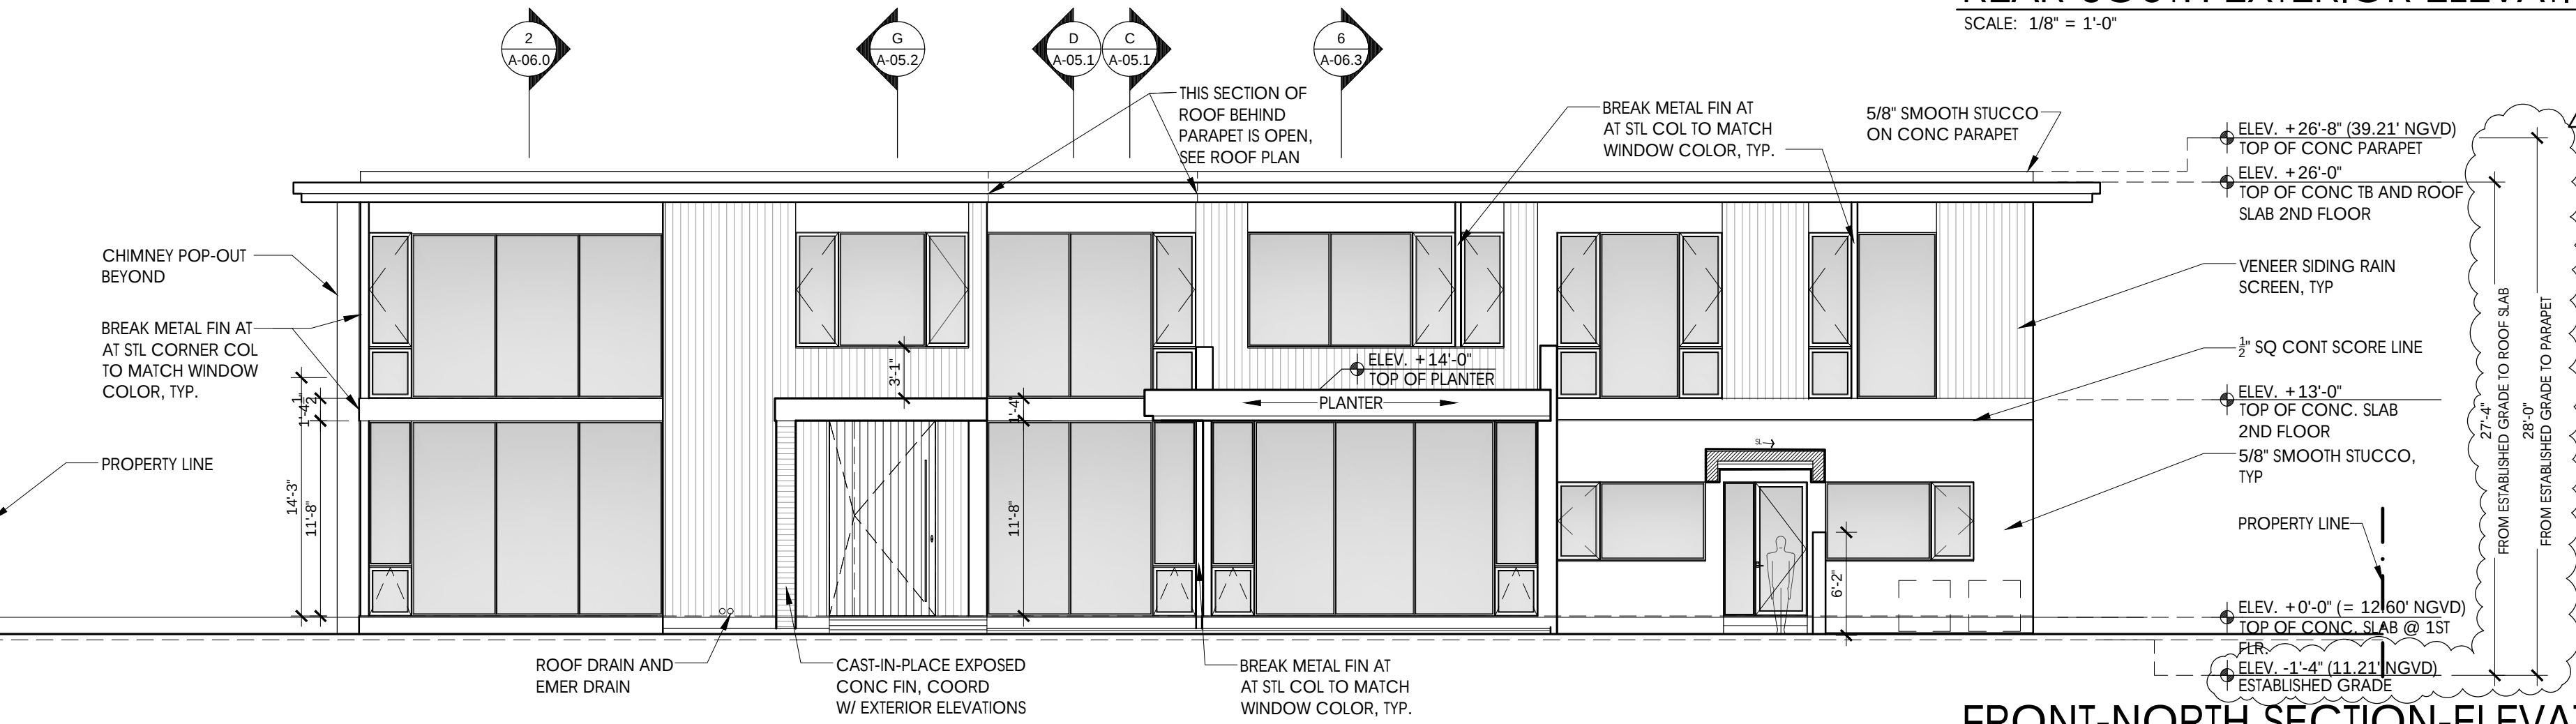

FRONT-NORTH SECTION-ELEVATION A-A

SCALE: 1/8" = 1'-0"

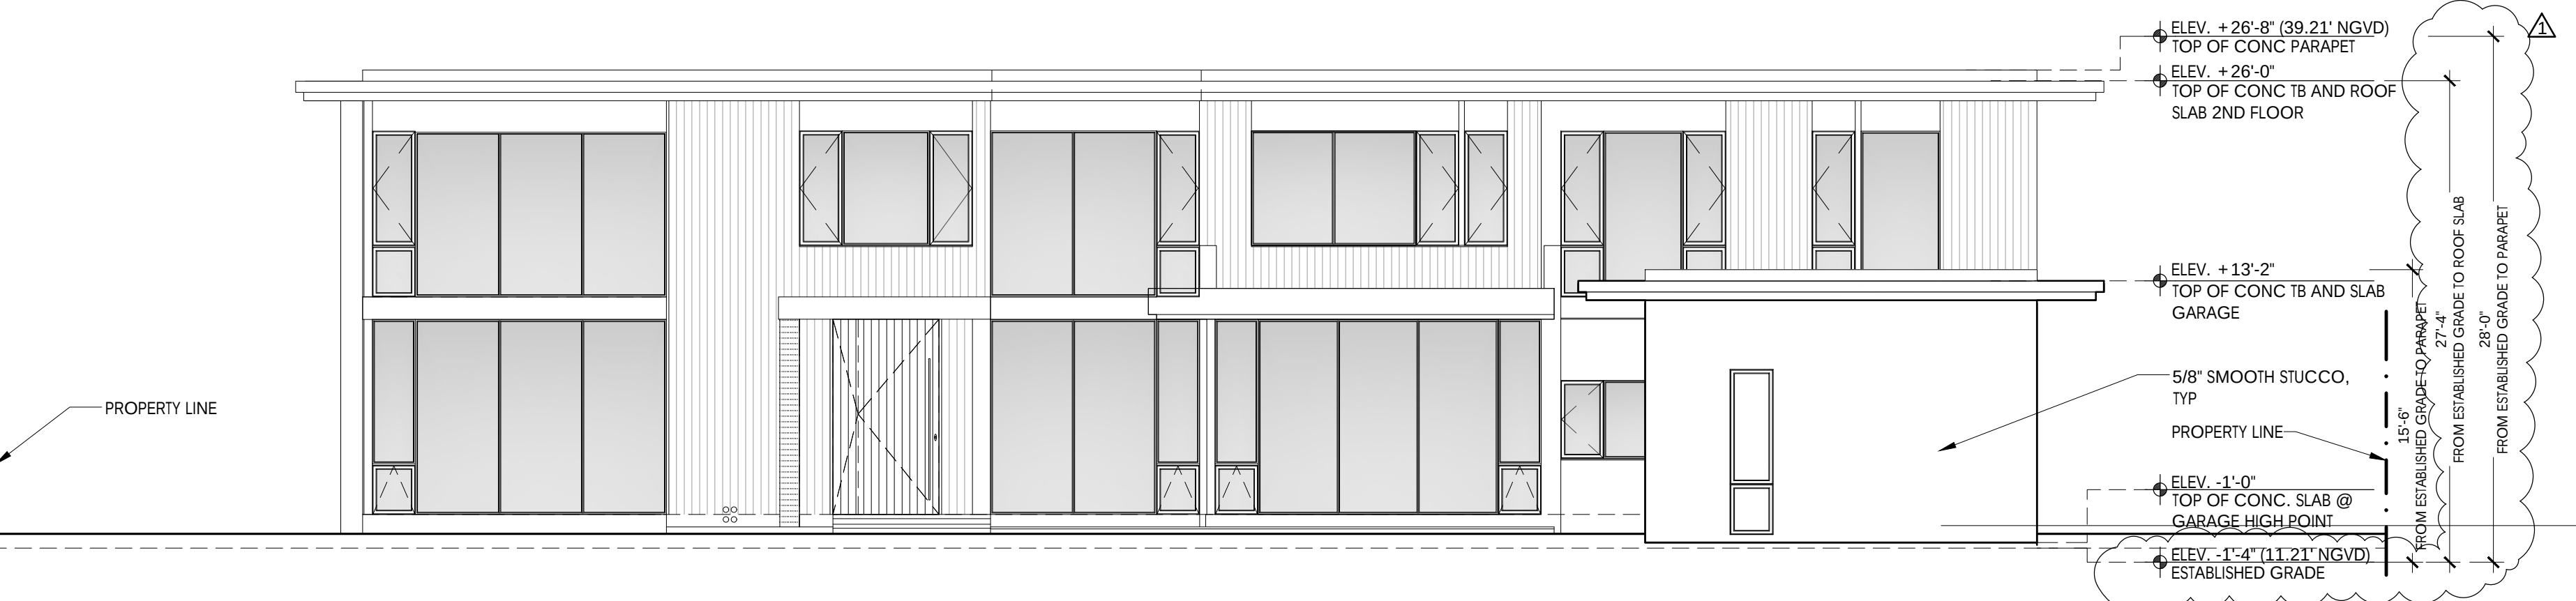

FRONT-NORTH EXTERIOR ELEVATION

SCALE: 1/8" = 1'-0"

NOTES

LOCUS
ARCHITECTURE
INCORPORATED
500 South Dixie Highway, Suite 307
Coral Gables, Florida 33146
Tel: (305) 740-0120
Email: locus@locusarchitecture.net
License: AR 13937

CONSULTANT(S)

NO.	REVISION/SUBMISSION	DATE
	OWNER REVIEW	04-08-24
	PERMIT SUBMITTAL	06-07-24
⚠	REVIEW COMMENT	08-19-24

PROJECT

New 2-Story Residence:
6100 W Suburban Dr, Pinecrest, FL 33156

DRAWING

Overall Exterior Elevations
Front, Rear, AA and BB



Nelson de Leon
AR 13937

SHEET NO.

A-05.0

SCALE

DRAWN

REVIEWED

NDL

PROJ. NO.

351