



BUILDING SECTION-ELEVATION: D-D

SCALE: 1/8" = 1'-0"

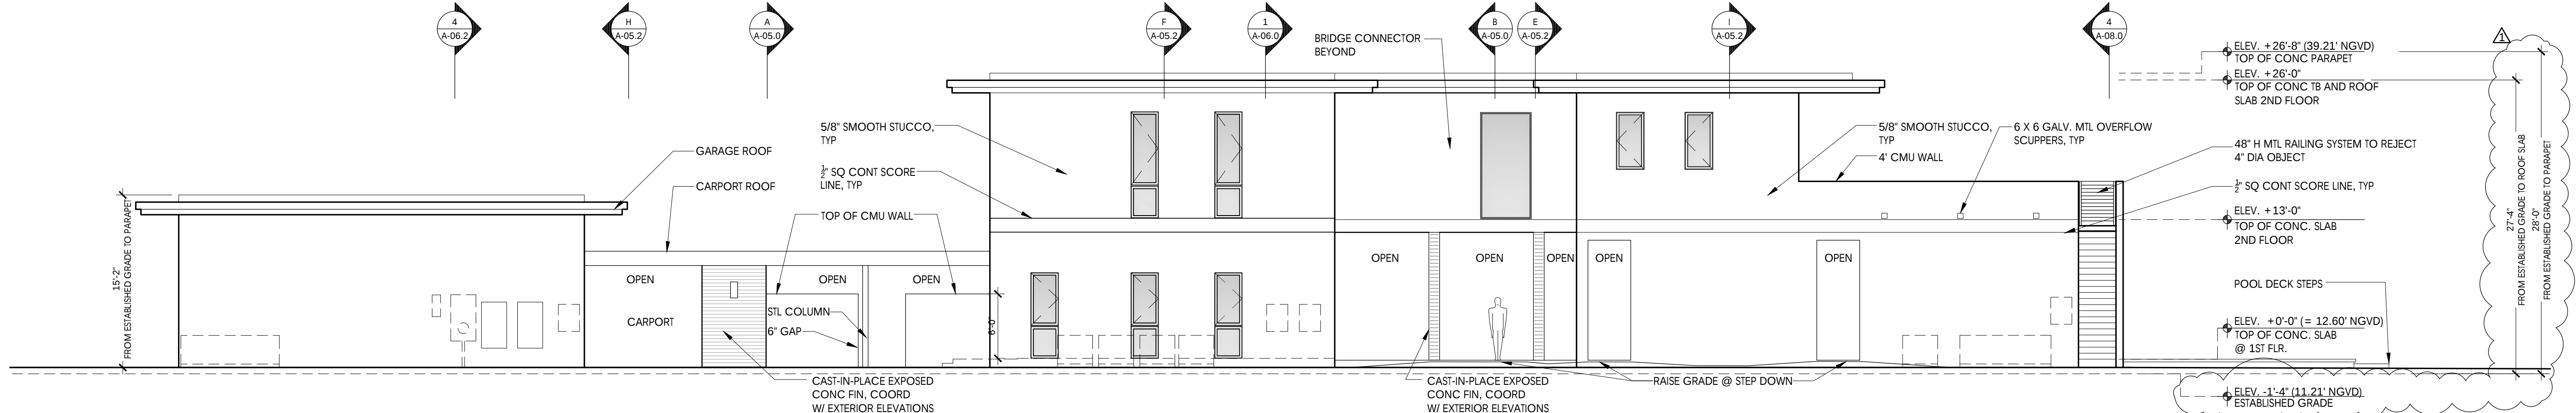


SIDE-WEST EXTERIOR ELEVATION

SCALE: 1/8" = 1'-0"

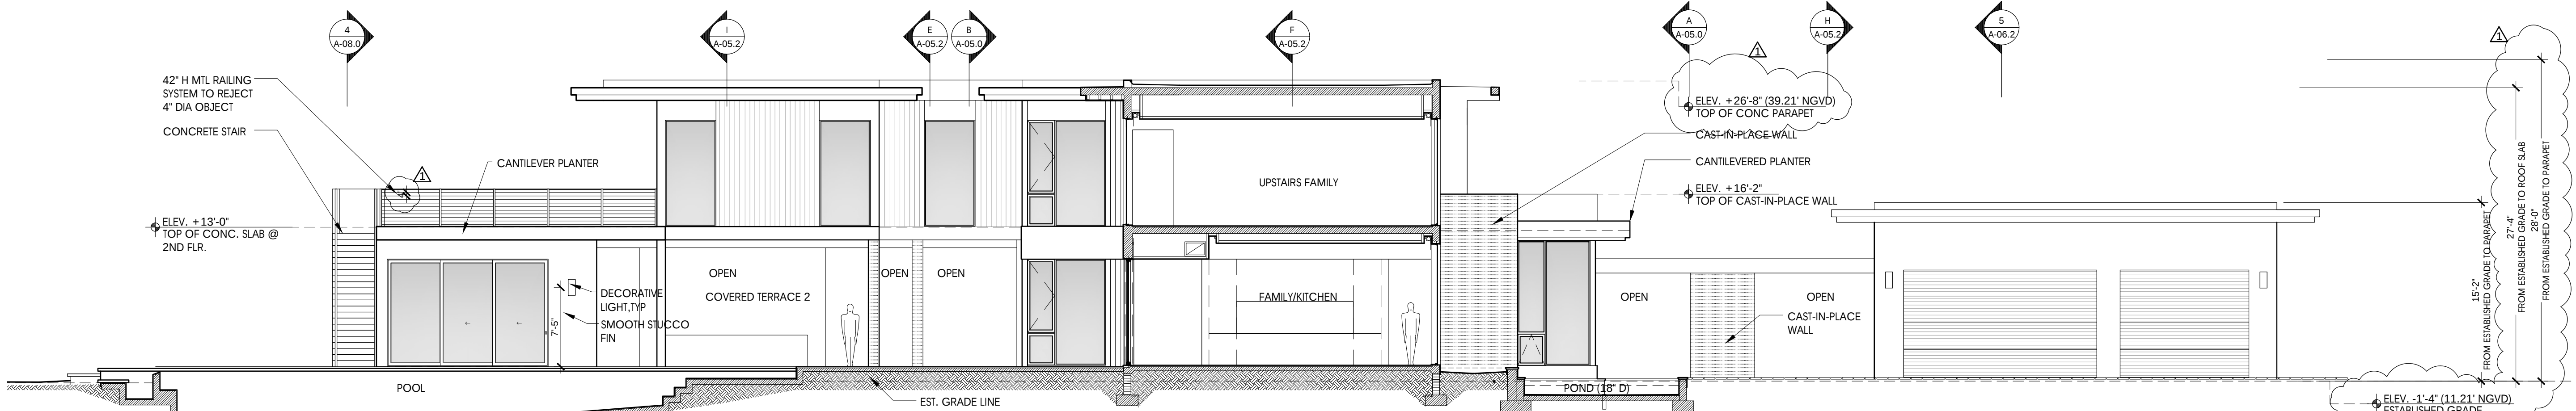

BUILDING SECTION-ELEVATION: C-C

SCALE: 1/8" = 1'-0"

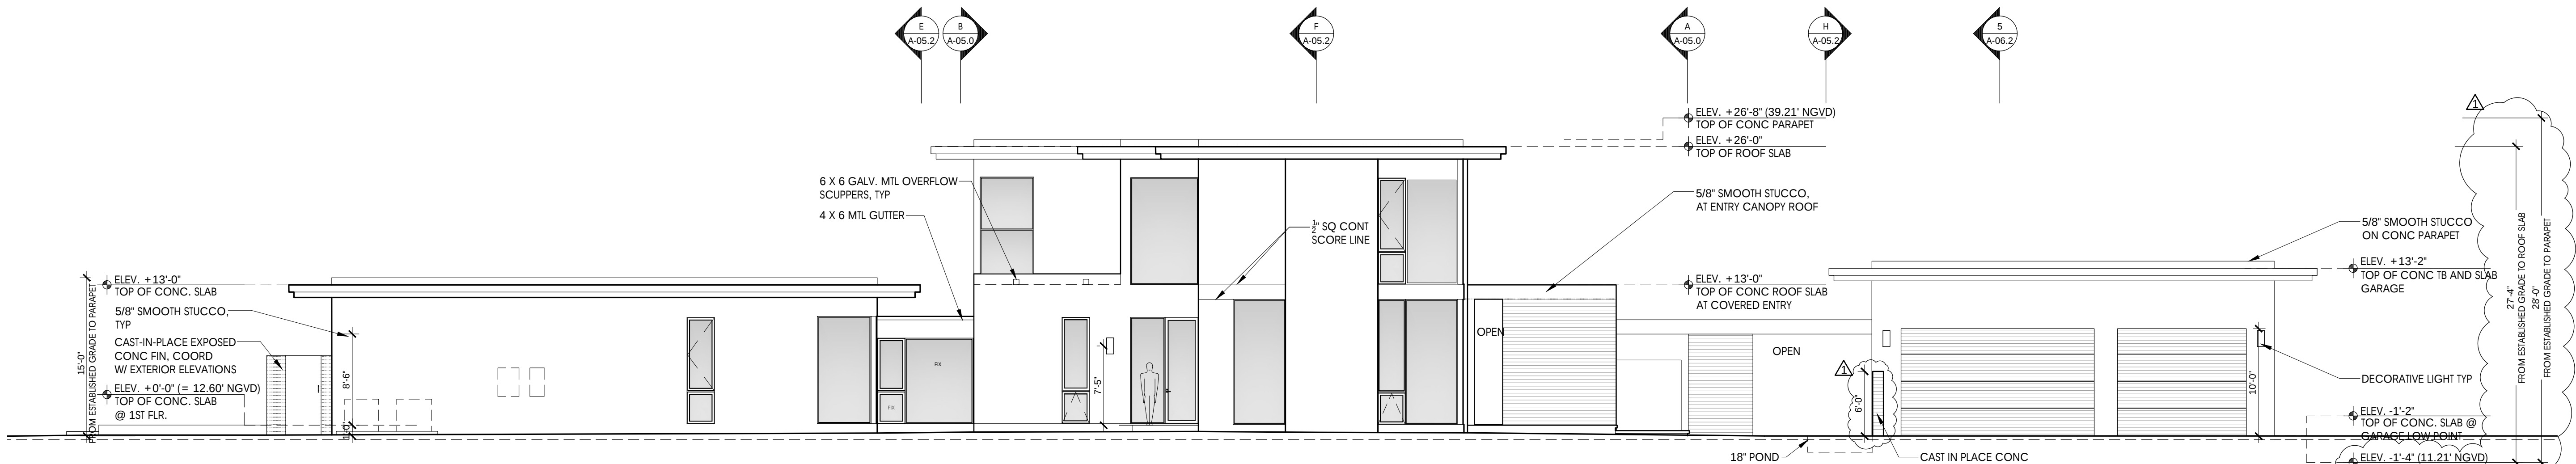

SIDE-EAST EXTERIOR ELEVATION

SCALE: 1/8" = 1'-0"

NOTES

LOCUS
ARCHITECTURE
INCORPORATED
500 South Dixie Highway, Suite 307
Coral Gables, Florida 33146
Tel: (305) 740-0120
Email: locus@locusarchitecture.net
License: AR 13937

CONSULTANT(S)

NO.	REVISION/SUBMISSION	DATE
	OWNER REVIEW	04-08-24
	PERMIT SUBMITTAL	06-07-24
Δ	REVIEW COMMENT	08-19-24

PROJECT

New 2-Story Residence:
6100 W Suburban Dr, Pinecrest, FL 33156

DRAWING

Overall Exterior Elevations
East and West Sides, CC and DD



Nelson de Leon
AR 13937

SHEET NO.

A-05.1

SCALE

DRAWN

REVIEWED

NDL

PROJ. NO.

351