


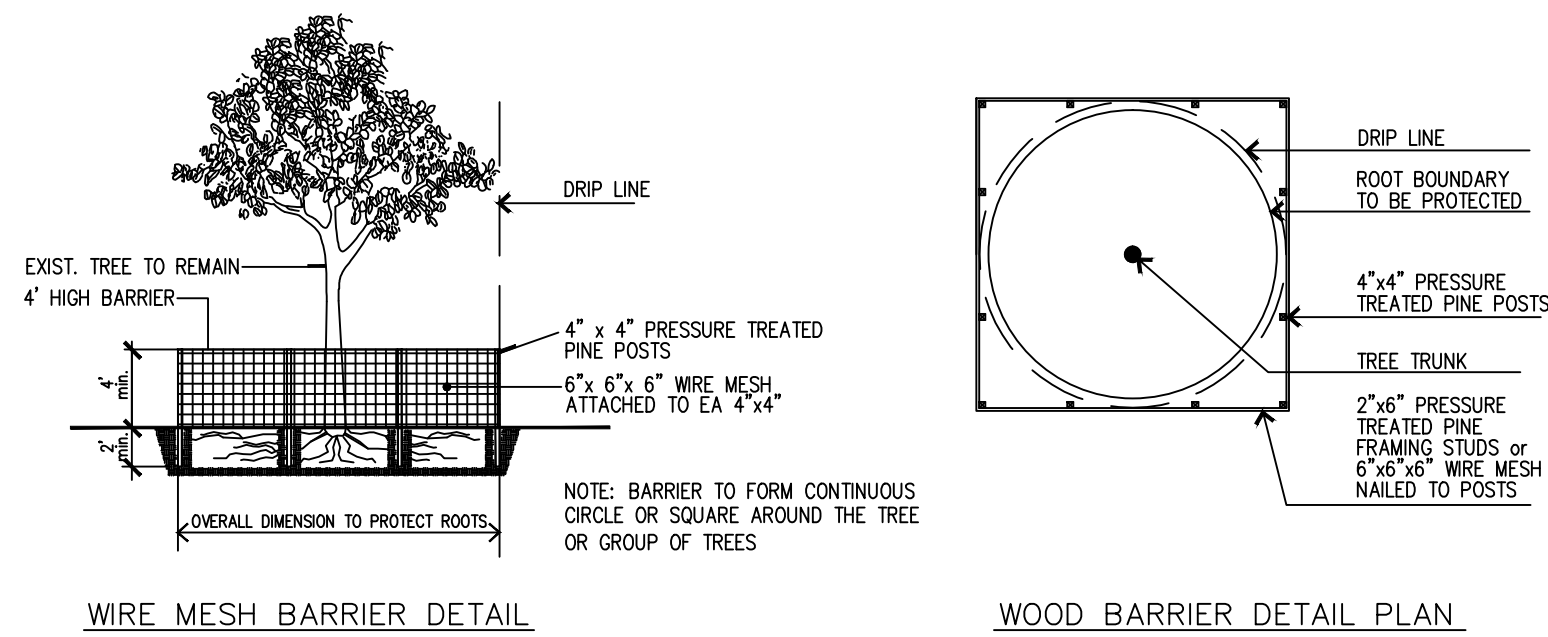

TREE PROTECTION BARRIER DETAIL
N.T.S.

Notes:

- 1) Tree Protection Barriers dimensions are measured from the center line of the trunk (as per Arborist's Report)
- 2) Tree Protection Barriers are adjusted where necessary to account for buildings, adjacent sidewalks, & street/curb.
- 3) No disturbance to soil or disposal of any building material/waste is permitted within the tree protection zone.
- 4) Barriers to remain in place throughout the duration of construction or demolition activities.
- 5) Barriers to be attached to existing CLF's, WD fences or concrete walls where applicable.

Tree Survey List

Num	Botanical / Common Name	Description DBH (in) HT (ft)	TPZ/CRZ DBH 1" x 2' DBH 12" x 2'	SPR (ft)	Condition	Notes	Disposition	Explanation/ Reason	Canopy SF To Be Removed	DBH > 18" (x 2) To Be Removed
#1A DR	Delonix regia / Royal Poinciana	2 40	60 12'	60	Good		Remain			
#3 QV	Quercus virginiana / Live Oak	1.5 35	25 9'	25	Good		Remain			
#4 QV	Quercus virginiana / Live Oak	1.8 50	30 10'	30	Good		Remain			
#5 QV	Quercus virginiana / Live Oak	1.5 40	30 9'	30	Good		Remain			
#8 QV	Quercus virginiana / Live Oak	2 60	40 12'	40	Good		Remain			
#10 BS	Bursera simaruba / Gumbo Limbo	2 50	40 12'	40	Good		Remain			
#13A BS	Bursera simaruba / Gumbo Limbo	2 40	40 12'	40	Good		Remain			
#13B SC	Spathodea campanulata / African Tulip	1 50	30 6'	30	Good		Remain			
#14 MI	Mangifera indica / Mango	1 30	30 6'	30	Poor		Remain			
#15 MI	Mangifera indica / Mango	3 45	30 12'	30	Poor		Remain			
#16 FA	Ficus aurea / Strangler Fig	5 60	40 30'	40	Good		Remain			
#17 QV	Quercus virginiana / Live Oak	1.5 40	40 9'	40	Good		Relocate			
#20 SC	Spathodea campanulata / African Tulip	2 60	40 12'	40	Good		Remove	See note #3		
#21 SC	Spathodea campanulata / African Tulip	1.5 60	40 9'	40	Good		Remove	See note #3		
#22 SC	Spathodea campanulata / African Tulip	1.5 60	40 9'	40	Good		Remove	See note #3		
#25 SC	Spathodea campanulata / African Tulip	0.7 40	10 4'	10	Good		Remain			
#26 MZ	Manilkara zapota / Sapodilla	1 35	25 6'	25	Good		Remain			


Tree Survey Notes:

- 1) Tree Descriptions are as per Survey prov'd to LA, dated 09.17.2024, by Suarez Surveying & Mapping, Inc.
- 2) Tree species identification by, Landscape Architect, based on site visit in May 2024.
- 3) Trees #20,21,22 SC (African Tulip) to be removed as per PZ 2024-0264.


Indicates existing tree / palm to remain.
CRZ, (Critical Root Zone)

Indicates existing tree / palm to be removed.

Indicates existing tree/palm to be removed.

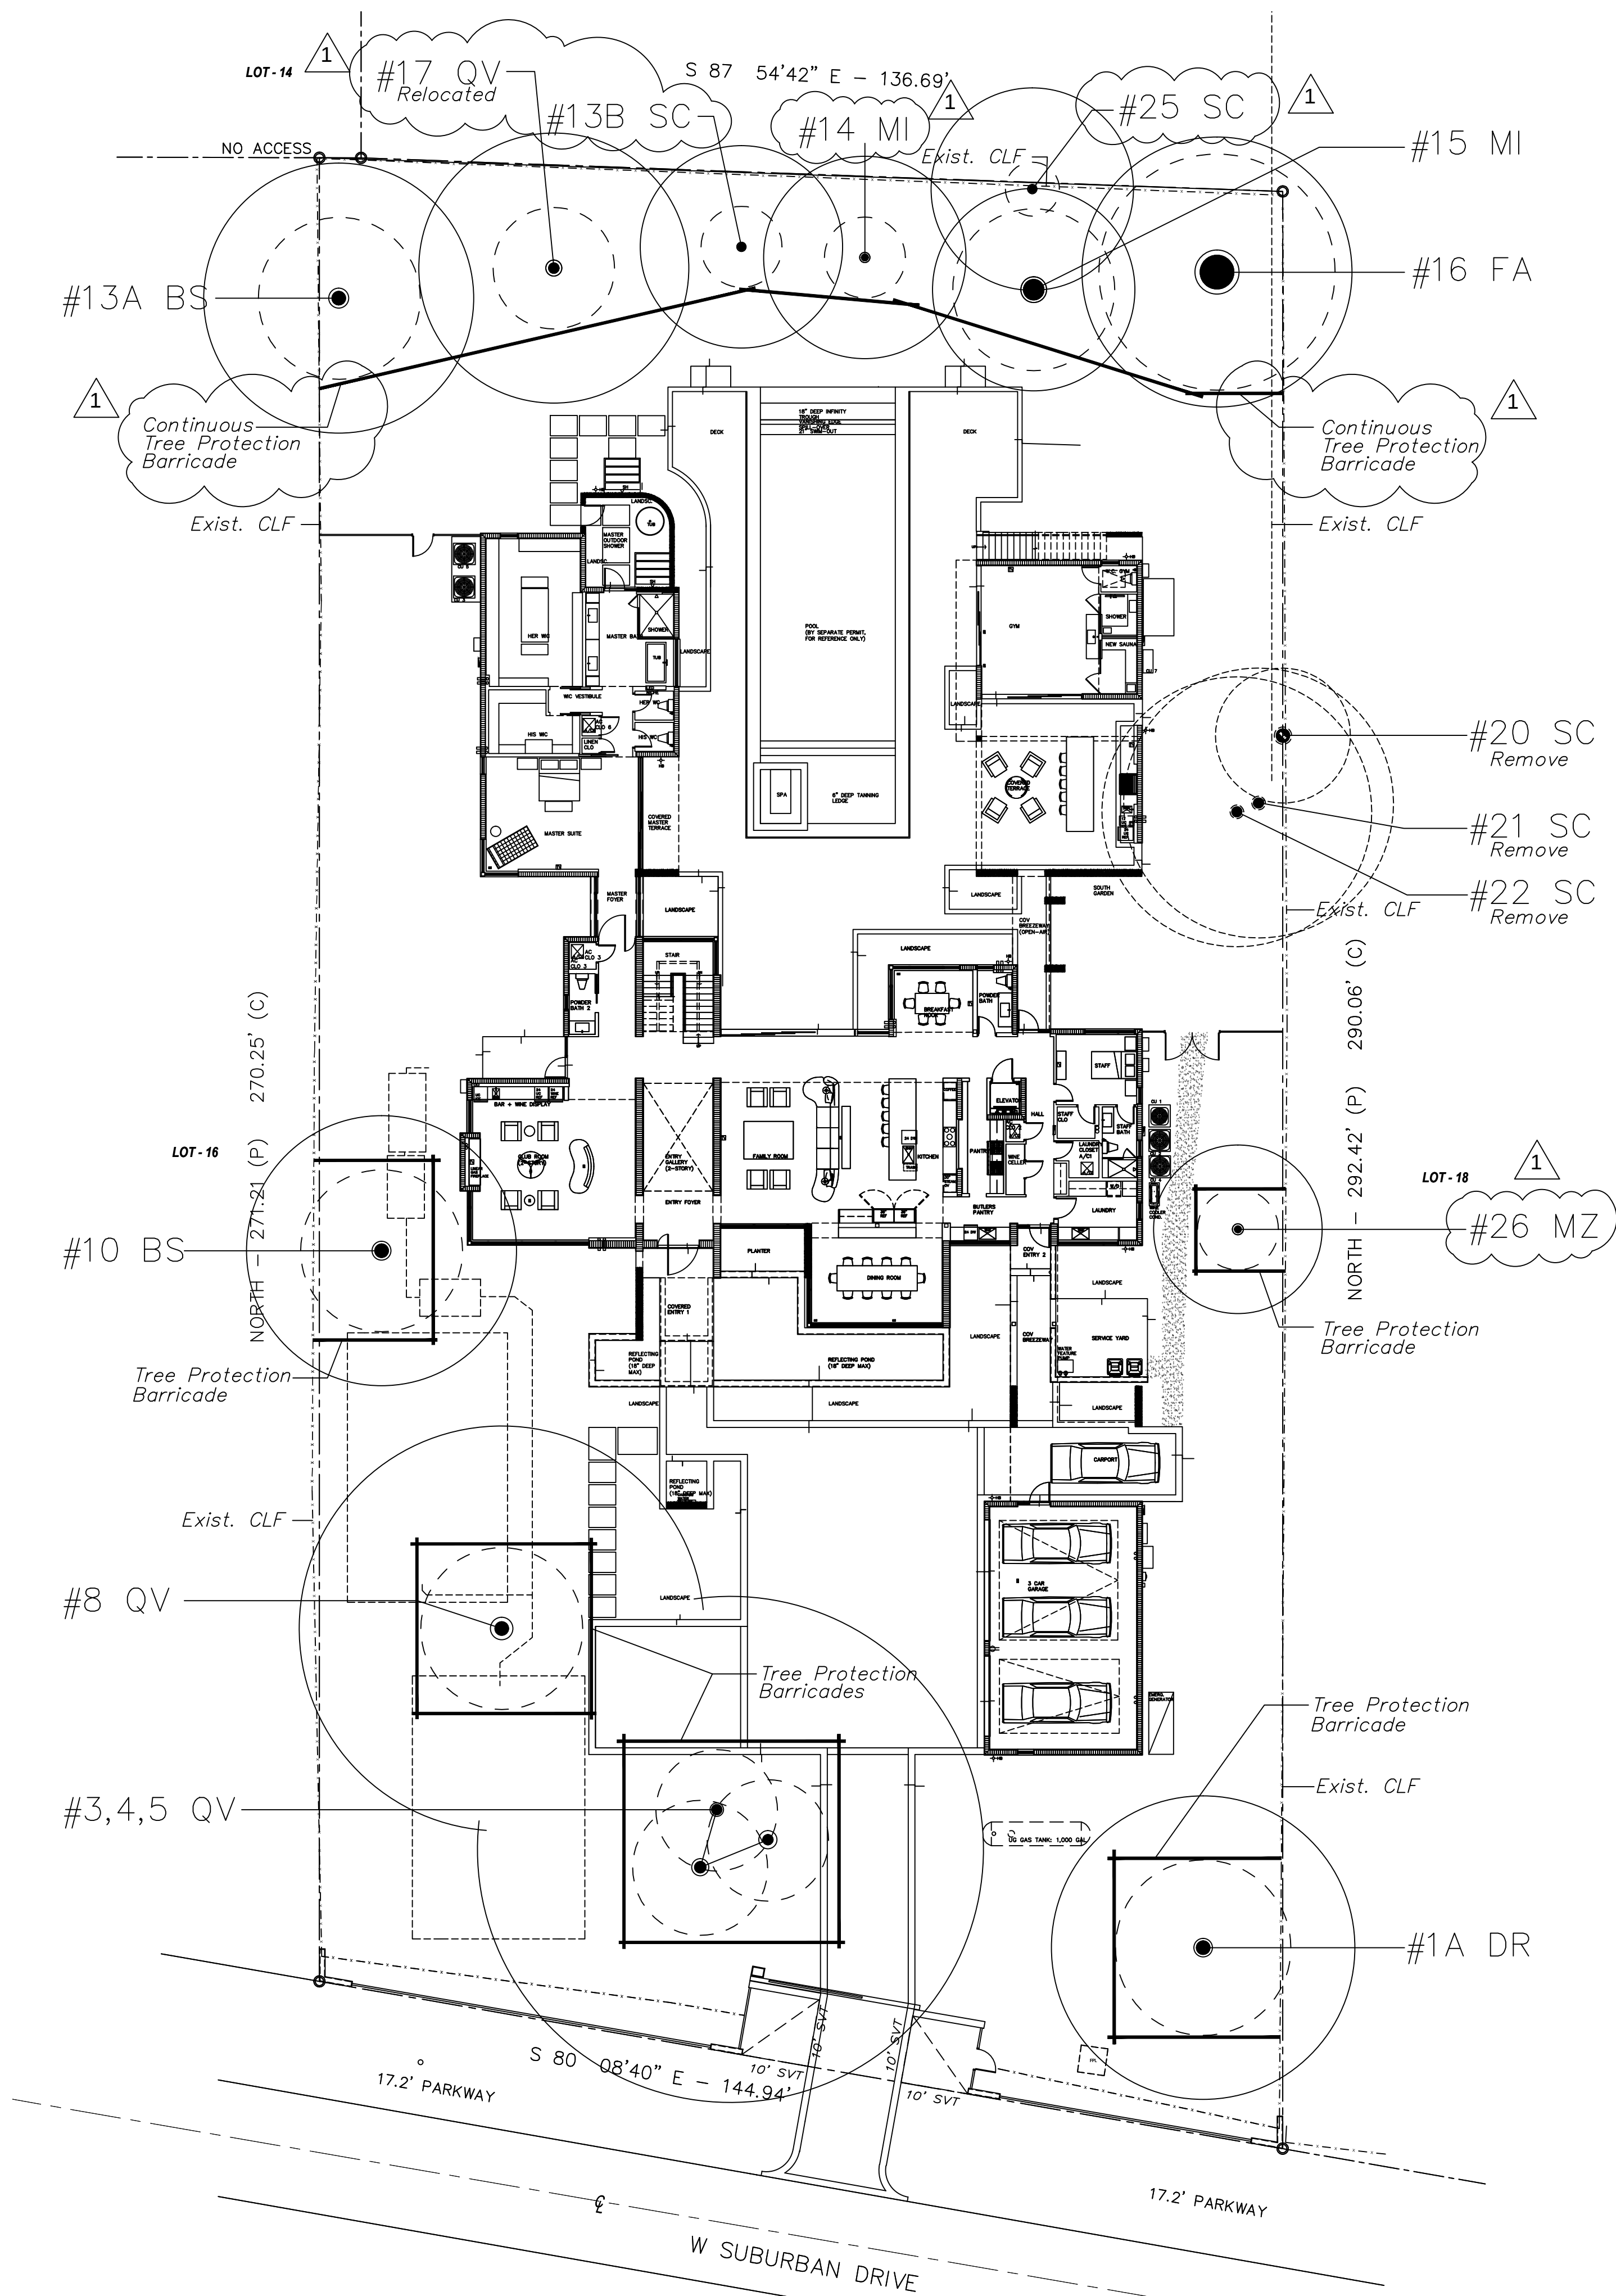

TREE SURVEY / DISPOSITION PLAN
SCALE: 1/16" = 1'-0"

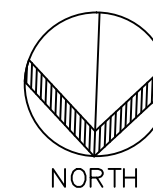

L-01.0 Landscape Plan
L-01.1 Notes, Details, Legend
L-01.2 Tree Survey /Disposition
L-01.3 Tree Protection Plan
IR-01.4 Irrigation Plan

NOTES

LOCUS
ARCHITECTURE
INCORPORATED

500 South Dixie Highway, Suite 307
Coral Gables, Florida 33146
Tel (305) 740-0120
Email locus@locusarchitecture.net
License AR 13937

CONSULTANT(S)

H.L. Martin, Landscape Architect, P.A.
Lic# 26000404 LA #0001722
5965 SW 38th Street, Miami, Florida 33155
305 790-4372, himartin@bellsouth.net
Herbert L. Martin, Landscape Architect

NO.	REVISION/SUBMISSION	DATE
1	OWNER REVIEW	04-08-24
2	PERMIT SUBMITTAL	06-07-24

Rev. Tree Survey & Review Comments

09.24.24

PROJECT

New 2-Story Residence:
6100 W Suburban Dr.
Pinecrest, FL 33156

DRAWING

Tree Protection Plan
Zoning Information

SEAL

SCALE

DRAWN

REVIEWED

NDL

PROJ. NO.

351

Nelson de Leon
AR-13937
SHEET NO.

L-01.3