



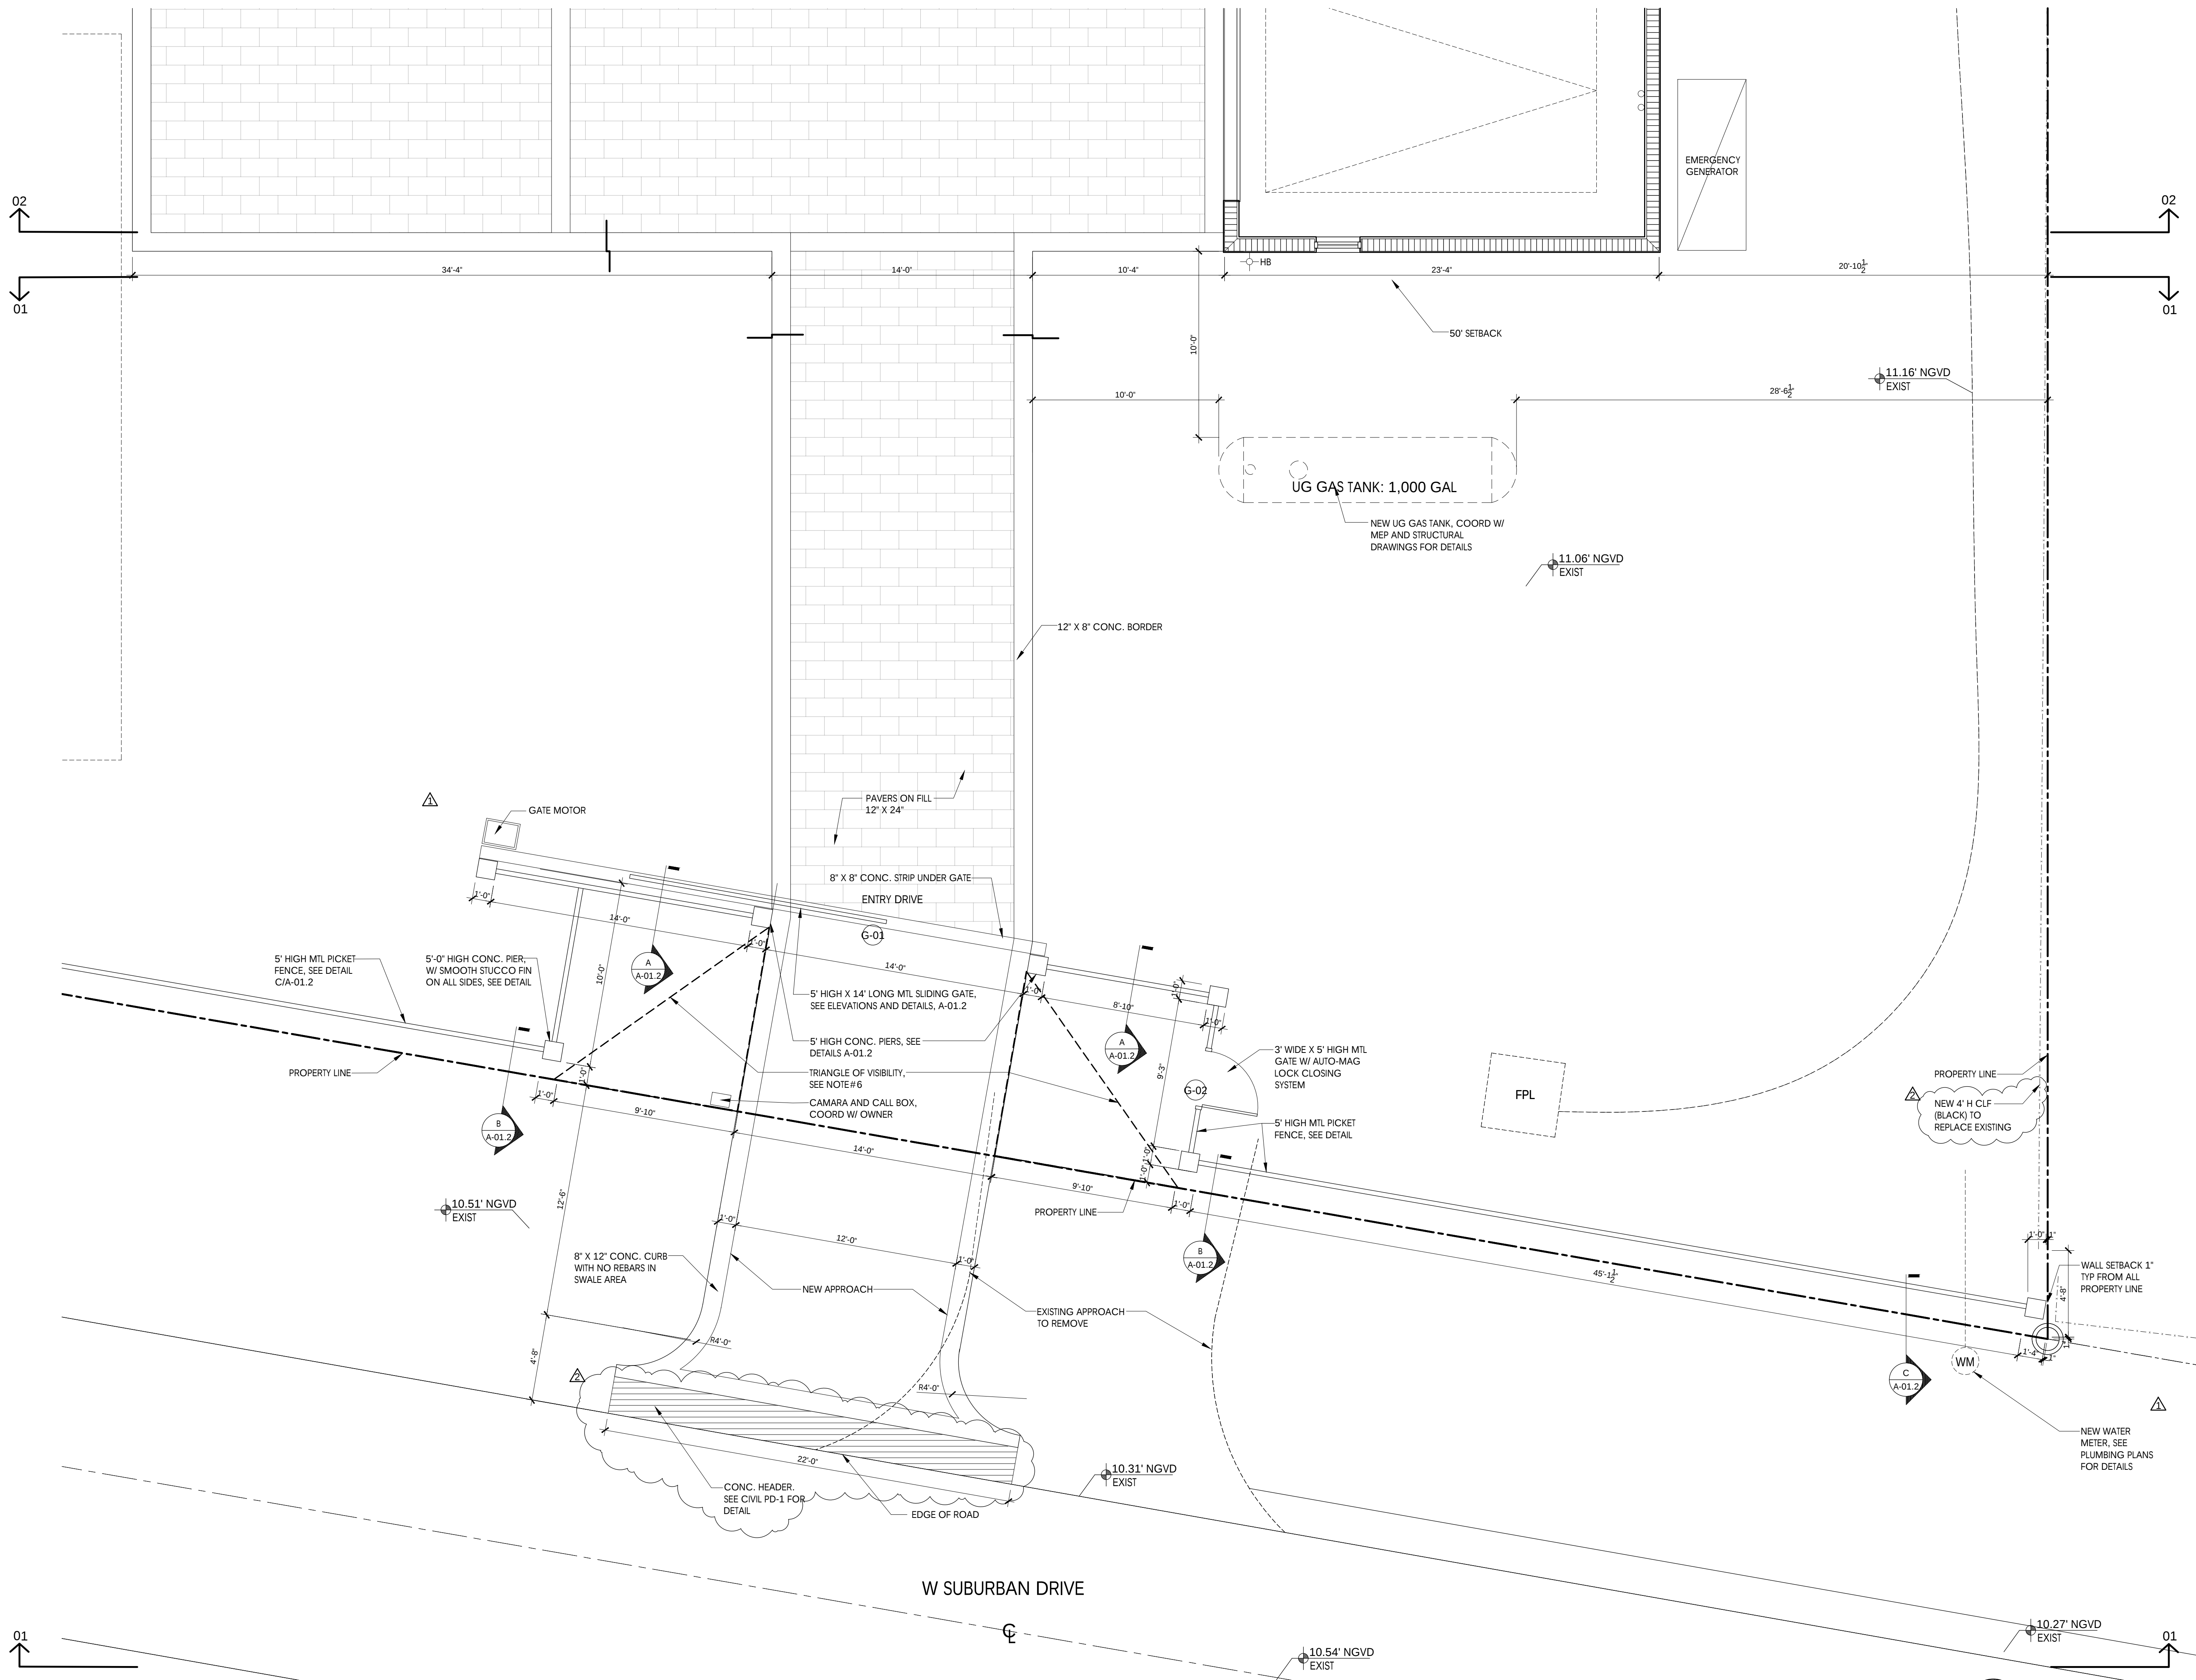

ENLARGED PARTIAL SITE PLAN 01

SCALE: 1/4"=1'-0"

NOTES

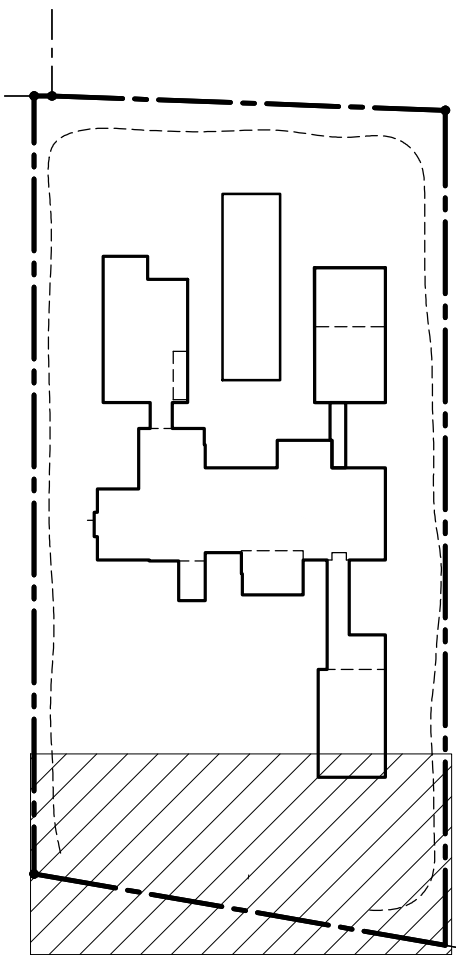

KEY PLAN

SCALE: 1/4" = 1'-0"

LOCUS ARCHITECTURE INCORPORATED
 500 South Dixie Highway, Suite 307
 Coral Gables, Florida 33146
 Tel: (305) 740-0120
 Email: locus@locusarchitecture.net
 License: AR 13937

CONSULTANT(S)

NO.	REVISION/SUBMISSION	DATE
	OWNER REVIEW	04-08-24
	PERMIT SUBMITTAL	06-07-24
	REVIEW COMMENT	08-19-24
	REVIEW COMMENT	11-04-24

PROJECT

New 2-Story Residence:
6100 W Suburban Dr, Pinecrest, FL 33156

DRAWING

Enlarged entry drive

SEAL

 Nelson de Leon
 AR 13937

SCALE
 DRAWN
 REVIEWED
 ND
 PROJ. NO.
 351

A-01.3