



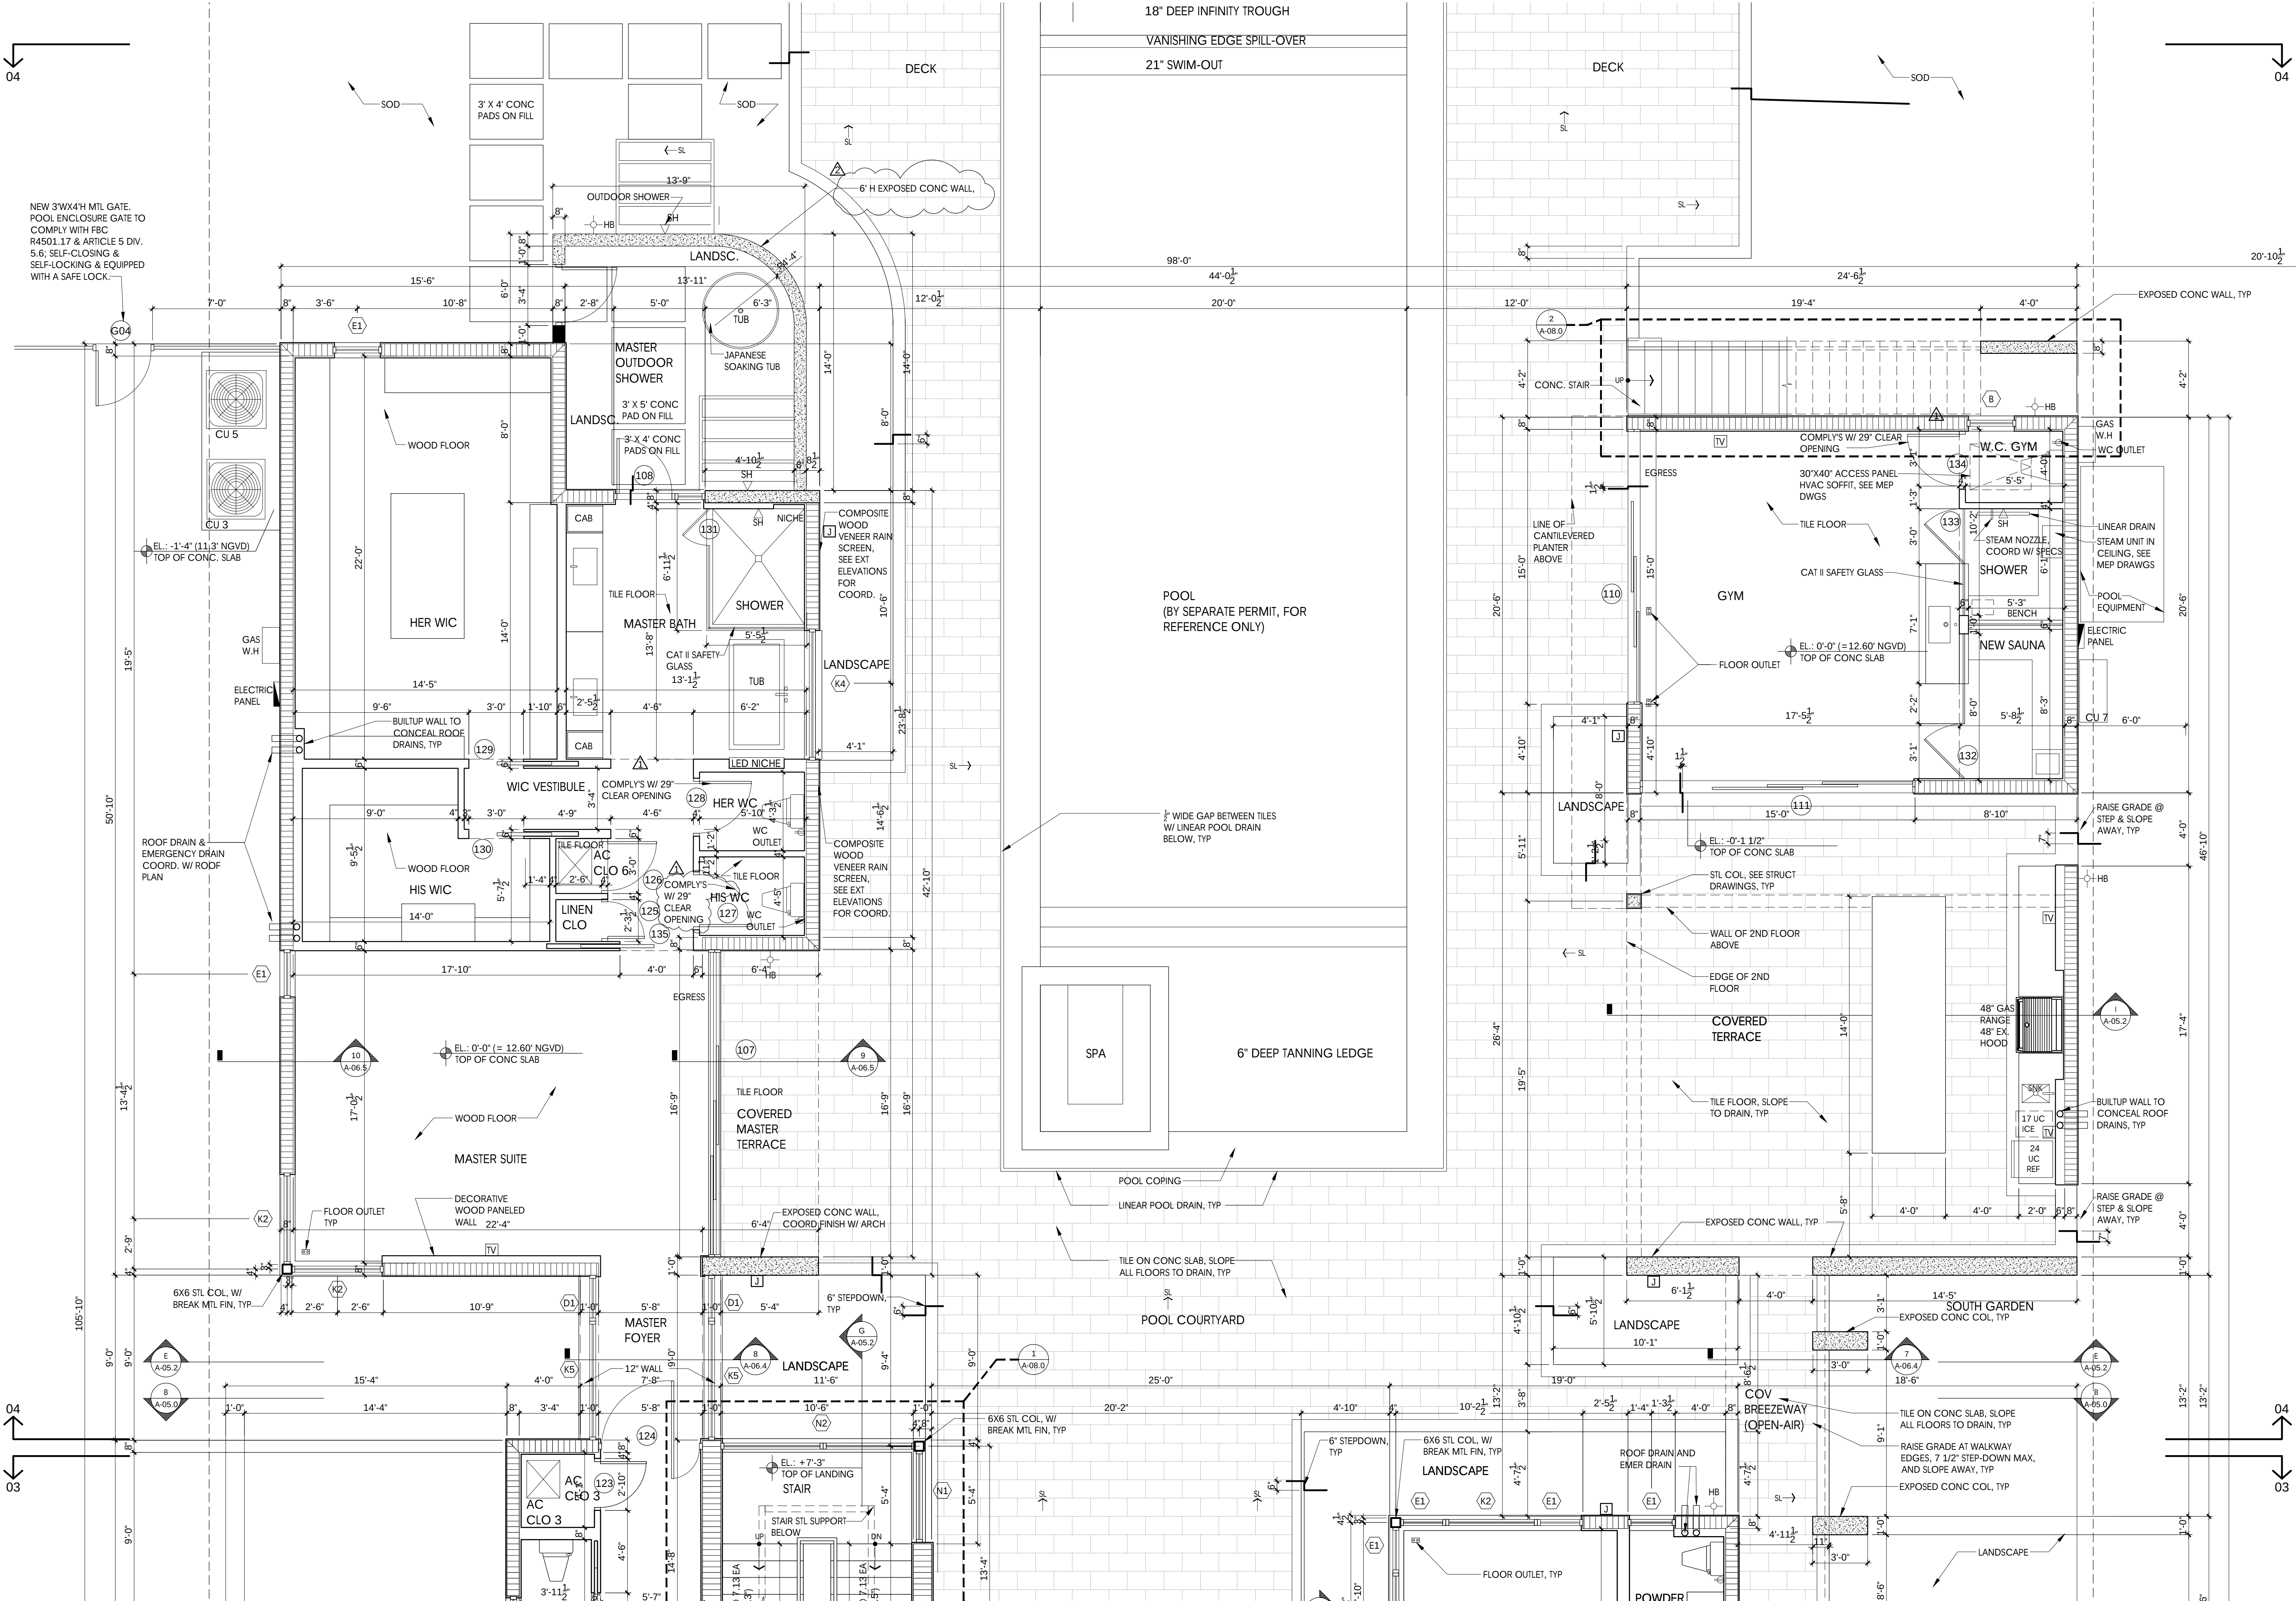

PARTIAL FIRST FLOOR PLAN: 04
SCALE: 1/4" = 1'-0"

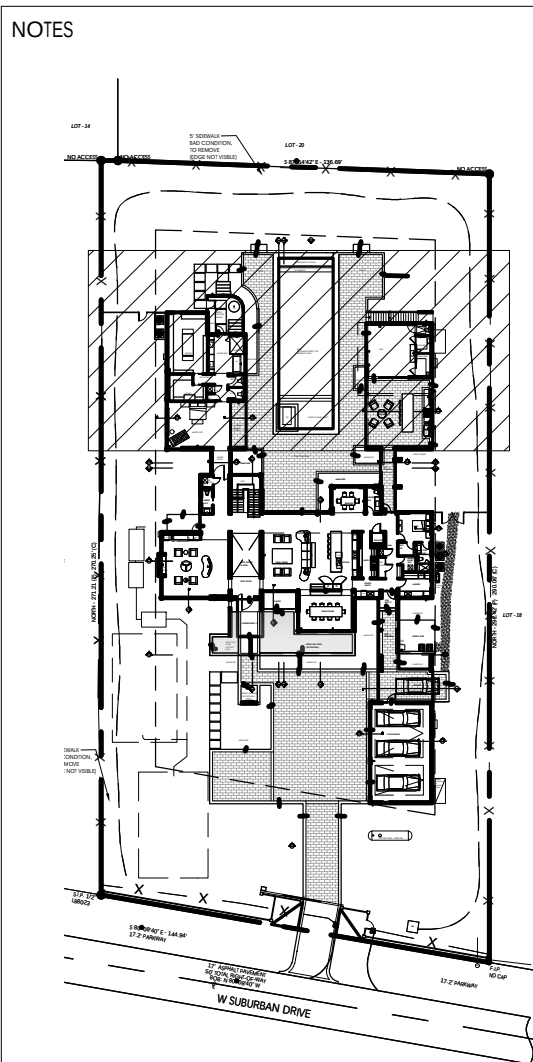

KEY PLAN
SCALE: 1/4" = 1'-0"

LOCUS
ARCHITECTURE
INCORPORATED
500 South Dixie Highway, Suite 307
Coral Gables, Florida 33146
Tel: (305) 740-0120
Email: locus@locusarchitecture.net
License: AR 13937

CONSULTANT(S)


NO.	REVISION/SUBMISSION	DATE
	OWNER REVIEW	04-08-24
	PERMIT SUBMITTAL	06-07-24
⚠	REVIEW COMMENT	08-19-24
⚠	REVIEW COMMENT	11-04-24

PROJECT

New 2-Story Residence:
6100 W suburban Dr, Pinecrest, FI 33156

DRAWING

Partial First Floor Plan: 04

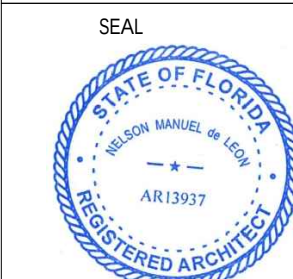

Nelson de Leon
AR 13937

SHEET NO.

A-02.3

SCALE
DRAWN
REVIEWED
NDL
PROJ. NO.
351