





THINKQ
Civil Engineering

WINDOWS AND DOOR CALCULATIONS

12940 SW, 63 Ave
Pinecrest, FL 33156

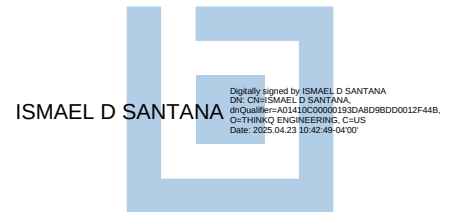

SHOP DRAWING / SUBMITTAL REVIEW	
☒ APPROVED	☐ APPROVED WITH CHANGES NOTED
☐ REVISE AND RESUBMIT	☐ REJECTED: _____
SUBMITTAL WAS REVIEWED FOR DESIGN CONFORMITY AND GENERAL CONFORMANCE TO CONTRACT DOCUMENTS ONLY. THE CONTRACTOR IS RESPONSIBLE FOR CONFIRMING AND CORRELATING DIMENSIONS AT JOB SITES FOR TOLERANCES, CLEARANCES, QUANTITIES, FABRICATION PROCESSES AND TECHNIQUES OF CONSTRUCTION, COORDINATION OF HIS WORK WITH OTHER TRADES AND FULL COMPLIANCE WITH THE CONTRACT DOCUMENTS.	
BY <u>Julio Pulido</u>	DATE <u>04-15-25</u>
NOVUS ARCHETYPE, LLC 12721 SW 30 ST MIAMI, FL 33175	

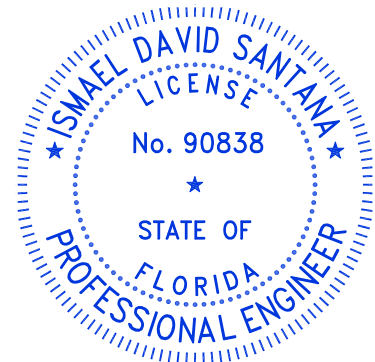

This item has been digitally signed and sealed by Ismael David Santana, P.E. on the date adjacent to the seal.


Printed copies of this document are not considered signed and sealed and the signature must be verified on any electronic copies.

Ismael David Santana, P.E.
Florida Registration No. 90838

Table Of Contents

Cover Page -----	01
Index -----	02
Wind Load Calculation -----	03-05

WIND LOAD CALCULATION

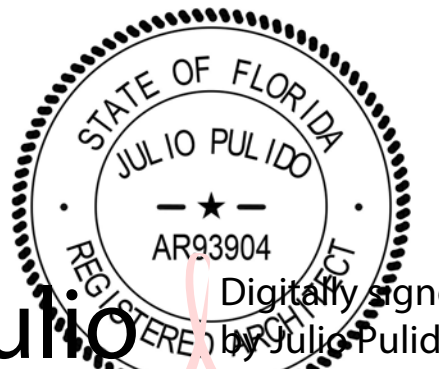

Digitally signed
by Julio Pulido
Date: 2024.06.13
15:06:39 -04'00'



2-Story Addition

[illegible]


Project number	-
Date	12-20-2022
Drawn by	SM
Checked by	SM, JP

SHEET TITLE


SHEET No.

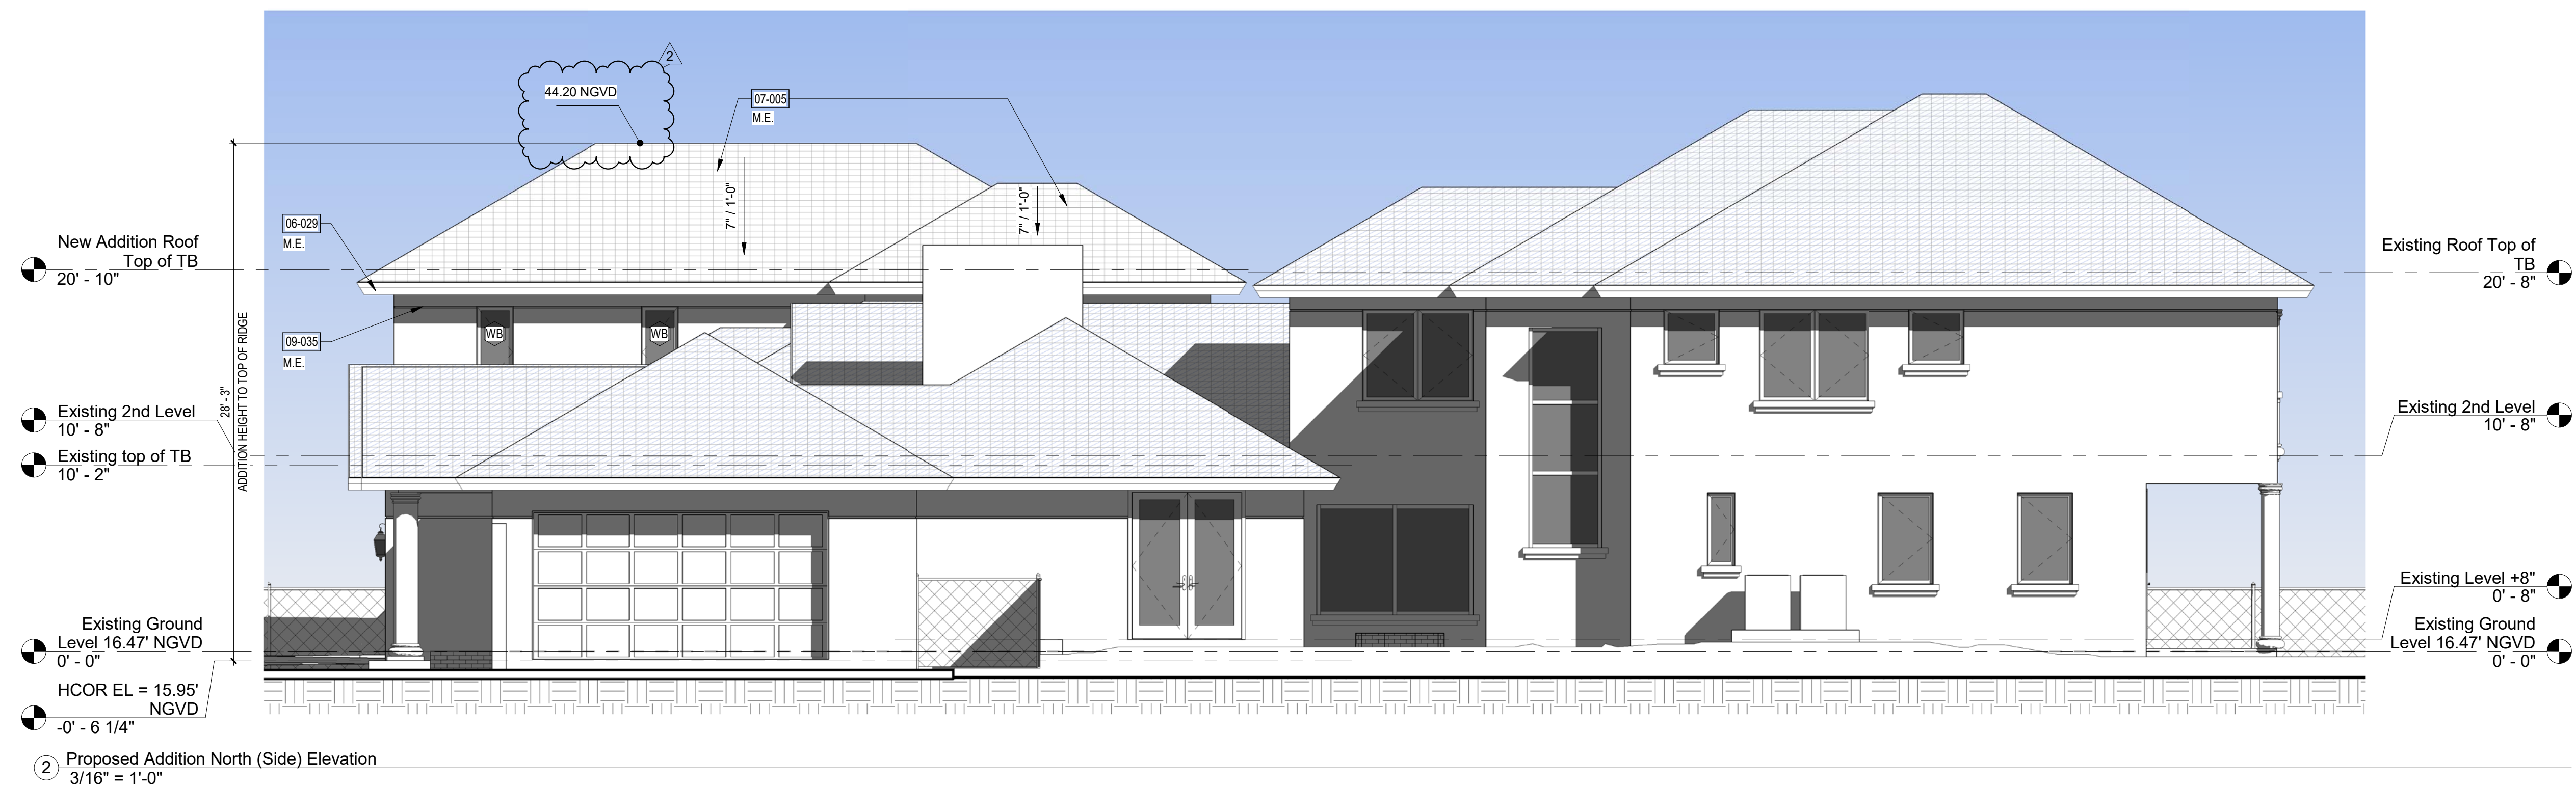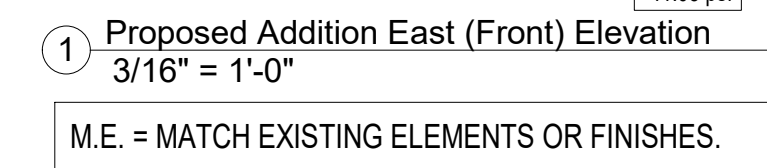Page 4 of 5
A410


REFER TO SHEET A420 FOR ELEVATIONS
& SECTIONS KEYNOTES SCHEDULE.

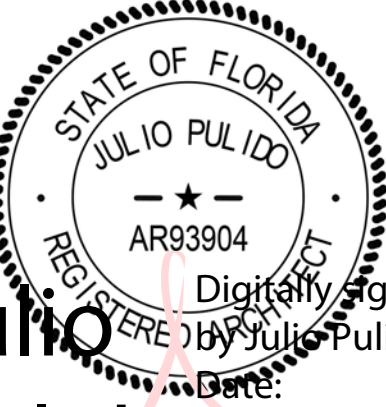

Digitally signed by Julio Pulido
Date: 2024.06.13 15:05:40 -04'00'

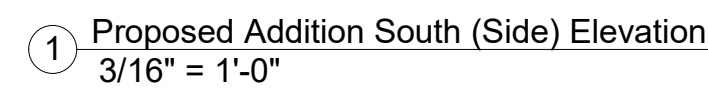

M.E. = MATCH EXISTING ELEMENTS OR FINISHES.

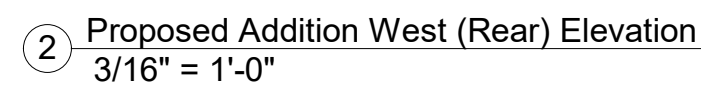

2 Proposed Addition West (Rear) Elevation
3/16" = 1'-0"

[illegible]

Project number	-
----------------	---

Date	12-20-2022
------	------------

Drawn by	SM
----------	----

Checked by	SM, JP
------------	--------

SHEET TITLE

Proposed Addition

Proposed Addition

Elevations	
------------	--

SHEET No. _____

Page 5 of 5

A415

ATHS

REFER TO SHEET A420 FOR ELEVATIONS
& SECTIONS KEYNOTES SCHEDULE.

Page 5 of 5
A415