



MIAMI-DADE COUNTY, FLORIDA
PRODUCT CONTROL SECTION

11805 SW 26 Street, Room 208

Miami, Florida 33175-2474

T (786) 315-2590 F (786) 315-2599

www.miamidade.gov/building

DEPARTMENT OF REGULATORY AND ECONOMIC RESOURCES (RER)
BOARD AND CODE ADMINISTRATION DIVISION

NOTICE OF ACCEPTANCE (NOA)

PGT Industries, Inc.
1070 Technology Drive
North Venice, FL 34275

SCOPE:

This NOA is being issued under the applicable rules and regulations governing the use of construction materials. The documentation submitted has been reviewed and accepted by Miami-Dade County RER - Product Control Section to be used in Miami Dade County and other areas where allowed by the Authority Having Jurisdiction (AHJ).

This NOA shall not be valid after the expiration date stated below. The Miami-Dade County Product Control Section (In Miami-Dade County) and/or the AHJ (in areas other than Miami-Dade County) reserve the right to have this product or material tested for quality assurance purposes. If this product or material fails to perform in the accepted manner, the manufacturer will incur the expense of such testing and the AHJ may immediately revoke, modify, or suspend the use of such product or material within their jurisdiction. RER reserves the right to revoke this acceptance if it is determined by Miami-Dade County Product Control Section that this product or material fails to meet the requirements of the applicable building code.

This product is approved as described herein and has been designed to comply with the Florida Building Code, including the High Velocity Hurricane Zone.

DESCRIPTION: Series "PW-740 Casement Picture" Aluminum Fixed Window - L.M.I.

APPROVAL DOCUMENT: Drawing No. MD-PW740-LM, titled "Casement Picture Window Details - LM", sheets 1 through 11 of 11, dated 08/08/12, with revision F dated 07/31/23, prepared by manufacturer, signed and sealed by Anthony Lynn Miller, P.E., bearing the Miami-Dade County Product Control Revision stamp with the Notice of Acceptance number and expiration date by the Miami-Dade County Product Control Section.

MISSILE IMPACT RATING: Large and Small Missile Impact Resistant

LABELING: Each unit shall bear a permanent label with the manufacturer's name or logo, city, state, model/series, and following statement: "Miami-Dade County Product Control Approved", unless otherwise noted herein.

RENEWAL of this NOA shall be considered after a renewal application has been filed and there has been no change in the applicable building code negatively affecting the performance of this product.

TERMINATION of this NOA will occur after the expiration date or if there has been a revision or change in the materials, use, and/or manufacture of the product or process. Misuse of this NOA as an endorsement of any product, for sales, advertising or any other purposes shall automatically terminate this NOA. Failure to comply with any section of this NOA shall be cause for termination and removal of NOA.

ADVERTISEMENT: The NOA number preceded by the words Miami-Dade County, Florida, and followed by the expiration date may be displayed in advertising literature. If any portion of the NOA is displayed, then it shall be done in its entirety.

INSPECTION: A copy of this entire NOA shall be provided to the user by the manufacturer or its distributors and shall be available for inspection at the job site at the request of the Building Official.

This NOA **revises** NOA No. 23-0303.02 and consists of this page 1 and evidence pages E-1, E-2, E-3 and E-4, as well as approval document mentioned above.

The submitted documentation was reviewed by **Manuel Perez, P.E.**




9/8/23

NOA No. 23-0816.08
Expiration Date: April 11, 2028
Approval Date: September 14, 2023
Page 1

NOTICE OF ACCEPTANCE: EVIDENCE SUBMITTED

1. EVIDENCE SUBMITTED UNDER PREVIOUS NOA's

A. DRAWINGS

1. Manufacturer's die drawings and sections.
(Submitted under NOA No. 12-1218.11)
2. Drawing No. **MD-PW740-LM**, titled "Casement Picture Window Details - LM", sheets 1 through 11 of 11, dated 08/08/12, with revision **E** dated 12/17/20, prepared by manufacturer, signed and sealed by Anthony Lynn Miller, P.E.
(Submitted under NOA No. 20-1223.06)

B. TESTS

1. Test reports on: 1) Air Infiltration Test, per FBC, TAS 202-94
2) Uniform Static Air Pressure Test, Loading per FBC, TAS 202-94
3) Water Resistance Test, per FBC, TAS 202-94
4) Large Missile Impact Test per FBC, TAS 201-94
5) Cyclic Wind Pressure Loading per FBC, TAS 203-94
6) Forced Entry Test, per ASTM F588 and TAS 202-94
along with marked-up drawings and installation diagram of all PGT Industries, Inc. representative units listed below and tested to qualify **Dowsil 791** and **Dowsil 983** silicones, prepared by Fenestration Testing Laboratory, Inc., Test Reports No.: **FTL-7897**, PGT PW5520 PVC Fixed Window (unit 6 in proposal), dated 09/03/14
FTL-20-2107.1, PGT SGD780 Aluminum Sliding Glass Door (unit 7 in proposal)
FTL-20-2107.2, PGT CA740 Alum. Outswing Casement Window (unit 8 in proposal)
FTL-20-2107.3, PGT PW7620A Aluminum Fixed Window (unit 9 in proposal) and
FTL-20-2107.4, PGT PW7620A Aluminum Fixed Window (unit 10 in proposal) dated 07/13/20, all signed and sealed by Idalmis Ortega, P.E.
(Submitted under NOA No. 20-0401.14)
2. Test reports on: 1) Uniform Static Air Pressure Test, Loading per FBC, TAS 202-94
2) Large Missile Impact Test per FBC, TAS 201-94
3) Cyclic Wind Pressure Loading per FBC, TAS 203-94
along with marked-up drawings and installation diagram of a PVC sliding glass door, a PVC fixed window and an aluminum sliding glass door, using: Kodispace 4SG TPS spacer system, Duraseal® spacer system, Super Spacer® NXT™ spacer system and XL Edge™ spacer system at insulated glass, prepared by Fenestration Testing Laboratory, Inc., Test Reports No. **FTL-8717**, **FTL-8968** and **FTL-8970**, dated 11/16/15, 06/07/16 and 06/02/16 respectively, all signed and sealed by Idalmis Ortega, P.E.
(Submitted under NOA No. 16-0629.22)


Manuel Pérez, P.E.
Product Control Examiner
NOA No. 23-0816.08
Expiration Date: April 11, 2028
Approval Date: September 14, 2023

NOTICE OF ACCEPTANCE: EVIDENCE SUBMITTED

1. EVIDENCE SUBMITTED UNDER PREVIOUS NOA's (CONTINUED)

B. TESTS (CONTINUED)

3. Test reports on: 1) Air Infiltration Test, per FBC, TAS 202-94
2) Uniform Static Air Pressure Test, Loading per FBC, TAS 202-94
3) Water Resistance Test, per FBC, TAS 202-94
4) Large Missile Impact Test per FBC, TAS 201-94
5) Cyclic Wind Pressure Loading per FBC, TAS 203-94
6) Forced Entry Test, per FBC 2411.3.2.1, and TAS 202-94
along with marked-up drawings and installation diagram of a series CA-740F
aluminum fixed casement window, prepared by Fenestration Testing Laboratory, Inc.,
Test Report No. **FTL-7063**, dated 09/17/12, signed and sealed by Marlin D. Brinson,
P.E.
(Submitted under NOA No. 12-1218.11)

C. CALCULATIONS


1. Anchor verification calculations and structural analysis, complying with **FBC 6th Edition (2017)** and **FBC 7th Edition (2020)** dated 03/19/20. prepared by
manufacturer, signed and sealed by Anthony Lynn Miller, P.E.
(Submitted under NOA No. 20-0401.14)

D. QUALITY ASSURANCE

1. Miami-Dade Department of Regulatory and Economic Resources (RER).

E. MATERIAL CERTIFICATIONS

1. Notice of Acceptance No. **20-0915.22** issued to **Kuraray America, Inc.** for their
“**Trosifol® Ultraclear, Clear and Color PVB Glass Interlayers**” dated 11/19/20,
expiring on 07/08/24.
2. Notice of Acceptance No. **22-1116.01** issued to **Kuraray America, Inc.** for their
“**SentryGlas® (Clear and White) Glass Interlayers**” dated 12/15/22, expiring on
07/04/28.

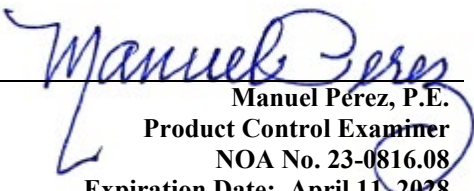
Manuel Pérez, P.E.
Product Control Examiner
NOA No. 23-0816.08
Expiration Date: April 11, 2028
Approval Date: September 14, 2023

NOTICE OF ACCEPTANCE: EVIDENCE SUBMITTED

1. EVIDENCE SUBMITTED UNDER PREVIOUS NOA's (CONTINUED)
E. STATEMENTS

1. Statement letter of conformance, complying with **FBC 7th Edition (2020)**, dated March 1, 2023, issued by manufacturer, signed and sealed by Anthony Lynn Miller, P.E.
(Submitted under NOA No. 23-0303.02)
2. Statement letter of no financial interest, dated March 1, 2023, issued by manufacturer, signed and sealed by Anthony Lynn Miller, P.E..
(Submitted under NOA No. 23-0303.02)
3. Proposal No. **19-1155 TP** issued by the Product Control Section, dated January 10, 2020, signed by Ishaq Chanda, P.E.
(Submitted under NOA No. 20-0401.14)

G. OTHERS

1. Notice of Acceptance No. **20-1223.06**, issued to PGT Industries, Inc. for their Series "PW740 Casement Picture" Aluminum Fixed Window – L.M.I." approved on 03/04/21 and expiring on 04/11/23.


2. NEW EVIDENCE SUBMITTED

A. DRAWINGS

1. Drawing No. **MD-PW740-LM**, titled "Casement Picture Window Details - LM", sheets 1 through 11 of 11, dated 08/08/12, with revision **F** dated 07/31/23, prepared by manufacturer, signed and sealed by Anthony Lynn Miller, P.E.

B. TESTS

1. Test reports on: 1) 400 ft-lb Drop Test, per ANSI Z97.1-15 Class A and FBC Sections 2406.2 and 2406.4.3. along with marked-up drawings and installation diagram of CGI Windows & Doors, Inc. and PGT Industries, Inc. representative units listed below and tested to qualify ANSI Z97.1 Safety Glazing on corresponding lites of CGI and PGT lines of fixed window products, prepared by QAI Laboratories, Test Reports No.: **NOK-0049**, test specimen: CGI Windows & Doors, Inc. Series "PW238" Aluminum Fixed Window – L.M.I. (unit 1 in proposal No. **23-0441R** dated 06/12/23) **NOK-0050**, test specimen: PGT Industries, Inc. Series "PW5520 Vinyl Fixed Window – L.M.I. (unit 2 in proposal No. **23-0441R** dated 07/13/20), each dated 08/02/23, and signed and sealed by Idalmis Ortega, P.E

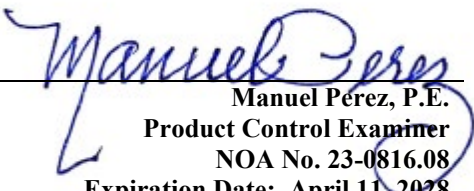
Manuel Pérez, P.E.
Product Control Examiner
NOA No. 23-0816.08
Expiration Date: April 11, 2028
Approval Date: September 14, 2023

NOTICE OF ACCEPTANCE: EVIDENCE SUBMITTED

2. NEW EVIDENCE SUBMITTED (CONTINUED)

C. CALCULATIONS

1. None.

D. QUALITY ASSURANCE

1. Miami-Dade Department of Regulatory and Economic Resources (RER)

E. MATERIAL CERTIFICATIONS

1. Notice of Acceptance No. **20-0915.22** issued to **Kuraray America, Inc.** for their “Trosifol® Ultraclear, Clear and Color PVB Glass Interlayers” dated 11/19/20, expiring on 07/08/24.
2. Notice of Acceptance No. **22-1116.01** issued to **Kuraray America, Inc.** for their “SentryGlas® (Clear and White) Glass Interlayers” dated 12/15/22, expiring on 07/04/28.

F. STATEMENTS

1. Statement letter of conformance, complying with **FBC 7th Edition (2020)** and the **FBC 8th Edition (2023)**, dated July 31, 2023, issued by manufacturer, signed and sealed by Anthony Lynn Miller, P.E.
2. Statement letter of no financial interest, dated July 31, 2023, issued by manufacturer, signed and sealed by Anthony Lynn Miller, P.E.
3. Proposal No. **23-0441R** issued by the Product Control Section, dated 06/06/23 and revised on 06/12/23, signed by Manuel Perez, P.E.

G. OTHERS

1. Notice of Acceptance No. **23-0303.02**, issued to PGT Industries, Inc. for their Series “PW740 Casement Picture” Aluminum Fixed Window – L.M.I.” approved on 03/30/23 and expiring on 04/11/28.


Manuel Perez, P.E.
Product Control Examiner
NOA No. 23-0816.08
Expiration Date: April 11, 2028
Approval Date: September 14, 2023

GENERAL NOTES: SERIES PW740
IMPACT-RESISTANT CASEMENT PICTURE WINDOW

1) THIS PRODUCT HAS BEEN DESIGNED & TESTED TO COMPLY WITH THE REQUIREMENTS OF THE FLORIDA BUILDING CODE, INCLUDING THE HIGH VELOCITY HURRICANE ZONE (HVHZ).

1) THIS PRODUCT HAS BEEN DESIGNED & TESTED TO COMPLY WITH THE REQUIREMENTS OF THE FLORIDA BUILDING CODE, INCLUDING THE HIGH VELOCITY HURRICANE ZONE (HVHZ).

2) SHUTTERS ARE NOT REQUIRED WHEN USED IN WIND-BORNE DEBRIS REGIONS. FOR INSULATED GLASS INSTALLATIONS ABOVE 30' IN THE HVHZ, THE OUTBOARD LITE (CAP) MUST TEMPERED.

3) FOR MASONRY APPLICATIONS IN MIAMI-DADE COUNTY, USE ONLY MIAMI-DADE COUNTY APPROVED MASONRY ANCHORS. MATERIALS USED FOR ANCHOR EVALUATIONS WERE SOUTHERN PINE, ASTM C90 CONCRETE MASONRY UNITS AND CONCRETE WITH MIN. KSI PER ANCHOR TYPE, SEE TABLE 3, SHEET 4.

4) ALL WOOD BUCKS LESS THAN 1-1/2" THICK ARE TO BE CONSIDERED 1X INSTALLATIONS. 1X WOOD BUCKS ARE OPTIONAL IF UNIT IS INSTALLED DIRECTLY TO SUBSTRATE. WOOD BUCKS DEPICTED AS 2X ARE 1-1/2" THICK OR GREATER. 1X AND 2X BUCKS (WHEN USED) SHALL BE DESIGNED TO PROPERLY TRANSFER LOADS TO THE STRUCTURE. WOOD BUCK DESIGN AND INSTALLATION IS THE RESPONSIBILITY OF THE ENGINEER OR ARCHITECT OF RECORD.

5) ANCHOR EMBEDMENT TO BASE MATERIAL SHALL BE BEYOND WALL DRESSING OR STUCCO. USE ANCHORS OF SUFFICIENT EMBEDMENT AS SPECIFIED ON TABLE 3, SHEET 4. NARROW JOINT SEALANT IS USED ON ALL FOUR CORNERS OF THE FRAME. OVERALL SEALING/FLASHING STRATEGY FOR WATER RESISTANCE OF INSTALLATION SHALL BE DONE BY OTHERS AND IS BEYOND THE SCOPE OF THESE INSTRUCTIONS.

6) SHIMS ARE REQUIRED AT EACH ANCHOR LOCATION WHERE THE PRODUCT IS NOT FLUSH TO THE SUBSTRATE. USE SHIMS CAPABLE OF TRANSFERRING APPLIED LOADS. WOOD BUCKS, BY OTHERS, MUST BE SUFFICIENTLY ANCHORED TO RESIST LOADS IMPOSED ON THEM BY THE WINDOW.

7) DESIGN PRESSURES:

- A. NEGATIVE DESIGN LOADS BASED ON STRUCTURAL TEST PRESSURE, FRAME ANALYSIS AND GLASS PER ASTM E1300.
- B. POSITIVE DESIGN LOADS BASED ON WATER TEST PRESSURE, STRUCTURAL TEST PRESSURE, FRAME ANALYSIS AND GLASS PER ASTM E1300.
- C. DESIGN LOADS ARE BASED ON ALLOWABLE STRESS DESIGN, ASD.

8) THE ANCHORAGE METHODS SHOWN HAVE BEEN DESIGNED TO RESIST THE WINDLOADS CORRESPONDING TO THE REQUIRED DESIGN PRESSURE. THE 33-1/3% STRESS INCREASE HAS NOT BEEN USED IN THE DESIGN OF THIS PRODUCT. THE 1.6 LOAD DURATION FACTOR WAS USED FOR THE EVALUATION OF ANCHORS INTO WOOD. ANCHORS THAT COME INTO CONTACT WITH OTHER DISSIMILAR MATERIALS SHALL MEET THE REQUIREMENTS OF THE FLORIDA BUILDING CODE FOR CORROSION RESISTANCE.

9) REFERENCES: TEST REPORTS FTL-7063, 3579, 3580, 3724; DEWALT ULTRACON+ NOA; ELCO ULTRACON NOA; DEWALT/ELCO CRETEFLEX NOA; ANSI/AF&PA NDS FOR WOOD CONSTRUCTION AND ADM ALUMINUM DESIGN MANUAL.


10) THE PW740 CASEMENT PICTURE WINDOW WAS FORMERLY KNOWN AS THE CA740F FIXED CASEMENT WINDOW.

11) FRAME FLANGES OR INTEGRAL FINS MAY BE TRIMMED IN-FIELD TO
CREATE AN EQUAL-LEG FRAME.

CODES / STANDARDS USED:

- 2023 FLORIDA BUILDING CODE (FBC), 8TH EDITION
- 2020 FLORIDA BUILDING CODE (FBC), 7TH EDITION
- ASTM E1300-04
- ANSI/AF&PA NDS-2018 FOR WOOD CONSTRUCTION
- ALUMINUM DESIGN MANUAL, ADM-2020
- AISI S100-16
- AISC 360-16

DESIGN PRESSURE RATING	IMPACT RATING
VARIABLE, SEE SHEETS 6-10	RATED FOR LARGE & SMALL MISSILE IMPACT RESISTANCE

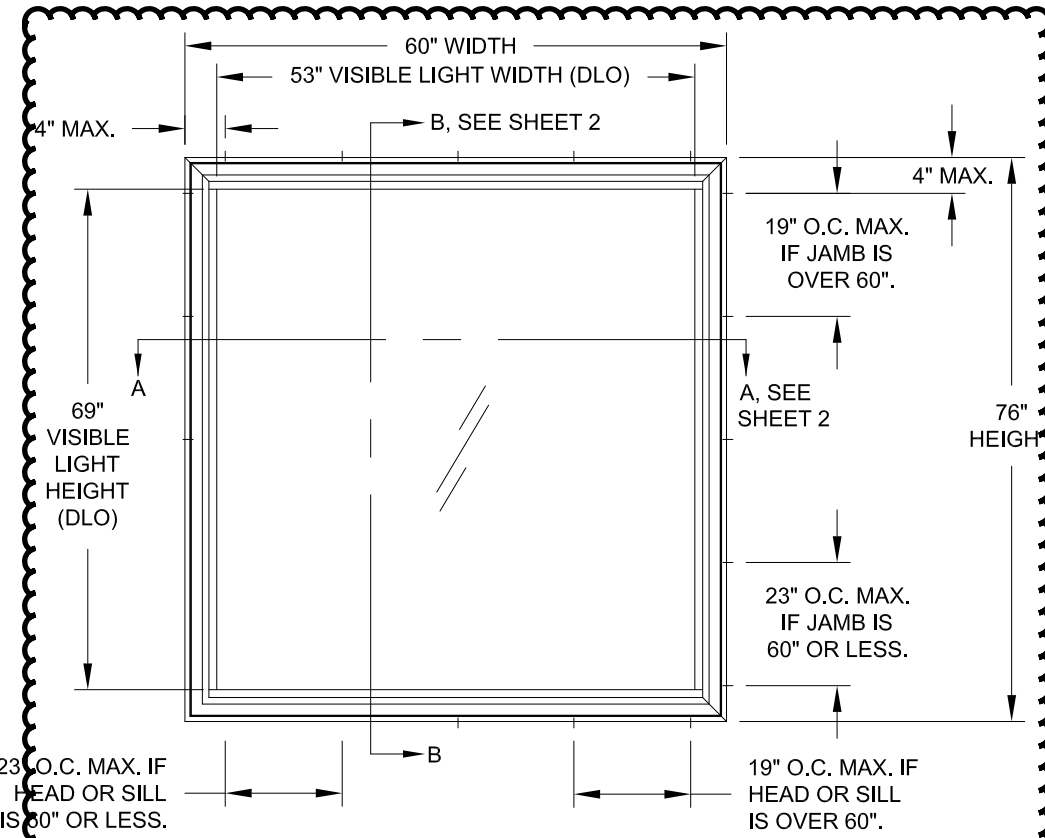

TYP. ELEVATION OF CASEMENT PICTURE WINDOW

TABLE 1:



Glass Types		Sheet #
1	5/16" Lami (1/8 An - .090" PVB - 1/8 An)	6
2	7/16" Lami (3/16 An - .090" SG - 3/16 An)	8
3	7/16" Lami (3/16 HS - .090" SG - 3/16 HS)	9
4	7/8" Lami. IG (1/8" An - 7/16" Air - 1/8" An - .090" PVB - 1/8" An	10
5	7/8" Lami. IG (1/8" T - 7/16" Air - 1/8" An - .090" PVB - 1/8" An	7
6	7/8" Lami. IG (3/16" An - 1/4" Air - 3/16" An - .090" SG - 3/16" An	8
7	7/8" Lami. IG (3/16" An - 1/4" Air - 3/16" HS - .090" SG - 3/16" HS	9
8	7/8" Lami. IG (3/16" T - 1/4" Air - 3/16" An - .090" SG - 3/16" An	8
9	7/8" Lami. IG (3/16" T - 1/4" Air - 3/16" HS - .090" SG - 3/16" HS	9

"PVB"= TROSIFOL[®] PVB INTERLAYER BY KURARAY AMERICA, INC.
 "SG"= SENTRYGLAS[®] INTERLAYER BY KURARAY AMERICA, INC.

THIS SYSTEM HAS BEEN TESTED TO MEET THE 400 FT-LB KINETIC ENERGY IMPACT LOADING REQUIREMENTS OF ANSI Z97.1 WHEN USING GLASS TYPES 3 & 9.


GENERAL NOTES.....	1
ELEVATION.....	1
GLAZING DETAILS.....	1
INSTALLATION.....	2
ASSEMBLY TUBE DETAILS.....	3
ANCHOR SPECIFICATIONS.....	4
ANCHOR QUANTITIES.....	4-5
DESIGN PRESSURES.....	6-10
ASSEMBLY DETAILS/BOM.....	11

PRODUCT REVISED
As complying with the Florida
Building Code
NOA-No. 23-0816.08
Expiration Date: 04/11/2028
By: Mamuk Bero
Miami-Dade Product Control

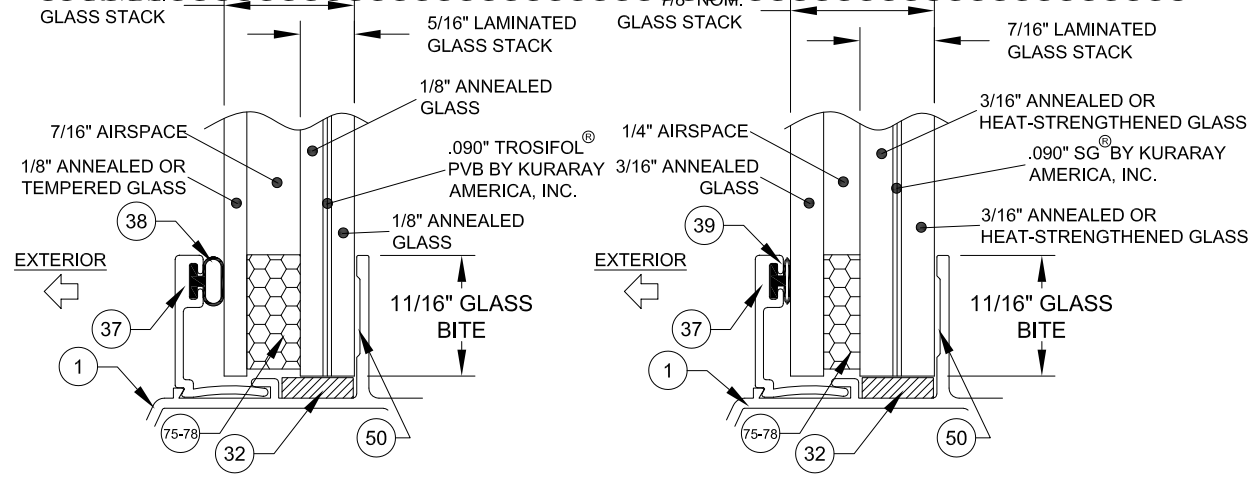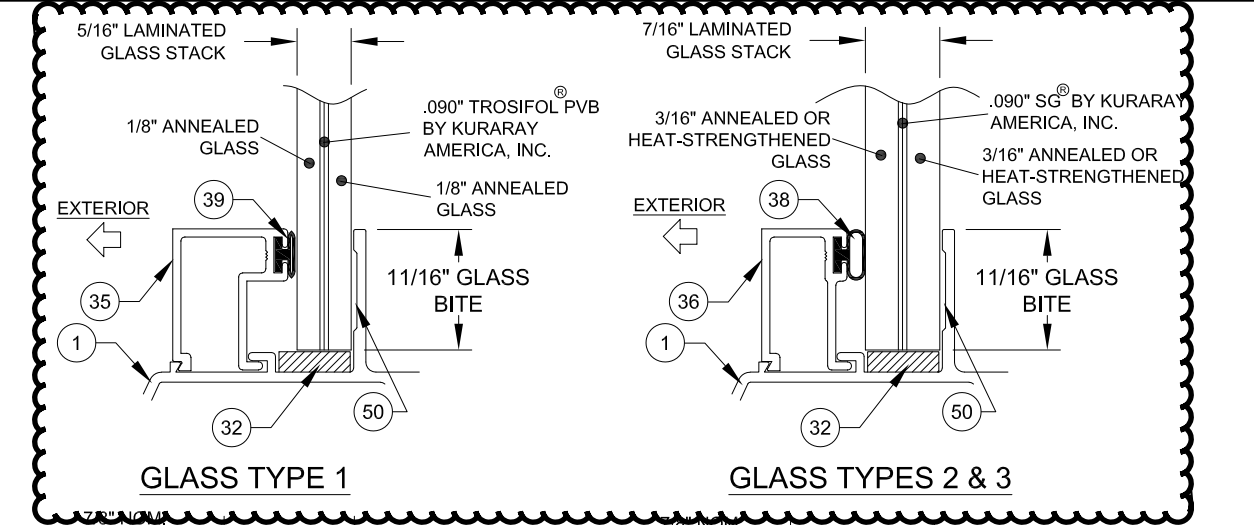

GLASS TYPES 4 & 5

GLASS TYPES 6 & 7

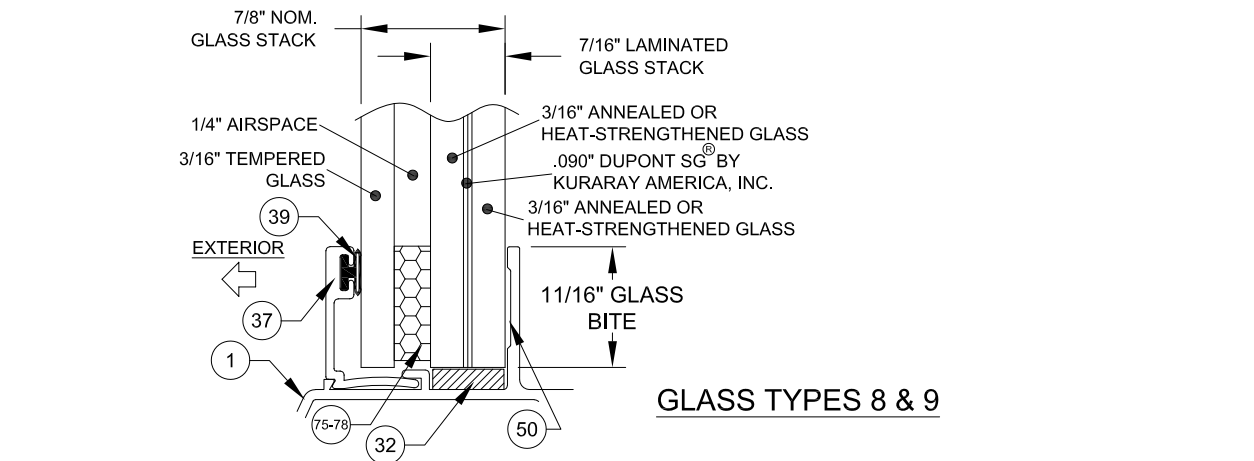

GLASS TYPES 8 & 9




Custom Windows and Doors
1070 TECHNOLOGY DRIVE
N. VENICE, FL 34275
(941) 480-1600

PREPARED BY A. LYNN MILLER
1070 TECHNOLOGY DRIVE
N. VENICE, FL 34275

(941) 480-1600

REGISTRATION #29296

Title	CASEMENT PICTURE WINDOW DETAILS - LM						Date	08/08/12		
Desc.	GENERAL NOTES & ELEVATION				Drawn By	J ROSOWSKI				
Rev.	F) UPDATE TO 2023 BUILDING CODE. REMOVE "INSTALLATION ANCHORS s/b SEALED" FROM NOTE 5. ADD NOTE 11. ADD NOTE. MEETS ANSI Z97.1. SB						Rev Date	07/31/23		
Series	PW-740		Sheet	1 OF 11		DWG No.	MD-PW740-LM		Rev.	F

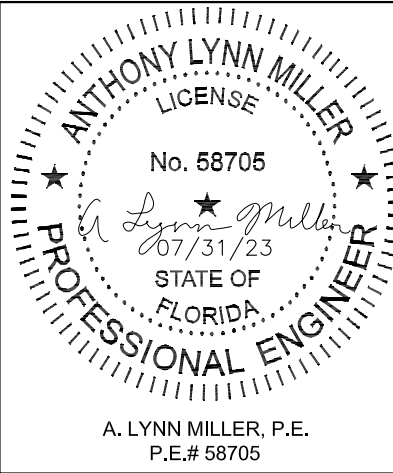

INSTALLATION
OPTION 1
INSTALLATION ANCHORS
INTO 2X WOOD.

EDGE DISTANCE

EDGE DISTANCE

EMBEDMENT

AS REQUIRED
PER TABLE 3,
SHEET 4

35-37

WINDOW
HEIGHT

VISIBLE
LIGHT
HEIGHT
(DLO)

EXTERIOR

BUCK
HEIGHT

38 39

1

3

4

1X WOOD
BUCKSTRIP,
SEE NOTE 2,
THIS SHEET.

1/4" MAX SHIM

CONCRETE
PER ANCHOR
REQUIREMENT

EMBEDMENT

EDGE DISTANCE

VERTICAL SECTION B-B

INSTALLATION
OPTION 2
INSTALLATION
ANCHORS DIRECTLY
INTO MASONRY.

TYP. ANCHOR
TYPE,
EMBEDMENT AND
EDGE DISTANCE
PER SUBSTRATE,
SEE TABLE 3,
SHEET 4.

CONCRETE/CMU
PER ANCHOR
REQUIREMENT

1/4" MAX
SHIM

EDGE
DISTANCE

EMBEDMENT

70
OPTIONAL ADDON
FLANGE @ HEAD,
SILL & JAMBS

NOTES:

1) USE ONLY SUBSTRATE-APPROPRIATE
ANCHORS LISTED ON TABLE 3, SHEET 4.
FOLLOW EMBEDMENT AND EDGE
DISTANCE LIMITS. ANY INSTALLATION
OPTION SHOWN MAY BE USED ON ANY
SIDE OF THE WINDOW.

2) ALL WOOD BUCKS LESS THAN 1-1/2"
THICK ARE TO BE CONSIDERED 1X
INSTALLATIONS. 1X WOOD BUCKS ARE
OPTIONAL. UNIT MAY BE INSTALLED
DIRECTLY TO SUBSTRATE. WOOD BUCKS
DEPICTED AS 2X ARE 1-1/2" THICK OR
GREATER. 1X AND 2X BUCKS (WHEN USED)
SHALL BE DESIGNED TO PROPERLY
TRANSFER LOADS TO THE STRUCTURE.
WOOD BUCK DESIGN AND INSTALLATION
IS THE RESPONSIBILITY OF THE ENGINEER
OR ARCHITECT OF RECORD. MAXIMUM
SHIM THICKNESS TO BE 1/4".

INSTALLATION
OPTION 2
INSTALLATION
ANCHORS DIRECTLY
INTO MASONRY.

CONCRETE/CMU
PER ANCHOR
REQUIREMENT



1/4" MAX
SHIM

EDGE
DISTANCE


EMBEDMENT

70
OPTIONAL ADDON
FLANGE @ HEAD,
SILL & JAMBS


SEE DETAIL
A1, BELOW

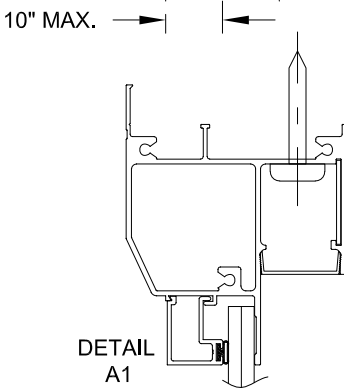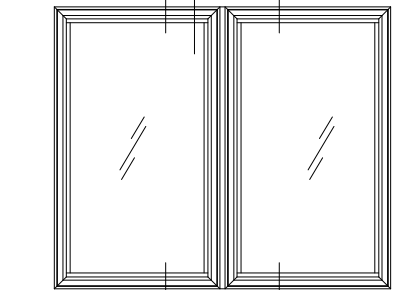

DETAIL
A1

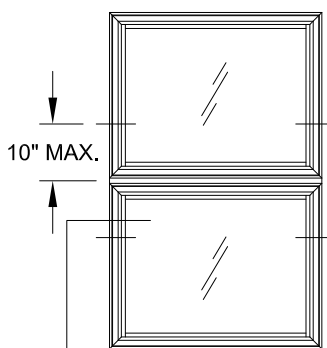

10" MAX.

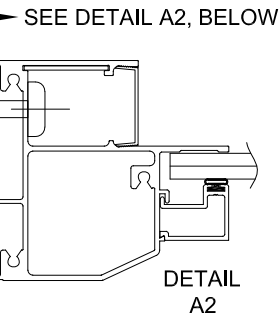

SEE DETAIL A2, BELOW

DETAIL
A2

BUCK WIDTH

VISIBLE LIGHT WIDTH (DLO)

HORIZONTAL SECTION A-A

INSTALLATION
OPTION 4
INSTALLATION
ANCHORS DIRECTLY
INTO METAL.

STEEL
SELF-DRILLING
SMS, SEE TABLE 3,
SHEET 4.

EDGE DISTANCE

DADE APPROVED
MULLION, ALUMINUM,
STEEL FRAMING OR
STEEL STUD.

VISIBLE LIGHT FORMULAS
WIDTH: WINDOW WIDTH - 7
HEIGHT: WINDOW HEIGHT - 7

AS REQUIRED
PER TABLE 3,
SHEET 4

2

35-37

1

NOTES:

1) WHEN INSTALLING
COMBINATION UNITS,
ADDITIONAL INSTALLATION
ANCHORS MAY NEED TO BE
INSTALLED THROUGH THE
WINDOW FRAMES AT 10" MAX.
FROM EACH SIDE OF THE FRAME
ASSEMBLY TUBE CENTERLINE.
SEE TABLE BELOW:

Additional Anchors Required on each Side of the Frame Assembly Tube (FAT)			
Vert. FAT	Window Width	Anchor Type	
		A	B, C & D
	17" - 25.9"	1	0
Horiz. FAT	Window Height	Anchor Type	
		A	B, C & D
	17" - 25.9"	1	0
Horiz. FAT	26"+	1	1

PGT
Custom Windows and Doors

1070 TECHNOLOGY DRIVE
N. VENICE, FL 34275
(941) 480-1600


PREPARED BY A. LYNN MILLER
1070 TECHNOLOGY DRIVE
N. VENICE, FL 34275

(941) 480-1600


REGISTRATION #29296

PRODUCT REVISED
As complying with the Florida
Building Code
NOA-No. **23-0816.08**
Expiration Date: **04/11/2028**
By: *Manuel Perez*
Miami-Dade Product Control



Series	Rev	Desc.	Title	Date
PW-740	2	OF 11	CASEMENT PICTURE WINDOW DETAILS - LM	08/08/12
			GENERAL NOTES & ELEVATION	Drawn By J ROSOWSKI
			F) NO CHANGES, THIS SHEET. SB	Rev Date 07/31/23
				Rev. F

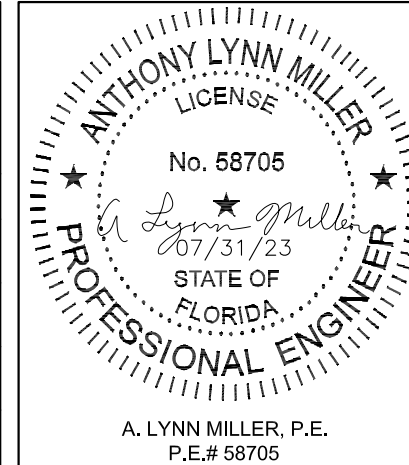


CASEMENT PICTURE WINDOW (O)

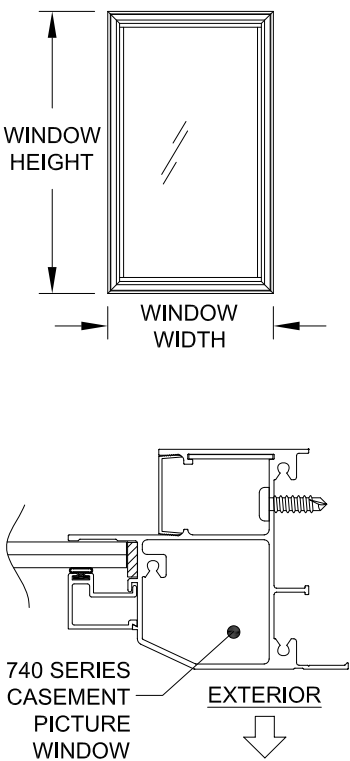


CASEMENT PICTURE WINDOW / CASEMENT (OX)

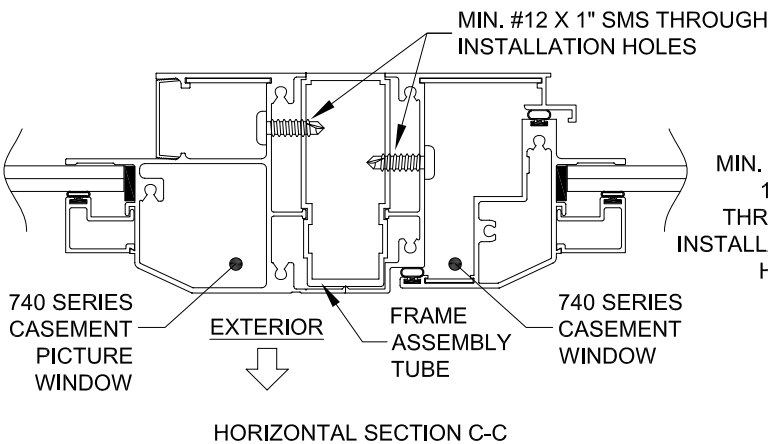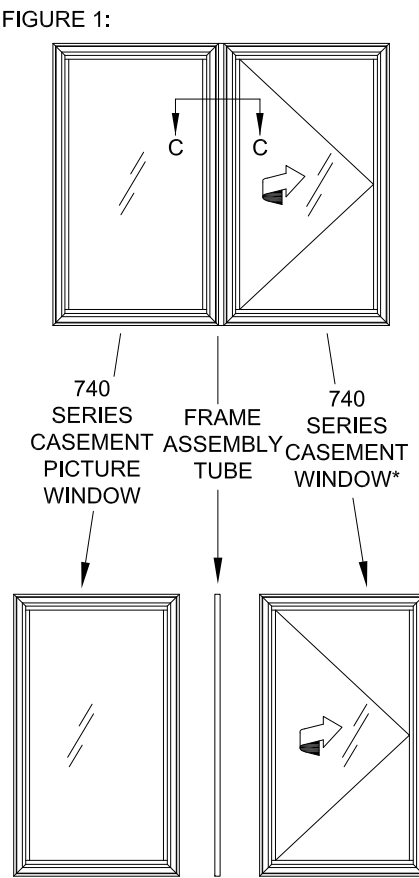


AWNING / CASEMENT / CASEMENT PICTURE WINDOW (XXO)

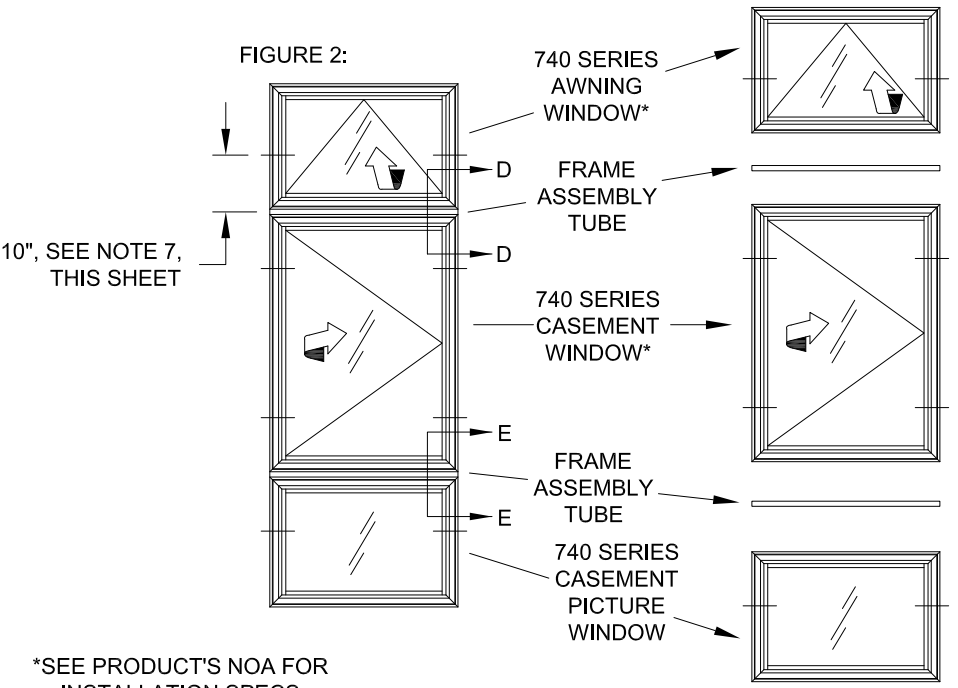

*SEE PRODUCT'S NOA FOR INSTALLATION SPECS

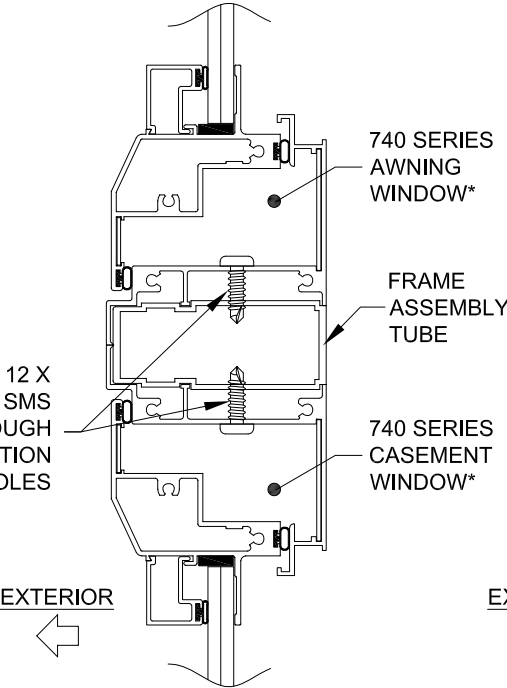

VERTICAL SECTION D-D

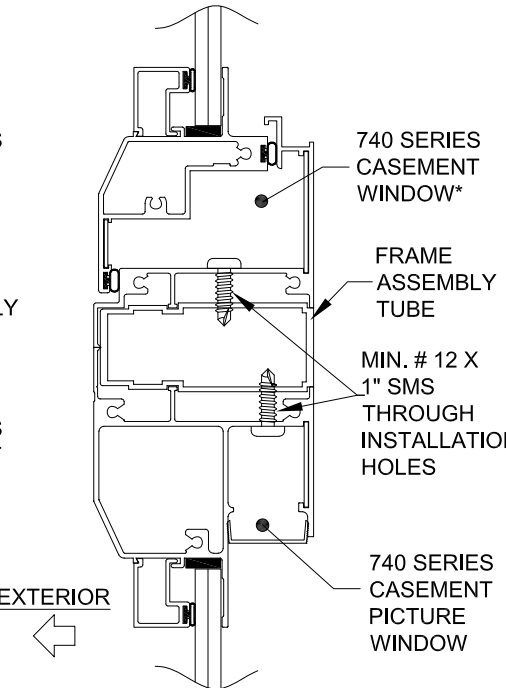

VERTICAL SECTION E-E

FRAME ASSEMBLY TUBE NOTES:

- 1) DIMENSIONS SHOWN ARE TIP-TO-TIP DIMENSIONS FOR EACH INDIVIDUAL WINDOW. FOR SIZES NOT SHOWN, ROUND UP TO THE NEXT AVAILABLE WIDTH OR HEIGHT DIMENSION SHOWN ON THE TABLES.
- 2) ANY 740-SERIES PRODUCT (CASEMENT, AWNING OR CASEMENT PICTURE WINDOW) MAY BE ATTACHED TO THE FRAME ASSEMBLY TUBE. FOR ALL WINDOWS, USE THE WINDOW'S NOA FOR ANCHORAGE, SIZE AND DESIGN PRESSURE LIMITATIONS.
- 3) ALL WINDOWS IN THE COMBINATION UNIT MUST BE ABLE TO INDIVIDUALLY COMPLY WITH THE REQUIREMENTS OF THEIR RESPECTIVE NOA.
- 4) FRAME ASSEMBLY TUBE TO BE FASTENED TO WINDOW, AS SHOW IN DETAILS, WITH MIN. #12 X 1" SHEET METAL SCREWS. USE THE SAME SPACING AND QUANTITY AS THE OPPOSITE FRAME MEMBER.
- 5) THE FRAME ASSEMBLY TUBE MAY NOT EXCEED 62" IN LENGTH (AS USED IN A 63" FLANGED WINDOW) OR BE USED IN TEE OR CROSS CONFIGURATIONS.
- 6) THE FRAME ASSEMBLY TUBE IS NOT REQUIRED TO BE CLIPPED TO THE SUBSTRATE. ALL EXTERIOR JOINTS TO BE SEALED BY INSTALLER.
- 7) FOR ALL COMBINATION UNITS, ADDITIONAL INSTALLATION ANCHORS MAY NEED TO BE INSTALLED THROUGH THE WINDOW FRAMES AT 10" MAX. FROM EACH SIDE OF THE FRAME ASSEMBLY TUBE CENTERLINE. SEE TABLE BELOW:

Additional Anchors Required on each Side of the Frame Assembly Tube (FAT)			
Vert. FAT	Window Width	Anchor Type	
		A	B, C & D
	17" - 25.9"	1	0
Horiz. FAT	Window Height	Anchor Type	
		A	B, C & D
	17" - 25.9"	1	0
	26"+	Anchor Type	
		A	B, C & D
		1	1

FOR SINGLE UNITS:

- 1) DETERMINE YOUR WINDOW SIZE AND GLASS.
- 2) KNOWING YOUR ANCHOR TYPE AND SUBSTRATE, DETERMINE YOUR ANCHOR GROUP FROM TABLE 3, SHEET 4.
- 3) FROM SHEETS 6-10, FIND THE SHEET FOR YOUR GLASS TYPE. FIND THE PRODUCT'S DESIGN PRESSURE FROM THE TABLE LABELED "DESIGN PRESSURE (PSF) FOR SINGLE WINDOWS, ALL ANCHOR GROUPS".
- 4) DIMENSIONS SHOWN ARE TIP-TO-TIP. FOR SIZES NOT SHOWN, ROUND UP TO THE NEXT AVAILABLE WIDTH OR HEIGHT DIMENSION SHOWN ON THE TABLES.
- 5) USING THE TABLES LABELED "WINDOW ANCHORS REQUIRED" (TABLES 2A & 2B, SHEETS 4 & 5), DETERMINE THE NUMBER OF ANCHORS NEEDED IN THE HEAD, SILL AND JAMBS OF YOUR WINDOW.
- 6) INSTALL AS PER THE INSTRUCTIONS ON SHEET 2.

FOR EACH WINDOW IN A COMBINED ASSEMBLY:

- 1) DETERMINE EACH INDIVIDUAL WINDOW TYPE, SIZE AND GLASS MAKEUP, SEE FIGURES 1 & 2, THIS SHEET. DETERMINE YOUR ANCHOR GROUP FROM TABLE 3, SHEET 4.
- 2) FROM SHEETS 6-10, FIND THE SHEET FOR YOUR GLASS TYPE.
- 3) FIND THE DESIGN PRESSURE FROM THE TABLES LABELED "DESIGN PRESSURE (PSF) FOR WINDOWS ATTACHED TO A FRAME ASSEMBLY TUBE". THIS MUST BE DONE FOR EACH WINDOW IN THE ASSEMBLY, AND THE LOWEST DESIGN PRESSURE APPLIES TO THE ENTIRE ASSEMBLY. DIMENSIONS SHOWN ARE TIP-TO-TIP. FOR SIZES NOT SHOWN, ROUND UP TO THE NEXT AVAILABLE WIDTH OR HEIGHT DIMENSION SHOWN ON THE TABLES.
- 4) USING THE TABLE LABELED "WINDOW ANCHORS REQUIRED" (TABLES 2A & 2B, SHEETS 4 & 5), DETERMINE THE NUMBER OF ANCHORS NEEDED IN THE HEAD, SILL AND JAMBS OF YOUR WINDOW.
- 5) INSTALL AS PER THE INSTRUCTIONS ON SHEETS 2-3. NOTE THAT ADDITIONAL ANCHORS THROUGH THE WINDOW FRAME INTO THE SUBSTRATE MAY BE REQUIRED (SEE SHEET 2), AND THAT MIN. # 12 X 1" ANCHORS ARE TO BE USED THROUGH THE FRAME INTO THE FRAME ASSEMBLY TUBE (SEE DETAILS ON THIS SHEET).

PRODUCT REVISED
As complying with the Florida Building Code
NOA-No. 23-0816.08
Expiration Date: 04/11/2028
By: *Manuel Perez*
Miami-Dade Product Control

Revision:
F) NO CHANGES, THIS SHEET.
SB - 7/31/23

PGT Custom Windows and Doors		PREPARED BY A. LYNN MILLER 1070 TECHNOLOGY DRIVE N. VENICE, FL 34275 (941) 480-1600	
1070 TECHNOLOGY DRIVE N. VENICE, FL 34275 (941) 480-1600		REGISTRATION #29296	
CASEMENT PICTURE WINDOW DETAILS - LM		Date	08/08/12
FRAME ASSEMBLY TYPE		Drawn By	J ROSOWSKI
DETAILS			
Series	PW-740	DWG No.	3 OF 11
Sheet			
			MD-PW740-LM
		Rev.	F

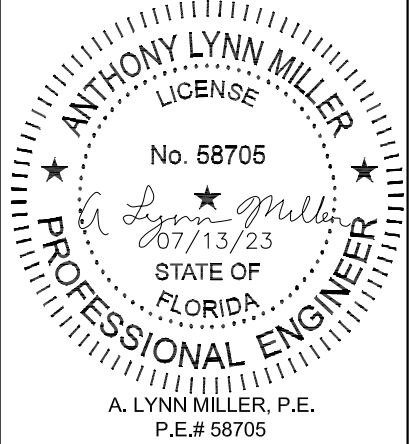



TABLE 2A:

Window Anchors Required (37" and Less on Short Side Dimension)																																		
Anchor Type			Short Side																								37"							
			under 23"				25-15/16"				27-3/4"				29"				31-1/2"				33-1/2"							34"				
			A	B	C	D	A	B	C	D	A	B	C	D	A	B	C	D	A	B	C	D	A	B	C	D	A	B	C	D				
Long Side	under 23"	Long Side	2	2	2	2																												
		Short Side	2	2	2	2																												
	25-15/16"	Long Side	3	2	2	2	3	2	2	2																								
		Short Side	2	2	2	2	3	2	2	2																								
	35"	Long Side	4	3	3	3	5	3	3	3	5	3	3	3	5	3	3	3	5	3	3	3	5	3	3	3	5	3	3	3				
		Short Side	2	2	2	2	3	2	2	2	3	2	2	2	4	2	2	2	4	3	3	3	5	3	3	3	5	3	3	3				
	37"	Long Side	5	3	3	3	5	3	3	3	5	3	3	3	5	3	3	3	5	4	3	3	5	4	3	3	5	4	3	3	5	4	3	3
		Short Side	2	2	2	2	3	2	2	2	3	2	2	2	4	2	2	2	4	3	3	3	5	3	3	3	5	3	3	3	5	4	3	3
	44"	Long Side	6	4	3	3	6	4	3	3	6	4	4	3	7	4	4	3	7	4	4	3	7	5	4	3	7	5	4	3	7	5	4	3
		Short Side	2	2	2	2	3	2	2	2	3	2	2	2	4	2	2	2	4	3	3	3	5	3	3	3	5	3	3	3	5	4	3	3
	44-1/4"	Long Side	6	4	3	3	6	4	4	3	7	4	4	3	7	4	4	3	7	4	4	3	7	5	4	3	7	5	4	3	7	5	4	3
		Short Side	2	2	2	2	3	2	2	2	3	2	2	2	4	2	2	2	4	3	3	3	5	3	3	3	5	3	3	3	5	4	3	3
	53-1/8"	Long Side	7	5	4	3	8	5	4	3	8	5	5	3	8	5	5	3	9	6	5	3	9	6	5	3	9	6	5	3	10	6	5	3
		Short Side	2	2	2	2	3	2	2	2	3	2	2	2	4	2	2	2	4	3	3	3	5	3	3	3	5	3	3	3	5	4	3	3
	58"	Long Side	8	5	4	4	9	6	5	4	9	6	5	4	10	6	5	4	10	6	5	4	10	7	6	4	10	7	6	4	11	7	6	4
		Short Side	2	2	2	2	3	2	2	2	3	2	2	2	4	2	2	2	4	3	3	3	5	3	3	3	5	3	3	3	5	4	3	3
	63"	Long Side	9	6	5	4	10	6	5	4	10	7	6	4	11	7	6	4	11	7	6	4	12	7	6	4	12	7	6	4	12	7	6	4
		Short Side	2	2	2	2	3	2	2	2	3	2	2	2	4	2	2	2	4	3	3	3	5	3	3	3	5	3	3	3	5	4	3	3
74"	Long Side	11	7	6	5	12	8	6	5	12	8	7	5	13	8	7	5	14	9	7	5	14	9	8	5	14	9	8	5	15	10	8	5	
	Short Side	2	2	2	2	3	2	2	2	3	2	2	2	4	2	2	2	4	3	3	3	5	3	3	3	5	3	3	3	5	4	3	3	
76"	Long Side	11	7	6	5	12	8	7	5	13	8	7	5	13	8	7	5	14	9	8	5	15	9	8	5	15	9	8	5	16	10	8	5	
	Short Side	2	2	2	2	3	2	2	2	3	2	2	2	4	2	2	2	4	3	3	3	5	3	3	3	5	3	3	3	5	4	3	3	
84"	Long Side	12	8	7	5	14	9	7	5	14	9	8	5	15	9	8	5	16	10	8	6	17	11	9	6	17	11	9	6	18	11	10	6	
	Short Side	2	2	2	2	3	2	2	2	3	2	2	2	4	2	2	2	4	3	3	3	5	3	3	3	5	3	3	3	5	4	3	3	
114"	Long Side	17	11	9	7	19	12	10	7	20	13	11	7	21	13	11	7	23	14	12	8	24	15	13	8	24	15	13	8	26	16	14	9	
	Short Side	2	2	2	2	3	2	2	2	3	2	2	2	4	2	2	2	4	3	3	3	5	3	3	3	5	3	3	3	5	4	3	3	
134"	Long Side	21	13	11	8	23	14	12	8	24	15	13	8	25	16	13	9	27	17	14	9	29	18	15	10	29	18	15	10					
	Short Side	2	2	2	2	3	2	2	2	3	2	2	2	4	2	2	2	4	3	3	3	5	3	3	3	5	3	3	3					
145"	Long Side	22	14	12	9	25	16	13	9	26	17	14	9	28	17	15	9	29	19	16	10													
	Short Side	2	2	2	2	3	2	2	2	3	2	2	2	4	2	2	2	4	3	3	3													


1) USE THIS TABLE FOR ALL WINDOWS PER THE ELEVATIONS ON SHEET 1. DIMENSIONS SHOWN ARE TIP-TO-TIP.

2) FOR SIZES NOT SHOWN, ROUND UP TO THE NEXT AVAILABLE SHORT OR LONG SIDE DIMENSION SHOWN ON THE TABLE.

3) TABLE DIMENSIONS MAY BE ORIENTED VERTICALLY OR HORIZONTALLY AS SHOWN:

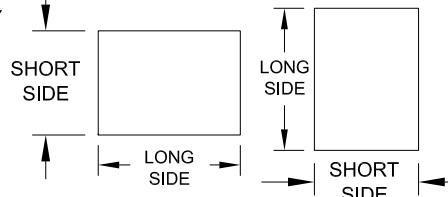

SAMPLE CONFIGURATIONS:

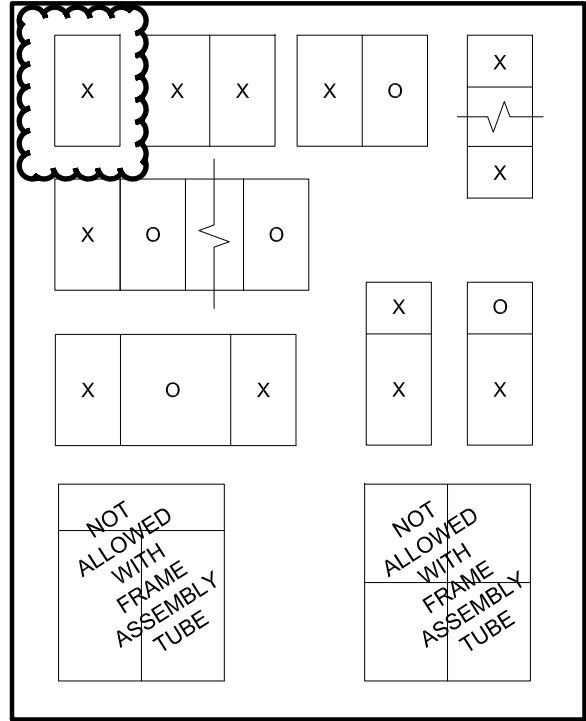

1) OPERABLE
(X) WINDOWS
MAY BE
CASEMENT
WINDOWS
OR AWNING
WINDOWS OF
THE SAME
SERIES.

TABLE 3:

Group	Anchor	Substrate	Min. Edge Distance	Min. O.C. Distance	Min. Embedment	Anchor Plate Required?
A	#12 steel SMS (G5) or #14 steel SMS (G5) or #14 410 SS SMS	S. Pine	5/8"	1"	1-3/8"	No
		6063-T5 Alum.	3/8"	5/8"	.063"	No
		A36 Steel	3/8"	5/8"	.050"	No
		A653 Stud, Gr. 33	3/8"	5/8"	.045", 20 Ga.	No
	1/4" steel Ultracon+	3k Concrete	1"	3"	1-3/4"	No
		Hollow Block	1"	3"	1-1/4"	No
B	1/4" steel Ultracon	S. Pine	1"	1"	1-3/8"	No
		2.85k Concrete	2-1/2"	4"	1-3/8"	No
		Hollow Block	1"	6"	1-1/4"	No
		Hollow Block	2-1/2"	5"	1-1/4"	No
C	1/4" steel Ultracon	Hollow Block	1"	6"	1-1/4"	Yes
	1/4" steel Ultracon+	3k Concrete	1"	4"	1-3/8"	Yes
		Hollow Block	1"	3"	1-1/4"	Yes
	1/4" 410 SS CreteFlex	3.35k Concrete	1"	5"	1-3/4"	No
		Hollow Block	2-1/2"	5"	1-1/4"	No

TABLE 3: (cont.)

Group	Anchor	Substrate	Min. Edge Distance	Min. O.C. Distance	Min. Embedment	Anchor Plate Required?
D	#12 steel SMS (G5) or #12 410 SS SMS or #14 steel SMS (G5) or #14 410 SS SMS	S. Pine	5/8"	1"	1-3/8"	Yes
		6063-T5 Alum.	3/8"	5/8"	.0713"	Yes
		A36 Steel	3/8"	5/8"	.050"	Yes
		A653 Stud, Gr. 33	3/8"	5/8"	.045", 18 Ga.	Yes
	1/4" steel Ultracon	2.85k Concrete	1"	4"	1-3/4"	Yes
		2.85k Concrete	2-1/2"	4"	1-3/8"	Yes
		Hollow Block	2-1/2"	5"	1-1/4"	Yes
		Filled Block	2-1/2"	4"	1-3/4"	Yes
	1/4" 410 SS CreteFlex	3.35k Concrete	1"	6"	1-3/4"	Yes
		3.35k Concrete	2-1/2"	6"	1"	Yes
		Hollow Block	2-1/2"	6"	1-1/4"	Yes
	5/16" steel Ultracon	3.5k Concrete	1-1/4"	5"	1-3/4"	No
		Hollow Block	3-1/8"	5"	1-1/4"	No
		Filled Block	2-1/2"	5"	1-3/4"	No
	1/4" steel Ultracon+	3k Concrete	1-5/16"	4"	1-3/8"	Yes
		Hollow Block	1-3/4"	3"	1-1/4"	Yes
		S. Pine	1"	1"	1-3/8"	Yes

1) WHERE SUBSTRATE CONDITIONS REQUIRE ANCHORAGE FROM MORE THAN ONE OF THE ANCHOR GROUPS, CHOOSE THE ANCHOR GROUP OF THE LOWEST LETTER FOR ALL SUBSEQUENT TABLES IN THIS APPROVAL.

2) ANCHOR MUST
EXTEND A MIN. OF 3
THREADS BEYOND
ANY METAL SUBSTRATE.

3) ALL ANCHOR HEAD TYPES ARE ACCEPTABLE.

Material	Min. F_y	Min. F_u
Steel Screw	92 ksi	120 ksi
410 Screw	90 ksi	110 ksi
Elco UltraCon®	155 ksi	177 ksi
1/4" DeWalt UltraCon+®	148 ksi	164 ksi
410 SS Elco/Dewalt CreteFlex®	127.4 ksi	189.7 ksi
6063-T5 Aluminum	16 ksi	22 ksi
A36 Steel	36 ksi	58 ksi
Gr. 33 Steel Stud	33 ksi	45 ksi

PRODUCT REVISED
As complying with the Florida
Building Code
NOA-No. 23-0816.08
Expiration Date: 04/11/2028

By: Manuel Perez
Miami-Dade Product Control

Revision:	F) CHANGE NOTE 3, INCLUDE ALL ANCHOR HEAD TYPES. SB - 7/31/23
-----------	---

		PREPARED BY A. LYNN MILLER 1070 TECHNOLOGY DRIVE N. VENICE, FL 34275 (941) 480-1600		REGISTRATION #29296	
		1070 TECHNOLOGY DRIVE N. VENICE, FL 34275 (941) 480-1600		REGISTRATION #29296	
Custom Windows and Doors		CASEMENT PICTURE WINDOW DETAILS - LM			
1070 TECHNOLOGY DRIVE N. VENICE, FL 34275 (941) 480-1600		ANCHOR TYPE & QUANTITY		J ROSOWSKI	
PW-740		4 OF 11		MD-PW740-LM	
Sheet		DWG		No.	
Series		Desc.		Title	
Date		By		08/08/12	


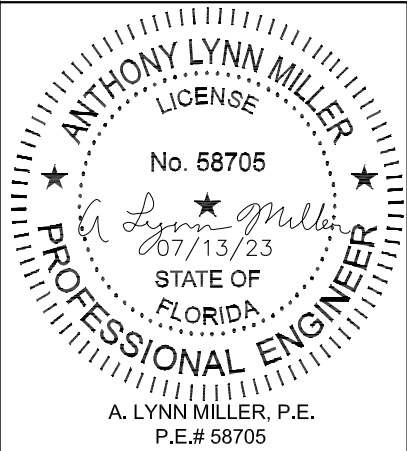



TABLE 2B:

Window Anchors Required (Over 37" on Short Side Dimension)																																						
Anchor Type			Short Side																																			
			40"				44"				48-1/4"				53-1/8"				54"				58"				60"				63"				67-1/2"			
			A	B	C	D	A	B	C	D	A	B	C	D	A	B	C	D	A	B	C	D	A	B	C	D	A	B	C	D	A	B	C	D				
Long Side	under 23"	Long Side																																				
		Short Side																																				
	25-15/16"	Long Side																																				
		Short Side																																				
	35"	Long Side																																				
		Short Side																																				
	37"	Long Side																																				
		Short Side																																				
	44"	Long Side	7	5	4	3	7	5	4	3																												
		Short Side	6	4	3	3	7	5	4	3																												
	44-1/4"	Long Side	7	5	4	3	7	5	4	3																												
		Short Side	6	4	3	3	7	5	4	3																												
	53-1/8"	Long Side	10	6	5	4	10	7	6	4	10	7	6	4	11	7	6	4																				
		Short Side	6	4	3	3	7	5	4	3	9	6	5	3	11	7	6	4																				
	58"	Long Side	11	7	6	4	12	8	6	4	12	8	7	4	12	8	7	4	12	8	7	4																
		Short Side	6	4	3	3	7	5	4	3	9	6	5	3	11	7	6	4	13	8	7	4																
	63"	Long Side	13	8	7	5	13	9	7	5	14	9	7	5	14	9	8	5	14	9	8	5	15	9	8	5	15	9	8	5	15	9	8	5				
		Short Side	6	4	3	3	7	5	4	3	9	6	5	3	11	7	6	4	11	7	6	4	13	8	7	4	13	9	7	5	15	9	8	5				
	66-13/16"	Long Side	14	9	7	5	15	9	8	5	15	10	8	5	16	10	8	5	16	10	8	5	16	10	8	5	16	10	8	5	16	10	8	5				
		Short Side	6	4	3	3	7	5	4	3	9	6	5	3	10	7	6	4	11	7	6	4	12	8	7	4	13	8	7	5	14	9	8	5				
67-1/2"	Long Side	14	9	8	5	15	9	8	5	15	10	8	5	16	10	8	6	16	10	8	6	16	10	8	6	16	10	8	6	16	10	8	6					
	Short Side	6	4	3	3	7	5	4	3	9	6	5	3	10	7	6	4	11	7	6	4	12	8	7	4	13	8	7	5	14	9	7	5					
68"	Long Side	14	9	8	5	15	10	8	5	16	10	8	5	16	10	9	6	16	10	9	6	16	10	9	6	16	10	9	6	16	10	9	6					
	Short Side	6	4	3	3	7	5	4	3	9	6	5	3	10	7	6	4	11	7	6	4	12	8	6	4	13	8	7	4	14	9	7	5					
70"	Long Side	15	9	8	5	16	10	8	5	16	10	9	6	16	10	9	6	16	10	9	6	16	10	9	6	16	10	9	6	16	10	9	6					
	Short Side	6	4	3	3	7	5	4	3	9	6	5	3	10	7	6	4	10	7	6	4	12	7	6	4	12	8	7	4	13	9	7	5					
72"	Long Side	15	10	8	5	16	10	9	6	17	11	9	6	17	11	9	6	17	11	9	6	17	11	9	6	17	11	9	6	17	11	9	6					
	Short Side	6	4	3	3	7	5	4	3	9	6	5	3	10	6	5	4	10	7	6	4	12	7	6	4	12	8	7	4	13	8	7	5					
74"	Long Side	16	10	9	6	17	11	9	6	17	11	9	6	17	11	9	6	17	11	9	6	17	11	9	6	17	11	9	6	PRODUCT REVISED As complying with the Florida Building Code NOA-No. 23-0816.08 Expiration Date: 04/11/2028								
	Short Side	6	4	3	3	7	5	4	3	9	6	5	3	10	6	5	4	10	7	6	4	11	7	6	4	12	8	6	4									
76"	Long Side	16	10	9	6	17	11	9	6	18	11	9	6	18	11	9	6	18	11	9	6	18	11	9	6	18	11	9	6					PRODUCT REVISED As complying with the Florida Building Code NOA-No. 23-0816.08 Expiration Date: 04/11/2028				
	Short Side	6	4	3	3	7	5	4	3	9	5	5	3	10	6	5	4	10	6	5	4	11	7	6	4	12	8	6	4									
84"	Long Side	19	12	10	6	20	12	10	7	20	12	10	7	20	12	10	7	20	12	10	7	PRODUCT REVISED As complying with the Florida Building Code NOA-No. 23-0816.08 Expiration Date: 04/11/2028																
	Short Side	6	4	3	3	7	5	4	3	8	5	4	3	9	6	5	3	10	6	5	3																	
114"	Long Side	26	17	14	9																																	
	Short Side	6	4	3	3																																	

- 1) USE THIS TABLE FOR ALL WINDOWS PER THE ELEVATIONS ON SHEET 1. DIMENSIONS SHOWN ARE TIP-TO-TIP.
- 2) FOR SIZES NOT SHOWN, ROUND UP TO THE NEXT AVAILABLE SHORT OR LONG SIDE DIMENSION SHOWN ON THE TABLE.
- 3) TABLE DIMENSIONS MAY BE ORIENTED VERTICALLY OR HORIZONTALLY AS SHOWN:

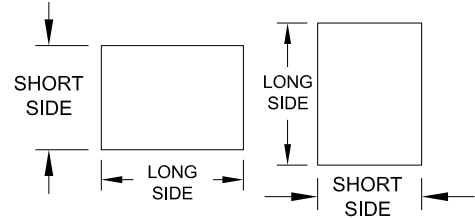

EXAMPLE 1: FOR WINDOW COMBINATION SHOWN BELOW; 7/16" L LAMINATED GLASS, 1/4" MASONRY ANCHORS INTO CONCRETE, +70/-90.

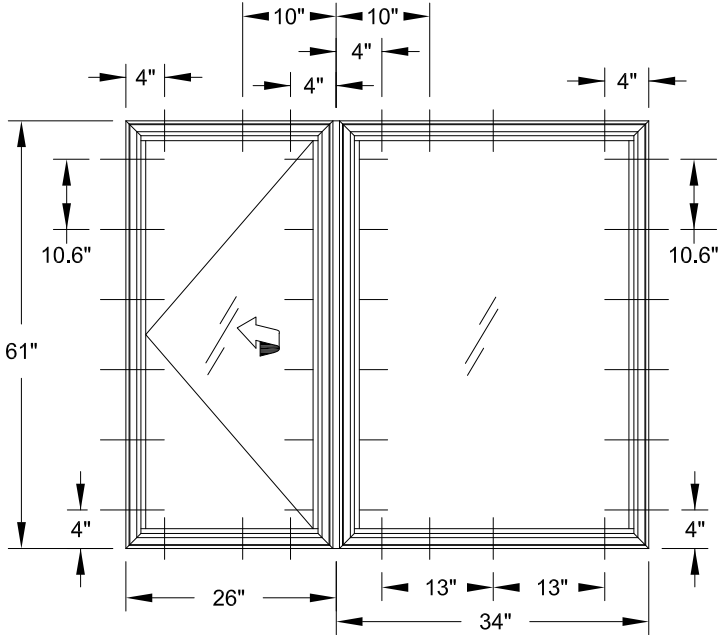

CASEMENT ANCHORS (SEE SEPERATE NOA):

- A) FROM TABLE 12, ANCHORS C & D ALLOW A DP OF +70/-90.
- B) FOR THE JAMB, FROM TABLE 3, ANCHOR TYPE C HAS THE ANCHOR AND SUBSTRATE DESIRED AND DOES NOT REQUIRE THE ANCHOR PLATE IF USING THE CRETEFLEX ANCHOR.
- C) FROM TABLE 2, 6 ANCHORS ARE REQUIRED IN EACH JAMB.
- D) SIMILARLY, 2 ANCHORS ARE REQUIRED IN THE HEAD & SILL.
- E) DISTRIBUTE ANCHORS FOLLOWING GUIDELINES FROM ELEVATION ON SHEET 1.
- F) PER RULES ON SHEETS 2 & 3, INSTALL 1 ADDITIONAL ANCHOR ON THE FRAME ASSEMBLY TUBE SIDE OF THE AWNING (HEAD & SILL).


CASEMENT PICTURE WINDOW ANCHORS:

- A) FROM TABLE 11, A 34" X 61" CASEMENT PICTURE WINDOW HAS A DESIGN PRESSURE OF +70/-90 USING ANCHORS C OR D.
- B) FOR THE JAMB, FROM TABLE 3, ANCHOR TYPE C HAS THE ANCHOR AND SUBSTRATE DESIRED AND DOES NOT REQUIRE THE ANCHOR PLATE IF USING THE CRETEFLEX ANCHOR.
- C) FROM TABLE 2A, 6 ANCHORS ARE REQUIRED IN EACH JAMB.
- D) SIMILARLY, 3 ANCHORS ARE REQUIRED IN THE HEAD & SILL.
- E) DISTRIBUTE ANCHORS FOLLOWING GUIDELINES FROM ELEVATION ON SHEET 1.
- F) PER RULES ON SHEET 2, INSTALL 1 ADDITIONAL ANCHOR ON THE FRAME ASSEMBLY TUBE SIDE OF THE CASEMENT PICTURE (HEAD & SILL).

PRODUCT REVISED
As complying with the Florida Building Code
NOA-No. 23-0816.08
Expiration Date: 04/11/2028
By: Manuel Perez
Miami-Dade Product Control

Revision:
F) NO CHANGES, THIS SHEET.
SB - 7/31/23

PREPARED BY A. LYNN MILLER 1070 TECHNOLOGY DRIVE N. VENICE, FL 34275 (941) 480-1600	REGISTRATION #29296	08/08/12	J ROSOWSKI	MD-PW740-LM	F
PGT Custom Windows and Doors 1070 TECHNOLOGY DRIVE N. VENICE, FL 34275 (941) 480-1600	CASEMENT PICTURE WINDOW DETAILS - LM	ANCHOR TYPE & QUANTITY	PW-740	5 OF 11	Sheet


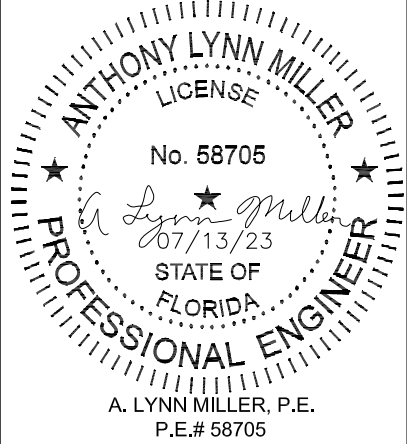


FOR GLASS TYPES:
1) 5/16" LAMI (1/8 AN - .090" PVB - 1/8 AN)

"PVB"= TROSIFOL® PVB INTERLAYER BY KURARAY AMERICA, INC.

TABLE 4:

Design Pressure (psf) for Single Windows, All Anchor Groups								
Long Side	Short Side							
	under 23"	25-15/16"	27-3/4"	33-1/2"	37"	44"	48-1/4"	53-1/8"
	under 23"	+70/-90						
	25-15/16"	+70/-90	+70/-90					
	37"	+70/-90	+70/-90	+70/-90	+70/-90			
	44"	+70/-90	+70/-90	+70/-90	+70/-90	+70/-90		
	48-1/4"	+70/-90	+70/-90	+70/-90	+70/-90	+70/-84.1	+70/-80.1	
	53-1/8"	+70/-90	+70/-90	+70/-90	+70/-90	+70/-84.1	+60/-70	+60/-67.5
	58"	+70/-90	+70/-90	+70/-90	+70/-83.2	+70/-77	+60/-67.8	+60/-63.2
	63"	+70/-90	+70/-90	+70/-90	+70/-76.5	+70/-70.1	+60/-61.3	
	76"	+70/-90	+70/-84.6	+70/-75.7	+/-58.9	+/-55.6		
	84"	+70/-90	+70/-80.4	+70/-71.3	+/-54.2			

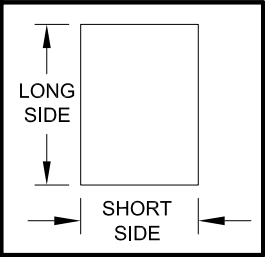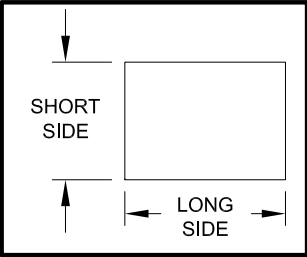


1) SEE SHEETS 1, 4 & 5 FOR WINDOW ANCHOR LOCATIONS AND QUANTITIES.
2) TABLE DIMENSIONS MAY BE ORIENTED VERTICALLY OR HORIZONTALLY AS SHOWN.

TABLE 5:


Design Pressure (psf) for Windows Attached to a Frame Assembly Tube																													
Window Dimension "B"	Window Dimension "A"																												
	under 23"	25-15/16"	27-3/4"	33-1/2"			37"			44"				48-1/4"				53-1/8"				58"				63"			
	Anchor Group	Anchor Group	Anchor Group	Anchor Group			Anchor Group			Anchor Group				Anchor Group				Anchor Group				Anchor Group				Anchor Group			
	All	All	All	A	B	C & D	A	B	C & D	A	B	C	D	A	B	C	D	A	B	C	D	A	B	C	D	A	B	C	D
	under 23"	+70/-90	+70/-90	+70/-90	+70/-90	+70/-87.6	+70/-90	+70/-79.2	+70/-90	+70/-83.1	+/-66.6	+70/-79.7	+70/-90	+70/-75.8	+/-60.7	+70/-72.7	+70/-90	+/-69	+/-55.3	+/-66.1	+70/-90	+/-63.1	+/-50.5	+/-60.5	+70/-90	+/-58.1	+/-46.5	+/-55.7	+70/-88.7
25-15/16"	+70/-90	+70/-90	+70/-90	+70/-90	+70/-90	+70/-90	+70/-87.6	+70/-90	+70/-90	+70/-73.7	+70/-90	+70/-90	+70/-90	+/-67.1	+70/-90	+70/-90	+70/-90	+/-61.1	+70/-90	+70/-90	+70/-90	+/-55.9	+70/-89.6	+70/-90	+70/-90	+/-51.5	+70/-82.5	+70/-90	+70/-90
37"	+70/-90	+70/-90	+70/-90	+70/-84.9	+70/-90	+70/-90	+70/-76.8	+70/-90	+70/-90	+/-64.6	+70/-90	+70/-90	+70/-90	+/-58.8	+70/-90	+70/-90	+70/-90	+/-53.6	+70/-84.1	+70/-84.1	+70/-84.1	+/-49	+70/-77	+70/-77	+70/-77	+/-45.1	+70/-70.1	+70/-70.1	+70/-70.1
44"	+70/-90	+70/-90	+70/-90	+70/-85.6	+70/-90	+70/-90	+70/-90	+70/-90	+70/-90	+70/-76	+70/-87	+70/-90	+70/-90	+/-59.4	+70/-79.3	+70/-84.1	+70/-84.1	+/-54.1	+70/-72.2	+70/-75.7	+70/-75.7	+/-49.4	+/-66	+67/-67.8	+67/-67.8	+/-37.9	+/-60.8	+/-61.3	+/-61.3
48-1/4"	+70/-90	+70/-90	+70/-90	+70/-90	+70/-90	+70/-90	+70/-82.4	+70/-90	+70/-90	+/-69.3	+70/-79.3	+70/-84.1	+70/-84.1	+/-63.1	+70/-72.3	+70/-80.1	+70/-80.1	+/-49.3	+/-65.8	+69.6/-71.6	+69.6/-71.6	+/-45	+/-60.2	+/-63.2	+/-63.2				
53-1/8"	+70/-90	+70/-90	+70/-90	+70/-90	+70/-90	+70/-90	+70/-84.1	+70/-84.1	+70/-84.1	+/-63.1	+70/-75.7	+70/-75.7	+70/-75.7	+/-57.5	+/-65.8	+69.6/-71.6	+69.6/-71.6	+/-52.3	+/-59.9	+/-67.5	+/-67.5								
58"	+70/-90	+70/-90	+70/-90	+70/-83.2	+70/-83.2	+70/-83.2	+70/-77	+70/-77	+70/-77	+/-65.9	+67/-67.8	+67/-67.8	+67/-67.8	+/-52.6	+/-63.2	+/-63.2	+/-63.2												
63"	+70/-90	+70/-90	+70/-90	+70/-76.5	+70/-76.5	+70/-76.5	+70/-70.1	+70/-70.1	+70/-70.1	+/-60.7	+/-61.3	+/-61.3	+/-61.3																
76"	+70/-90	+70/-84.6	+70/-75.7	+/-58.9	+/-58.9	+/-58.9	+/-55.6	+/-55.6	+/-55.6																				
84"	+70/-90	+70/-80.4	+70/-71.3	+/-54.2	+/-54.2	+/-54.2																							

FIGURE FOR VERTICAL FRAME ASSEMBLY TUBE

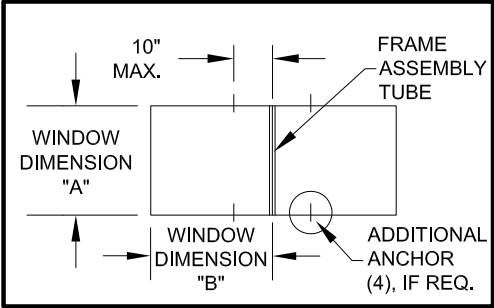

SEE SHEETS 1, 4 & 5 FOR WINDOW ANCHOR LOCATIONS AND QUANTITIES. SEE SHEET 3 FOR ANY ADDITIONAL ANCHORS REQUIRED FOR THE FRAME ASSEMBLY TUBE.

FIGURE FOR HORIZONTAL FRAME ASSEMBLY TUBE

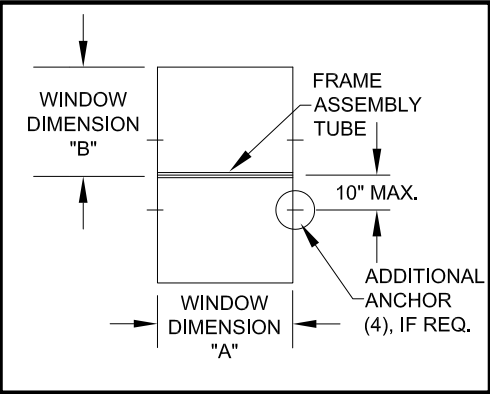

SEE SHEETS 1, 4 & 5 FOR WINDOW ANCHOR LOCATIONS AND QUANTITIES. SEE SHEET 3 FOR ANY ADDITIONAL ANCHORS REQUIRED FOR THE FRAME ASSEMBLY TUBE.

PRODUCT REVISED
As complying with the Florida Building Code
NOA-No. **23-0816.08**
Expiration Date: **04/11/2028**
By: *Manuel Perez*
Miami-Dade Product Control

F) NO CHANGES, THIS SHEET.
SB - 7/31/23

PREPARED BY A. LYNN MILLER
1070 TECHNOLOGY DRIVE
N. VENICE, FL 34275
(941) 480-1600

Custom Windows and Doors
1070 TECHNOLOGY DRIVE
N. VENICE, FL 34275
(941) 480-1600

REGISTRATION #29296

CASEMENT PICTURE WINDOW DETAILS - LM 08/08/12

DESIGN PRESSURE PER
GLAZING TYPE


J ROSOWSKI

MD-PW740-LM

6 OF 11

PW-740

F

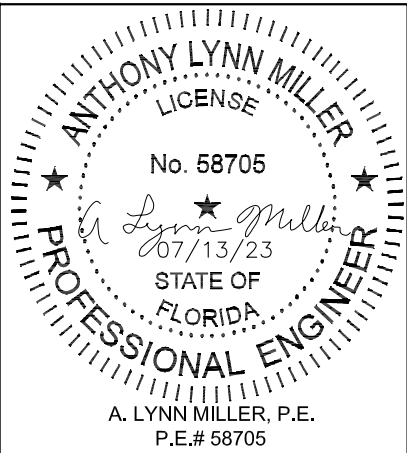



FOR GLASS TYPES:

5) 7/8" LAMI. IG:(1/8" T - 7/16" AIR - 1/8" AN - .090" PVB - 1/8" AN)

"PVB"= TROSIFOL PVB INTERLAYER BY KURARAY AMERICA, INC.

TABLE 6:

		Design Pressure (psf) for Single Windows, All Anchor Groups						
		Short Side						
		under 23"	25-15/16"	27-3/4"	33-1/2"	37"	44"	48-1/4"
Long Side	under 23"	+70/-90						
	25-15/16"	+70/-90	+70/-90					
	37"	+70/-90	+70/-90	+70/-90	+70/-90	+70/-90		
	44"	+70/-90	+70/-90	+70/-90	+70/-90	+70/-90	+70/-90	
	48-1/4"	+70/-90	+70/-90	+70/-90	+70/-90	+70/-90	+70/-90	+70/-90
	53-1/8"	+70/-90	+70/-90	+70/-90	+70/-90	+70/-90		
	58"	+70/-90	+70/-90	+70/-90	+70/-90	+70/-87.8		
	63"	+70/-90	+70/-90	+70/-90	+70/-87.2	+70/-79.9		
	76"	+70/-90	+70/-90	+70/-86.3				
	84"	+70/-90	+70/-90	+70/-81.3				

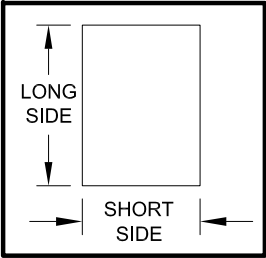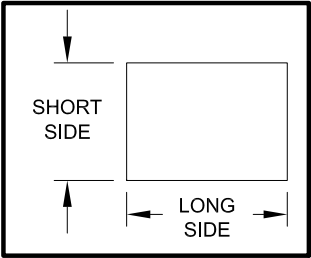


1) SEE SHEETS 1, 4 & 5 FOR WINDOW ANCHOR LOCATIONS AND QUANTITIES.
2) TABLE DIMENSIONS MAY BE ORIENTED VERTICALLY OR HORIZONTALLY AS SHOWN.

TABLE 7:


		Design Pressure (psf) for Windows Attached to a Frame Assembly Tube																																
		Window Dimension "A"																																
		under 23"	25-15/16"	27-3/4"	33-1/2"			37"			44"				48-1/4"				53-1/8"				58"				63"							
		Anchor Group	Anchor Group	Anchor Group	Anchor Group			Anchor Group			Anchor Group				Anchor Group				Anchor Group				Anchor Group											
		All	All	All	A	B	C & D	A	B	C & D	A	B	C	D	A	B	C	D	A	B	C	D	A	B	C	D	A	B	C	D				
Window Dimension "B"	under 23"	+70/-90	+70/-90	+70/-90	+70/-90	+70/-87.6	+70/-90	+70/-90	+70/-79.2	+70/-90	+70/-83.1	+/-66.6	+70/-79.7	+70/-90	+70/-75.8	+/-60.7	+70/-72.7	+70/-90	+/-69	+/-55.3	+/-66.1	+70/-90	+/-63.1	+/-50.5	+/-60.5	+70/-90	+/-58.1	+/-46.5	+/-55.7	+70/-88.7				
	25-15/16"	+70/-90	+70/-90	+70/-90	+70/-90	+70/-90	+70/-90	+70/-87.6	+70/-90	+70/-90	+70/-73.7	+70/-90	+70/-90	+70/-90	+/-67.1	+70/-90	+70/-90	+70/-90	+/-61.1	+70/-90	+70/-90	+70/-90	+/-55.9	+70/-89.6	+70/-90	+70/-90	+/-51.5	+70/-82.5	+70/-90	+70/-90				
	37"	+70/-90	+70/-90	+70/-90	+70/-90	+70/-84.9	+70/-90	+70/-90	+70/-90	+70/-76.8	+70/-90	+70/-90	+70/-90	+70/-90	+/-64.6	+70/-90	+70/-90	+70/-90	+/-58.8	+70/-90	+70/-90	+70/-90	+/-53.6	+70/-85.9	+70/-90	+70/-90	+/-49	+70/-78.5	+70/-87.8	+70/-87.8	+/-45.1	+70/-72.3	+70/-79.9	+70/-79.9
	44"	+70/-90	+70/-90	+70/-90	+70/-85.6	+70/-90	+70/-90	+70/-90	+70/-90	+70/-90	+70/-76	+70/-87	+70/-90	+70/-90	+/-69.3	+70/-79.3	+70/-90	+70/-90																
	48-1/4"	+70/-90	+70/-90	+70/-90	+70/-90	+70/-90	+70/-90	+70/-82.4	+70/-90	+70/-90	+/-69.3	+70/-90	+70/-90	+70/-90	+/-63.1	+70/-86.7	+70/-86.5	+70/-90																
	53-1/8"	+70/-90	+70/-90	+70/-90	+70/-90	+70/-90	+70/-90	+70/-90	+70/-85.7	+70/-90	+70/-90																							
	58"	+70/-90	+70/-90	+70/-90	+70/-86.6	+70/-90	+70/-90	+70/-87.8	+70/-87.8	+70/-87.8																								
	63"	+70/-90	+70/-90	+70/-90	+70/-87.2	+70/-87.2	+70/-87.2	+70/-79.9	+70/-79.9	+70/-79.9																								
	76"	+70/-90	+70/-90	+70/-90	+70/-86.3																													
84"	+70/-90	+70/-90	+70/-81.3																															

FIGURE FOR VERTICAL FRAME ASSEMBLY TUBE

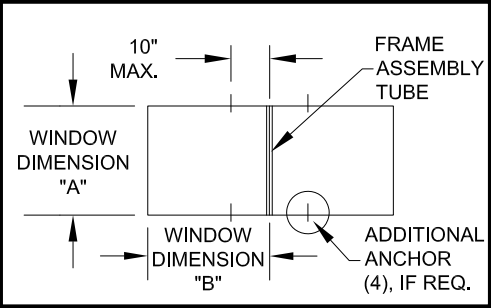

SEE SHEETS 1, 4 & 5 FOR WINDOW ANCHOR LOCATIONS AND QUANTITIES. SEE SHEET 3 FOR ANY ADDITIONAL ANCHORS REQUIRED FOR THE FRAME ASSEMBLY TUBE.

FIGURE FOR HORIZONTAL FRAME ASSEMBLY TUBE

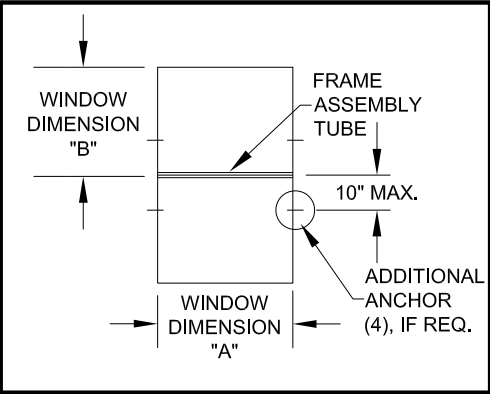

SEE SHEETS 1, 4 & 5 FOR WINDOW ANCHOR LOCATIONS AND QUANTITIES. SEE SHEET 3 FOR ANY ADDITIONAL ANCHORS REQUIRED FOR THE FRAME ASSEMBLY TUBE.

PRODUCT REVISED
As complying with the Florida Building Code
NOA-No. 23-0816.08
Expiration Date: 04/11/2028
By: Manuel Perez
Miami-Dade Product Control

F) NO CHANGES, THIS SHEET.
SB - 7/31/23

PREPARED BY A. LYNN MILLER
1070 TECHNOLOGY DRIVE
N. VENICE, FL 34275
(941) 480-1600

REGISTRATION #29296

CASEMENT PICTURE WINDOW DETAILS - LM 08/08/12


DESIGN PRESSURE PER
GLAZING TYPE

PW-740

7 OF 11

MD-PW740-LM

F

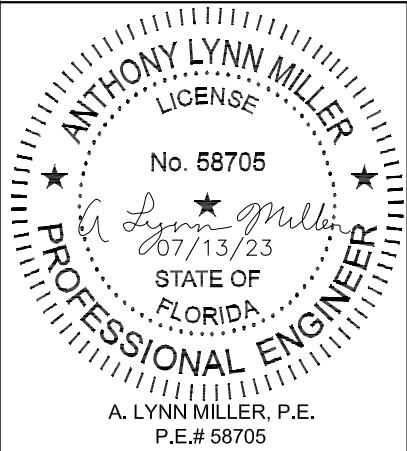



FOR GLASS TYPES:

- 2) 7/16" LAMI. (3/16" AN - .090" SG - 3/16" AN
- 6) 7/8" LAMI. IG: (3/16" AN - 1/4" AIR - 3/16" AN - .090" SG - 3/16" AN)
- 8) 7/8" LAMI. IG: (3/16" T - 1/4" AIR - 3/16" AN - .090" SG - 3/16" AN)

"SG"= SENTRYGLAS®INTERLAYER BY KURARAY AMERICA, INC.

TABLE 8:

Design Pressure (psf) for Single Windows, All Anchor Groups										
Long Side	Short Side									
	under 23"	25-15/16"	29"	31-1/2"	34"	40"	54"	60"	63"	67-1/2"
	under 23"	+90/-130								
	25-15/16"	+90/-130	+90/-130							
	63"	+90/-130	+90/-130	+90/-123.1	+90/-116.5	+90/-110.7	+/- 89.1	+/- 86.1	+/- 83.1	
	67-1/2"	+90/-130	+90/-130	+90/-120.7	+90/-113.9	+90/-108	+/- 84.8	+/- 80.5	+/- 78.3	+/- 75.1
	72"	+90/-130	+90/-129.2	+90/-118.7	+90/-111.8	+90/-105.8	+/- 81.3	+/- 76.1	+/- 73.8	
	76"	+90/-130	+90/-127.8	+90/-117.1	+90/-110.2	+90/-104.1	+/- 78	+/- 72.5		
	84"	+90/-130	+90/-125.3	+90/-114.5	+90/-107.5	+90/-101.3	+/- 89.9	+/- 70.7		
	114"	+90/-130	+90/-119.6	+90/-108.6	+90/-101.4	+90/-95	+/- 73			
	134"	+90/-130	+90/-117.3	+90/-106.3	+90/-99	+90/-92.6				
	145"	+90/-129.8	+90/-116.4	+90/-105.3	+90/-98					

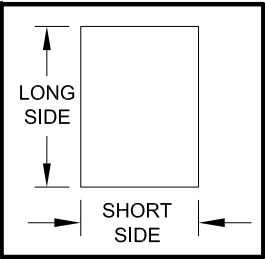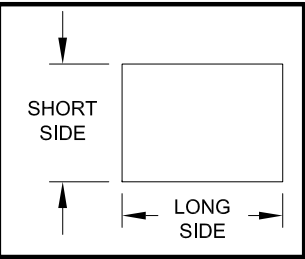


- 1) SEE SHEETS 1, 4 & 5 FOR WINDOW ANCHOR LOCATIONS AND QUANTITIES.
- 2) TABLE DIMENSIONS MAY BE ORIENTED VERTICALLY OR HORIZONTALLY AS SHOWN.

TABLE 9:


		Design Pressure (psf) for Windows Attached to a Frame Assembly Tube																							
		Window Dimension "A"																							
		under 23"	25-15/16"	29"	31-1/2"	34"			40"				54"				60"				63"				
		Anchor Group	Anchor Group	Anchor Group	Anchor Group	Anchor Group			Anchor Group				Anchor Group				Anchor Group				Anchor Group				
		All	All	All	All	A	B	C & D	A	B	C	D	A	B	C	D	A	B	C	D	A	B	C	D	
Window Dimension "B"	under 23"	+70/-90	+70/-90	+70/-90	+70/-90	+70/-90	+70/-86.2	+70/-90	+70/-90	+70/-73.3	+70/-87.7	+70/-90	+/-67.7	+/-54.3	+/-65	+70/-90	+/-61	+/-48.9	+/-58.5	+70/-90	+/-58.1	+/-46.5	+/-55.7	+70/-88.7	
	25-15/16"	+70/-90	+70/-90	+70/-90	+70/-90	+70/-90	+70/-90	+70/-90	+70/-90	+70/-90	+70/-90	+70/-90	+70/-75.1	+70/-90	+70/-90	+70/-90	+/-67.5	+70/-86.6	+70/-90	+70/-90	+/-64.3	+70/-82.5	+70/-90	+70/-90	
	63"	+70/-90	+70/-90	+70/-90	+70/-90	+70/-90	+70/-90	+70/-90	+70/-90	+70/-90	+70/-90	+70/-90	+/-68	+70/-79.2	+70/-83	+70/-89.1	+/-61.2	+70/-71.3	+70/-74.7	+70/-86.1	+/-53	+/-59.4	+70/-71.1	+70/-83.1	
	67-1/2"	+70/-90	+70/-90	+70/-90	+70/-90	+70/-90	+70/-90	+70/-90	+70/-85.6	+70/-90	+70/-90	+70/-90	+/-63.4	+70/-73.9	+70/-77.4	+70/-84.8	+/-57.1	+/-66.5	+/-69.7	+70/-80.5	+/-54.4	+/-63.4	+/-66.4	+70/-78.3	
	72"	+70/-90	+70/-90	+70/-90	+70/-90	+70/-90	+70/-90	+70/-90	+70/-87.6	+70/-90	+70/-90	+70/-90	+/-64.9	+/-69.3	+70/-72.6	+70/-81.3	+/-58.4	+/-62.4	+/-65.3	+70/-76.1	+/-51	+/-59.4	+/-62.2	+70/-73.8	
	76"	+70/-90	+70/-90	+70/-90	+70/-90	+70/-90	+70/-90	+70/-90	+70/-83	+70/-90	+70/-90	+70/-90	+/-61.5	+70/-73.9	+70/-78	+70/-78	+/-55.3	+/-59.1	+/-61.9	+70/-72.5					
	84"	+70/-90	+70/-90	+70/-90	+70/-90	+70/-90	+70/-90	+70/-90	+70/-81.3	+70/-89.9	+70/-89.9	+70/-89.9	+/-60.3	+/-66.9	+70/-70.7	+70/-70.7									
	114"	+70/-90	+70/-90	+70/-90	+70/-90	+70/-90	+70/-90	+70/-90	+70/-73	+70/-73	+70/-73	+70/-73													
	134"	+70/-90	+70/-90	+70/-90	+70/-90	+70/-90	+70/-90	+70/-90																	
145"	+70/-90	+70/-90	+70/-90	+70/-90																					

FIGURE FOR VERTICAL FRAME ASSEMBLY TUBE

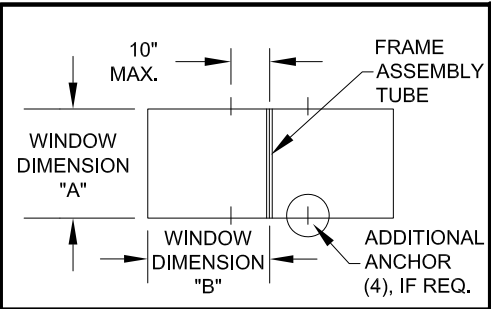

SEE SHEETS 1, 4 & 5 FOR WINDOW ANCHOR LOCATIONS AND QUANTITIES. SEE SHEET 3 FOR ANY ADDITIONAL ANCHORS REQUIRED FOR THE FRAME ASSEMBLY TUBE.

FIGURE FOR HORIZONTAL FRAME ASSEMBLY TUBE

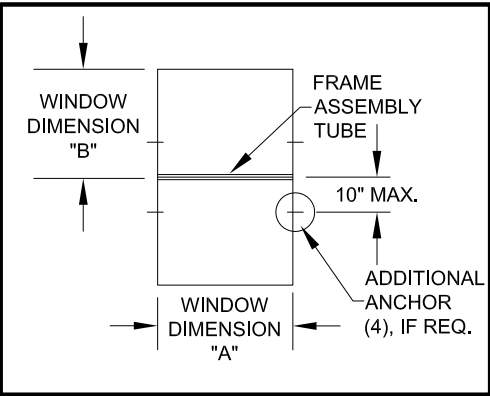

SEE SHEETS 1, 4 & 5 FOR WINDOW ANCHOR LOCATIONS AND QUANTITIES. SEE SHEET 3 FOR ANY ADDITIONAL ANCHORS REQUIRED FOR THE FRAME ASSEMBLY TUBE.

PRODUCT REVISED
As complying with the Florida Building Code
NOA-No. 23-0816.08
Expiration Date: 04/11/2028
By: Manuel Perez
Miami-Dade Product Control

F) NO CHANGES, THIS SHEET.
SB - 7/31/23

PGT Custom Windows and Doors 1070 TECHNOLOGY DRIVE N. VENICE, FL 34275 (941) 480-1600		PREPARED BY A. LYNN MILLER 1070 TECHNOLOGY DRIVE N. VENICE, FL 34275 (941) 480-1600		REGISTRATION #29296			
Title		CASEMENT PICTURE WINDOW DETAILS - LM				Date	08/08/12
Series		DESIGN PRESSURE PER GLAZING TYPE		J ROSOWSKI		By Drawn	
Sheet		PW-740		8 OF 11		DWC No.	
						MD-PW740-LM	
Rev.						F	

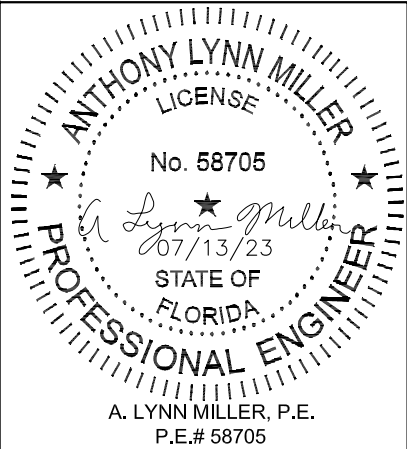


TABLE 10:

		Design Pressure (psf) for Single Windows, All Anchor Groups									
		Short Side									
		under 23"	25-15/16"	29"	31-1/2"	34"	40"	54"	60"	63"	67-1/2"
Long Side	under 23"	+90/-130									
	25-15/16"	+90/-130	+90/-130								
	63"	+90/-130	+90/-130	+90/-130	+90/-130	+90/-130	+90/-130	+90/-130	+90/-130	+90/-130	
	67-1/2"	+90/-130	+90/-130	+90/-130	+90/-130	+90/-130	+90/-130	+90/-130	+90/-130	+90/-130	+90/-130
	72"	+90/-130	+90/-130	+90/-130	+90/-130	+90/-130	+90/-130	+90/-130	+90/-130	+90/-130	
	76"	+90/-130	+90/-130	+90/-130	+90/-130	+90/-130	+90/-130	+90/-130	+90/-130		
	84"	+90/-130	+90/-130	+90/-130	+90/-130	+90/-130	+90/-130	+90/-130			
	114"	+90/-130	+90/-130	+90/-130	+90/-130	+90/-130	+90/-130				
	134"	+90/-130	+90/-130	+90/-130	+90/-130	+90/-130					
	145"	+90/-130	+90/-130	+90/-130	+90/-130						



FOR GLASS TYPES:

3) 7/16" LAMI (3/16 HS - .090" SG - 3/16 HS)

7) 7/8" LAMI IG: 3/16" AN - 1/4" AIR - 3/16" HS - .090" SG - 3/16" HS)

9) 7/8" LAMI IG: (3/16" T - 1/4" AIR - 3/16" HS - .090" SG - 3/16" HS)

"SG"= SENTRYGLAS®INTERLAYER BY KURARAY AMERICA, INC.

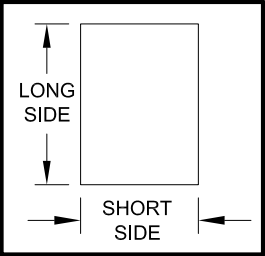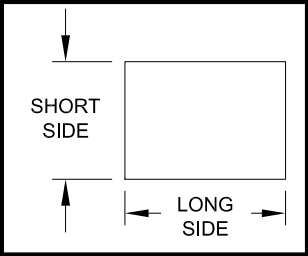


- 1) SEE SHEETS 1, 4 & 5 FOR WINDOW ANCHOR LOCATIONS AND QUANTITIES.
- 2) TABLE DIMENSIONS MAY BE ORIENTED VERTICALLY OR HORIZONTALLY AS SHOWN.

TABLE 11:


		Design Pressure (psf) for Windows Attached to a Frame Assembly Tube																							
		Window Dimension "A"																							
		under 23"	25-15/16"	29"	31-1/2"	34"			40"				54"				60"				63"				
		Anchor Group	Anchor Group	Anchor Group	Anchor Group	Anchor Group			Anchor Group				Anchor Group				Anchor Group				Anchor Group				
		All	All	All	All	A	B	C & D	A	B	C	D	A	B	C	D	A	B	C	D	A	B	C	D	
Window Dimension "B"	under 23"	+70/-90	+70/-90	+70/-90	+70/-90	+70/-90	+70/-86.2	+70/-90	+70/-90	+70/-73.3	+70/-87.7	+70/-90	+/-67.7	+/-54.3	+/-65	+70/-90	+/-61	+/-48.9	+/-58.5	+70/-90	+/-58.1	+/-46.5	+/-55.7	+70/-88.7	
	25-15/16"	+70/-90	+70/-90	+70/-90	+70/-90	+70/-90	+70/-90	+70/-90	+70/-90	+70/-90	+70/-90	+70/-90	+70/-75.1	+70/-90	+70/-90	+70/-90	+/-67.5	+70/-86.6	+70/-90	+70/-90	+/-64.3	+70/-82.5	+70/-90	+70/-90	
	63"	+70/-90	+70/-90	+70/-90	+70/-90	+70/-90	+70/-90	+70/-90	+70/-90	+70/-90	+70/-90	+70/-90	+70/-90	+70/-90	+70/-90	+70/-90	+70/-83.4	+70/-89.1	+70/-90	+70/-90	+70/-79.5	+70/-84.9	+70/-90	+70/-90	
	67-1/2"	+70/-90	+70/-90	+70/-90	+70/-90	+70/-90	+70/-90	+70/-90	+70/-90	+70/-90	+70/-90	+70/-90	+70/-90	+70/-90	+70/-90	+70/-90	+70/-83	+70/-90	+70/-90	+70/-90	+70/-84	+70/-87.1	+70/-90	+70/-90	
	72"	+70/-90	+70/-90	+70/-90	+70/-90	+70/-90	+70/-90	+70/-90	+70/-90	+70/-90	+70/-90	+70/-90	+70/-90	+70/-90	+70/-90	+70/-90	+70/-87.6	+70/-90	+70/-90	+70/-90	+70/-83.4	+70/-89.1	+70/-90	+70/-90	
	76"	+70/-90	+70/-90	+70/-90	+70/-90	+70/-90	+70/-90	+70/-90	+70/-90	+70/-90	+70/-90	+70/-90	+70/-90	+70/-90	+70/-90	+70/-90	+70/-90	+70/-90	+70/-90	+70/-90					
	84"	+70/-90	+70/-90	+70/-90	+70/-90	+70/-90	+70/-90	+70/-90	+70/-90	+70/-90	+70/-90	+70/-90	+70/-90	+70/-90	+70/-90	+70/-90	+70/-90	+70/-90	+70/-90	+70/-90					
	114"	+70/-90	+70/-90	+70/-90	+70/-90	+70/-90	+70/-90	+70/-90	+70/-90	+70/-90	+70/-90	+70/-90	+70/-90												
	134"	+70/-90	+70/-90	+70/-90	+70/-90	+70/-90	+70/-90	+70/-90																	
145"	+70/-90	+70/-90	+70/-90	+70/-90																					

FIGURE FOR VERTICAL FRAME ASSEMBLY TUBE

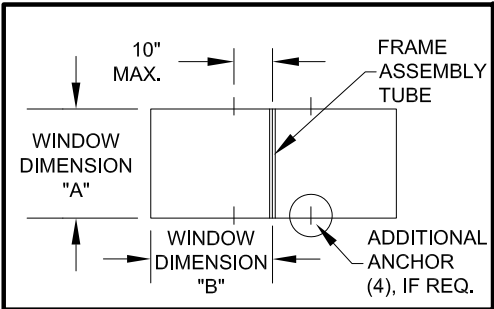

SEE SHEETS 1, 4 & 5 FOR WINDOW ANCHOR LOCATIONS AND QUANTITIES. SEE SHEET 3 FOR ANY ADDITIONAL ANCHORS REQUIRED FOR THE FRAME ASSEMBLY TUBE.

FIGURE FOR HORIZONTAL FRAME ASSEMBLY TUBE

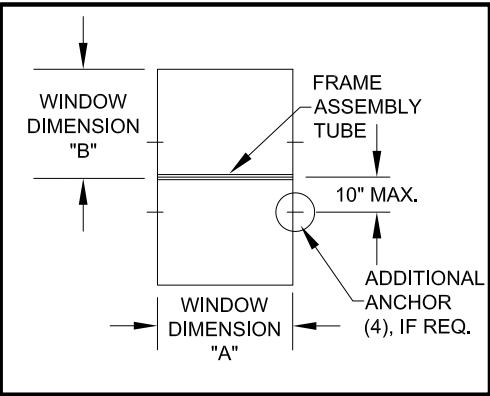

SEE SHEETS 1, 4 & 5 FOR WINDOW ANCHOR LOCATIONS AND QUANTITIES. SEE SHEET 3 FOR ANY ADDITIONAL ANCHORS REQUIRED FOR THE FRAME ASSEMBLY TUBE.

PRODUCT REVISED
As complying with the Florida Building Code
NOA-No. **23-0816.08**
Expiration Date: **04/11/2028**
By: *Manuel Perez*
Miami-Dade Product Control

Revision:

F) NO CHANGES, THIS SHEET.
SB - 7/31/23

PREPARED BY A. LYNN MILLER
1070 TECHNOLOGY DRIVE
N. VENICE, FL 34275
(941) 480-1600

REGISTRATION #29296

CASEMENT PICTURE WINDOW DETAILS - LM 08/08/12

DESIGN PRESSURE PER GLAZING TYPE

J ROSOWSKI

MD-PW740-LM

9 OF 11

PW-740

PGT
Custom Windows and Doors
1070 TECHNOLOGY DRIVE
N. VENICE, FL 34275
(941) 480-1600

ANTHONY LYNN MILLER
LICENSE
No. 58705
07/13/23
STATE OF FLORIDA
PROFESSIONAL ENGINEER
A. LYNN MILLER, P.E.
P.E.# 58705



FOR GLASS TYPES:

4) 7/8" LAMI. IG:(1/8" AN - 7/16" AIR - 1/8" AN - .090" PVB - 1/8" AN)

"PVB"= TROSFOL® PVB INTERLAYER BY KURARAY AMERICA, INC.

TABLE 12:

		Design Pressure (psf) for Single Windows, All Anchor Groups							
		Short Side							
		under 23"	25-15/16"	27-3/4"	33-1/2"	37"	44"	48-1/4"	53-1/8"
Long Side	under 23"	+60/-70							
	25-15/16"	+60/-70	+60/-70						
	37"	+60/-70	+60/-70	+60/-70	+60/-70	+60/-70			
	44"	+60/-70	+60/-70	+60/-70	+60/-70	+60/-70	+60/-70		
	48-1/4"	+60/-70	+60/-70	+60/-70	+60/-70	+60/-70	+60/-70	+60/-70	
	53-1/8"	+60/-70	+60/-70	+60/-70	+60/-70	+60/-70	+60/-70	+60/-70	+60/-69.3
	58"	+60/-70	+60/-70	+60/-70	+60/-70	+60/-70	+60/-69.6	+60/-64.9	
	63"	+60/-70	+60/-70	+60/-70	+60/-70	+60/-70	+60/-62.9		
	76"	+60/-70	+60/-70	+60/-70	+60/-70	+60/-60.5	+/- 57		
	84"	+60/-70	+60/-70	+60/-70	+/- 55.6				

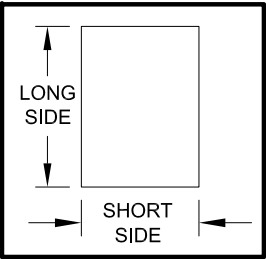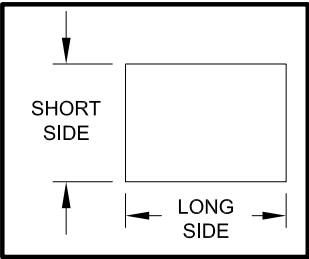


1) SEE SHEETS 1, 4 & 5 FOR WINDOW ANCHOR LOCATIONS AND QUANTITIES.
2) TABLE DIMENSIONS MAY BE ORIENTED VERTICALLY OR HORIZONTALLY AS SHOWN.

TABLE 13:


		Design Pressure (psf) for Windows Attached to a Frame Assembly Tube																							
		Window Dimension "A"																							
		under 23"	25-15/16"	27-3/4"	34-1/2"	37"	44"			48-1/4"			53-1/8"				58"				63"				
		Anchor Group	Anchor Group	Anchor Group	Anchor Group	Anchor Group	Anchor Group			Anchor Group			Anchor Group				Anchor Group				Anchor Group				
		All	All	All	All	All	A	B	C & D	A	B	C & D	A	B	C	D	A	B	C	D	A	B	C	D	
Window Dimension "B"	under 23"	+60/-70	+60/-70	+60/-70	+60/-70	+60/-70	+60/-70	+60/-66.6	+60/-70	+60/-70	+60/-60.7	+60/-70	+60/-69	+/-55.3	+60/-66.1	+60/-70	+60/-63.1	+/-50.5	+60/-60.5	+60/-70	+/-58.1	+/-46.5	+/-55.7	+60/-70	
	25-15/16"	+60/-70	+60/-70	+60/-70	+60/-70	+60/-70	+60/-70	+60/-70	+60/-70	+60/-67.1	+60/-70	+60/-70	+60/-61.1	+60/-70	+60/-70	+60/-70	+/-55.9	+60/-70	+60/-70	+60/-70	+/-51.5	+60/-70	+60/-70	+60/-70	
	37"	+60/-70	+60/-70	+60/-70	+60/-70	+60/-70	+60/-70	+60/-64.6	+60/-70	+60/-70	+/-58.8	+60/-70	+60/-70	+/-53.6	+60/-70	+60/-70	+60/-70	+/-49	+60/-70	+60/-70	+60/-70	+/-45.1	+60/-70	+60/-70	+60/-70
	44"	+60/-70	+60/-70	+60/-70	+60/-70	+60/-70	+60/-70	+60/-65.2	+60/-70	+60/-70	+/-59.4	+60/-70	+60/-70	+/-54.1	+60/-70	+60/-70	+60/-70	+/-49.4	+60/-66	+60/-69.6	+60/-69.6	+/-37.9	+60/-60.8	+60/-62.9	+60/-62.9
	48-1/4"	+60/-70	+60/-70	+60/-70	+60/-70	+60/-70	+/-59.4	+60/-70	+60/-70	+/-54.1	+60/-70	+60/-70	+/-49.3	+60/-65.8	+60/-70	+60/-70	+/-45	+60/-60.2	+60/-64.9	+60/-64.9					
	53-1/8"	+60/-70	+60/-70	+60/-70	+60/-70	+60/-70	+60/-63.1	+60/-70	+60/-70	+/-57.5	+60/-65.8	+60/-70	+/-52.3	+/-59.9	+60/-69.3	+60/-69.3									
	58"	+60/-70	+60/-70	+60/-70	+60/-70	+60/-68.6	+60/-65.9	+60/-69.6	+60/-69.6	+60/-60.1	+60/-64.9	+60/-64.9													
	63"	+60/-70	+60/-70	+60/-70	+60/-70	+60/-70	+60/-60.7	+60/-62.9	+60/-62.9																
	76"	+60/-70	+60/-70	+60/-70	+60/-70	+60/-60.5	+/-57																		
	84"	+60/-70	+60/-70	+60/-70	+/-55.6																				

FIGURE FOR VERTICAL FRAME ASSEMBLY TUBE

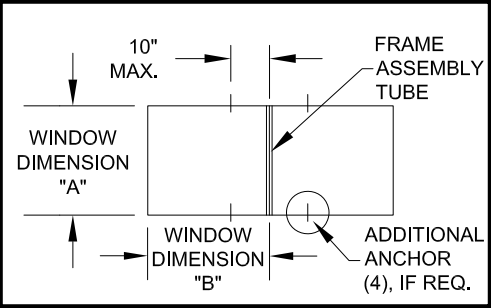

SEE SHEETS 1, 4 & 5 FOR WINDOW ANCHOR LOCATIONS AND QUANTITIES. SEE SHEET 3 FOR ANY ADDITIONAL ANCHORS REQUIRED FOR THE FRAME ASSEMBLY TUBE.

FIGURE FOR HORIZONTAL FRAME ASSEMBLY TUBE

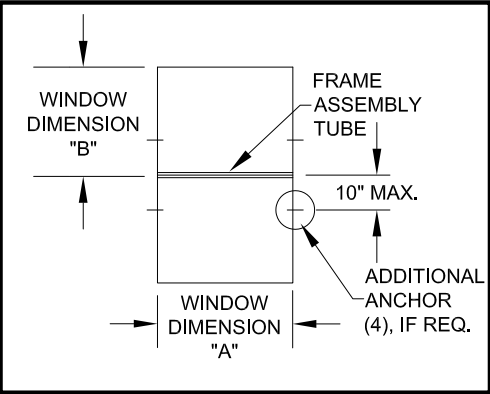



SEE SHEETS 1, 4 & 5 FOR WINDOW ANCHOR LOCATIONS AND QUANTITIES. SEE SHEET 3 FOR ANY ADDITIONAL ANCHORS REQUIRED FOR THE FRAME ASSEMBLY TUBE.

PRODUCT REVISED
As complying with the Florida Building Code
NOA-No. 23-0816.08
Expiration Date: 04/11/2028
By: Manuel Perez
Miami-Dade Product Control


F) NO CHANGES, THIS SHEET.
SB - 7/31/23

PREPARED BY A. LYNN MILLER 1070 TECHNOLOGY DRIVE N. VENICE, FL 34275 (941) 480-1600	REGISTRATION #29296	08/08/12	J ROSOWSKI	MD-PW740-LM	F
PGT Custom Windows and Doors 1070 TECHNOLOGY DRIVE N. VENICE, FL 34275 (941) 480-1600	CASEMENT PICTURE WINDOW DETAILS - LM	DESIGN PRESSURE PER GLAZING TYPE	PW-740	10 OF 11	PW-740

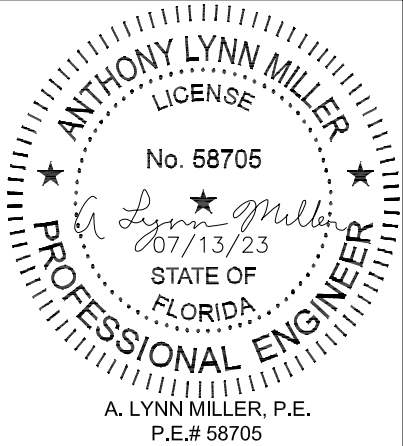


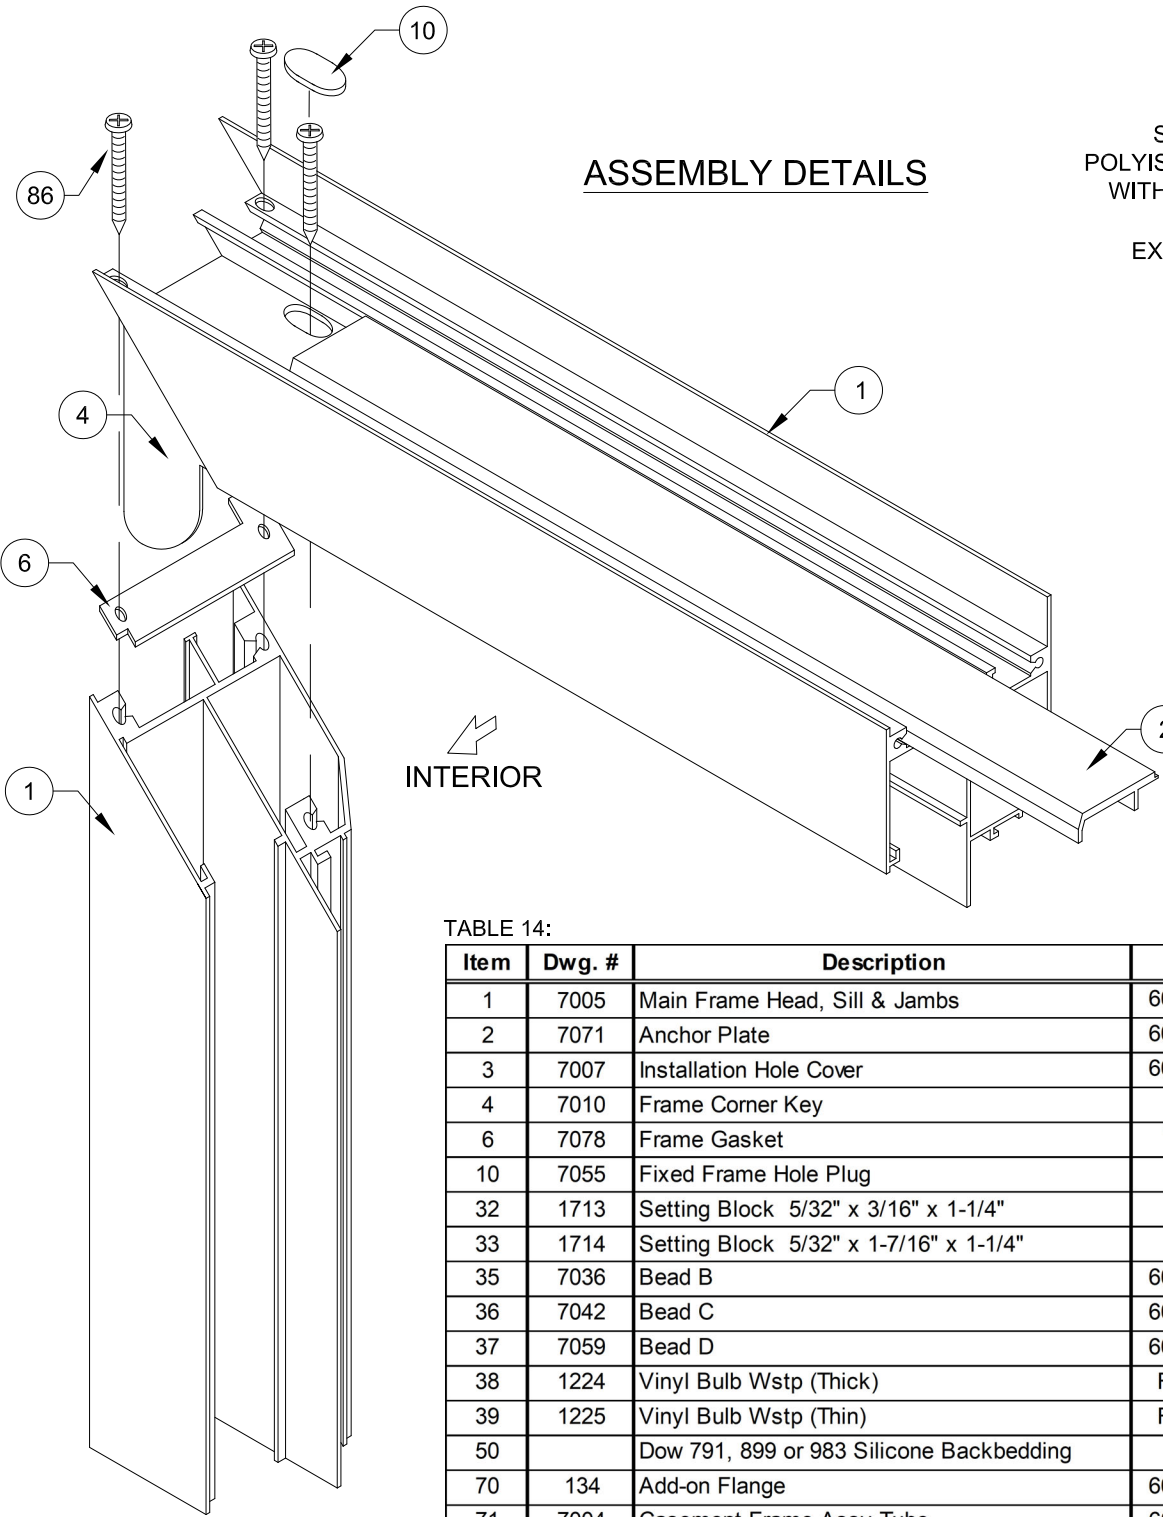


ASSEMBLY DETAILS

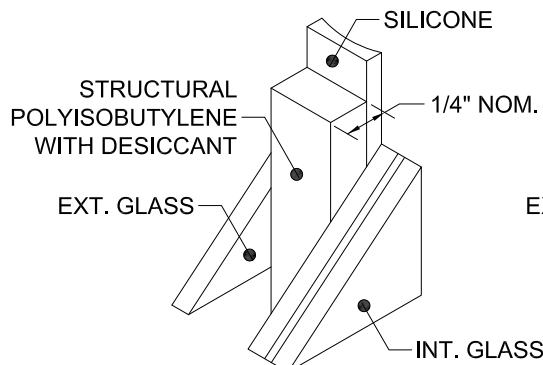


75 KODISPACE
4SG TPS

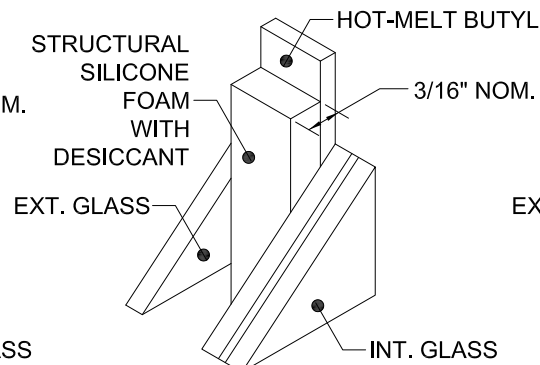

76 SUPER
SPACER[®] NXT™

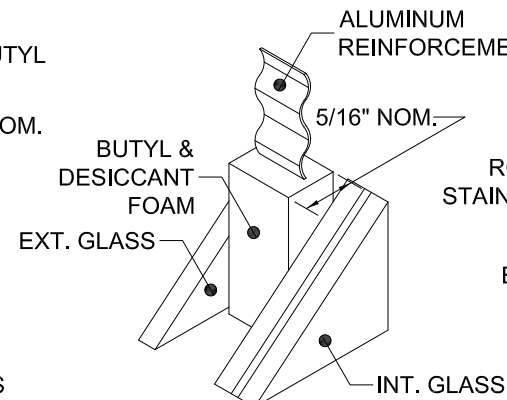

77 DURASEAL[®]
SPACER

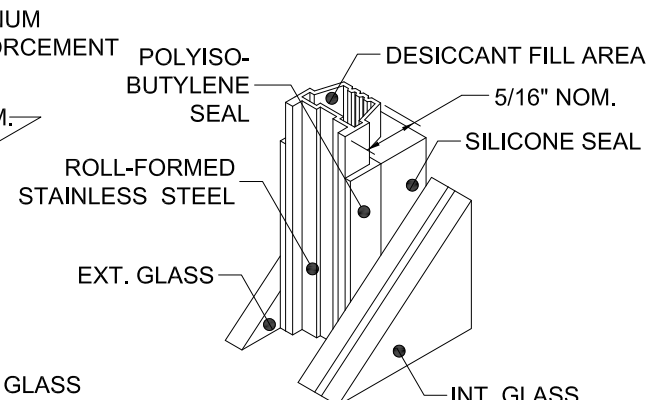


78 XL EDGE™
SPACER

TABLE 14:


Item	Dwg. #	Description	Mat.
1	7005	Main Frame Head, Sill & Jambs	6063-T6 Alum.
2	7071	Anchor Plate	6063-T6 Alum.
3	7007	Installation Hole Cover	6063-T6 Alum.
4	7010	Frame Corner Key	Steel
6	7078	Frame Gasket	Vinyl Foam
10	7055	Fixed Frame Hole Plug	PVC
32	1713	Setting Block 5/32" x 3/16" x 1-1/4"	EPDM
33	1714	Setting Block 5/32" x 1-7/16" x 1-1/4"	EPDM
35	7036	Bead B	6063-T6 Alum.
36	7042	Bead C	6063-T6 Alum.
37	7059	Bead D	6063-T6 Alum.
38	1224	Vinyl Bulb Wstp (Thick)	Flex PVC 70
39	1225	Vinyl Bulb Wstp (Thin)	Flex PVC 70
50		Dow 791, 899 or 983 Silicone Backbedding	
70	134	Add-on Flange	6063-T6 Alum.
71	7004	Casement Frame Assy Tube	6063-T6 Alum.
86		#8 X 1-1/2" Quad Pn SMS Stainless Steel	Stainless Steel
90		#12 X 1" Ph. Pn. TEK	Stainless Steel

Part #	Description	Material
75	Kommerling 4SG TPS Spacer System	See this Sheet for Materials
76	Quanex Super Spacer nXT with Hot Melt Butyl	
77	Quanex Duraseal Spacer	
78	Cardinal XL Edge Spacer	


REFERENCE TEST REPORTS: FTL-8717, 8968 & 8970

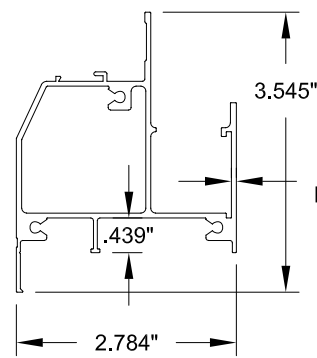


1 FRAME HEAD,
SILL & JAMB
#7005, 6063-T6

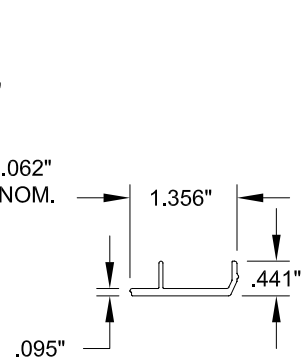


2 ANCHOR PLATE
#7071, 6063-T6

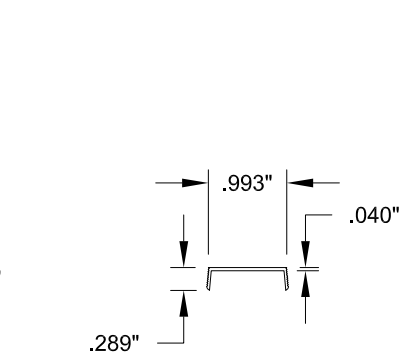


3 INST. HOLE COVER
#7007, 6063-T6

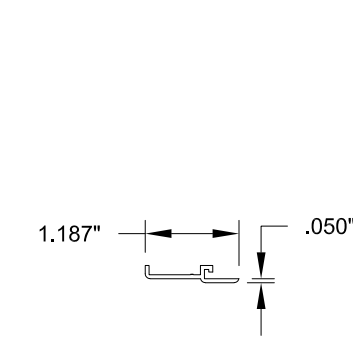


70 ADDON FLANGE
#134, 6063-T6

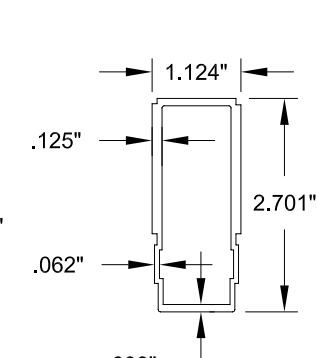


71 FRAME
ASSEMBLY TUBE
#7004, 6063-T6

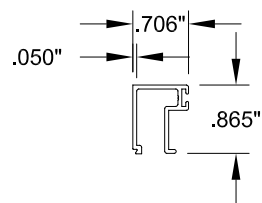

35 BEAD B
#7036, 6063-T6

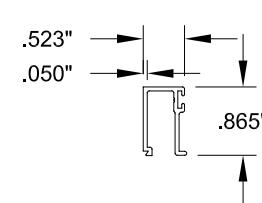

36 BEAD C
#7042, 6063-T6

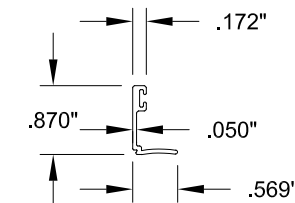

37 BEAD D
#7059, 6063-T6

PRODUCT REVISED
As complying with the Florida
Building Code
NOA-No. **23-0816.08**
Expiration Date: **04/11/2028**
By: *Manuel Perez*
Miami-Dade Product Control

PGT
Custom Windows and Doors
1070 TECHNOLOGY DRIVE
N. VENICE, FL 34275
(941) 480-1600

PREPARED BY A. LYNN MILLER
1070 TECHNOLOGY DRIVE
N. VENICE, FL 34275

(941) 480-1600

REGISTRATION #29296

Case	Desc.	Title	Date
		CASEMENT PICTURE WINDOW DETAILS - LM	08/08/12
BOM	Extrusions	Drawn By	J ROSOWSKI
F)	NO CHANGES, THIS SHEET. SB	Rev Date	07/31/23
PW-740	Sheet	11 OF 11	DWG No.
MD-PW740-LM	Rev.	F	

