



Shop Drawing Review

Project: Casa Robles at 6545 SW 131 Street - Pinecrest
Submitted 08/10/2025 Window Shop Drawing

Approved: ☒
Approved As Noted: ☐
Rejected/Re-Submit: ☐
Reviewed - For Record: ☐

Corrections or comments made on the shop drawing review process do not relieve contractor from compliance with drawings and specifications requirements. This check is only for review of general conformance with the design concept of the project and general compliance with the information given in the contract documents. The contractor is responsible for confirming and correlating all quantities and dimensions, selecting fabrication processes and techniques of construction. Review shall be construed in strict accordance with AIA - A201 general conditions, 1987 paragraph 3.12 and 4.2.7.

Reviewed By: A.R (J.L)
Date: 10-22-25

RECEIVED

10/23/2025

CFS Engineering Group, Inc.

APPROVED

By Alexander P Becerra at 10:19 am, Oct 20, 2025

SPECIALTY ENGINEER SHOP DRAWING REVIEW

Review of design calculations and drawings prepared by delegated engineer (Specialty Engineer) does not constitute a detailed check of calculations, nor does it relieve the Specialty Engineer from the responsibility of the detailing of the specialty component or system.

Review is limited to confirming the following:
That the specialty engineering documents conform with the intent of the engineer of record as expressed on the Structural Documents and have been prepared by a structural engineer registered in Florida;
That the effect of the Specialty Engineer's work on the structural frame conforms with the intent of the Structural Documents.

- ☒ NO EXCEPTIONS TAKEN
☐ SUBMIT SPECIFIED ITEM
☐ NON-COMPLIANT SUBMITTAL
☐ ACKNOWLEDGE RECEIPT FOR RECORD
- ☐ EXCEPTIONS NOTED
☐ REVISE & RESUBMIT
☐ REJECTED

CFS ENGINEERING GROUP, INC.

BY CS DATE 10-27-25

Reviewed only for compliance with wind loading criteria.

- ☒ NO EXCEPTIONS TAKEN
☐ MAKE CORRECTIONS AS NOTED
☐ REVIEW AND RESUBMIT
- ☐ REJECTED
☐ SUBMIT SPECIFIED ITEM
☐ NOT REVIEWED


Submittal is reviewed only as to general conformity with design concept of the project and general compliance with the information given in the Contract Documents. Corrections and or comments made as part of this submittal review do not relieve contractor of responsibility from conformance with the Contract Documents, applicable codes, and laws- all of which have priority over this submittal. The design professional does not warrant or represent that the information within the submittal is either accurate or complete. Sole responsibility for correct design, details, and dimensions shall remain with the party providing the submittal. Contractor is responsible for all dimensions, quantities and performance requirements to be confirmed and correlated at the job site; for all information that pertains solely to the fabrication process or to techniques of construction; for all coordination of the work of all trades; for assuring consistency with the Contract Documents; and for performing the work in a safe and satisfactory manner.

FAO ARCHITECTURE, LLC.

Reviewed by: FAO Date: 10-27-25

GENERAL NOTE:

- ALL ESCAPE WINDOWS SHALL PROVIDE A CLEAR OPENING OF NOT LESS THEN 5.7 SQUARE FEET. THE WIDTH SHALL NOT BE LESS THAN 20" AND THE HEIGHT SHALL NOT BE LESS THAN 24". THE BOTTOM OF THE OPENING SHALL NOT BE MORE THAN 44" ABOVE FINISHED FLOOR.
- WINDOW FRAMES/MULLIONS ANCHORAGE TO MAIN STRUCTURE SHALL BE IN STRICT ACCORDANCE WITH THE UNITS NOTICE OF ACCEPTANCE - REFER TO PRODUCT CONTROLS.
- ONLY THE OPENINGS THAT ARE IDENTIFIED WITH THEIR PRODUCT CONTROL N.O.A. DESIGN PRESSURES AND SIZE ARE PART OF THIS PERMIT. ALL OTHER OPENINGS ARE NOT PART OF THIS PERMIT.

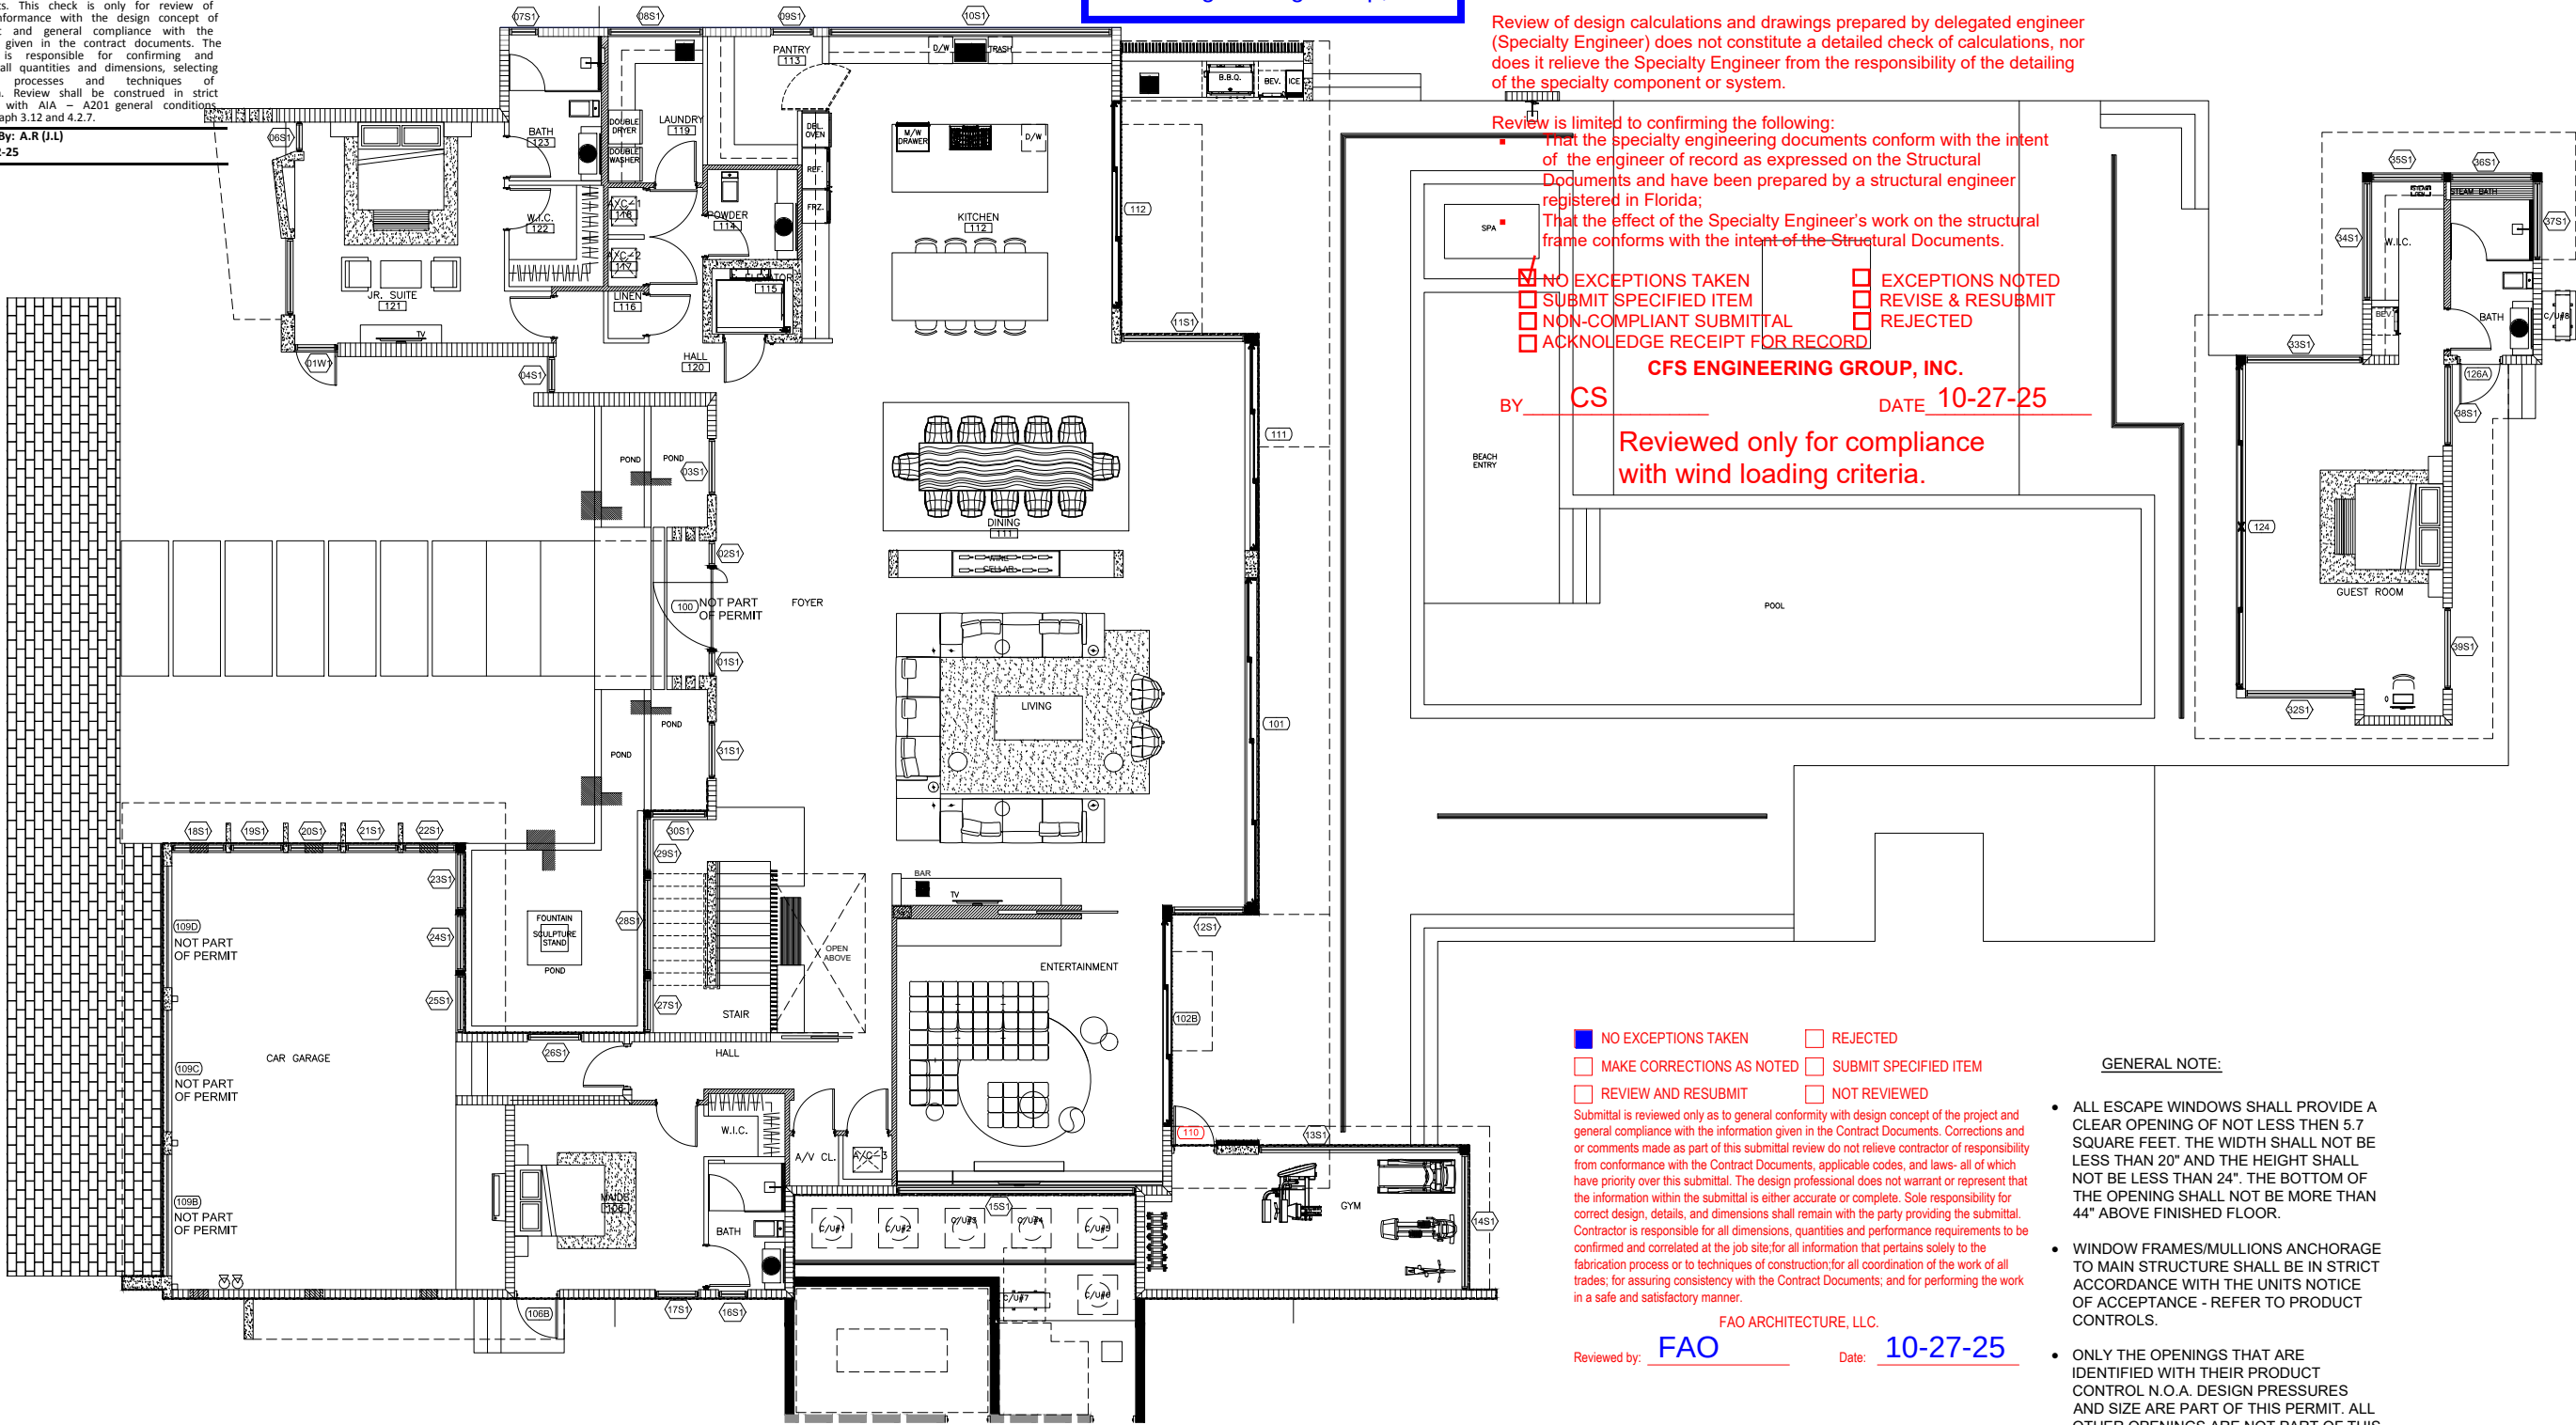

FIRST FLOOR AREAS
SCALE: 1/8"=1'-0"

WINDOWS AND DOORS
CASA ROBLES 131
6545 SW STREET PINECREST,
FLORIDA 33156


No.	Revision/Issue	Date


PERMIT

Sheet Name

FLOOR PLAN

Drawn by J. REY	Sheet 1
Date 07/31/2025	
Scale 3/16"=1'	

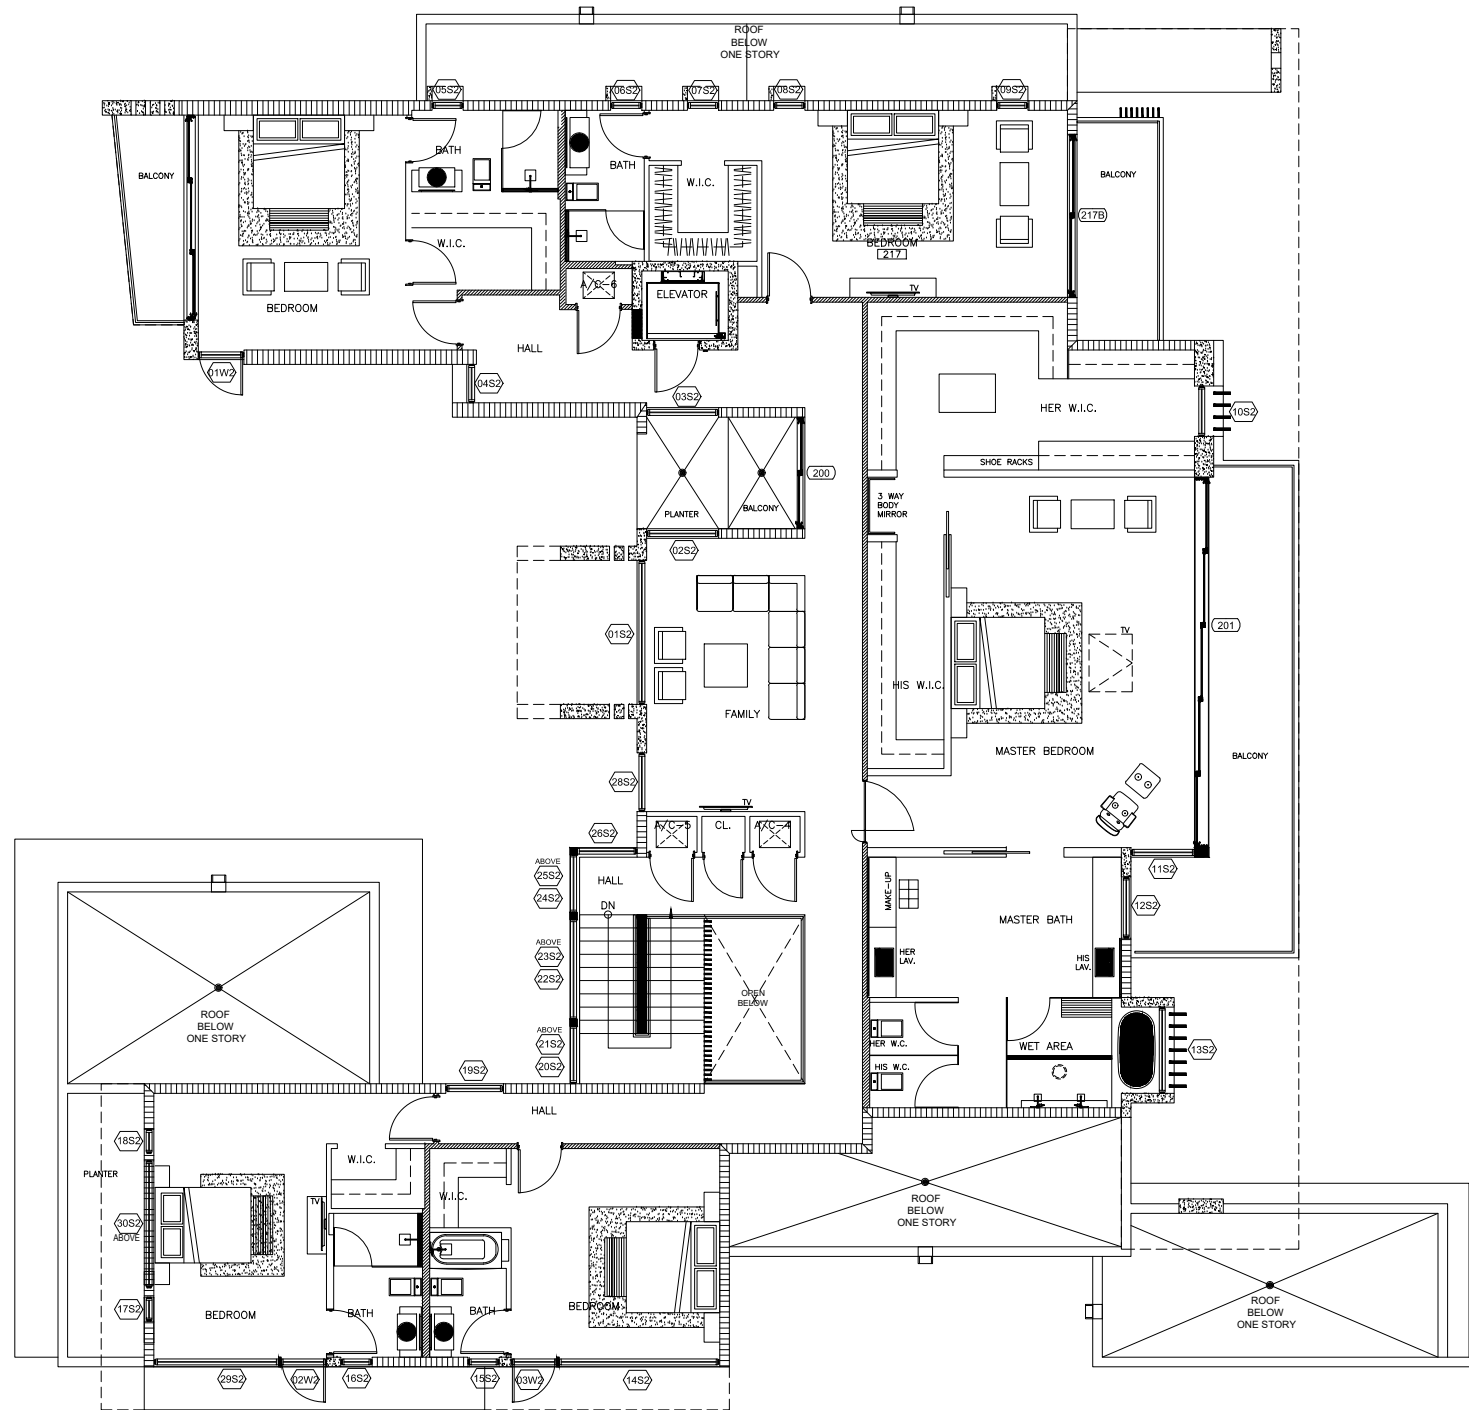

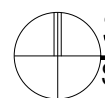 **SECOND FLOOR AREAS**
SCALE: 1/8"=1'-0"






WINDOWS AND DOORS
CASA ROBLES 131
6545 SW STREET PINECREST,
FLORIDA 33156

No.	Revision/Issue	Date

PERMIT

Sheet Name
FLOOR PLAN

Drawn by J. REY	Sheet 2
Date 07/31/2025	
Scale 3/16"=1'	

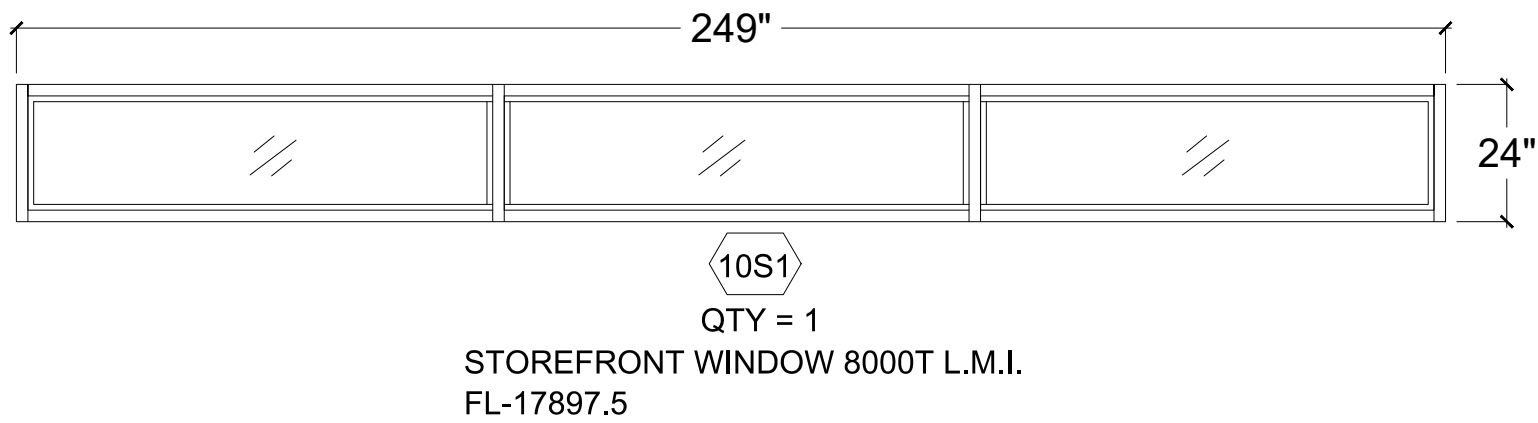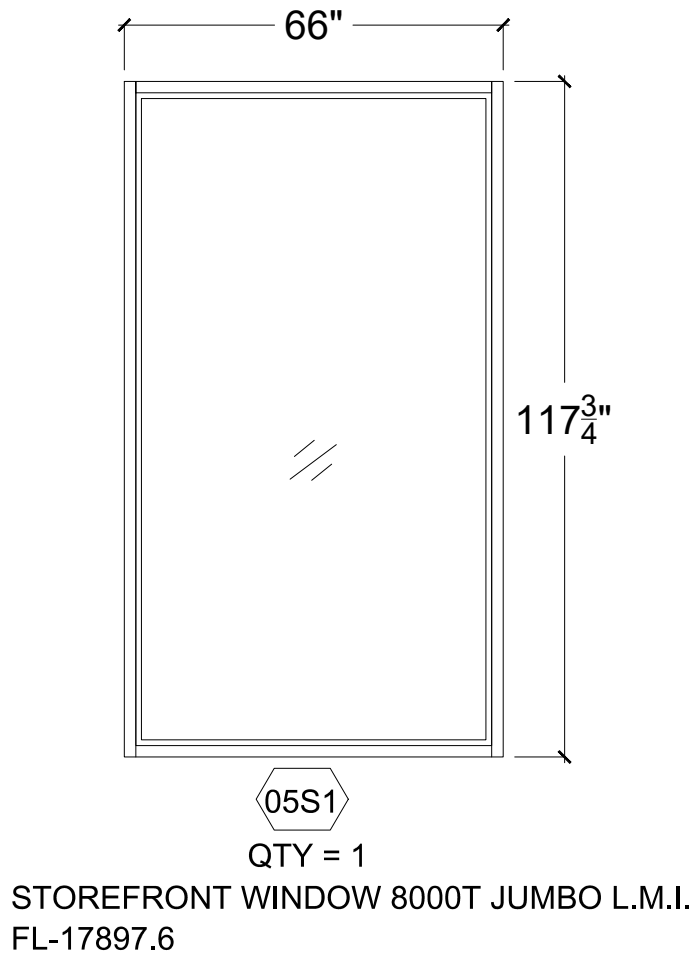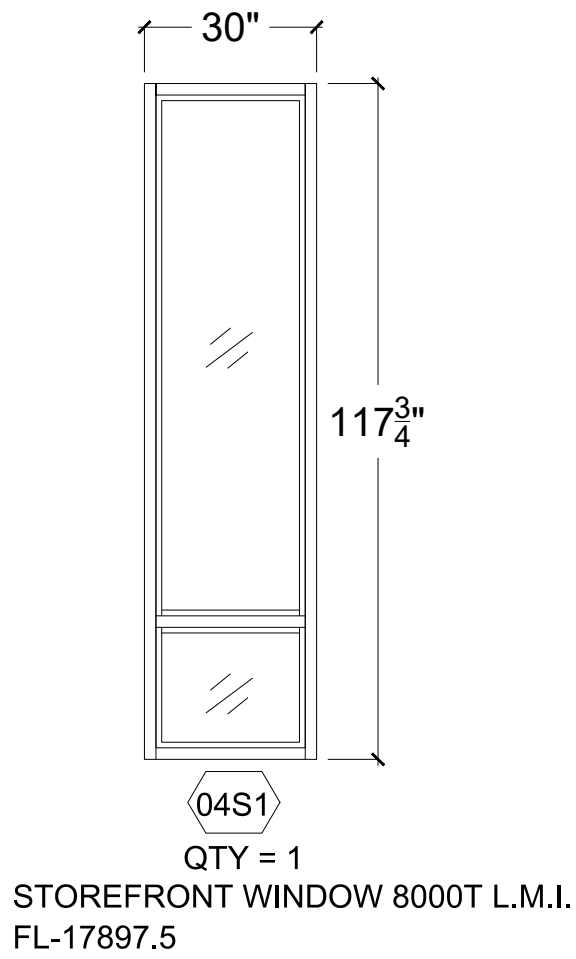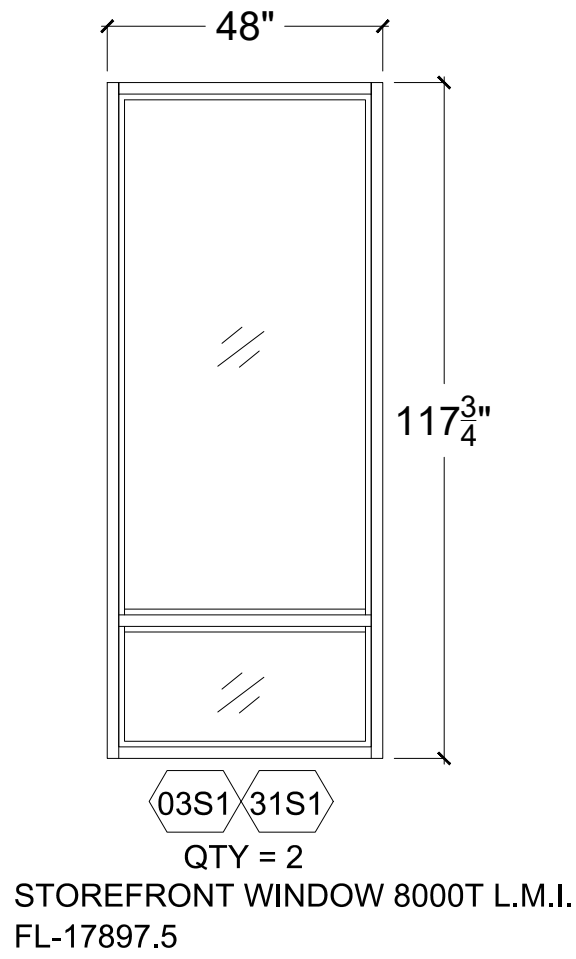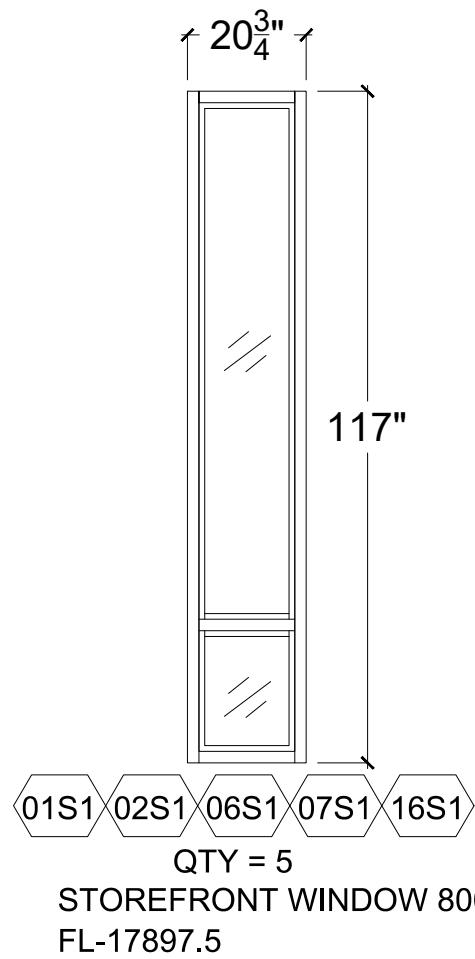


WINDOWS AND DOORS
CASA ROBLES 131
6545 SW STREET PINECREST,
FLORIDA 33156

No.	Revision/Issue	Date

PERMIT


Sheet Name
WINDOWS AND DOORS
ELEVATION

Drawn by J. REY	Sheet 3
Date 07/31/2025	
Scale 3/4"=1'	

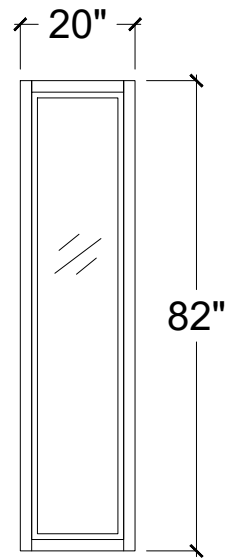


QTY = 1

STOREFRONT WINDOW 8000T L.M.I.
FL-17897.5

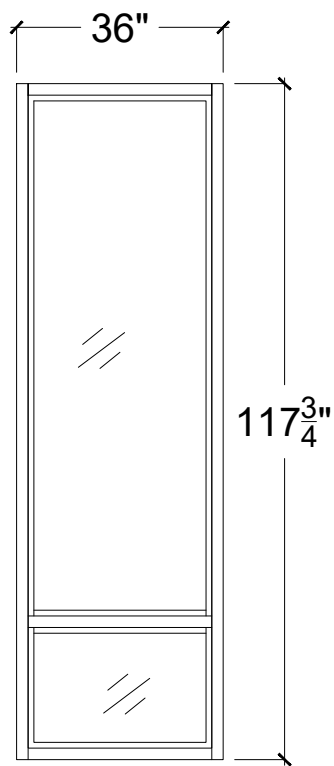

QTY = 1

STOREFRONT WINDOW 8000T L.M.I.
FL-17897.5

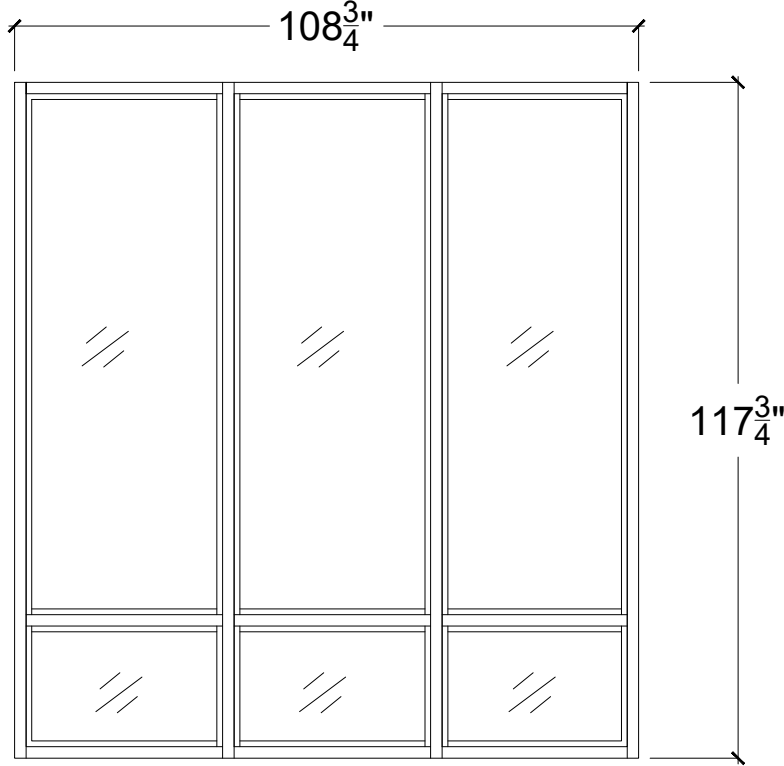

QTY = 1

STOREFRONT WINDOW 8000T L.M.I.
FL-17897.5



QTY = 1

STOREFRONT WINDOW 8000T L.M.I.
FL-17897.5

WINDOWS AND DOORS


CASA ROBLES 131
6545 SW STREET PINECREST,
FLORIDA 33156

No.	Revision/Issue	Date

PERMIT

Sheet Name
WINDOWS AND DOORS
ELEVATION


Drawn by J. REY	Sheet 4
Date 07/31/2025	
Scale 3/4"=1'	

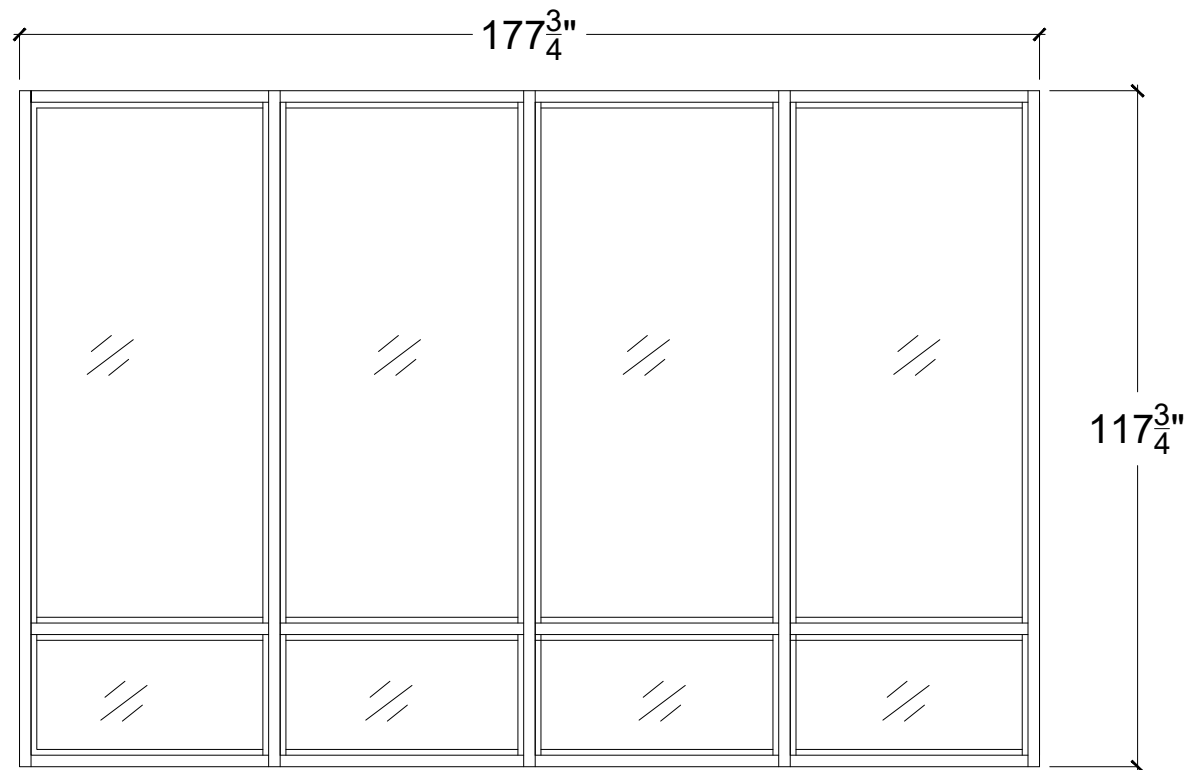

13S1

QTY = 1

STOREFRONT WINDOW 8000T L.M.I.
FL-17897.5

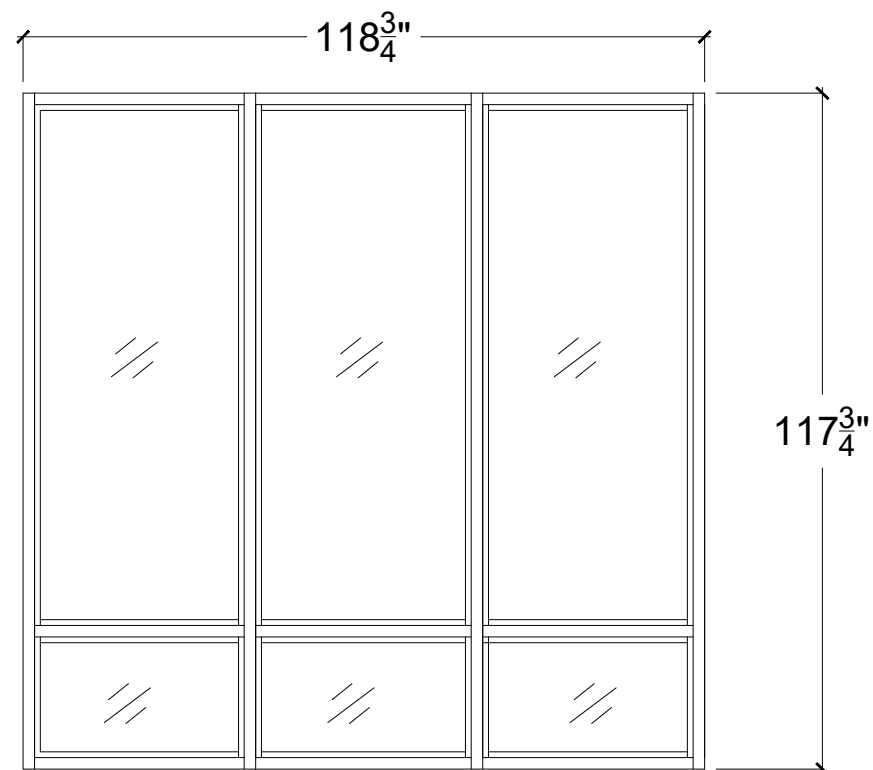

14S1

QTY = 1

STOREFRONT WINDOW 8000T L.M.I.
FL-17897.5

WINDOWS AND DOORS

CASA ROBLES 131
6545 SW STREET PINECREST,
FLORIDA 33156


No.	Revision/Issue	Date

PERMIT

Sheet Name


WINDOWS AND DOORS
ELEVATION

Drawn by J. REY	Sheet 5
Date 07/31/2025	
Scale 3/4"=1'	

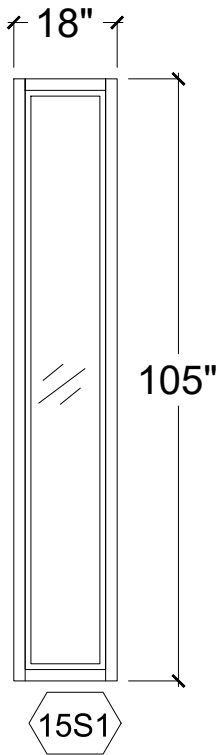


QTY = 2

STOREFRONT WINDOW 8000T L.M.I.
FL-17897.5

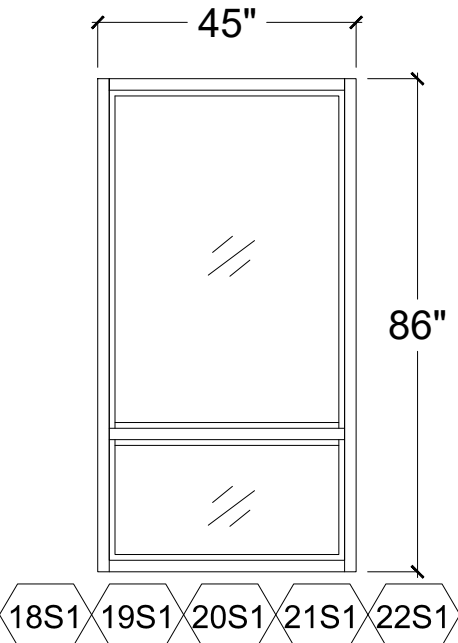


QTY = 5

STOREFRONT WINDOW 8000T L.M.I.
FL-17897.5

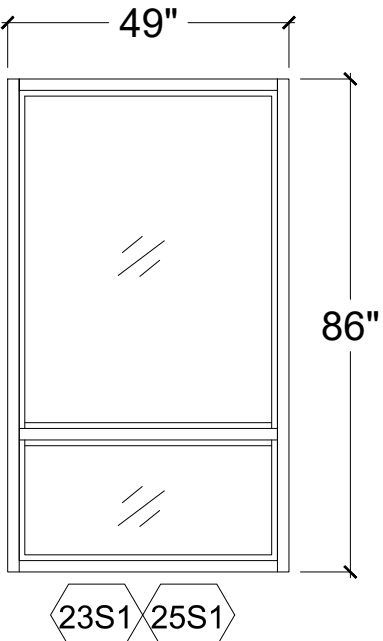

QTY = 2

STOREFRONT WINDOW 8000T L.M.I.
FL-17897.5

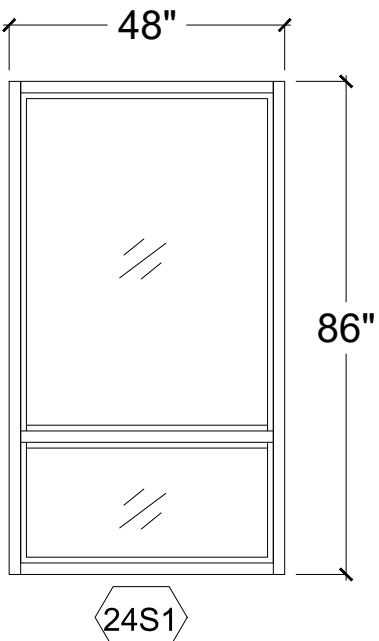

QTY = 1

STOREFRONT WINDOW 8000T L.M.I.
FL-17897.5


WINDOWS AND DOORS
CASA ROBLES 131
6545 SW STREET PINECREST,
FLORIDA 33156

No.	Revision/Issue	Date

PERMIT

Sheet Name
WINDOWS AND DOORS
ELEVATION


Drawn by J. REY	Sheet 6
Date 07/31/2025	
Scale 3/4"=1'	

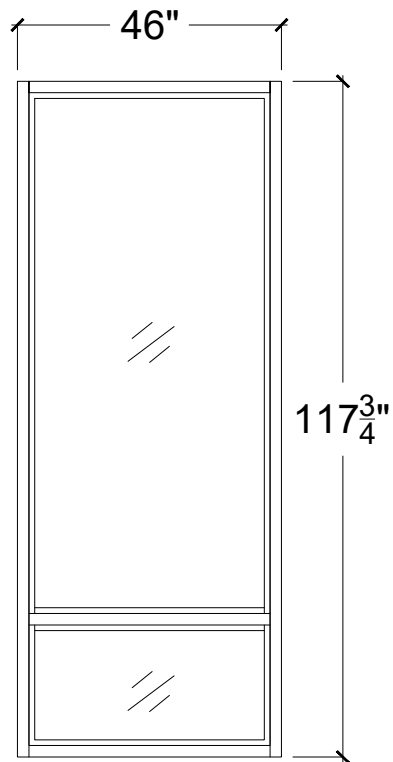

26S1

QTY = 1


STOREFRONT WINDOW 8000T L.M.I.
FL-17897.5

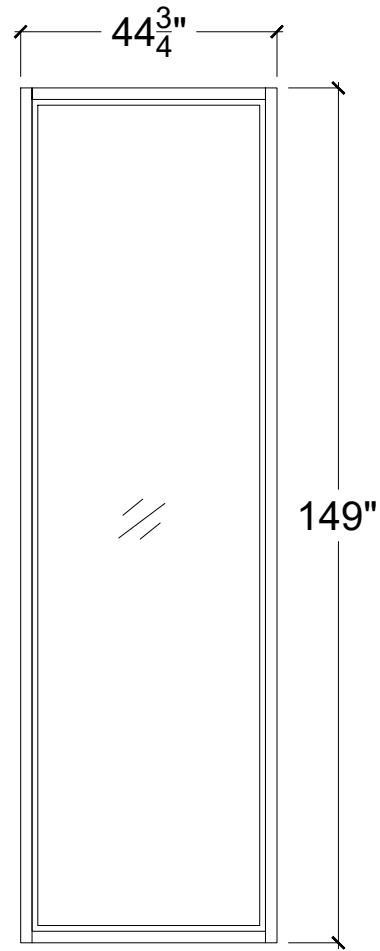

27S1

QTY = 1


STOREFRONT WINDOW 8000T JUMBO L.M.I.
FL-17897.6

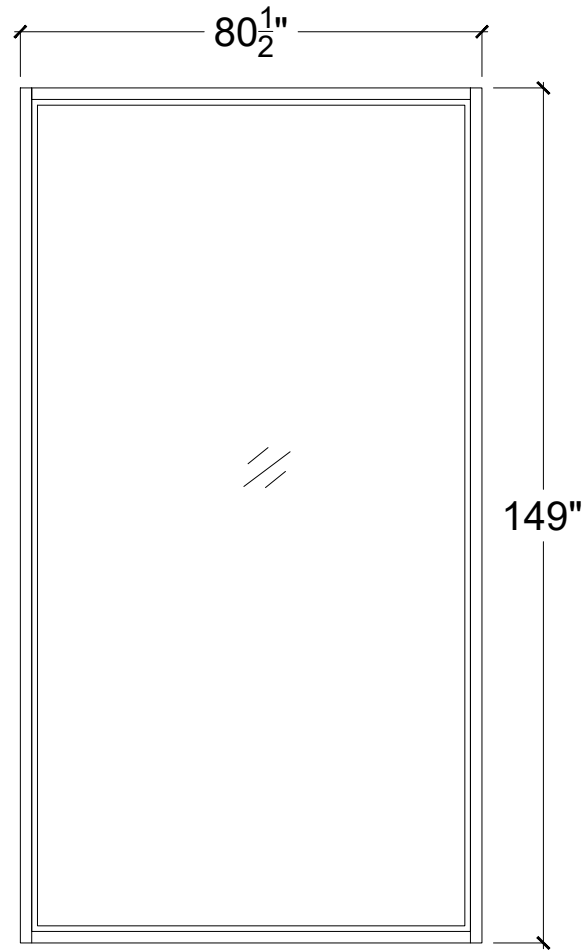

28S1

QTY = 1

STOREFRONT WINDOW 8000T JUMBO L.M.I.
FL-17897.6

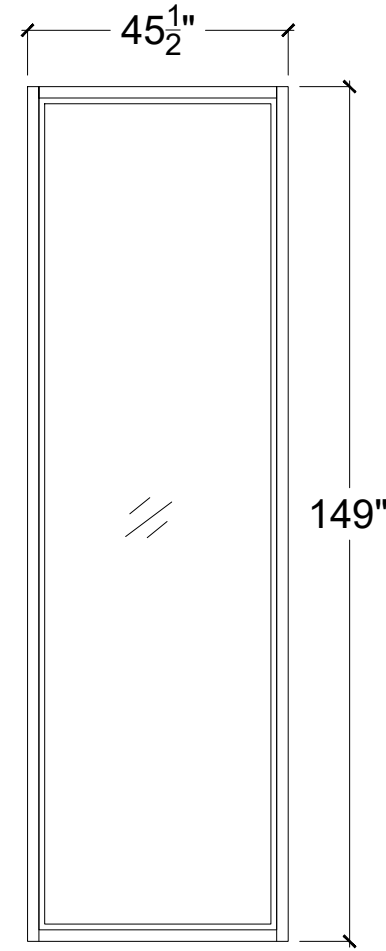

29S1

QTY = 1

STOREFRONT WINDOW 8000T JUMBO L.M.I.
FL-17897.6

WINDOWS AND DOORS


CASA ROBLES 131
6545 SW STREET PINECREST,
FLORIDA 33156

No.	Revision/Issue	Date

PERMIT

Sheet Name
WINDOWS AND DOORS
ELEVATION


Drawn by J. REY	Sheet 7
Date 07/31/2025	
Scale 3/4"=1'	

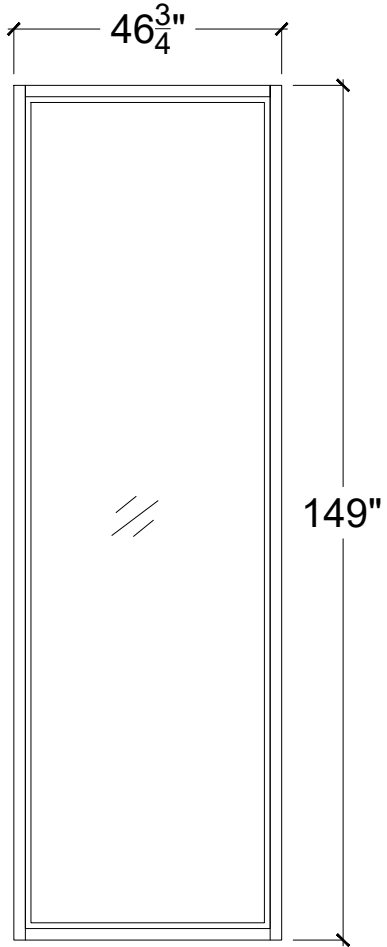

30S1

QTY = 1


STOREFRONT WINDOW 8000T JUMBO L.M.I.
FL-17897.6

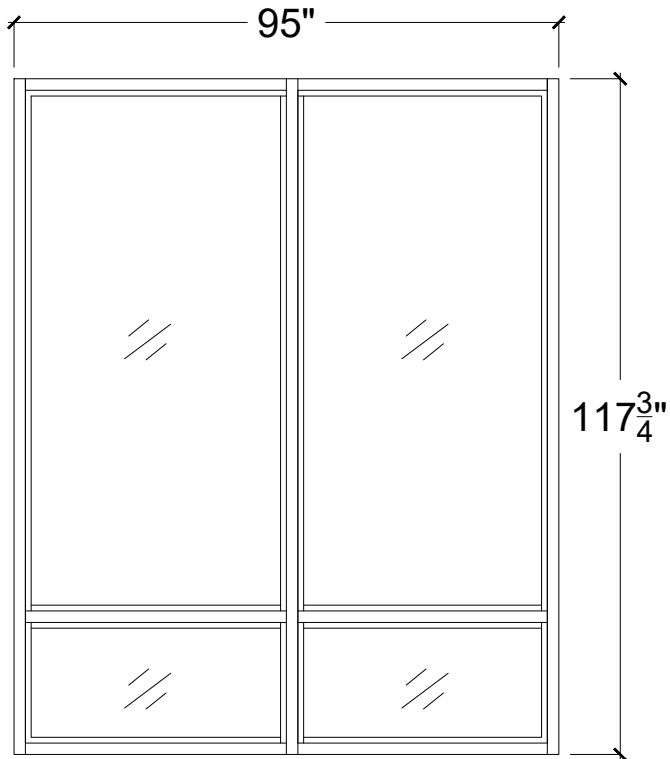

32S1

QTY = 1


STOREFRONT WINDOW 8000T L.M.I.
FL-17897.5

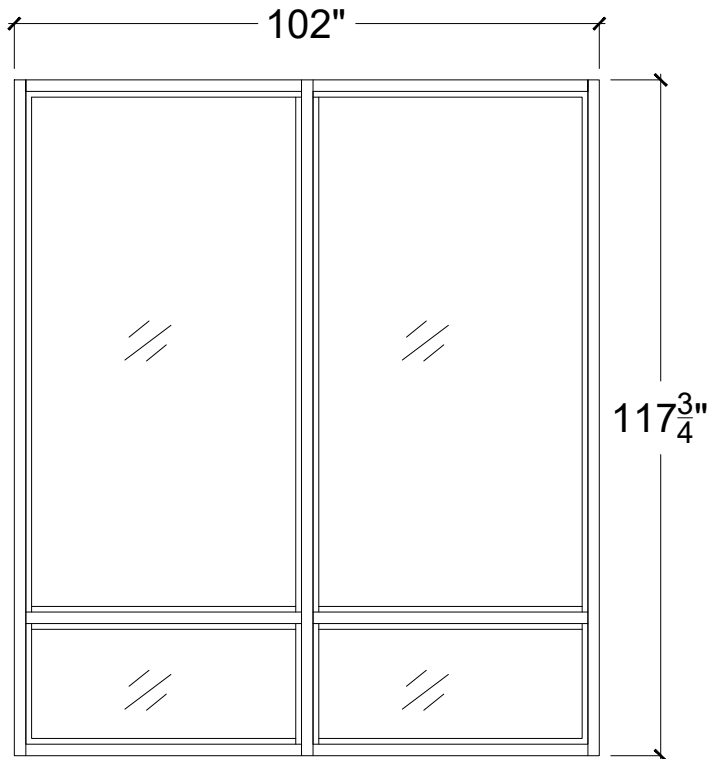

33S1

QTY = 1

STOREFRONT WINDOW 8000T L.M.I.
FL-17897.5

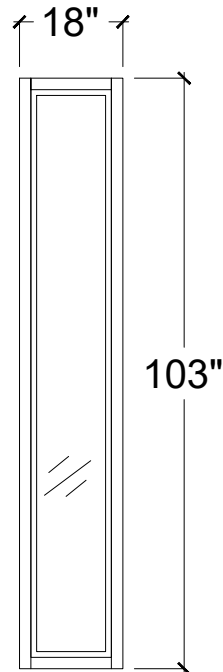

34S1

QTY = 1

STOREFRONT WINDOW 8000T L.M.I.
FL-17897.5

WINDOWS AND DOORS


CASA ROBLES 131
6545 SW STREET PINECREST,
FLORIDA 33156

No.	Revision/Issue	Date

PERMIT


Sheet Name
WINDOWS AND DOORS
ELEVATION

Drawn by J. REY	Sheet 8
Date 07/31/2025	
Scale 3/4"=1'	

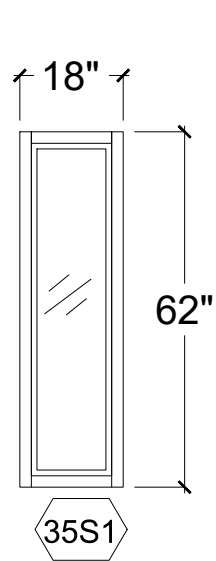


QTY = 1

STOREFRONT WINDOW 8000T L.M.I.
FL-17897.5

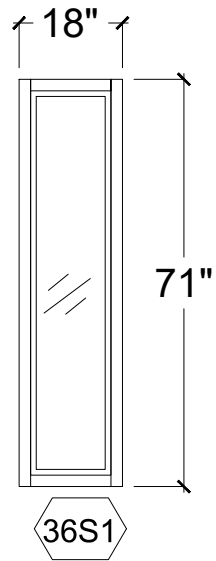


QTY = 1

STOREFRONT WINDOW 8000T L.M.I.
FL-17897.5

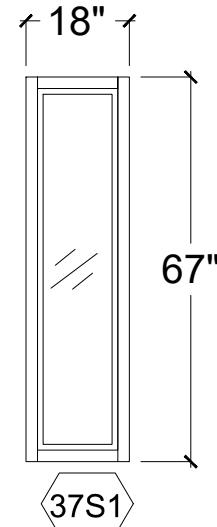


QTY = 1

STOREFRONT WINDOW 8000T L.M.I.
FL-17897.5

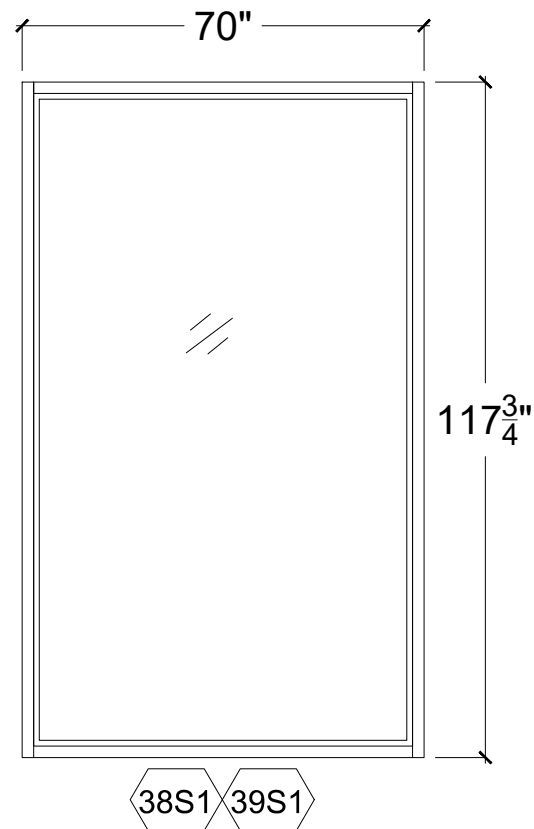

QTY = 2

STOREFRONT WINDOW 8000T JUMBO L.M.I.
FL-17897.6

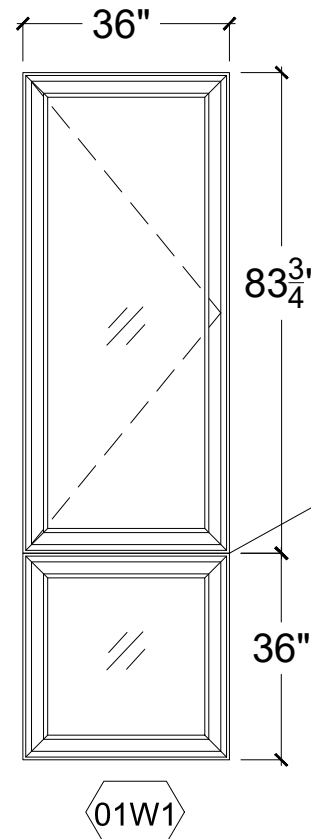

QTY= 1

CASEMENT WINDOW ES-P252 L.M.I.
FL-20692.1

CASEMENT WINDOW ES-P252 FIXED L.M.I.
FL-26359.1


WINDOWS AND DOORS
CASA ROBLES 131
6545 SW STREET PINECREST,
FLORIDA 33156

No.	Revision/Issue	Date

PERMIT

Sheet Name
WINDOWS AND DOORS
ELEVATION

Drawn by J. REY	Sheet 9
Date 07/31/2025	
Scale 3/4"=1'	

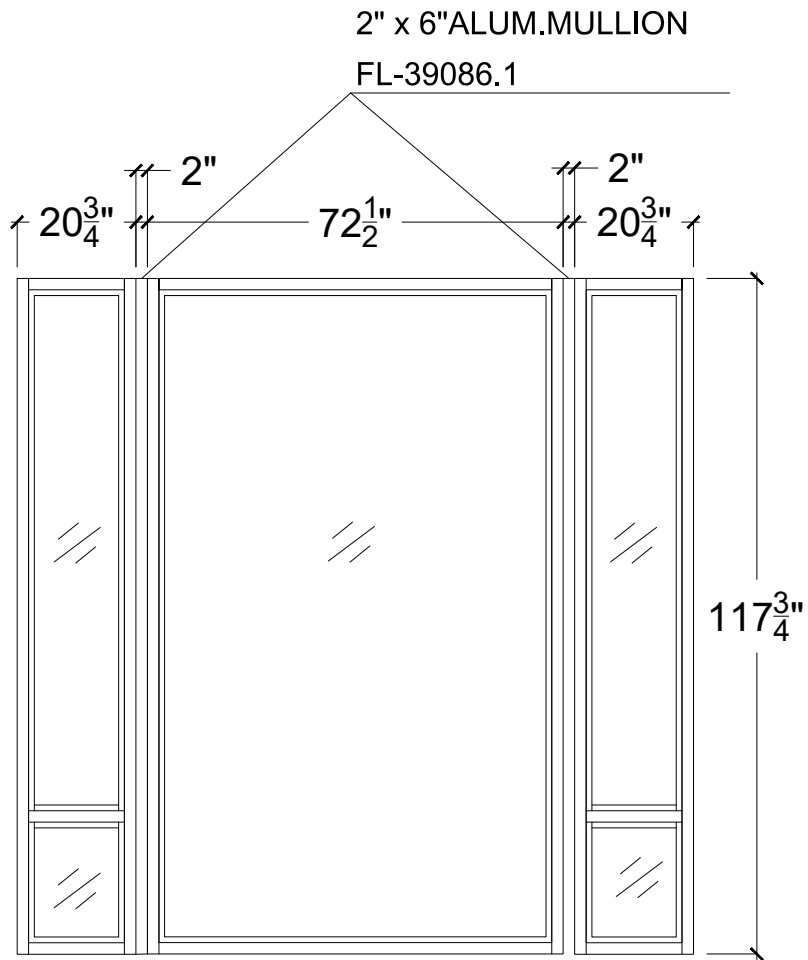


01S2

QTY = 1

STOREFRONT WINDOW 8000T L.M.I.
FL-17897.5


STOREFRONT WINDOW 8000T JUMBO L.M.I.
FL-17897.6

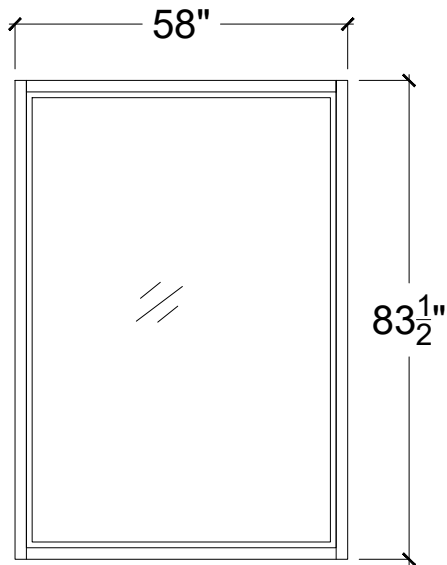

02S2 03S2

QTY = 2

STOREFRONT WINDOW 8000T JUMBO L.M.I.
FL-17897.6

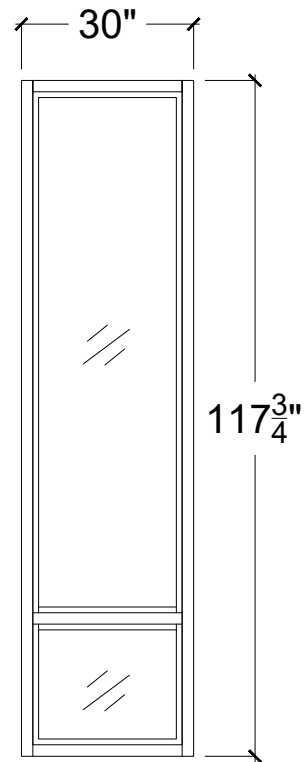

04S2

QTY = 1

STOREFRONT WINDOW 8000T L.M.I.
FL-17897.5

WINDOWS AND DOORS


CASA ROBLES 131
6545 SW STREET PINECREST,
FLORIDA 33156

No.	Revision/Issue	Date


PERMIT

Sheet Name
WINDOWS AND DOORS
ELEVATION


Drawn by J. REY	Sheet 10
Date 07/31/2025	
Scale 3/4"=1'	

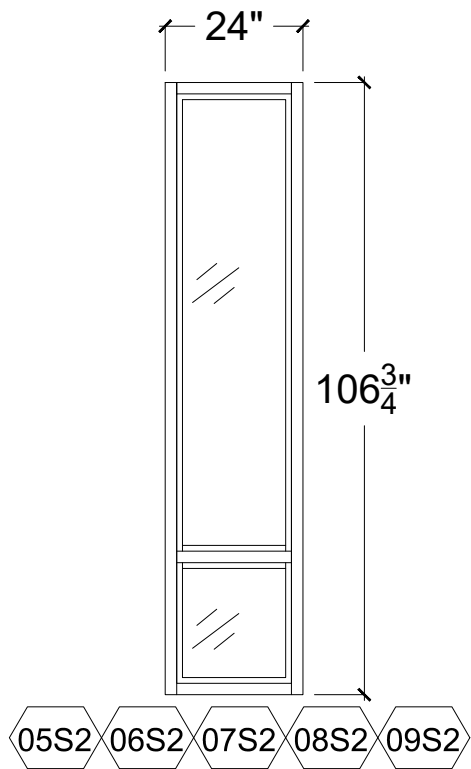


QTY = 5
STOREFRONT WINDOW 8000T L.M.I.
FL-17897.5

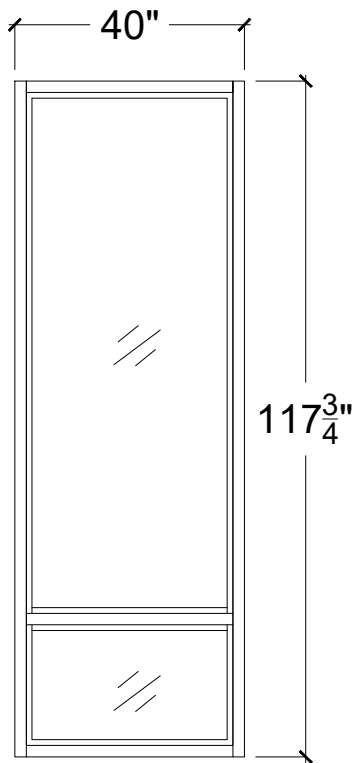

QTY = 1
STOREFRONT WINDOW 8000T L.M.I.
FL-17897.5

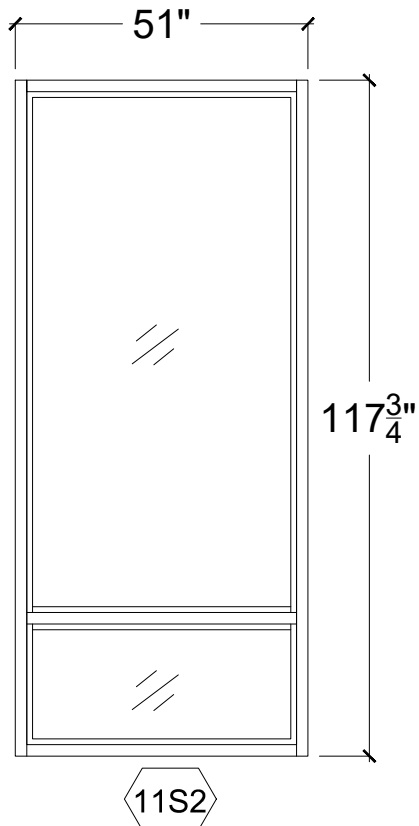

QTY = 1
STOREFRONT WINDOW 8000T L.M.I.
FL-17897.5

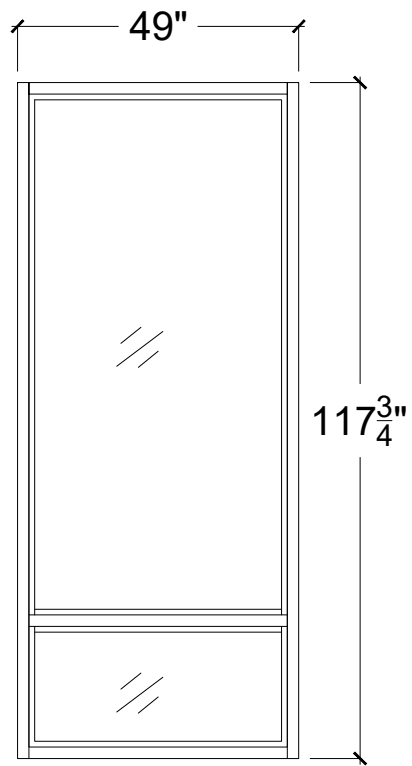

QTY = 1
STOREFRONT WINDOW 8000T L.M.I.
FL-17897.5

WINDOWS AND DOORS


CASA ROBLES 131
6545 SW STREET PINECREST,
FLORIDA 33156

No.	Revision/Issue	Date


PERMIT

Sheet Name
WINDOWS AND DOORS
ELEVATION


Drawn by J. REY	Sheet 11
Date 07/31/2025	
Scale 3/4"=1'	

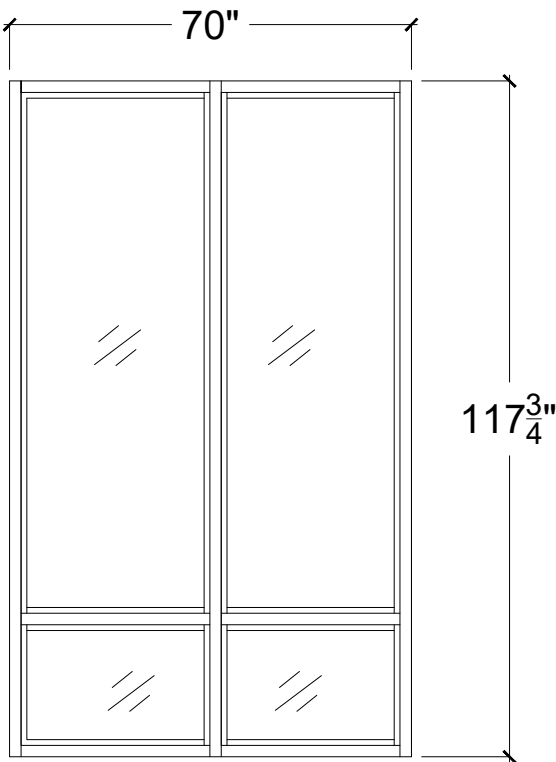


13S2
QTY = 1
STOREFRONT WINDOW 8000T L.M.I.
FL-17897.5

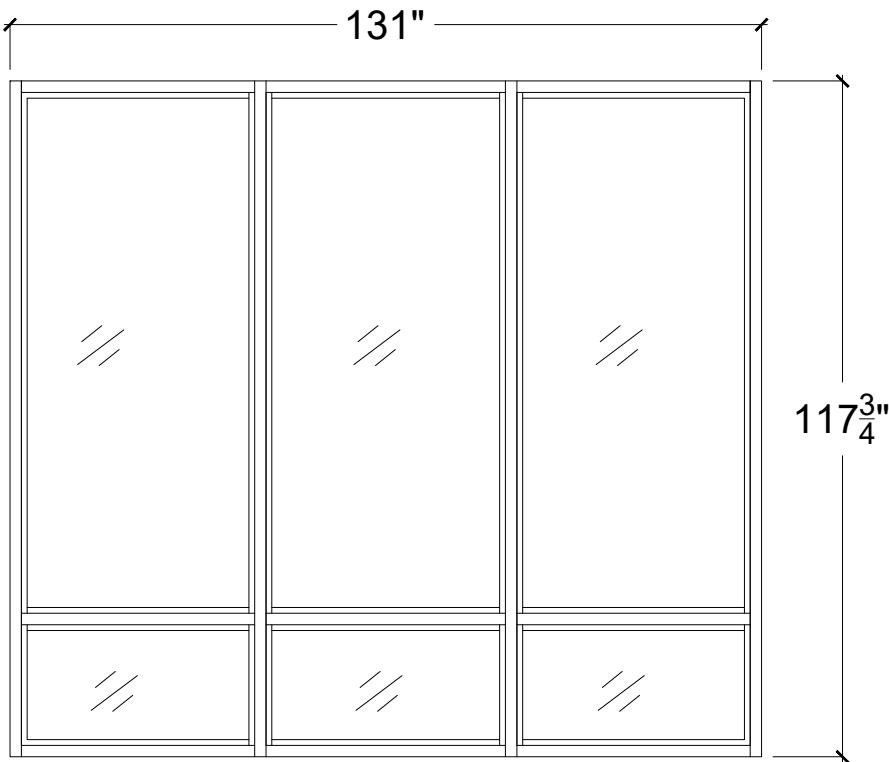

14S2
QTY = 1
STOREFRONT WINDOW 8000T L.M.I.
FL-17897.5

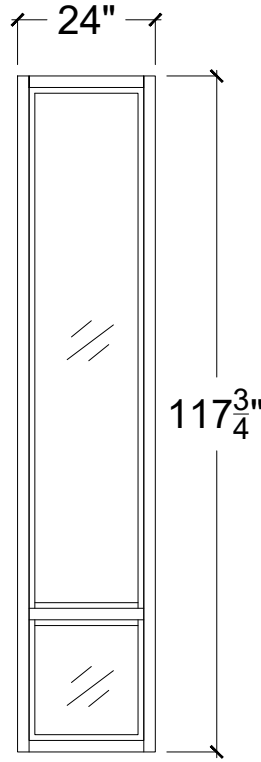

15S2 16S2
QTY = 2
STOREFRONT WINDOW 8000T L.M.I.
FL-17897.5

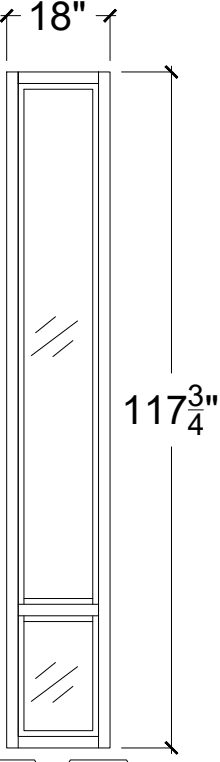

17S2 18S2
QTY = 2
STOREFRONT WINDOW 8000T L.M.I.
FL-17897.5

WINDOWS AND DOORS
CASA ROBLES 131
6545 SW STREET PINECREST,
FLORIDA 33156

No.	Revision/Issue	Date

PERMIT

Sheet Name
WINDOWS AND DOORS
ELEVATION

Drawn by J. REY	Sheet 12
Date 07/31/2025	
Scale 3/4"=1'	

46"

117³/₄"

19S2

QTY = 1

STOREFRONT WINDOW 8000T L.M.I.
FL-17897.5

44³/₄"

23¹/₂"

20S2

QTY = 1

STOREFRONT WINDOW 8000T L.M.I.
FL-17897.5

44³/₄"

93¹/₂"

21S2

QTY = 1

STOREFRONT WINDOW 8000T L.M.I.
FL-17897.5

23¹/₂"

80¹/₂"

22S2

QTY = 1

STOREFRONT WINDOW 8000T L.M.I.
FL-17897.5


WINDOWS AND DOORS
CASA ROBLES 131
6545 SW STREET PINECREST,
FLORIDA 33156

No.	Revision/Issue	Date

PERMIT

Sheet Name
WINDOWS AND DOORS
ELEVATION


Drawn by J. REY	Sheet 13
Date 07/31/2025	
Scale 3/4"=1'	

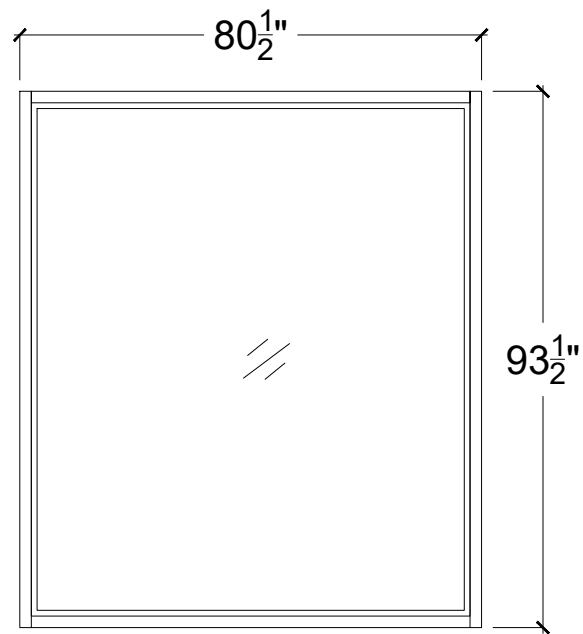

23S2

QTY = 1


STOREFRONT WINDOW 8000T JUMBO L.M.I.
FL-17897.6

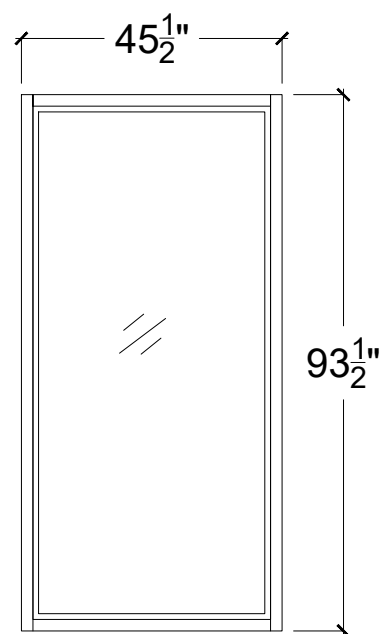

25S2

QTY = 1


STOREFRONT WINDOW 8000T L.M.I.
FL-17897.5

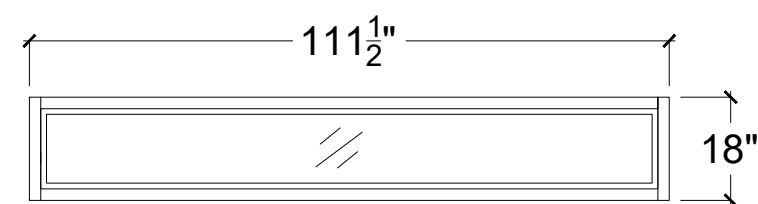

30S2

QTY = 1


STOREFRONT WINDOW 8000T L.M.I.
FL-17897.5

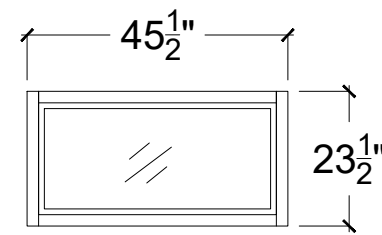

24S2

QTY = 1

STOREFRONT WINDOW 8000T L.M.I.
FL-17897.5

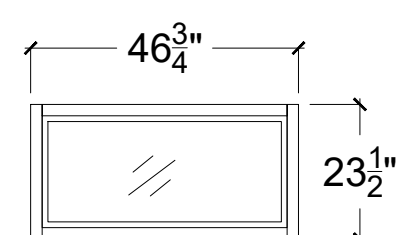

26S2

QTY = 1

STOREFRONT WINDOW 8000T L.M.I.
FL-17897.5

WINDOWS AND DOORS
CASA ROBLES 131
6545 SW STREET PINECREST,
FLORIDA 33156


No.	Revision/Issue	Date

PERMIT

Sheet Name

WINDOWS AND DOORS
ELEVATION


Drawn by J. REY	Sheet 14
Date 07/31/2025	
Scale 3/4"=1'	

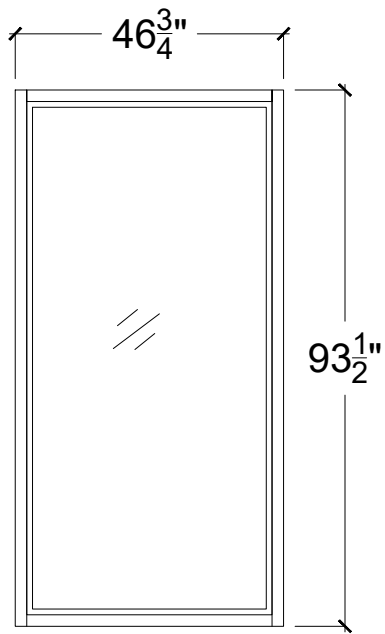

27S2

QTY = 1


STOREFRONT WINDOW 8000T L.M.I.
FL-17897.5

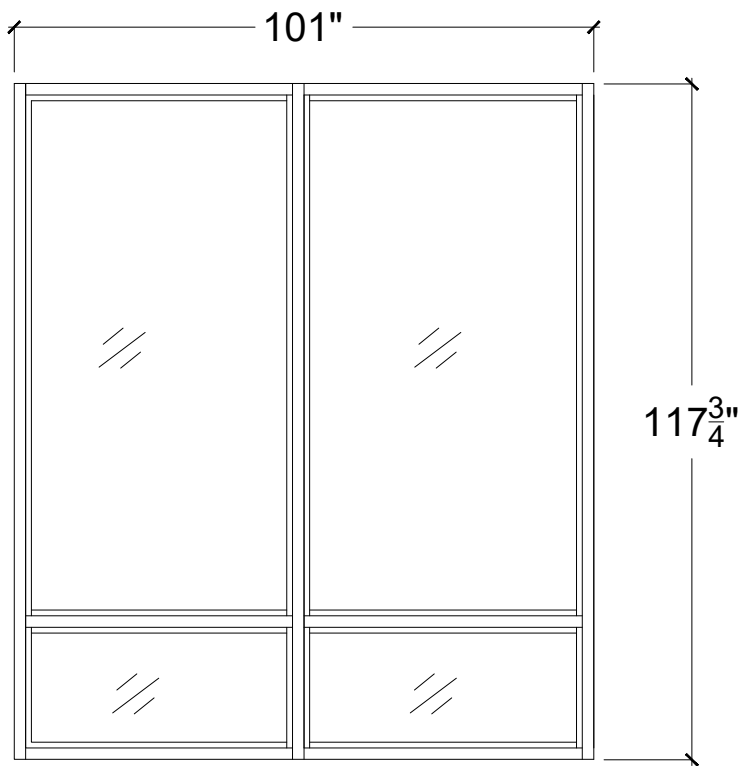

29S2

QTY = 1

STOREFRONT WINDOW 8000T L.M.I.
FL-17897.5

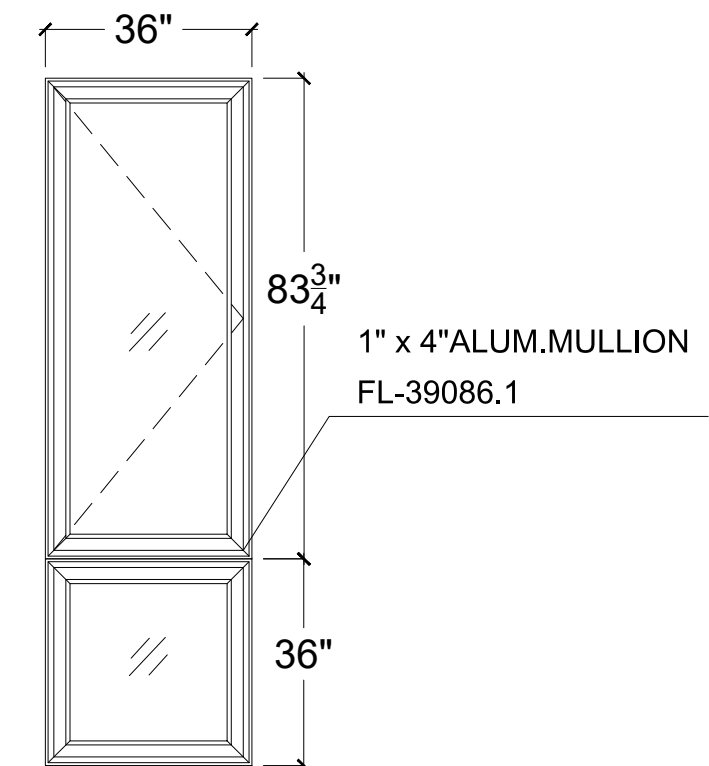

01W2 02W2 03W2

QTY= 3

CASEMENT WINDOW ES-P252 L.M.I.
FL-20692.1
CASEMENT WINDOW ES-P252 FIXED L.M.I.
FL-26359.1


WINDOWS AND DOORS
CASA ROBLES 131
6545 SW STREET PINECREST,
FLORIDA 33156

No.	Revision/Issue	Date


PERMIT

Sheet Name
WINDOWS AND DOORS
ELEVATION


Drawn by J. REY	Sheet 15
Date 07/31/2025	
Scale 3/4"=1'	

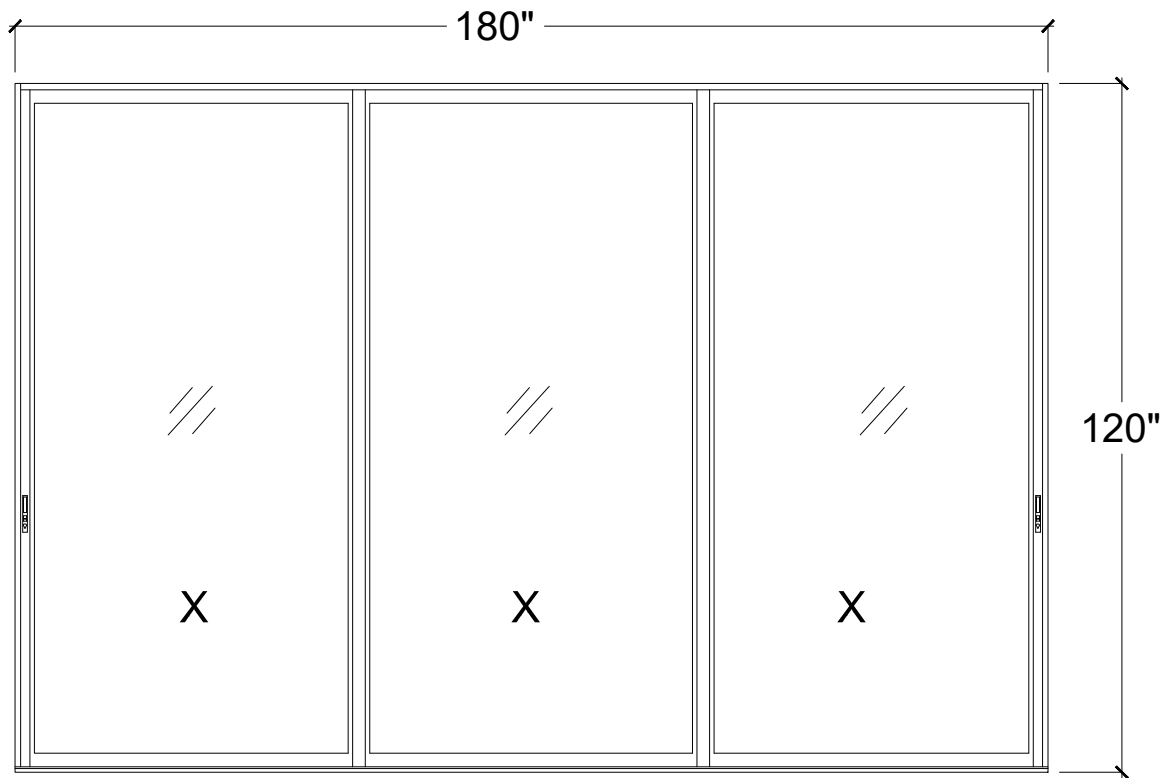

102B 111 112
QTY= 3
SLIDING GLASS DOORS ES-SGD2020 LMI
FL-22267.1

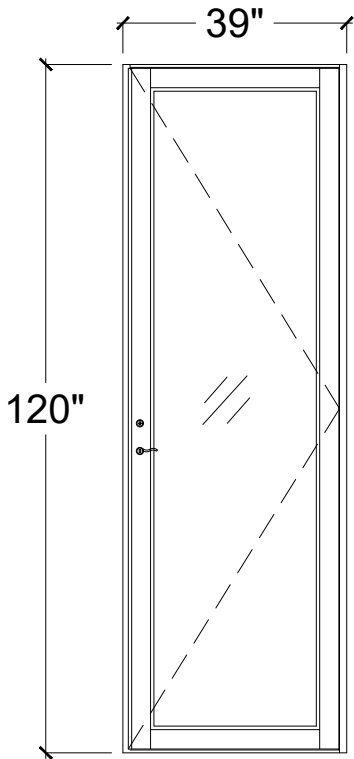

106B 110
QTY= 2
SWING DOOR ES9000 L.M.I
FL-22527.2

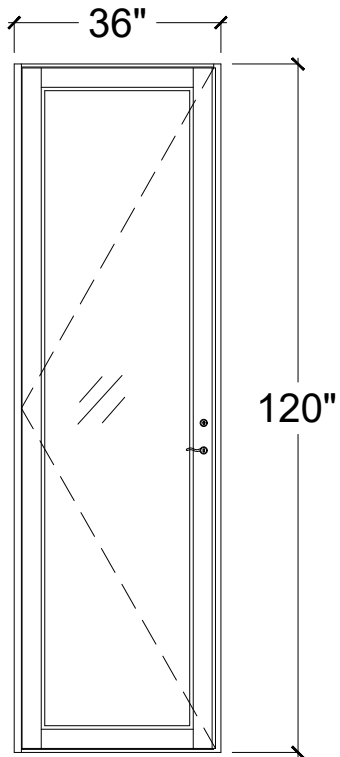

126A
QTY= 1
SWING DOOR ES9000 L.M.I
FL-22527.2


WINDOWS AND DOORS
CASA ROBLES 131
6545 SW STREET PINECREST,
FLORIDA 33156

No.	Revision/Issue	Date


PERMIT

Sheet Name
WINDOWS AND DOORS
ELEVATION

Drawn by J. REY	Sheet 16
Date 07/31/2025	
Scale 3/4"=1'	

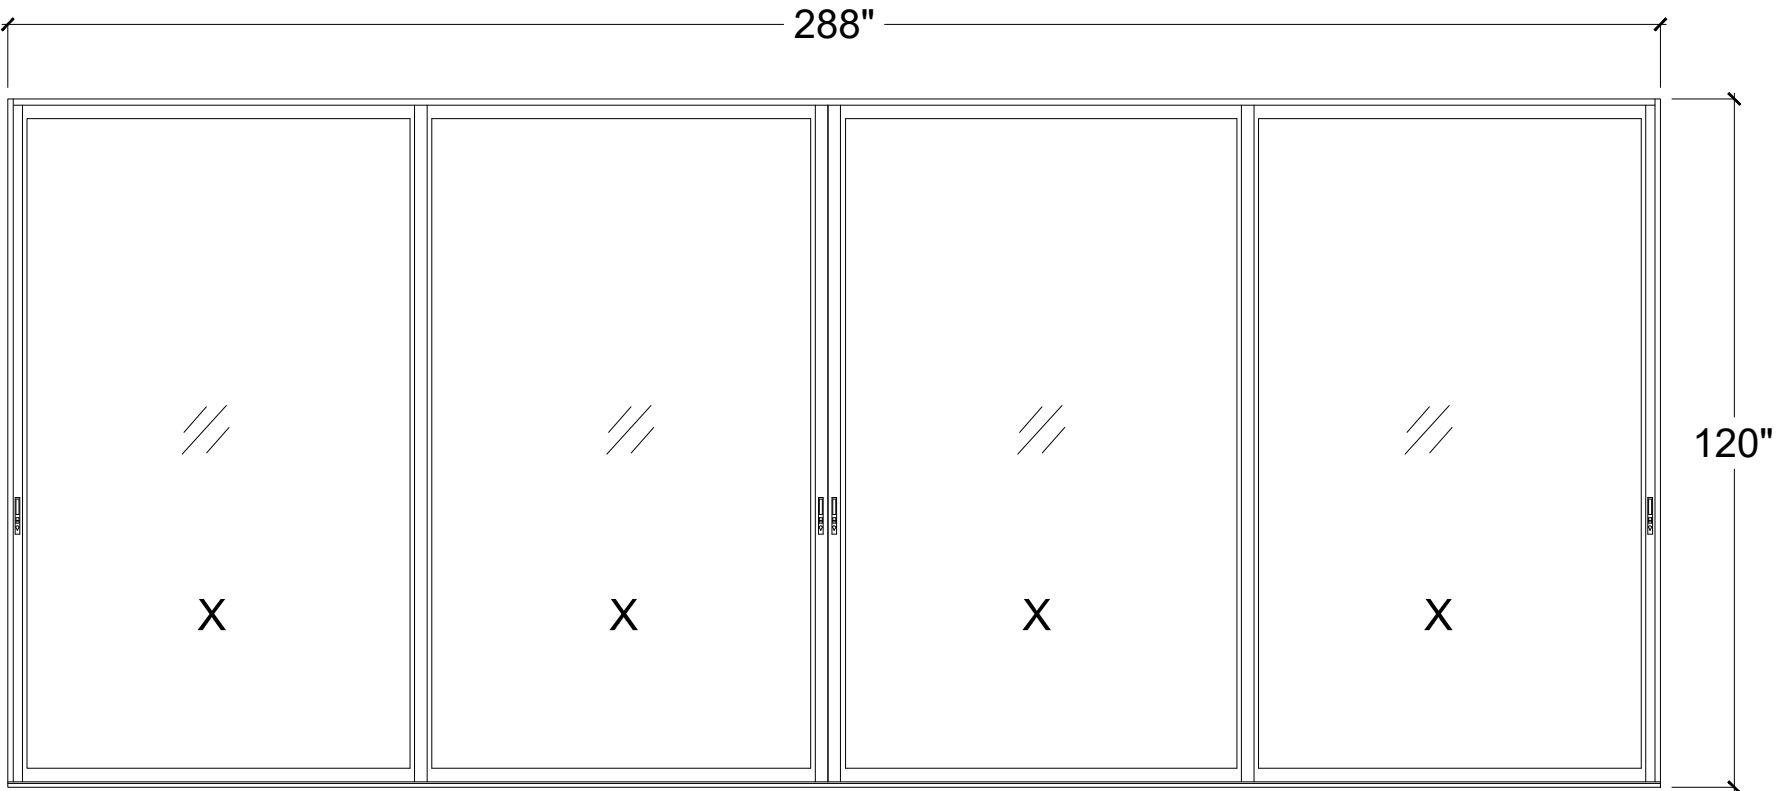

101 124
QTY= 1
SLIDING GLASS DOORS ES-SGD2020 LMI
FL-22267.1

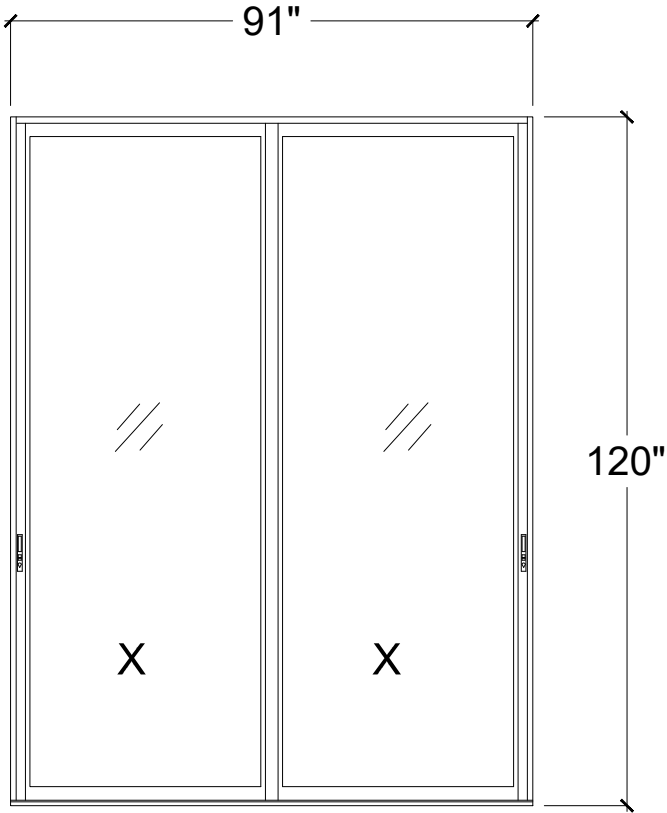

200
QTY= 1
SLIDING GLASS DOORS ES-SGD2020 LMI
FL-22267.1


WINDOWS AND DOORS
CASA ROBLES 131
6545 SW STREET PINECREST,
FLORIDA 33156

No.	Revision/Issue	Date

PERMIT

Sheet Name
WINDOWS AND DOORS
ELEVATION

Drawn by J. REY	Sheet 17
Date 07/31/2025	
Scale 3/4"=1'	

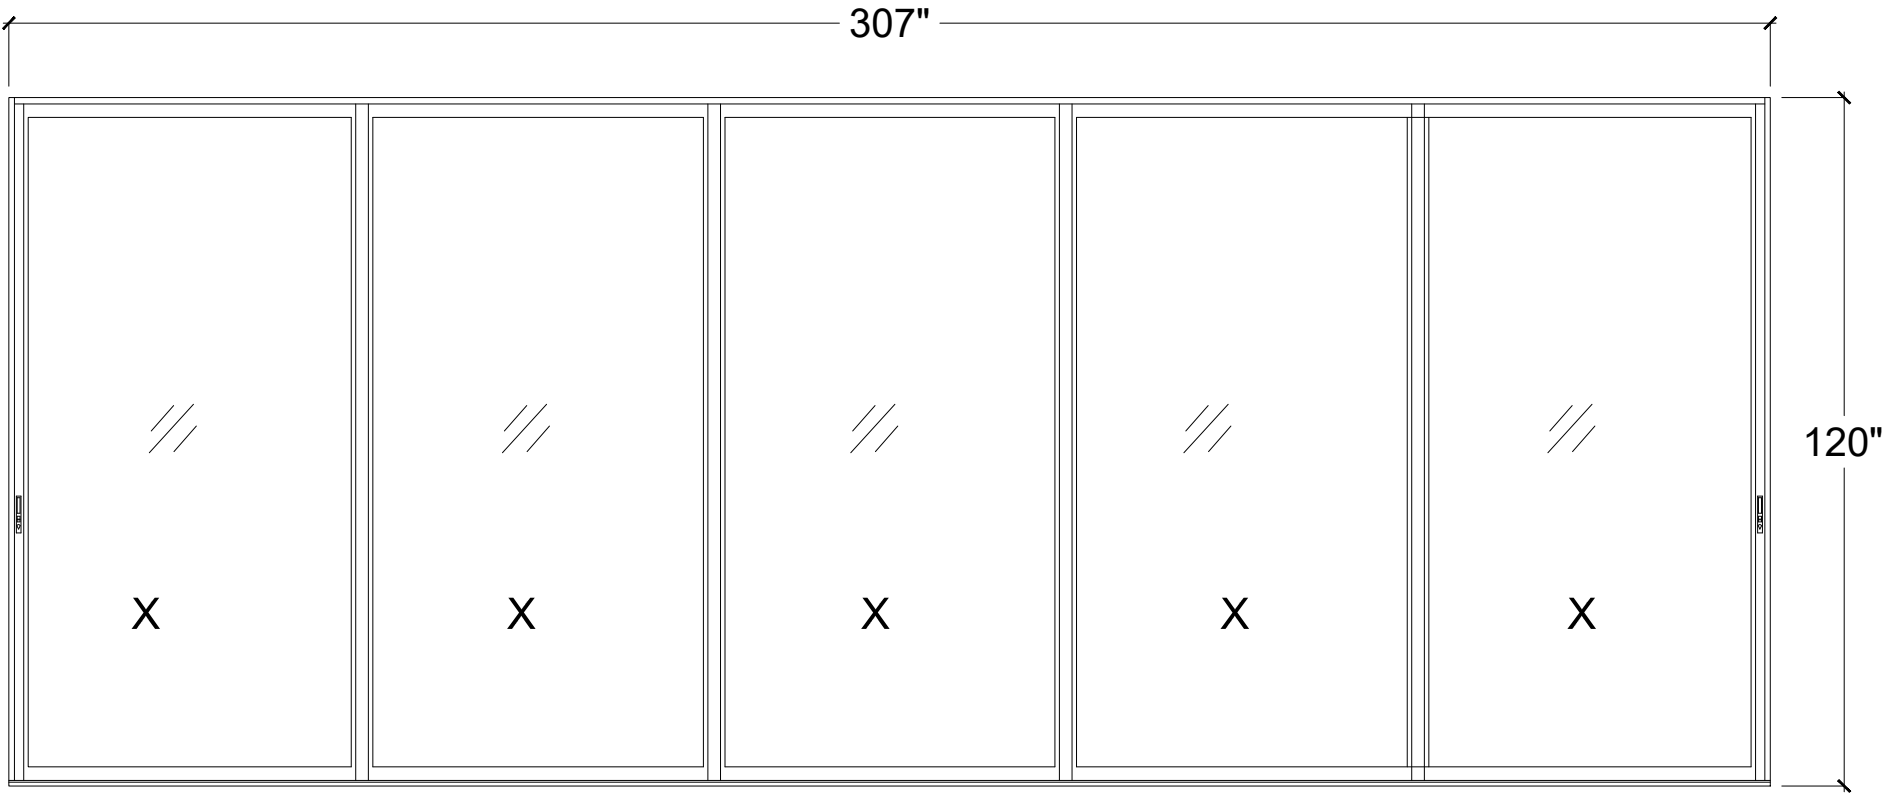

201

QTY= 1

SLIDING GLASS DOORS ES-SGD2020 LMI
FL-22267.1

WINDOWS AND DOORS


CASA ROBLES 131
6545 SW STREET PINECREST,
FLORIDA 33156

No.	Revision/Issue	Date

PERMIT

Sheet Name
WINDOWS AND DOORS
ELEVATION


Drawn by J. REY	Sheet 18
Date 07/31/2025	
Scale 3/4"=1'	

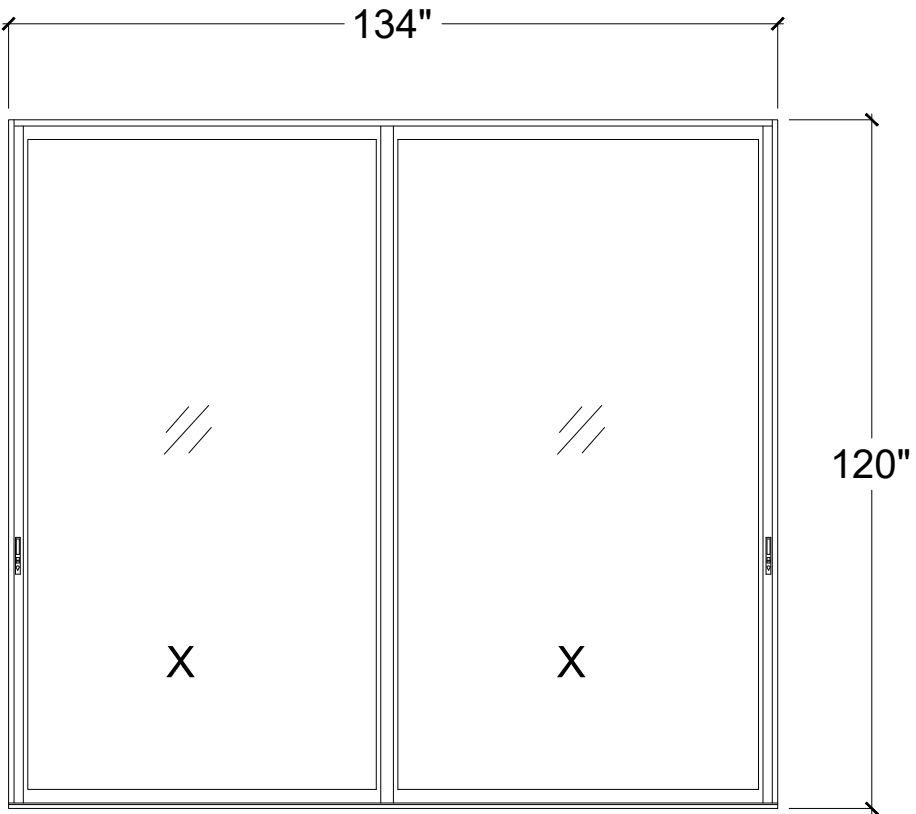

217B

QTY= 1

SLIDING GLASS DOORS ES-SGD2020 LMI
FL-22267.1

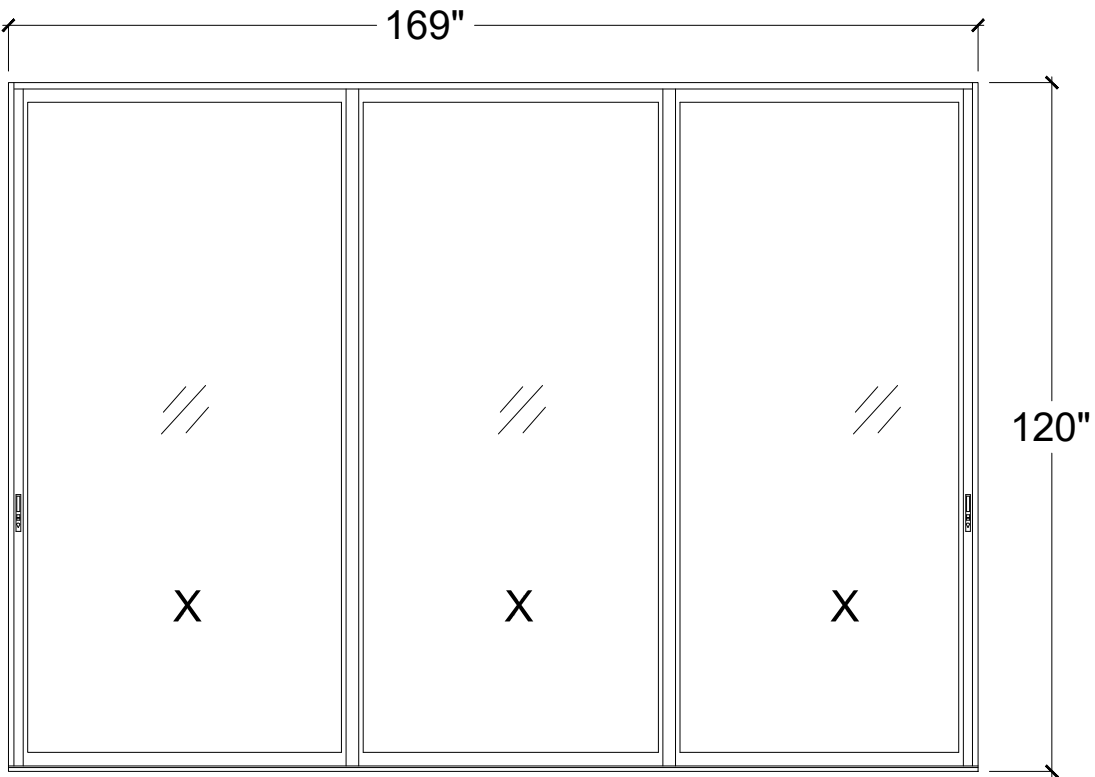

223B

QTY= 1

SLIDING GLASS DOORS ES-SGD2020 LMI
FL-22267.1

WINDOWS AND DOORS

CASA ROBLES 131
6545 SW STREET PINECREST,
FLORIDA 33156

No.	Revision/Issue	Date

PERMIT

Sheet Name
WINDOWS AND DOORS ELEVATION

Drawn by J. REY	Sheet 19
Date 07/31/2025	
Scale 3/4"=1'	

WINDOWS AND DOORS SCHEDULE										
OPENING	DESCRIPTION	GLASS	TINT	FRAME COLOR	PANEL STYLE	WIDTH	HEIGHT	MANUF. /MODEL	TESTED WINDOW PRESSURE(P.S.F.)	N.O.A.
01S1	WINDOW WALL SYSTEM IMPACT RESISTANT	LAM.INSUL.	GREY LOW E	BRONZE	O	20 ³ / ₄ "	117"	ES WINDOWS SERIES ES8000T	+60 -70	FL-17897.5
02S1	WINDOW WALL SYSTEM IMPACT RESISTANT	LAM.INSUL.	GREY LOW E	BRONZE	O	20 ³ / ₄ "	117"	ES WINDOWS SERIES ES8000T	+60 -70	FL-17897.5
03S1	WINDOW WALL SYSTEM IMPACT RESISTANT	LAM.INSUL.	GREY LOW E	BRONZE	O	48"	117 ³ / ₄ "	ES WINDOWS SERIES ES8000T	+70 -70	FL-17897.5
04S1	WINDOW WALL SYSTEM IMPACT RESISTANT	LAM.INSUL.	GREY LOW E	BRONZE	O	30"	117 ³ / ₄ "	ES WINDOWS SERIES ES8000T	+70 -70	FL-17897.5
05S1	WINDOW WALL SYSTEM IMPACT RESISTANT	LAM.INSUL.	GREY LOW E	BRONZE	O	66"	117 ³ / ₄ "	ES WINDOWS SERIES ES8000T JUMBO	+70 -70	FL-17897.6
06S1	WINDOW WALL SYSTEM IMPACT RESISTANT	LAM.INSUL.	GREY LOW E	BRONZE	O	20 ³ / ₄ "	117"	ES WINDOWS SERIES ES8000T	+60 -70	FL-17897.5
07S1	WINDOW WALL SYSTEM IMPACT RESISTANT	LAM.INSUL.	GREY LOW E	BRONZE	O	20 ³ / ₄ "	117"	ES WINDOWS SERIES ES8000T	+60 -70	FL-17897.5
08S1	WINDOW WALL SYSTEM IMPACT RESISTANT	LAM.INSUL.	GREY LOW E	BRONZE	O	20"	82"	ES WINDOWS SERIES ES8000T	+60 -70	FL-17897.5
09S1	WINDOW WALL SYSTEM IMPACT RESISTANT	LAM.INSUL.	GREY LOW E	BRONZE	O	36"	117 ³ / ₄ "	ES WINDOWS SERIES ES8000T	+60 -70	FL-17897.5
10S1	WINDOW WALL SYSTEM IMPACT RESISTANT	LAM.INSUL.	GREY LOW E	BRONZE	O	83"	24"	ES WINDOWS SERIES ES8000T	+60 -70	FL-17897.5
11S1	WINDOW WALL SYSTEM IMPACT RESISTANT	LAM.INSUL.	GREY LOW E	BRONZE	O	(3) 36 ¹ / ₄ "	117 ³ / ₄ "	ES WINDOWS SERIES ES8000T	+70 -70	FL-17897.5
12S1	WINDOW WALL SYSTEM IMPACT RESISTANT	LAM.INSUL.	GREY LOW E	BRONZE	O	(2) 31 ⁷ / ₈ "	117 ³ / ₄ "	ES WINDOWS SERIES ES8000T	+70 -70	FL-17897.5
13S1	WINDOW WALL SYSTEM IMPACT RESISTANT	LAM.INSUL.	GREY LOW E	BRONZE	O	(4) 44 ³ / ₈ "	117 ³ / ₄ "	ES WINDOWS SERIES ES8000T	+70 -70	FL-17897.5
14S1	WINDOW WALL SYSTEM IMPACT RESISTANT	LAM.INSUL.	GREY LOW E	BRONZE	O	(3) 39 ¹ / ₂ "	117 ³ / ₄ "	ES WINDOWS SERIES ES8000T	+70 -70	FL-17897.5
15S1	WINDOW WALL SYSTEM IMPACT RESISTANT	LAM.INSUL.	GREY LOW E	BRONZE	O	18"	105"	ES WINDOWS SERIES ES8000T	+120 -120	FL-17897.5
16S1	WINDOW WALL SYSTEM IMPACT RESISTANT	LAM.INSUL.	GREY LOW E	BRONZE	O	20 ³ / ₄ "	117"	ES WINDOWS SERIES ES8000T	+60 -70	FL-17897.5
17S1	WINDOW WALL SYSTEM IMPACT RESISTANT	LAM.INSUL.	GREY LOW E	BRONZE	O	36"	117 ³ / ₄ "	ES WINDOWS SERIES ES8000T	+60 -70	FL-17897.5
18S1	WINDOW WALL SYSTEM IMPACT RESISTANT	LAM.INSUL.	GREY LOW E	BRONZE	O	45"	86"	ES WINDOWS SERIES ES8000T	+120 -120	FL-17897.5
19S1	WINDOW WALL SYSTEM IMPACT RESISTANT	LAM.INSUL.	GREY LOW E	BRONZE	O	45"	86"	ES WINDOWS SERIES ES8000T	+120 -120	FL-17897.5
20S1	WINDOW WALL SYSTEM IMPACT RESISTANT	LAM.INSUL.	GREY LOW E	BRONZE	O	45"	86"	ES WINDOWS SERIES ES8000T	+120 -120	FL-17897.5

WINDOWS AND DOORS
CASA ROBLES 131
6545 SW STREET PINECREST,
FLORIDA 33156

No.	Revision/Issue	Date
-----	----------------	------

PERMIT

Sheet Name
WINDOWS AND DOORS
SCHEDULE

Drawn by J. REY	Sheet 20
Date 07/31/2025	
Scale N/A	

WINDOWS AND DOORS SCHEDULE										
OPENING	DESCRIPTION	GLASS	TINT	FRAME COLOR	PANEL STYLE	WIDTH	HEIGHT	MANUF. /MODEL	TESTED WINDOW PRESSURE(P.S.F.)	N.O.A.
21S1	WINDOW WALL SYSTEM IMPACT RESISTANT	LAM.INSUL.	GREY LOW E	BRONZE	O	45"	86"	ES WINDOWS SERIES ES8000T	+120 -120	FL-17897.5
22S1	WINDOW WALL SYSTEM IMPACT RESISTANT	LAM.INSUL.	GREY LOW E	BRONZE	O	45"	86"	ES WINDOWS SERIES ES8000T	+120 -120	FL-17897.5
23S1	WINDOW WALL SYSTEM IMPACT RESISTANT	LAM.INSUL.	GREY LOW E	BRONZE	O	49"	86"	ES WINDOWS SERIES ES8000T	+70 -70	FL-17897.5
24S1	WINDOW WALL SYSTEM IMPACT RESISTANT	LAM.INSUL.	GREY LOW E	BRONZE	O	48"	86"	ES WINDOWS SERIES ES8000T	+70 -70	FL-17897.5
25S1	WINDOW WALL SYSTEM IMPACT RESISTANT	LAM.INSUL.	GREY LOW E	BRONZE	O	49"	86"	ES WINDOWS SERIES ES8000T	+70 -70	FL-17897.5
26S1	WINDOW WALL SYSTEM IMPACT RESISTANT	LAM.INSUL.	GREY LOW E	BRONZE	O	46"	117 ³ / ₄ "	ES WINDOWS SERIES ES8000T	+60 -60	FL-17897.5
27S1	WINDOW WALL SYSTEM IMPACT RESISTANT	LAM.INSUL.	GREY LOW E	BRONZE	O	44 ³ / ₄ "	149"	ES WINDOWS SERIES ES8000T JUMBO	+70 -70	FL-17897.6
28S1	WINDOW WALL SYSTEM IMPACT RESISTANT	LAM.INSUL.	GREY LOW E	BRONZE	O	80 ¹ / ₂ "	149"	ES WINDOWS SERIES ES8000T JUMBO	+70 -70	FL-17897.6
29S1	WINDOW WALL SYSTEM IMPACT RESISTANT	LAM.INSUL.	GREY LOW E	BRONZE	O	45 ¹ / ₂ "	149"	ES WINDOWS SERIES ES8000T JUMBO	+70 -70	FL-17897.6
30S1	WINDOW WALL SYSTEM IMPACT RESISTANT	LAM.INSUL.	GREY LOW E	BRONZE	O	46 ³ / ₄ "	149"	ES WINDOWS SERIES ES8000T JUMBO	+70 -70	FL-17897.6
31S1	WINDOW WALL SYSTEM IMPACT RESISTANT	LAM.INSUL.	GREY LOW E	BRONZE	O	48"	117 ³ / ₄ "	ES WINDOWS SERIES ES8000T	+70 -70	FL-17897.5
32S1	WINDOW WALL SYSTEM IMPACT RESISTANT	LAM.INSUL.	GREY LOW E	BRONZE	O	(2) 47 ¹ / ₂ "	117 ³ / ₄ "	ES WINDOWS SERIES ES8000T	+70 -70	FL-17897.5
33S1	WINDOW WALL SYSTEM IMPACT RESISTANT	LAM.INSUL.	GREY LOW E	BRONZE	O	(2) 51"	117 ³ / ₄ "	ES WINDOWS SERIES ES8000T	+70 -70	FL-17897.5
34S1	WINDOW WALL SYSTEM IMPACT RESISTANT	LAM.INSUL.	GREY LOW E	BRONZE	O	18"	103"	ES WINDOWS SERIES ES8000T	+120 -120	FL-17897.5
35S1	WINDOW WALL SYSTEM IMPACT RESISTANT	LAM.INSUL.	GREY LOW E	BRONZE	O	18"	62"	ES WINDOWS SERIES ES8000T	+60 -60	FL-17897.5
36S1	WINDOW WALL SYSTEM IMPACT RESISTANT	LAM.INSUL.	GREY LOW E	BRONZE	O	18"	71"	ES WINDOWS SERIES ES8000T	+60 -60	FL-17897.5
37S1	WINDOW WALL SYSTEM IMPACT RESISTANT	LAM.INSUL.	GREY LOW E	BRONZE	O	18"	67"	ES WINDOWS SERIES ES8000T	+60 -60	FL-17897.5
38S1	WINDOW WALL SYSTEM IMPACT RESISTANT	LAM.INSUL.	GREY LOW E	BRONZE	O	70"	117 ³ / ₄ "	ES WINDOWS SERIES ES8000T JUMBO	+70 -70	FL-17897.6
39S2	WINDOW WALL SYSTEM IMPACT RESISTANT	LAM.INSUL.	GREY LOW E	BRONZE	O	70"	117 ³ / ₄ "	ES WINDOWS SERIES ES8000T JUMBO	+70 -70	FL-17897.6

WINDOWS AND DOORS
CASA ROBLES 131
6545 SW STREET PINECREST,
FLORIDA 33156

No.	Revision/Issue	Date

PERMIT

Sheet Name	
WINDOWS AND DOORS SCHEDULE	

Drawn by J. REY	Sheet 21
Date 07/31/2025	
Scale N/A	

WINDOWS AND DOORS SCHEDULE										
OPENING	DESCRIPTION	GLASS	TINT	FRAME COLOR	PANEL STYLE	WIDTH	HEIGHT	MANUF. /MODEL	TESTED WINDOW PRESSURE(P.S.F.)	N.O.A.
01S2	WINDOW WALL SYSTEM IMPACT RESISTANT	LAM.INSUL.	GREY LOW E	BRONZE	O	(2) 20 ³ / ₄ "	117 ³ / ₄ "	ES WINDOWS SERIES ES8000T	+60 -70	FL-17897.5
01S2	WINDOW WALL SYSTEM IMPACT RESISTANT	LAM.INSUL.	GREY LOW E	BRONZE	O	72 ¹ / ₂ "	117 ³ / ₄ "	ES WINDOWS SERIES ES8000T JUMBO	+70 -70	FL-17897.6
02S2	WINDOW WALL SYSTEM IMPACT RESISTANT	LAM.INSUL.	GREY LOW E	BRONZE	O	58"	83 ¹ / ₂ "	ES WINDOWS SERIES ES8000T JUMBO	+70 -70	FL-17897.6
03S2	WINDOW WALL SYSTEM IMPACT RESISTANT	LAM.INSUL.	GREY LOW E	BRONZE	O	58"	83 ¹ / ₂ "	ES WINDOWS SERIES ES8000T JUMBO	+70 -70	FL-17897.6
04S2	WINDOW WALL SYSTEM IMPACT RESISTANT	LAM.INSUL.	GREY LOW E	BRONZE	O	30"	117 ³ / ₄ "	ES WINDOWS SERIES ES8000T	+60 -70	FL-17897.5
05S2	WINDOW WALL SYSTEM IMPACT RESISTANT	LAM.INSUL.	GREY LOW E	BRONZE	O	24"	106 ³ / ₄ "	ES WINDOWS SERIES ES8000T	+60 -70	FL-17897.5
06S2	WINDOW WALL SYSTEM IMPACT RESISTANT	LAM.INSUL.	GREY LOW E	BRONZE	O	24"	106 ³ / ₄ "	ES WINDOWS SERIES ES8000T	+60 -70	FL-17897.5
07S2	WINDOW WALL SYSTEM IMPACT RESISTANT	LAM.INSUL.	GREY LOW E	BRONZE	O	24"	106 ³ / ₄ "	ES WINDOWS SERIES ES8000T	+60 -70	FL-17897.5
08S2	WINDOW WALL SYSTEM IMPACT RESISTANT	LAM.INSUL.	GREY LOW E	BRONZE	O	24"	106 ³ / ₄ "	ES WINDOWS SERIES ES8000T	+60 -70	FL-17897.5
09S2	WINDOW WALL SYSTEM IMPACT RESISTANT	LAM.INSUL.	GREY LOW E	BRONZE	O	24"	106 ³ / ₄ "	ES WINDOWS SERIES ES8000T	+60 -70	FL-17897.5
10S2	WINDOW WALL SYSTEM IMPACT RESISTANT	LAM.INSUL.	GREY LOW E	BRONZE	O	40"	117 ³ / ₄ "	ES WINDOWS SERIES ES8000T	+60 -70	FL-17897.5
17S2	WINDOW WALL SYSTEM IMPACT RESISTANT	LAM.INSUL.	GREY LOW E	BRONZE	O	18"	117 ³ / ₄ "	ES WINDOWS SERIES ES8000T	+60 -70	FL-17897.5
18S2	WINDOW WALL SYSTEM IMPACT RESISTANT	LAM.INSUL.	GREY LOW E	BRONZE	O	18"	117 ³ / ₄ "	ES WINDOWS SERIES ES8000T	+60 -70	FL-17897.5

WINDOWS AND DOORS
CASA ROBLES 131
6545 SW STREET PINECREST,
FLORIDA 33156

No.	Revision/Issue	Date

PERMIT

Sheet Name
WINDOWS AND DOORS
SCHEDULE

Drawn by J. REY	Sheet 22
Date 07/31/2025	
Scale N/A	

WINDOWS AND DOORS SCHEDULE										
OPENING	DESCRIPTION	GLASS	TINT	FRAME COLOR	PANEL STYLE	WIDTH	HEIGHT	MANUF. /MODEL	TESTED WINDOW PRESSURE(P.S.F.)	N.O.A.
19S2	WINDOW WALL SYSTEM IMPACT RESISTANT	LAM.INSUL.	GREY LOW E	BRONZE	O	46"	117 ³ / ₄ "	ES WINDOWS SERIES ES8000T	+60 -70	FL-17897.5
20S2	WINDOW WALL SYSTEM IMPACT RESISTANT	LAM.INSUL.	GREY LOW E	BRONZE	O	44 ³ / ₄ "	23 ¹ / ₂ "	ES WINDOWS SERIES ES8000T	+60 -70	FL-17897.5
21S2	WINDOW WALL SYSTEM IMPACT RESISTANT	LAM.INSUL.	GREY LOW E	BRONZE	O	44 ³ / ₄ "	93 ¹ / ₂ "	ES WINDOWS SERIES ES8000T	+60 -70	FL-17897.5
22S2	WINDOW WALL SYSTEM IMPACT RESISTANT	LAM.INSUL.	GREY LOW E	BRONZE	O	23 ¹ / ₂ "	80 ¹ / ₂ "	ES WINDOWS SERIES ES8000T	+60 -70	FL-17897.5
23S2	WINDOW WALL SYSTEM IMPACT RESISTANT	LAM.INSUL.	GREY LOW E	BRONZE	O	80 ¹ / ₂ "	93 ¹ / ₂ "	ES WINDOWS SERIES ES8000T JUMBO	+70 -70	FL-17897.6
24S2	WINDOW WALL SYSTEM IMPACT RESISTANT	LAM.INSUL.	GREY LOW E	BRONZE	O	45 ¹ / ₂ "	23 ¹ / ₂ "	ES WINDOWS SERIES ES8000T	+60 -70	FL-17897.5
25S2	WINDOW WALL SYSTEM IMPACT RESISTANT	LAM.INSUL.	GREY LOW E	BRONZE	O	45 ¹ / ₂ "	93 ¹ / ₂ "	ES WINDOWS SERIES ES8000T	+60 -70	FL-17897.5
26S2	WINDOW WALL SYSTEM IMPACT RESISTANT	LAM.INSUL.	GREY LOW E	BRONZE	O	46 ³ / ₄ "	23 ¹ / ₂ "	ES WINDOWS SERIES ES8000T	+60 -70	FL-17897.5
27S2	WINDOW WALL SYSTEM IMPACT RESISTANT	LAM.INSUL.	GREY LOW E	BRONZE	O	46 ³ / ₄ "	93 ¹ / ₂ "	ES WINDOWS SERIES ES8000T	+60 -70	FL-17897.5
29S2	WINDOW WALL SYSTEM IMPACT RESISTANT	LAM.INSUL.	GREY LOW E	BRONZE	O	(2) 50 ¹ / ₂ "	117 ³ / ₄ "	ES WINDOWS SERIES ES8000T	+60 -70	FL-17897.5
30S2	WINDOW WALL SYSTEM IMPACT RESISTANT	LAM.INSUL.	GREY LOW E	BRONZE	O	111 ¹ / ₂ "	18"	ES WINDOWS SERIES ES8000T	+60 -70	FL-17897.5
01W1	ALUMINUM CASEMENT WINDOW IMPACT RESISTANT	LAM.INSUL.	CLEAR	BRONZE	XR	36"	83 ³ / ₄ "	ES WINDOWS SERIES ESP252	+70 -75	FL-20695.1
01W1	ALUMINUM CASEMENT FIXED WINDOW IMPACT RESISTANT	LAM.INSUL.	CLEAR	BRONZE	O	36"	36"	ES WINDOWS SERIES ESP252 F	+110 -150	FL-26359.1
01W2	ALUMINUM CASEMENT WINDOW IMPACT RESISTANT	LAM.INSUL.	CLEAR	BRONZE	XR	36"	83 ³ / ₄ "	ES WINDOWS SERIES ESP252	+70 -75	FL-20695.1
01W2	ALUMINUM CASEMENT FIXED WINDOW IMPACT RESISTANT	LAM.INSUL.	CLEAR	BRONZE	O	36"	36"	ES WINDOWS SERIES ESP252 F	+110 -150	FL-26359.1
02W2	ALUMINUM CASEMENT WINDOW IMPACT RESISTANT	LAM.INSUL.	CLEAR	BRONZE	XR	36"	83 ³ / ₄ "	ES WINDOWS SERIES ESP252	+70 -75	FL-20695.1
02W2	ALUMINUM CASEMENT FIXED WINDOW IMPACT RESISTANT	LAM.INSUL.	CLEAR	BRONZE	O	36"	36"	ES WINDOWS SERIES ESP252 F	+110 -150	FL-26359.1
03W2	ALUMINUM CASEMENT WINDOW IMPACT RESISTANT	LAM.INSUL.	CLEAR	BRONZE	XR	36"	83 ³ / ₄ "	ES WINDOWS SERIES ESP252	+70 -75	FL-20695.1
03W2	ALUMINUM CASEMENT FIXED WINDOW IMPACT RESISTANT	LAM.INSUL.	CLEAR	BRONZE	O	36"	36"	ES WINDOWS SERIES ESP252 F	+110 -150	FL-26359.1

WINDOWS AND DOORS
CASA ROBLES 131
6545 SW STREET PINECREST,
FLORIDA 33156

No.	Revision/Issue	Date

PERMIT

Sheet Name	
WINDOWS AND DOORS SCHEDULE	

Drawn by J. REY	Sheet 23
Date 07/31/2025	
Scale N/A	

WINDOWS AND DOORS SCHEDULE										
OPENING	DESCRIPTION	GLASS	TINT	FRAME COLOR	PANEL STYLE	WIDTH	HEIGHT	MANUF. /MODEL	TESTED WINDOW PRESSURE(P.S.F.)	N.O.A.
101	ALUMINUM SLIDING GLASS DOOR IMPACT RESISTANT	LAM.INSUL.	GREY LOW E	BRONZE	XXXX	288"	120"	ES WINDOWS SERIES ES2020	+70 -80	FL-22267.1
102B	ALUMINUM SLIDING GLASS DOOR IMPACT RESISTANT	LAM.INSUL.	GREY LOW E	BRONZE	XXX	180"	120"	ES WINDOWS SERIES ES2020	+70 -80	FL-22267.1
106B	ALUMINUM OUTSWING DOOR IMPACT RESISTANT	LAM.INSUL.	GREY LOW E	BRONZE	XR	39"	120"	ES WINDOWS SERIES ES9000	+90 -90	FL-22527.2
110	ALUMINUM OUTSWING DOOR IMPACT RESISTANT	LAM.INSUL.	GREY LOW E	BRONZE	XR	39"	120"	ES WINDOWS SERIES ES9000	+90 -90	FL-22527.2
111	ALUMINUM SLIDING GLASS DOOR IMPACT RESISTANT	LAM.INSUL.	GREY LOW E	BRONZE	XXX	180"	120"	ES WINDOWS SERIES ES2020	+70 -80	FL-22267.1
112	ALUMINUM SLIDING GLASS DOOR IMPACT RESISTANT	LAM.INSUL.	GREY LOW E	BRONZE	XXX	180"	120"	ES WINDOWS SERIES ES2020	+70 -80	FL-22267.1
124	ALUMINUM SLIDING GLASS DOOR IMPACT RESISTANT	LAM.INSUL.	GREY LOW E	BRONZE	XXXX	288"	120"	ES WINDOWS SERIES ES2020	+70 -80	FL-22267.1
126A	ALUMINUM OUTSWING DOOR IMPACT RESISTANT	LAM.INSUL.	GREY LOW E	BRONZE	XL	36"	120"	ES WINDOWS SERIES ES9000	+90 -90	FL-22527.2
200	ALUMINUM SLIDING GLASS DOOR IMPACT RESISTANT	LAM.INSUL.	GREY LOW E	BRONZE	XX	91"	120"	ES WINDOWS SERIES ES2020	+70 -80	FL-22267.1
201	ALUMINUM SLIDING GLASS DOOR IMPACT RESISTANT	LAM.INSUL.	GREY LOW E	BRONZE	XXXXX	307"	120"	ES WINDOWS SERIES ES2020	+70 -80	FL-22267.1
217B	ALUMINUM SLIDING GLASS DOOR IMPACT RESISTANT	LAM.INSUL.	GREY LOW E	BRONZE	XX	134"	120"	ES WINDOWS SERIES ES2020	+70 -80	FL-22267.1
223B	ALUMINUM SLIDING GLASS DOOR IMPACT RESISTANT	LAM.INSUL.	GREY LOW E	BRONZE	XXX	169"	120"	ES WINDOWS SERIES ES2020	+70 -80	FL-22267.1

WINDOWS AND DOORS
CASA ROBLES 131
6545 SW STREET PINECREST,
FLORIDA 33156

No.	Revision/Issue	Date

PERMIT

Sheet Name
WINDOWS AND DOORS
SCHEDULE

Drawn by J. REY	Sheet 24
Date 07/31/2025	
Scale N/A	