

BL2025-0584 APPROVED
vwaiters02/11/20262:38:00 PM



MEP ENGINEER
RD-ENGINEERS

STRUCTURAL ENGINEER
PALACIOS ENGINEERING

NEW CONSTRUCTION
AGD CALISTONE LLC
10840 SW 67 AVE



MIK ARCHITECTURE LLC
MATIAS DAROCH
AR-100480

1385 CORAL WAY, SUITE 202
MIAMI, FLORIDA 33145
+1 786 708 0880
hello@mikarch.com



AGD DEVELOPERS LLC
1385 CORAL WAY, SUITE 202
MIAMI, FLORIDA 33145
+1 786 805 7445
developers@agdmiami.com

CIVIL ENGINEER
CARLAB INC

LANDSCAPE ARCHITECT
LANDSTUDIO



GENERAL PROJECT NOTES

- 1 THE ARCHITECT/ENGINEER SHALL NOT BE RESPONSIBLE FOR, NOR HAVE CONTROL, OR CHANGE OF THE CONSTRUCTION MEANS, METHODS, SEQUENCES OR PROCEDURES OR FOR SAFETY PRECAUTIONS AND PROGRAMS.
- 2 ALL WORK SHALL BE DONE IN ACCORDANCE WITH THE FLORIDA BUILDING CODE AND ALL REGULATORY LEGAL AND GOVERNMENTAL CODES.
- 3 CONTRACTOR SHALL VERIFY ALL DIMENSIONS AND CONDITIONS AND SHALL NOTIFY THE ARCHITECT IF ANY DISCREPANCIES ARE DISCOVERED BEFORE PROCEEDING WITH THE WORK.
- 4 CONTRACTOR TO ACQUIRE ALL REQUIRED PERMITS FOR THE CONSTRUCTION AND SUBSEQUENT OCCUPANCY OF THE PROJECT.
- 5 ALL WORK DONE UNDER THE SUPERVISION OF THE CONTRACTOR SHALL BE DONE IN A NEAT AND WORKMANLIKE MANNER AND IN ACCORDANCE WITH ALL GOVERNING AGENCIES, RULES AND REGULATIONS HAVING JURISDICTION.
- 6 GENERAL CONTRACTOR SHALL VISIT THE JOBSITE TO FAMILIARIZE HIMSELF WITH THE EXISTING CONDITIONS AND THE GENERAL SCOPE OF WORK. ANY EXISTING ITEMS AND/OR CONDITIONS NOT SHOWN ON THESE DRAWINGS OR THOSE THAT FOLLOW AND/OR ARE INFERABLE AND NECESSARY TO BE REMOVED OR MODIFIED, SHALL BE DONE SO WITHOUT ANY ADDITIONAL TIME AND/OR EXPENSE TO THIS CONTRACT.
- 7 GENERAL CONTRACTOR SHALL COORDINATE ARCHITECTURAL DRAWINGS WITH MECHANICAL, ELECTRICAL, PLUMBING AND SPRINKLER DRAWINGS.
- 8 ANY DISCREPANCY IN THE CONTRACT DOCUMENTS MUST BE BROUGHT TO THE ATTENTION OF ARCHITECT, FAILURE TO DO SO MAY RESULT IN REDO OF FINISHED WORK THAT DOES NOT ADHERE TO THE INTENT OF THE CONTRACT DOCUMENTS.
- 9 THE GENERAL CONTRACTOR GUARANTEES AND WARRANTS THAT ALL WORK PERFORMED SHALL BE FREE FROM DEFECTS IN MATERIAL AND WORKMANSHIP FOR A PERIOD OF ONE YEAR AFTER THE ISSUANCE OF THE CERTIFICATE OF FINAL COMPLETION ANY DEFECTS OR DAMAGE DISCOVERED DURING SAID PERIOD SHALL BE REPAIRED OR REPLACED, AS DIRECTED IN WRITING BY THE ARCHITECT, AT NO ADDITIONAL COST.
- 10 THE CONTRACTOR SHALL PROVIDE ALL SUPPLEMENTAL MATERIAL REQUIRED TO PROPERLY INSTALL SUPPORT, BRACE, ALL ITEMS AND COMPONENTS WITHIN THE WORK.
- 11 CONTRACTOR TO PROVIDE SHORING (RESHORING) DRAWINGS AND CALCULATIONS FOR REVIEW AND APPROVAL FOR THE CITY OF MIAMI.
- 12 PRIOR TO COMMENCING WORK, THE CONTRACTOR SHALL VERIFY THE LOCATION OF ALL EQUIPMENT AND UTILITIES TO BE REMOVED. REMOVALS SHALL BE COORDINATED WITH THE OWNER AND ALL BUILDING AUTHORITIES HAVING JURISDICTION.
- 13 CONTRACTOR SHALL PROVIDE THE ARCHITECT WITH RED-LINED AS-BUILT DRAWINGS FOR ANY AND ALL FIELD CHANGES AND/OR ADDITIONS TO THE WORK INDICATED IN THE DRAWINGS.
- 14 IF ANY CHANGES AND/OR DEVIATIONS ARE MADE TO THESE PLANS WITHOUT THE WRITTEN AUTHORIZATION OF THE ARCHITECT, THE CONTRACTOR SHALL BEAR FULL RESPONSIBILITY FOR SUCH CHANGES AND/OR DEVIATIONS.
- 15 IF DURING THE COURSE OF CONSTRUCTION ANY DEVIATIONS ARE MADE AT THE FIELD, AGAIN, THE CONTRACTOR SHALL BEAR FULL RESPONSIBILITY FOR SUCH CHANGES AND DEVIATIONS.
- 16 CONTRACTOR SHALL SUBMIT SHOP DRAWINGS FOR ALL CUSTOM FABRICATED WORK. CONTRACTOR SHALL REVIEW/APPROVE ALL SUBMITTAL SHOP DRAWING PRIOR TO SUBMITTING FOR ARCHITECTS REVIEW, FOR DESIGN CONFORMANCE ONLY.
- 17 SUBSTITUTIONS MUST BE REVIEWED AND APPROVED BY THE ARCHITECT OR ENGINEERS.
- 18 IN THE EVENT THERE ARE FOUND DISCREPANCIES OR AMBIGUITIES IN OR OMISSION FROM THE SPECIFICATIONS DRAWINGS, SHOULD THERE BE DOUBT AS TO THEIR MEANING AND INTENT, THE ARCHITECT SHALL BE NOTIFIED IN ORDER TO PROVIDE CLARIFICATION IN THE 30 DAY FOLLOWING THE OWNER'S NOTICE TO PROCEED.
- 19 DO NOT SCALE DRAWING. USE DIMENSION INDICATED IN DRAWINGS. DIMENSIONS FOR LARGER SCALE DRAWINGS AND DETAILS SHALL TAKE PRECEDENCE OVER SMALLER SCALE DRAWINGS. CONTRACTOR SHALL BE RESPONSIBLE FOR ALL DIMENSIONS AND VERIFY SAME IN FIELD.
- 20 ALL REQUIRED TEST SHALL BE PERFORMED BY OWNER. TESTING REQUIRED FOR PRODUCT APPROVAL TO BE PROVIDED BY GENERAL CONTRACTOR AND INCLUDED IN THEIR BID COST.
- 21 COMPLETION CONTRACTOR TO NOTIFY OWNER AND/OR ARCHITECT IN WRITING AT LEAST ONE WEEK PRIOR TO FINAL INSPECTION. FINAL DISBURSEMENT TO CONTRACTOR SHALL NOT BE MADE UNTIL OWNERS AND/OR ARCHITECT PUNCH LIST HAS BEEN SATISFIED. CONTRACTOR TO PROVIDE OWNER WITH WRITTEN GUARANTEE ON ALL EQUIPMENT. CONTRACTOR AT COMPLETION OF WORK SHALL REMOVE FROM THE PREMISES ALL RUBBISH, IMPLEMENTS, EQUIPMENT, AND SURPLUS MATERIALS, LEAVE THE PROJECT "BROOM CLEAN".

ROOF NOTES

- 1 ROOF SYSTEM IS DESIGNED TO PREVENT THE ACCUMULATION OF NO MORE THAN FIVE (5) INCHES OF WATER ON ANY PORTION OF THE ROOF. UNLESS ROOFS ARE DESIGNED TO DRAIN OVER ROOF EDGES, DESIGN AND INSTALLATION OF ROOF DRAINAGE SYSTEMS SHALL COMPLY WITH SECTION 1103 AND THE FLORIDA BUILDING CODE, PLUMBING, CHAPTER 11.
- 2 WHERE ROOF DRAINS ARE REQUIRED, SECONDARY (EMERGENCY OVERFLOW) ROOF DRAINS OR SCUPPERS SHALL BE PROVIDED WHERE THE ROOF PERIMETER CONSTRUCTION EXTENDS ABOVE THE ROOF IN SUCH A MANNER THAT WATER WILL BE ENTRAPPED IF THE PRIMARY DRAINS ALLOW BUILDUP FOR ANY REASON, WHERE PRIMARY AND SECONDARY ROOF DRAINS ARE MANUFACTURED AS A SINGLE ASSEMBLY, THE INLET AND OUTLET FOR EACH DRAIN SHALL BE INDEPENDENT.
- 3 SECONDARY ROOF DRAIN SYSTEMS SHALL HAVE THE END POINT OF DISCHARGE SEPARATE FROM THE PRIMARY SYSTEM. DISCHARGE SHALL BE ABOVE GRADE, IN A LOCATION THAT WOULD NORMALLY BE OBSERVED BY THE BUILDING OCCUPANTS OR MAINTENANCE PERSONNEL.
- 4 SECONDARY (EMERGENCY) ROOF DRAIN SYSTEMS SHALL BE SIZED IN ACCORDANCE WITH SECTION 1106 BASED ON THE RAINFALL RATE FOR WHICH THE PRIMARY SYSTEM IS SIZED. SCUPPERS SHALL BE SIZED TO PREVENT THE DEPTH OF PONDING WATER FROM EXCEEDING THAT FOR WHICH THE ROOF WAS DESIGNED AS DETERMINED BY SECTION 1101.7. SCUPPERS SHALL HAVE AN OPENING DIMENSION OF NOT LESS THAN 4 INCHES (102 MM). THE FLOW THROUGH THE PRIMARY SYSTEM SHALL NOT BE CONSIDERED WHEN SIZING THE SECONDARY ROOF DRAIN SYSTEM, AS PER FBC, P. 1108.
- 5 OVERFLOW DRAINS AND SCUPPERS, WHERE ROOF DRAINS ARE REQUIRED, OVERFLOW DRAINS OR OVERFLOW SCUPPERS SIZED IN ACCORDANCE WITH FLORIDA BUILDING CODE, PLUMBING SHALL BE INSTALLED WITH THE INLET FLOW LINE LOCATED NOT LESS THAN 2 INCHES (51 MM) OR MORE THAN 4 INCHES (102 MM) ABOVE THE LOW POINT OF THE FINISHED 2 INCHES (51 MM) OR MORE THAN 4 INCHES (102 MM) ABOVE THE LOW POINT OF THE FINISHED ROOFING SURFACE, EXCLUDING SUMP. OVERFLOW SCUPPERS SHALL BE A MINIMUM OF 4 INCHES (102 MM) IN ANY DIMENSION AND SHALL BE LOCATED AS CLOSE AS PRACTICAL TO REQUIRED VERTICAL LEADERS, CONDUCTORS OR DOWNSPOUTS. OVERFLOW DRAINS AND SCUPPERS SHALL ALSO COMPLY WITH THE FLORIDA BUILDING CODE, PLUMBING AND SECTION 1617 OF THIS CODE.
- 6 INSTALL BUILT-UP ROOFING MEMBRANE SYSTEM ACCORDING TO ROOFING SYSTEM MANUFACTURER'S WRITTEN INSTRUCTIONS AND APPLICABLE RECOMMENDATIONS OF NRCA "QUALITY CONTROL GUIDELINES FOR THE APPLICATION OF BUILT-UP ROOFING".
- 7 ROOF DRAINAGE DEVICES WITH OVERFLOW TO HAVE LEAF AND DEBRIS SCREENS. ROOF DRAINAGE TO BE CONVEYED TO STREET VIA NON-EROSIVE DEVICES.

CONSTRUCTION NOTES

- 1 ALL INTERIOR CONSTRUCTION SHALL COMPLY WITH ALL APPLICABLE CODES AND ORDINANCES IN PLACE IN THE LOCATION OF WORK. CORRIDORS AND ALL OTHER CLEARANCES SHOULD BE CHECKED WITH ARCHITECT PRIOR THE FABRICATION OF ANY WORK. CONTRACTOR SHALL BE RESPONSIBLE FOR CORRECTING SAME AT HIS OWN EXPENSE.
- 2 ALL ROUGH CARPENTRY WOODWORK SHALL BE TREATED FOR FIRE RETARDATION WITH U.L. APPROVED MATERIAL. FLAME SPREAD RATING NOT TO EXCEED 25.
- 3 CONTRACTOR SHALL FURNISH AND INSTALL NEW ACCESS DOORS WHEREVER REQUIRED FOR PLUMBING, ELECTRICAL, HVAC, SPRINKLER, ETC. SYSTEMS FOR WORK ACCESS AND MAINTENANCE.
- 4 CONTRACTOR SHALL PLACE BACKING IN WALLS THAT SUPPORT UNITIES ACCORDING TO SPECS. AT BATHROOMS, KITCHENS OR WHERE IT IS OTHER NOTED, AND PROVIDE ALL SUCH BLOCKING PRIOR TO CLOSING UP ANY AND ALL WALLS, COLUMNS, ETC. TO MEET SUCH REQUIREMENTS. SEE CARPENTRY SHOP DRAWINGS FOR ALL FIXTURE INFORMATION.
- 5 FILL AND SEAL ALL EXISTING CORE DRILLED HOLES LEFT UNFISHED IN THE FLOOR SLAB AND CEILING SLAB.
- 6 MATERIALS USED AS BACKERS FOR WALL TILE IN TUB AND SHOWER AREAS AND WALL PANELS IN RESIDUOR AREAS SHALL BE OF MATERIALS LISTED IN TABLE R702.4.2 AND INSTALLED IN ACCORDANCE WITH THE MANUFACTURER'S RECOMMENDATIONS. AS PER FBC R702.4.2
- 7 PATCH AND REPAIR OR REPLACE ALL EXISTING AND NEW WORK DAMAGED BY CONSTRUCTION.
- 8 LAMINATE AND/OR PLASTER ALL EXPOSED CORE WALLS, PERIMETER COLUMNS, WALL & SLAB SURFACES WHICH ARE DAMAGE OR MISSING WITH ONE NEW LAYER OF GYPSUM BOARD SHIM IS REQUIRED, UNLESS OTHERWISE NOTED.
- 9 GENERAL CONTRACTOR SHALL REPAIR ANY LOOSE OR MISSING FIREPROOFING ON STRUCTURAL ELEMENTS AND OTHER FIRE RATED ELEMENTS OF THE SPACE.
- 10 NEW WALLS ARE DIMENSIONED TO THE FINISH FACE OF WALL THICKNESS UNLESS OTHERWISE NOTED. ALL GYPSUM BOARD TO BE 5/8" THICKNESS, UNLESS OTHERWISE NOTED. GREEN BOARD, TO BE USED IN TOILETS WHERE PAINT IS USED AND DUROCK IN TOILETS WHERE TILE IS USED.
- 11 MIN SHOWER ACCESS SHALL BE 22" CLEAR.
- 12 BATHUB AND SHOWER FLOORS AND ABOVE BATHUBS WITH INSTALLED SHOWER HEADS AND IN SHOWER COMPARTMENTS AND GLAZING LARGER THAN 9 SQ. FT. SHALL BE CATEGORY II SAFETY GLASS. TO COMPLY WITH FBC B 2406.1 AND/OR FBC R308. MANUFACTURER SHALL STONE GLASS ON SITE READILY ACCESSIBLE FOR INSPECTION.
- 13 REQUIRED GUARDS SHALL NOT HAVE OPENINGS FROM THE WALKING SURFACE TO THE REQUIRED GUARD HEIGHT THAT ALLOW PASSAGE OF A SPHERE 4 INCHES (102 MM) IN DIAMETER. AS PER FBC R312.1.3.
- 14 ANY GLAZING MATERIAL IN ANY WINDOW ADJACENT TO TUB AND SHOWER ENCLOSURES AND/OR ENCLOSURES AND GLAZING LARGER THAN 9 SQ. FT. SHALL BE CATEGORY II SAFETY GLASS. TO COMPLY WITH FBC B 2406.1 AND/OR FBC R308. MANUFACTURER SHALL STONE GLASS ON SITE READILY ACCESSIBLE FOR INSPECTION.
- 15 ALL NEW FINISHES (WALL/CEILING/FLOOR/TRIM/DECOR), ARE TO COMPLY WITH FBCB CHAPTER 8, FOR FLAME SPREAD AND SMOKE DEVELOPMENT CLASSIFICATION.
- 16 OPENINGS FROM A PRIVATE GARAGE DIRECTLY INTO A ROOM USED FOR SLEEPING PURPOSES SHALL NOT BE PERMITTED. OTHER OPENINGS BETWEEN THE GARAGE AND RESIDENCE SHALL BE EQUIPPED WITH SOLID WOOD DOORS NOT LESS THAN 1.38 INCHES (35MM) IN THICKNESS. SOLID OR HONEYCOMB-CORE STEEL DOORS NOT LESS THAN 1.38 INCHES THICK, OR 20-MINUTE FIRE-RATED DOORS.

REFLECTIVE CEILING NOTES

- 1 THE INTENT OF THIS REFLECTED CEILING PLANS IS TO SHOW RELATIONSHIPS BETWEEN WALLS AND CEILING, GLAZING, AND LOCATIONS OF MECHANICAL AND ELECTRICAL FEATURES. FOR COMPLETE MECHANICAL AND ELECTRICAL INFORMATION, REFER TO M.E.P. AND FIRE PROTECTION DRAWINGS.
- 2 NOTIFY ARCHITECT OF ANY DISCREPANCIES BETWEEN THIS REFLECTED CEILING PLAN AND ENGINEERING DRAWINGS FOR CLARIFICATION.
- 3 SUB-CONTRACTOR SHALL VERIFY ALL CEILING PLENUM CONDITIONS TO ASSURE CLEARANCE OF DUCTWORK, PIPING AND OTHER OBSTRUCTION WITH THE CEILING HEIGHTS SPECIFIED, AND THE LOCATIONS OF THE LIGHT FIXTURES SHOWN. SUB- CONTRACTOR SHALL PROVIDE CEILING TRANSITIONS WITH GYPSUM BOARD AND METAL SHADOW MOLDING WHERE LOWER CEILINGS ARE REQUIRED DUE TO CLEARANCE PROBLEMS.
- 4 SUB-CONTRACTOR SHALL SUPPLY ALL GYPSUM BOARD CEILING ACCESS PANELS REQUIRED AND NOTIFY ARCHITECT OF LOCATION PRIOR TO INSTALLATION.
- 5 CEILING HEIGHTS ARE DIMENSIONED IN RELATIONSHIP TO FINISHED FLOOR.
- 6 EMERGENCY LIGHTS SHALL BE INSTALLED ON SEPARATE CIRCUIT. REFER TO ENGINEERING DRAWINGS FOR EMERGENCY LIGHT LOCATIONS.
- 7 COORDINATE LOCATIONS WITH ARCHITECTURAL REFLECTED CEILING PLAN AND WITH ENGINEERING DRAWING FOR SWITCHING CIRCUITS AND FIRE ALARM SYSTEM.
- 7 REFER TO ENGINEERING DRAWINGS FOR LOCATIONS OF NEW AIR SUPPLY AND RETURNS AIR GRILLES.
- 8 ALL HORNS AND STROBES SHALL BE CENTERED ABOVE THE LIGHT SWITCH OR CENTERED ON SURFACE (WALL, COLUMN, ETC.) UNLESS OTHERWISE NOTED. ANY DEVIATION FROM THIS INSTALLATION SHALL RESULT IN CONTRACTOR RELOCATING THE HORNS AND STROBES AT HIS OWN EXPENSE.
- 9 ALL ABANDONED SLAB POKE THROUGH FROM SLAB ABOVE SHALL BE FIRE SAED AS REQUIRED.

SOIL STATEMENT

- 1 THE SOIL CONDITIONS AT THIS SITE ARE UNDISTURBED SAND AND ROCK WHICH IS ADEQUATE TO SUPPORT THE DESIGN LOAD OF 2000 PSF. THIS SITE HAS BEEN OBSERVED AND THE FOUNDATION CONDITIONS ARE SIMILAR TO THOSE UPON WHICH THE FOOTING DESIGN IS BASED. THE FOUNDATION HAS BEEN DESIGNED TO A DESIGN LOAD OF 2000 PSF. A LETTER TO THIS EFFECT WILL BE ISSUED TO THE BUILDINGS INSPECTOR, SIGNED AND SEALED BY THE ARCHITECT. FILL REQUIRED FOR SUPPORT OF SLAB ON GRADE CONDITIONS SHALL BE COMPACTED TO 95% OF MAXIMUM DENSITY UNDER THE SUPERVISION OF A SPECIAL INSPECTOR. A LETTER FROM THE SPECIAL INSPECTOR WILL BE SUBMITTED TO THE BUILDING OFFICIAL AT THE TIME OF INSPECTION.

GENERAL DOOR NOTES

- 1 ALL PRODUCTS APPROVAL DOCUMENTATION SHALL BE SUBMITTED TO THE BUILDING DEPARTMENT AS REQUIRED.
- 2 ALL EXTERIOR DOORS TO HAVE MIAMI DADE COUNTY PRODUCT APPROVAL, UNLESS OTHERWISE NOTED.
- 3 FORCE ENTRY REQUIREMENTS: ALL EXTERIOR DOORS SHALL COMPLY WITH THE REQUIREMENTS OF CHAPTER 36 OF THE S.F.B.C., FOR GROUP OCCUPANCIES.
- 4 STRUCTURAL PERFORMANCE: DOORS SHALL BE DESIGNED AND CONSTRUCTED TO PRESERVE THE ENCLOSED BUILDING ENVELOPE AGAINST WIND PRESSURE AS SET FORTH IN SECTION 2309 OF THE S.F.B.C. AND IMPACT LOADS AS SET FORTH IN SECTION 2315 OF THE S.F.B.C.
- 5 ALL DOOR DIMENSIONS SHOW ON THIS SHEET ARE UNIT SIZES, UNLESS OTHERWISE NOTED, PROVIDE MASONRY OPENING PER MANUFACTURER'S RECOMMENDATION.
- 6 WINDOW SUPPLIER SHALL FIELDS VERIFY ALL EXISTING DOOR OPENINGS AND CONTRACTOR SHALL MAKE ALL REQUIRED ADJUSTMENTS TO EXISTING MASONRY OPENING SIZES TO ACCOMMODATE AVAILABLE DOORS.
- 7 IF THE EXISTING MASONRY OPENING SIZES MUST BE ADJUSTED TO ENSURE NEW DOORS, THE CONTRACTOR SHALL BE RESPONSIBLE FOR PATCHING AND REPAIRING INTERIOR AND EXTERIOR WALL SURFACES TO BEGIN TO EXIST.
- 8 ALL INTERIOR DOORS SHALL HAVE APPROPRIATE THRESHOLDS AT DOORWAY WHEN FINISH FLOORING MATERIAL IS DIFFERENT FROM ROOM TO ADJOINING ROOM.
- 9 ALL EXTERIOR DOORS SHALL HAVE ALUM. THRESHOLDS, DOOR SWEEPERS, & WEATHER STRIPPING ALL AROUND.
- 10 ALL INTERIOR DOOR FRAMES TO MATCH ADJOINING DOOR FINISHES.
- 11 FOR TYPICAL FRAME DETAILS, REFER TO MANUFACTURER SPECS.
- 12 EVERY CLOSET DOOR LATCH SHALL BE SUCH THAT CHILDREN CAN OPEN THE DOOR FROM THE INSIDE, AS PER NFPA 101.
- 13 EVERY BATHROOM DOOR LOCK SHALL BE DESIGNED TO PERMIT THE OPENINGS OF THE LOCKED DOOR FROM THE OUTSIDE IN AN EMERGENCY AS PER NFPA 101.
- 14 ALL NEW DOORS SHALL HAVE 3 PAIRS OF HINGES OR AS RECOMMENDED BY MANUFACTURER.
- 15 HARDWARE SHALL BE: APPROVED IN EQUAL FINISH /COLOR. CONTRACTOR OR HARDWARE SUPPLIER SHALL SUBMIT A HARDWARE SCHEDULE FOR APPROVAL PRIOR TO INSTALLATION.
- 16 ALL DOUBLE DOORS SHALL HAVE MULTI POINT FLUSH-BOLT AT ASTRAGAL.
- 17 PROVIDE ALLOWANCE FOR ALL HARDWARE.

BURGLARY SECURITY & FORCED ENTRY

- 1 ALL LOCKS AND EXTERIOR DOORS: SHALL BE CAPABLE OF RESISTING A FORCE OF 300 LB. APPLIED IN ANY DIRECTION AND IN ACCORDANCE WITH THE RESISTANCE STANDARDS SET FORTH IN THE BUILDING CODE BOOK.
- 2 ALL SINGLE EXTERIOR SWING DOOR: SHALL HAVE A LOCK TO BE KEY OPERATED FROM EXTERIOR WITH A MINIMUM OF 6000 POSSIBLE KEY CHANGES OR LOCKING AUXILIARY SINGLE DEADLOCKS WITH INSERTS.
- 3 HINGES ON EXTERIOR OFFSET TYPE SWING DOORS: SHALL HAVE NON-REMOVABLE PINS.
- 4 JAMBS ON ALL EXTERIOR OFFSET TYPE DOORS IN-SWING DOORS: SHALL BE RABBETED, OR OF SIMILAR FABRICATION, TO PREVENT DEFEATING THE PURPOSE OF THE STRIKE AND THE INTEGRITY OF LOCKS AND LATCHES.
- 5 SINGLE SWINGING EXTERIOR DOORS: IF WOOD SHALL BE OF SOLID CORE OF NO LESS THAN 1-3/8" THICK.
- 6 EXTERIOR WINDOWS, SHALL BE LOCKED WITH DEVICE IN THE INSIDE CAPABLE OF WITHSTANDING A FORCE OF 150 LBS APPLIED IN AN OPERABLE.
- 7 WINDOW SUB-BUCKS: SHALL BE OF TREATED MATERIAL AT LEAST 2" NOMINAL THICKNESS & SECURED IN AT LEAST 6 POINTS ON EACH LEG WITH 3" OR EQUIVALENT FASTENERS.

SITE PLAN, FOUNDATION AND GRADING NOTES

- 1 CONTRACTOR SHALL FIELD VERIFY, PRIOR TO CONSTRUCTION, THAT ALL SETBACKS ARE MET PER SITE PLAN AND THAT RESIDENCE AND ITS AMENITIES SIT ON SITE EXACTLY AS PER THIS SITE PLAN.
- 2 EXCAVATION SHALL BE MADE IN COMPLIANCE WITH OSHA REGULATIONS.
- 3 ALL FOUNDATION EXCAVATIONS MUST BE OBSERVED AND APPROVED, IN WRITING BY THE PROJECT GEOTECHNICAL PRIOR TO PLACEMENT OF REINFORCING STEEL.
- 4 IF ADVERSE SOIL CONDITION ARE ENCOUNTERED, CONTACT GEOTECHNICAL CONSULTANT.
- 5 CONCRETE SLABS ON GRADE ON EXPANSIVE SOIL OR COMPACTED FILL SHALL BE PLACED ON A 4 INCH FILL OF COARSE AGGREGATE OR ON A 2" SAND BED COVERED MOISTURE BARRIER MEMBRANE. THE SLABS SHALL BE AT LEAST 31/2 INCHES THICK AND SHALL BE REINFORCED WITH #4 BARS SPACED AT INTERVALS NOT EXCEEDING 16 INCHES EACH WAY.

SITE INVESTIGATION NOTE

- 1 1.- EXAMINATION OF CONTRACT DOCUMENTS AND SITE OF WORK: THE CONTRACTOR IS REQUIRED, BEFORE SUBMITTING HIS PROPOSAL, TO VISIT THE SITE OF THE PROPOSED WORK AND GET FAMILIAR WITH THE NATURE AND EXTENT OF THE WORK AND ANY LOCAL CONDITIONS THAT MAY IN ANY MANNER AFFECT THE WORK TO BE DONE AND EQUIPMENT, MATERIALS AND LABOR REQUIRED THEREFORE.
- 2 2.- SINCE THE WORK INVOLVES NEW AND/OR EXISTING BUILDINGS, SYSTEMS AND FACILITIES, SPECIAL CONSIDERATION SHALL BE GIVEN TO EXAMINATION OF WORKING CONDITIONS, SLIGHT VARIATION OF ROUTING AND OR CONSTRUCTIONS SHOULD BE ANTICIPATED BY THIS CONTRACTOR TO AVOID CONFLICTS WITH OTHER TRADES. THESE VARIATIONS ARE EXPRESSLY INCLUDED AS PART OF THE WORK WHENEVER REQUIRED AT NO ADDITIONAL COST TO THE OWNER.
- 3 3.-IGNORANCE ON THE PART OF THE CONTRACTOR WILL IN NO WAY RELIEVE HIM OF THE OBLIGATIONS AND RESPONSIBILITY ASSUMED UNDER THIS CONTRACT.

VAPOR BARRIER NOTE

- 1 ALL CONCRETE SLABS ON GRADE OF ENCLOSED AIR-CONDITIONED SPACES ARE TO HAVE A 6 MIL POLYETHYLENE OR APPROVED VAPOR RETARDER WITH JOINTS LAPPED NOT LESS THAN 6" PLACED BETWEEN THE SLAB AND THE BASE COURSE OR PREPARED SUBGRADE.

TERMITE CONTROL NOTES

- 1 TREATMENT SHALL BE IN ACCORDANCE WITH RULES AND LAWS ESTABLISHED BY THE FLORIDA DEPARTMENT OF AGRICULTURE AND CONSUMER SERVICES. A CERTIFICATE OF COMPLIANCE SHALL BE ISSUED TO THE BUILDING DEPARTMENT BY THE LICENCED PEST CONTROL COMPANY.

TERMITE PROTECTION NOTES

- 1 SOIL SHALL BE TERMITE TREATED PRIOR TO CONSTRUCTION.
- 2 TERMITE PROTECTION SHALL BE PROVIDED BY FLORIDA REGISTERED TERMITICIDES OR OTHER APPROVED METHODS OF TERMITE PROTECTION LABELED FOR USE AS PREVENTATIVE TREATMENT TO NEW CONSTRUCTION.
- 3 CONTRACTOR SHALL POST A WEATHER RESISTANT JOB BOARD TO RECEIVE DUPLICATE TREATMENT CERTIFICATES AND SHALL DISPLAY PRODUCT USED IDENTITY OF APPLICATOR, TIME AND DATE OF TREATMENT, SITE LOCATION, AREA TREATED, CHEMICAL USED, PERCENT CONCENTRATION AND NUMBER OF GALLONS USED.

GENERAL WINDOWS NOTES

- 1 ALL EXTERIOR WINDOWS AND DOORS SHALL BE UNDER A SEPARATE PERMIT. G.C. SHALL SUBMIT PRODUCT APPROVALS FOR IMPACT RESISTANT ASSEMBLY RATING WITH AN APPROPRIATE N.O.A. AND STRUCTURAL CALCULATIONS DESIGNED BY THE STATE OF FLORIDA REGISTERED PROFESSIONAL ENGINEER FOR REVIEW AND APPROVAL PRIOR TO FABRICATION.
- 2 WINDOW ATTACHMENT IS THE RESPONSIBILITY OF THE BUILDER/CONTRACTOR AS PER THE PARTICULAR WINDOW MANUFACTURER'S INSTALLATION REQUIREMENTS TO MEET DESIGN PRESSURE AND MUST BE SIGNED AND SEALED BY A LICENSED ENGINEER FROM THE STATE OF FLORIDA.
- 3 ALL WINDOWS TO HAVE MIAMI-DADE COUNTY APPROVED IMPACT RESISTANT GLASS.
- 4 ALL STOREFRONT AND WINDOWS TO BE IMPACT GLASS.
- 5 SEE ALL PLANS FOR LOCATION OF WINDOW TYPES.
- 6 MANUFACTURER SHALL FIELD VERIFY ALL EXTERIOR MASONRY OPENINGS PRIOR TO FABRICATION.
- 7 VERIFY ROUGH OPENING DIMENSIONS WITH WINDOW MANUFACTURER.
- 8 CONTRACTOR TO SUBMIT SHOP DRAWINGS FOR ARCHITECTS APPROVAL PRIOR TO ORDERING WINDOWS.
- 9 ALL OUTSIDE FIXED GLASS IS TO COMPLY WITH SECTION 3508.2 FBC. ALL GLASS AT WINDOWS AND DOORS SHALL BE TINTED AS PER ENERGY CALCULATIONS.
- 10 PROVIDE CATEGORY II SAFETY GLASS AT SHOWER ENCLOSURES AND WINDOWS ADJACENT TO TUBS OR SHOWERS (FBC 2411.6.2).
- 11 WHEN APPLY, GENERAL CONTRACTOR TO PROVIDE PRODUCT APPROVAL SHUTTER SYSTEM. SUBMIT SHOP DRAWINGS FOR APPROVAL.

DRAINAGE NOTES

- 1 ALL DRAINAGE SHALL BE MAINTAINED ON PROPERTY AND SHALL NOT DRAIN ONTO NEIGHBORING PROPERTIES.
- 2 INSTALL ROOF DRAINS, GUTTERS AND DOWNSPOUT ACCORDING TO PLANS.
- 3 ALL DRAINAGE SHALL BE CONDUCTED TO STREET IN NON-EROSIVE DEVICES 2% MIN.
- 4 BASEMENT WATER SHALL BE DISCHARGED TO LAWN.

COPYRIGHT NOTE

- 1 ALL DESIGNS AND DRAWINGS HEREIN AND PRINTS ISSUED BY THE ARCHITECT ARE THE PROPERTY OF THE ARCHITECT AND SHALL NOT BE REUSED ON ANY OTHER LOCATION EXCEPT WHERE THE ONE FOR WHICH THEY WERE EXPRESSLY DESIGNED IF THESE DRAWINGS OR ANY PART THEREOF IS REPRODUCED WITHOUT THE WRITTEN CONSENT OF THE ARCHITECT, THE PERSON SO DOING WILL BE INDEBTED TO ARCHITECT FOR HIS FULL COMMISSION.

MEANS OF EGRESS

- 1 ALL EGRESS WINDOWS SHALL HAVE A MIN. NET CLEAR OPENING OF 5.7 SF; WHILE GRADE FLOOR OPENING MAY BE REDUCED TO 5 SF. HAVE A MIN. NET WIDTH OF 20" AND A MIN. NET HEIGHT OF 24". THE BOTTOM OF THE OPENING SHALL NOT BE GREATER THAN 44" MEASURED FROM THE FINISH FLOOR OF THAT STORY AS PER FBC-B 1030, FBC R311 FOR SLEEPING ROOMS IN R-2 AND R-3 OCCUPANCIES BELOW THE FOURTH STORY.
- 2 NO DOOR IN THE PATH OF TRAVEL OF MEANS OF ESCAPE SHALL BE LESS THAN 80" HEIGHT AND 20" WIDE MEASURED FROM FACE OF DOOR TO STOP WHEN OPENED 90°. BATHROOM DOORS MAY BE 24" WIDE UNLESS A LARGER DOOR OPENING IN REQUIRED TO SATISFY REQUIREMENTS, AS PER FBC B 1010.1.
- 3 EVERY CLOSET DOOR LATCH SHALL BE SUCH THAT CHILDREN CAN OPEN THE DOOR FROM INSIDE THE CLOSET.
- 4 EVERY BATHROOM DOOR LOCK SHALL BE DESIGN TO PERMIT THE OPENING OF THE LOCKED DOOR FROM THE OUTSIDE IN AN EMERGENCY.
- 5 NO DOOR IN ANY MEANS OF ESCAPE SHALL BE LOCKED AGAINST EGRESS WHEN THE BUILDING IS OCCUPIED. ALL LOCKING WHICH IMPEDE OR PROHIBIT EGRESS OR WHICH CANNOT BE EASILY DISENGAGED SHALL BE PROHIBITED.

ACCESSIBLE NOTES

- 1 UNIT ENTRY DOORS (ACCESSIBLE DOOR) SHALL HAVE A MINIMUM CLEAR PASSAGEWAY OF 32". ALL OTHER UNIT DOORWAYS (USER DOOR) SHALL HAVE A CLEAR OPENING OF 31 5/8" MIN. CLEAR OPENING OF SWINGING DOORS SHALL BE MEASURED BETWEEN THE FACE OF THE DOOR AND STOP, WITH THE DOOR OPEN 90 DEGREES.
- 2 LIGHTING CONTROLS, ELECTRICAL SWITCHES AND RECEPTACLES, ENVIRONMENTAL CONTROLS, APPLIANCES CONTROLS, OPERATING HARDWARE FOR OPERABLE WINDOWS, PLUMBING FIXTURE, CONTROLS AND USER CONTROLS FOR SECURITY OR INTERCOM SYSTEMS SHALL COMPLY WITH THE REACH REQUIREMENTS ACCORDING FAIR HOUSING ACT DESIGN MANUALS. OPERABLE PARTS SHALL BE OPERABLE WITH ONE HAND AND SHALL NOT REQUIRE TIGHT GRASPING, PINCHING, OR TWISTING OF THE WRIST, THE FORCE REQUIRED TO ACTIVATE OPERABLE PARTS SHALL BE 5.0 POUNDS MAX.
- 3 WASHING MACHINE AND CLOTHES DRYER ARE NOT REQUIRED TO MEET THE CLEAR FLOORS SPACE PER THE FAIR HOUSING ACT DESIGN MANUAL.
- 4 KITCHENS:
* CLEARANCE BETWEEN ALL OPPOSING BASE CABINETS, COUNTERTOPS, APPLIANCES, OR WALLS WITHIN KITCHEN WORK AREAS SHALL BE 40" MIN.
* SINK: PROVIDE A CLEAR FLOOR SPACE FOR PARALLEL APPROACH AND CENTERED ON SINK BOWL.
* DW: PROVIDE A CLEAR FLOOR SPACE, POSITIONED FOR PARALLEL OR FORWARD APPROACH TO THE DISHWASHER.
* COOKTOP/OVEN/RANGE: PROVIDE A CLEAR FLOOR SPACE POSITIONED FOR A PARALLEL OR FORWARD APPROACH TO THE COOKTOP/OVEN/RANGE AND CENTERED ON THE CENTERLINE OF COOKTOP.
* REF-FREEZER: PROVIDE A CLEAR FLOOR SPACE POSITIONED FOR PARALLEL OR FORWARD APPROACH
- 5 BATHROOMS:
* LAV: PROVIDE A 30" X 48" CLEAR FLOOR SPACE POSITIONED FOR A PARALLEL OR FORWARD APPROACH
* WC: THE LATERAL DISTANCE FROM THE CENTERLINE OF THE WATER CLOSET TO A TUB OR LAVATORY SHALL BE 18" MIN. ON THE SIDE OPPOSITE THE DIRECTION OF APPROACH AND 15" MIN. ON THE OTHER SIDE. THE LATERAL DISTANCE FROM THE CENTERLINE OF THE WATER CLOSET TO AN ADJACENT WALL SHALL BE 18". THE LATERAL DISTANCE FROM THE CENTERLINE OF THE WATER CLOSET TO A LAVATORY OR BATHTUB SHALL BE 15" MIN. REFER TO DIAGRAMS ON THIS SHEET FOR CLEARANCE AROUND THE WC.

- 6 PROVIDE REINFORCEMENT IN WALLS TO PERMIT THE FUTURE INSTALLATION OF GRAB BARS PER FAIR HOUSING ACT DESIGN MANUAL.
- 7 GRAB BARS, WHEN REQUIRED TO BE INSTALLED, SHALL HAVE AN OUTSIDE DIAMETER OF 1 1/2" MIN. AND 2" MAX. THE SPACE BETWEEN THE WALL AND THE GRAB BAR SHALL BE 1 1/2". STRUCTURAL STRENGTH OF THE GRAB BAR SHALL NOT SUPPORT LESS THAN 250 POUNDS. GRAB BARS ARE NOT REQUIRED TO BE INSTALLED AT TIME OF CONSTRUCTION, THIS ONLY APPLIES IF GRAB BARS ARE REQUESTED BY A SPECIFIC TENANT.
- 8 CLEAR WIDTH AT KITCHENS TO BE MEASURED FROM THE FURTHEST PROJECTING ELEMENTS SUCH AS THE FACE OF THE COUNTERTOP EDGE, FACE OF APPLIANCE OR FACE OF TRIM.
- 9 TACTILE CHARACTERS SHALL BE 48" MIN. A.F.F. MEASURED TO THE BASELINE OF THE LOWEST TACTILE CHARACTER AND 60" MAX. A.F.F. MEASURED TO THE BASELINE OF THE HIGHEST TACTILE CHARACTER.
- 10 ALL DIMENSIONS SHOWING CLEARANCE REQUIREMENTS SHALL BE TAKEN FROM THE FACE OF THE FINISH MATERIAL.
- 11 SLIDING, POCKET AND BIFOLD DOORS MUST STOP FULLY WITH THEIR HANDLES EXPOSED AND CLEAR OPENING OF 32".

ABBREVIATIONS

@	AT
A.F.F	ABOVE FINISH FLOOR
AHU.	AIR HANDLER UNIT
AL.	ALUMINUM
APPROX.	APPROXIMATE
ARCH.	ARCHITECTURAL, ARCHITECT
AVG.	AVERAGE
B.O	BOTTOM OF
BD.	BOARD
C.L.	CENTER LINE
C.L.F.	CHAIN LINK FENCE
C/U.	CONDENSER UNIT
CEM. PLS.	CEMENT PLASTER
CL.	CLOSET
CLG.	CEILING
CMU	CONCRETE MASONRY UNIT
COL.	COLUMN
CONC.	CONCRETE
D.	DRYER
DBL.	DOUBLE
DIA.	DIAMETER
DISP.	DIMENSION
DIM.	FOOD DISPOSAL.
DN.	DOWN
DWG.	DRAWING
E.J.	EXPANSION JOINT
EA.	EACH
ELEC.	ELECTRICAL
ELEV.	ELEVATION
EMERG.	EMERGENCY
ENG.	ENGINEERING, ENGINEER
EQ.	EQUAL
EQPT.	EQUIPMENT
EXH.	EXHAUST
EXIST.	EXISTING
F.F.E.	FINISH FLOOR ELEVATION
FBC	FLORIDA BUILDING CODE
FD.	FLOOR DRAIN
FR.	FIRE RATED
FRR.	FURRING
FRZ.	FREEZER
FEET, FOOT	
FTG.	FOOTING
G.C	GENERAL CONTRACTOR
GA.	GAUGE
GALV.	GALVANIZED
GL.	GLASS
GYP.	GYPSUM
HORZ.	HORIZONTAL
HR.	HOUR

GRAPHIC SYMBOLS LEGEND

	DOOR TAG. SEE SCHEDULE FOR DIMENSION.
	WINDOW TAG. SEE SCHEDULE FOR DIMENSION.
	REVISION TAG. SEE REVISION NOTES.
	WALL TAG. SEE SCHEDULE FOR WALLS
	WALL FIRE RATING
	SECTION MARK
	SHEET NUMBER
	SHEET REFERENCE
	ELEVATION MARK
	SHEET REF.
	ELEVATION NUMBER
	MASONRY 21 CODE LOT LAYERS
	STEP HEIGHT
	GRID NUMBER

WALL LEGEND

	TYPICAL NON-LOAD BEARING 8" CMU WALL W/ VERTICAL REINFORCING. SEE TYPICAL WALL TYPES AND STRUCTURAL DRAWINGS FOR DETAILS.
	REINFORCED CONCRETE WALL. SEE TYPICAL WALL TYPES AND STRUCTURAL DRAWINGS FOR DETAILS.
	TYP 4" INTERIOR PARTITIONS. SEE TYPICAL WALL TYPES FOR DETAILS.
	TYP 6" INTERIOR PARTITIONS. SEE TYPICAL WALL TYPES FOR DETAILS.

LEVELS


	ELEV.	NGVD
MAX PARAPET HEIGHT	28' - 6"	39.50'
T.O. PARAPET WALL	26' - 6"	37.50'
ROOF LEVEL	23' - 6"	34.50'
2ND LEVEL	12' - 0"	23.00'
1ST LEVEL	0' - 0"	11.00'
BFE	-1' - 0"	10.00'
FOOTINGS	-3' - 0"	8.00'

ABBREVIATIONS

I.W.H.	INSTANT WATER HEATER
INSUL.	INSULATE, INSULATION
INT.	INTERIOR
LB.	POUND
L.V.	LAVATORY
MANF.	MANUFACTURER
MAT.	MATERIAL
MAX.	MAXIMUM
MECH.	MECHANICAL
MEMB.	MEMBRANE
MET.	METAL
MIN.	MINIMUM
MISC.	MISCELLANEOUS
MW	MICROWAVE
N.O.A.	NOTICE OF APPROVAL
N.T.S	NOT TO SCALE
N/A	NOT APPLICABLE
NGVD.	NATIONAL GEODETIC VERTICAL DATUM
NO.	NUMBER
O.C.	ON CENTER
PL.	PROPERTY LINE
PKWY.	PARKWAY
PL.	PLATE
PLUMB.	PLUMBING
PLY.	SINGLE-PLY MEMBRANES
PLYWD.	PLYWOOD
PREFAB.	PREFABRICATED
PT.	PRESSURE TREATED
R.	RADIUS
R.O.W	RIGHT OF WAY
REF.	REFERENCE
REFG	REFRIGERATOR
REINF.	REINFORCEMENT
REQ.	REQUIRED
RG.	RANGE
SF.	SQUARE FEET
SH.	SHOWER
SIM.	SIMILAR
SK.	SINK
SPEC.	SPECIFICATION
STRUC.	STRUCTURAL
SUSP.	SUSPEND, SUSPENDED
SYS.	SYSTEM
T.B.D	TO BE DETERMINATED
T.O.	TOP OF
TEMP.	TEMPORARY.
TV.	TELEVISION
TYP.	TYPICAL
U.O.N	UNLESS OTHERWISE NOTED
VERT.	VERTICAL
W.	WASHER
W.H.	WATER HEATER
W.M.	WATER METER
W/	WITH
W/O	WITH OUT
WC.	WATER CLOSET, TOILET
WD.	WOOD


SHEET ID LEGEND

DISCIPLINE DESIGNATIONS	SHEET TYPE DESIGNATIONS
G GENERAL HAZARDOUS MATERIAL	0 GENERAL SYMBOLS, LEGENDS, NOTES
H CIVIL	1 PLANS
I LANDSCAPE	2 ELEVATIONS
S STRUCTURAL	3 SECTIONS
A ARCHITECTURAL	4 LARGE SCALE VIEWS (3D, PLANS)
I INTERIORS	5 ELEVATIONS, SECTIONS NOT DETAILS
Q EQUIPMENTS	6 DETAILS
FP FIRE PROTECTION	7 SCHEDULES AND DIAGRAMS
P PLUMBING	8 WORKING DRAWINGS
M MECHANICAL	9 END PAGE, RESERVED FOR CITY COMMENTS
E ELECTRICAL	
R TELECOMMUNICATIONS	
RES RESOURCE	
X OTHER DISCIPLINES	
Z CONTRACTOR / SHOP DRAWINGS	

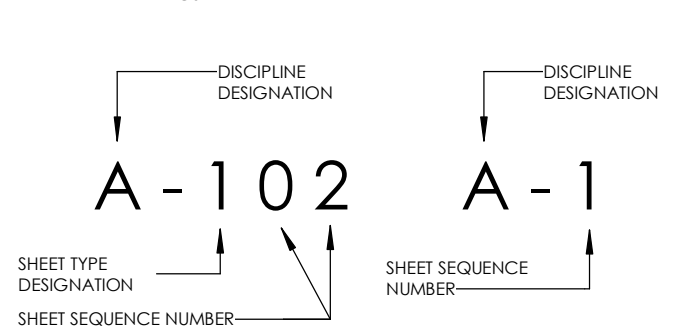


SHEET LIST


ARCHITECTURE	LEGEND & GENERAL NOTES
A-001	LEGEND & GENERAL NOTES
A-002	AREAS & CODE SUMMARY
A-100	SITE PLAN
A-101	FIRST FLOOR PLAN
A-101a	FIRST FLOOR PLAN
A-101b	FIRST FLOOR PLAN
A-101c	FIRST FLOOR PLAN

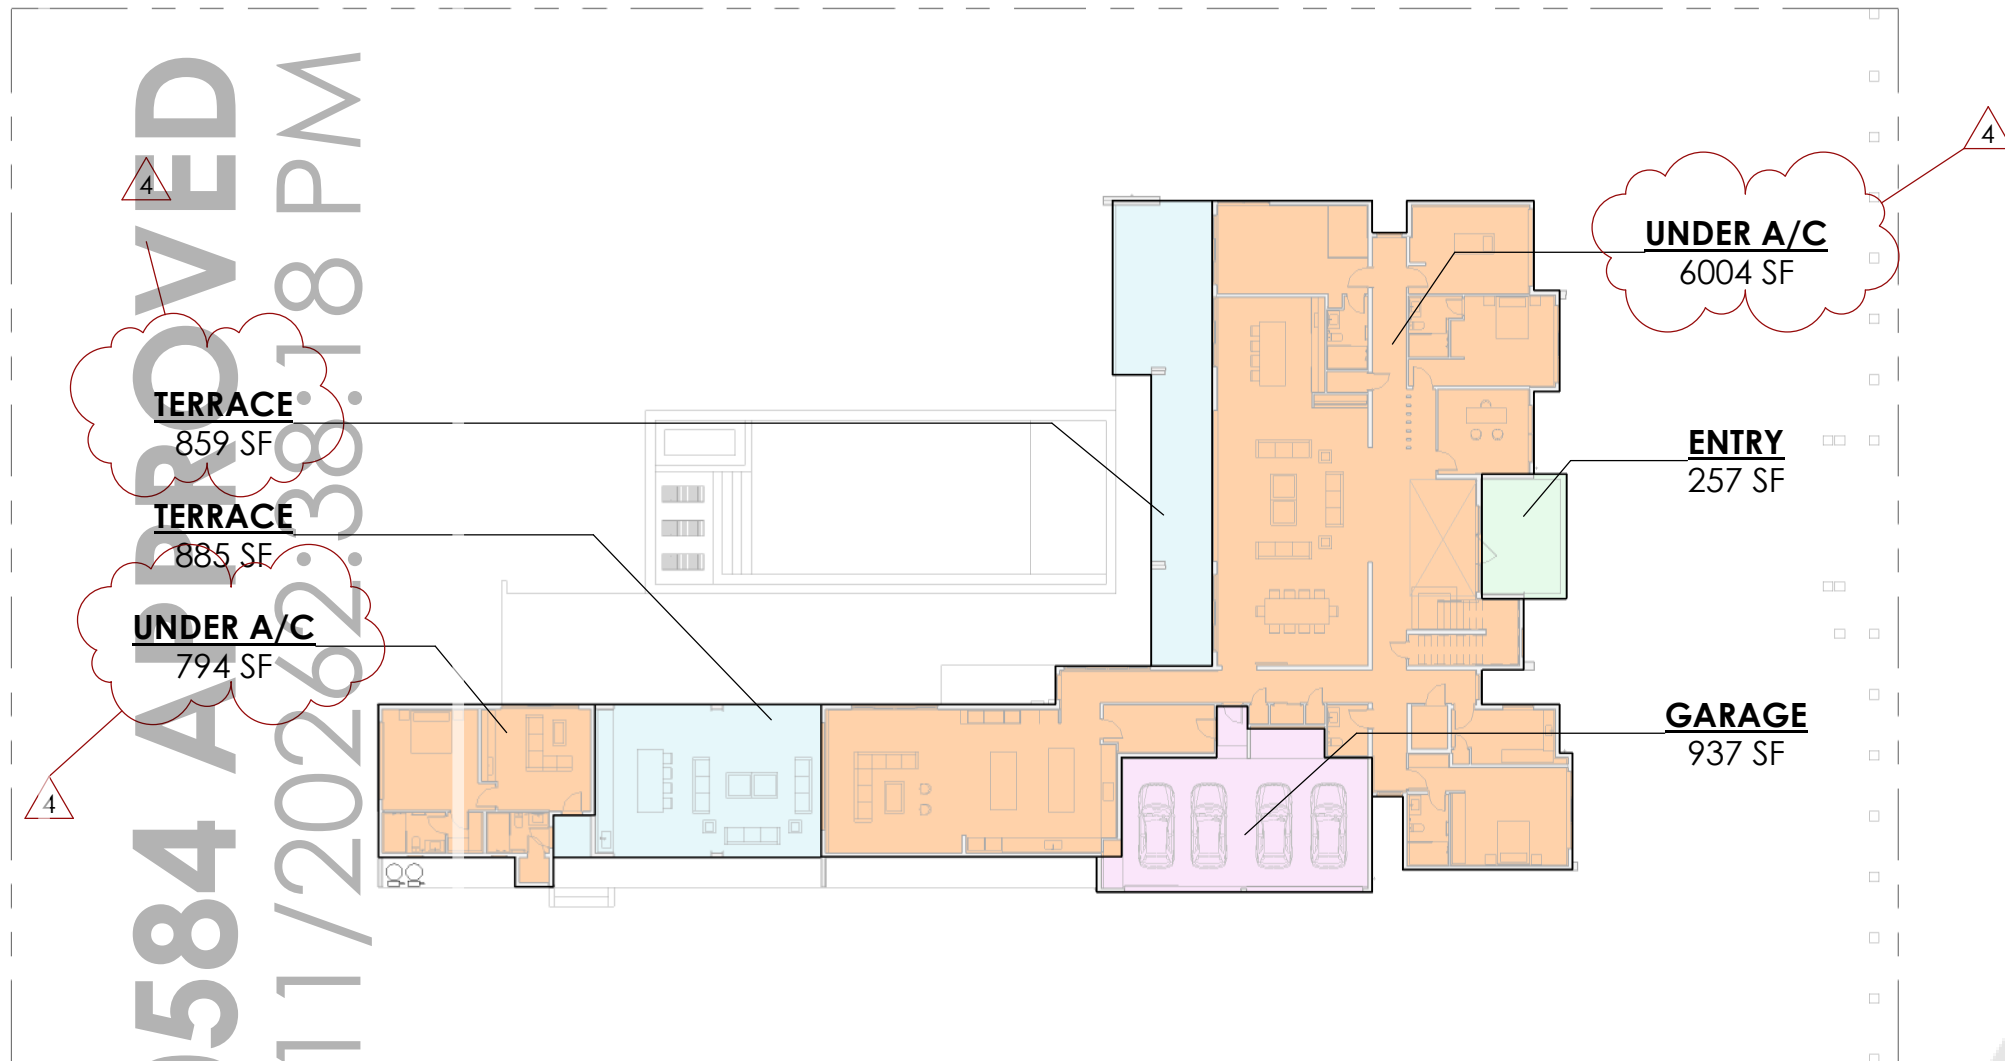


1ST LEVEL 1
1" = 30'-0"

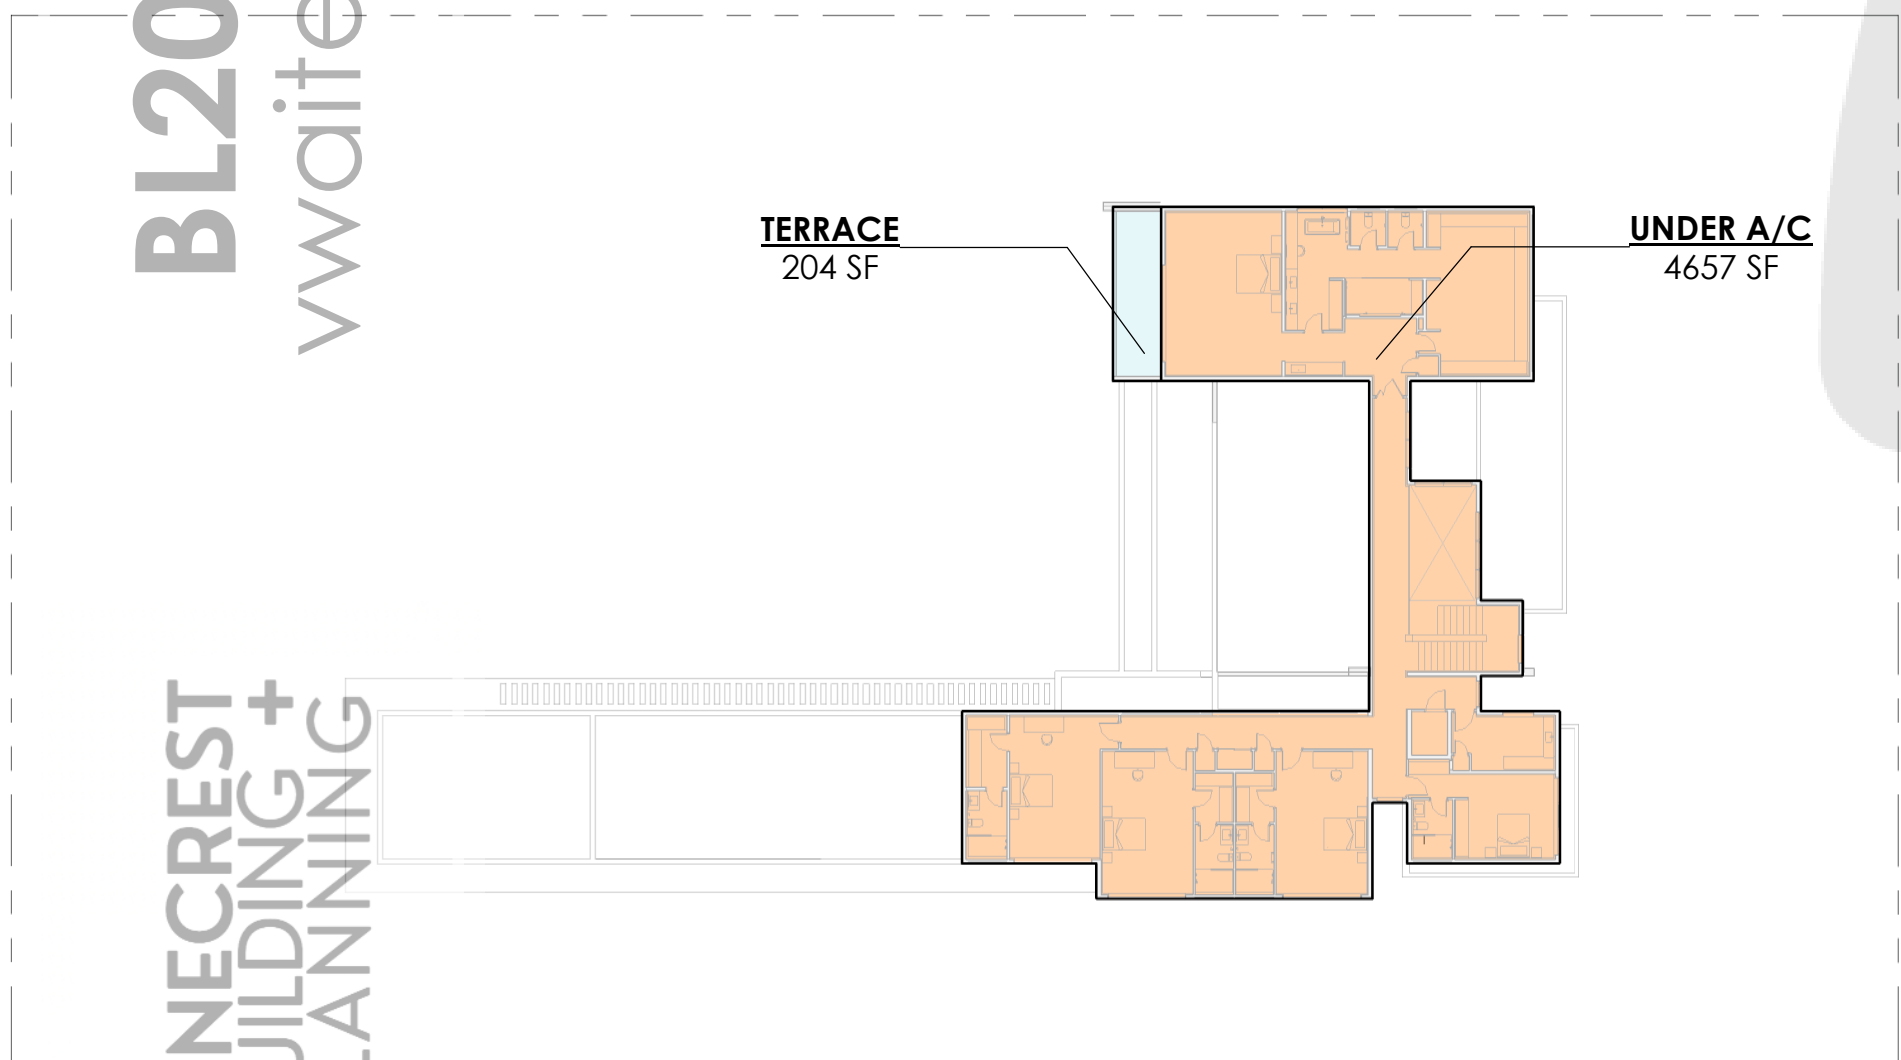

2ND LEVEL 2
1" = 30'-0"

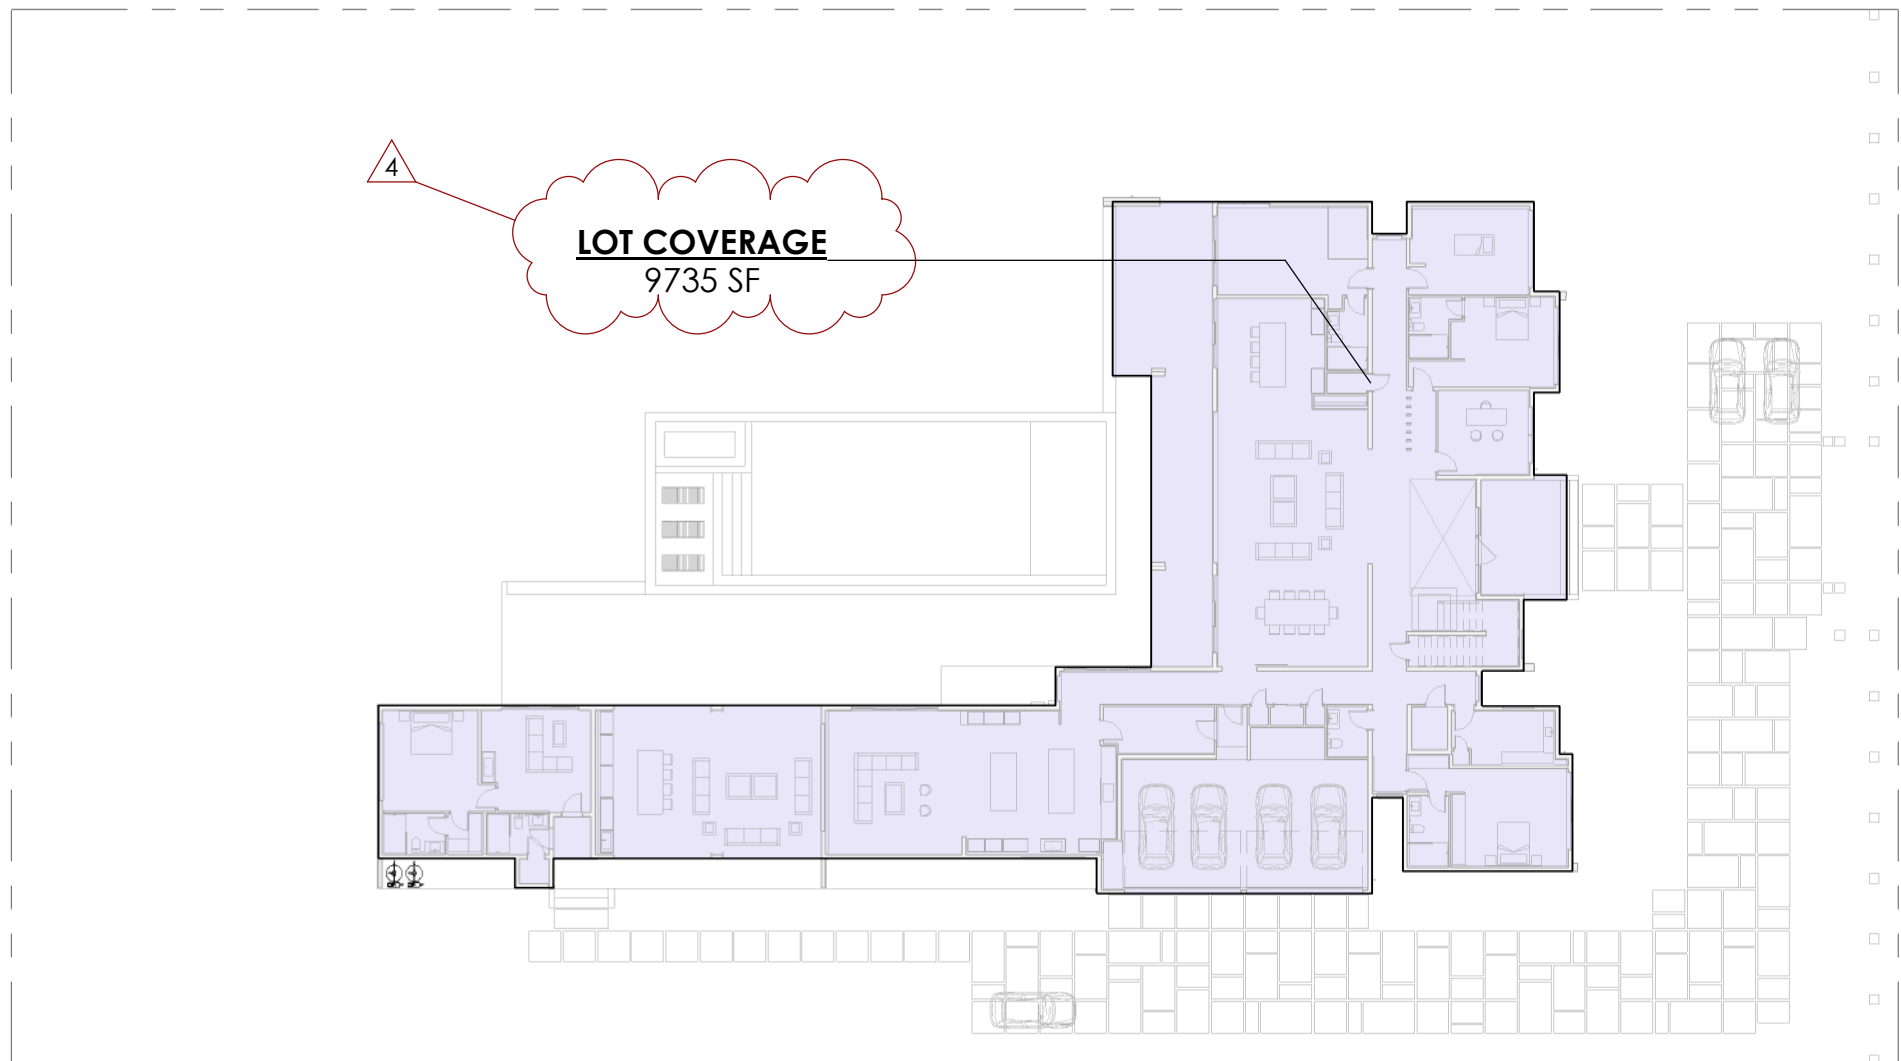

LOT COVERAGE 3
1" = 30'-0"

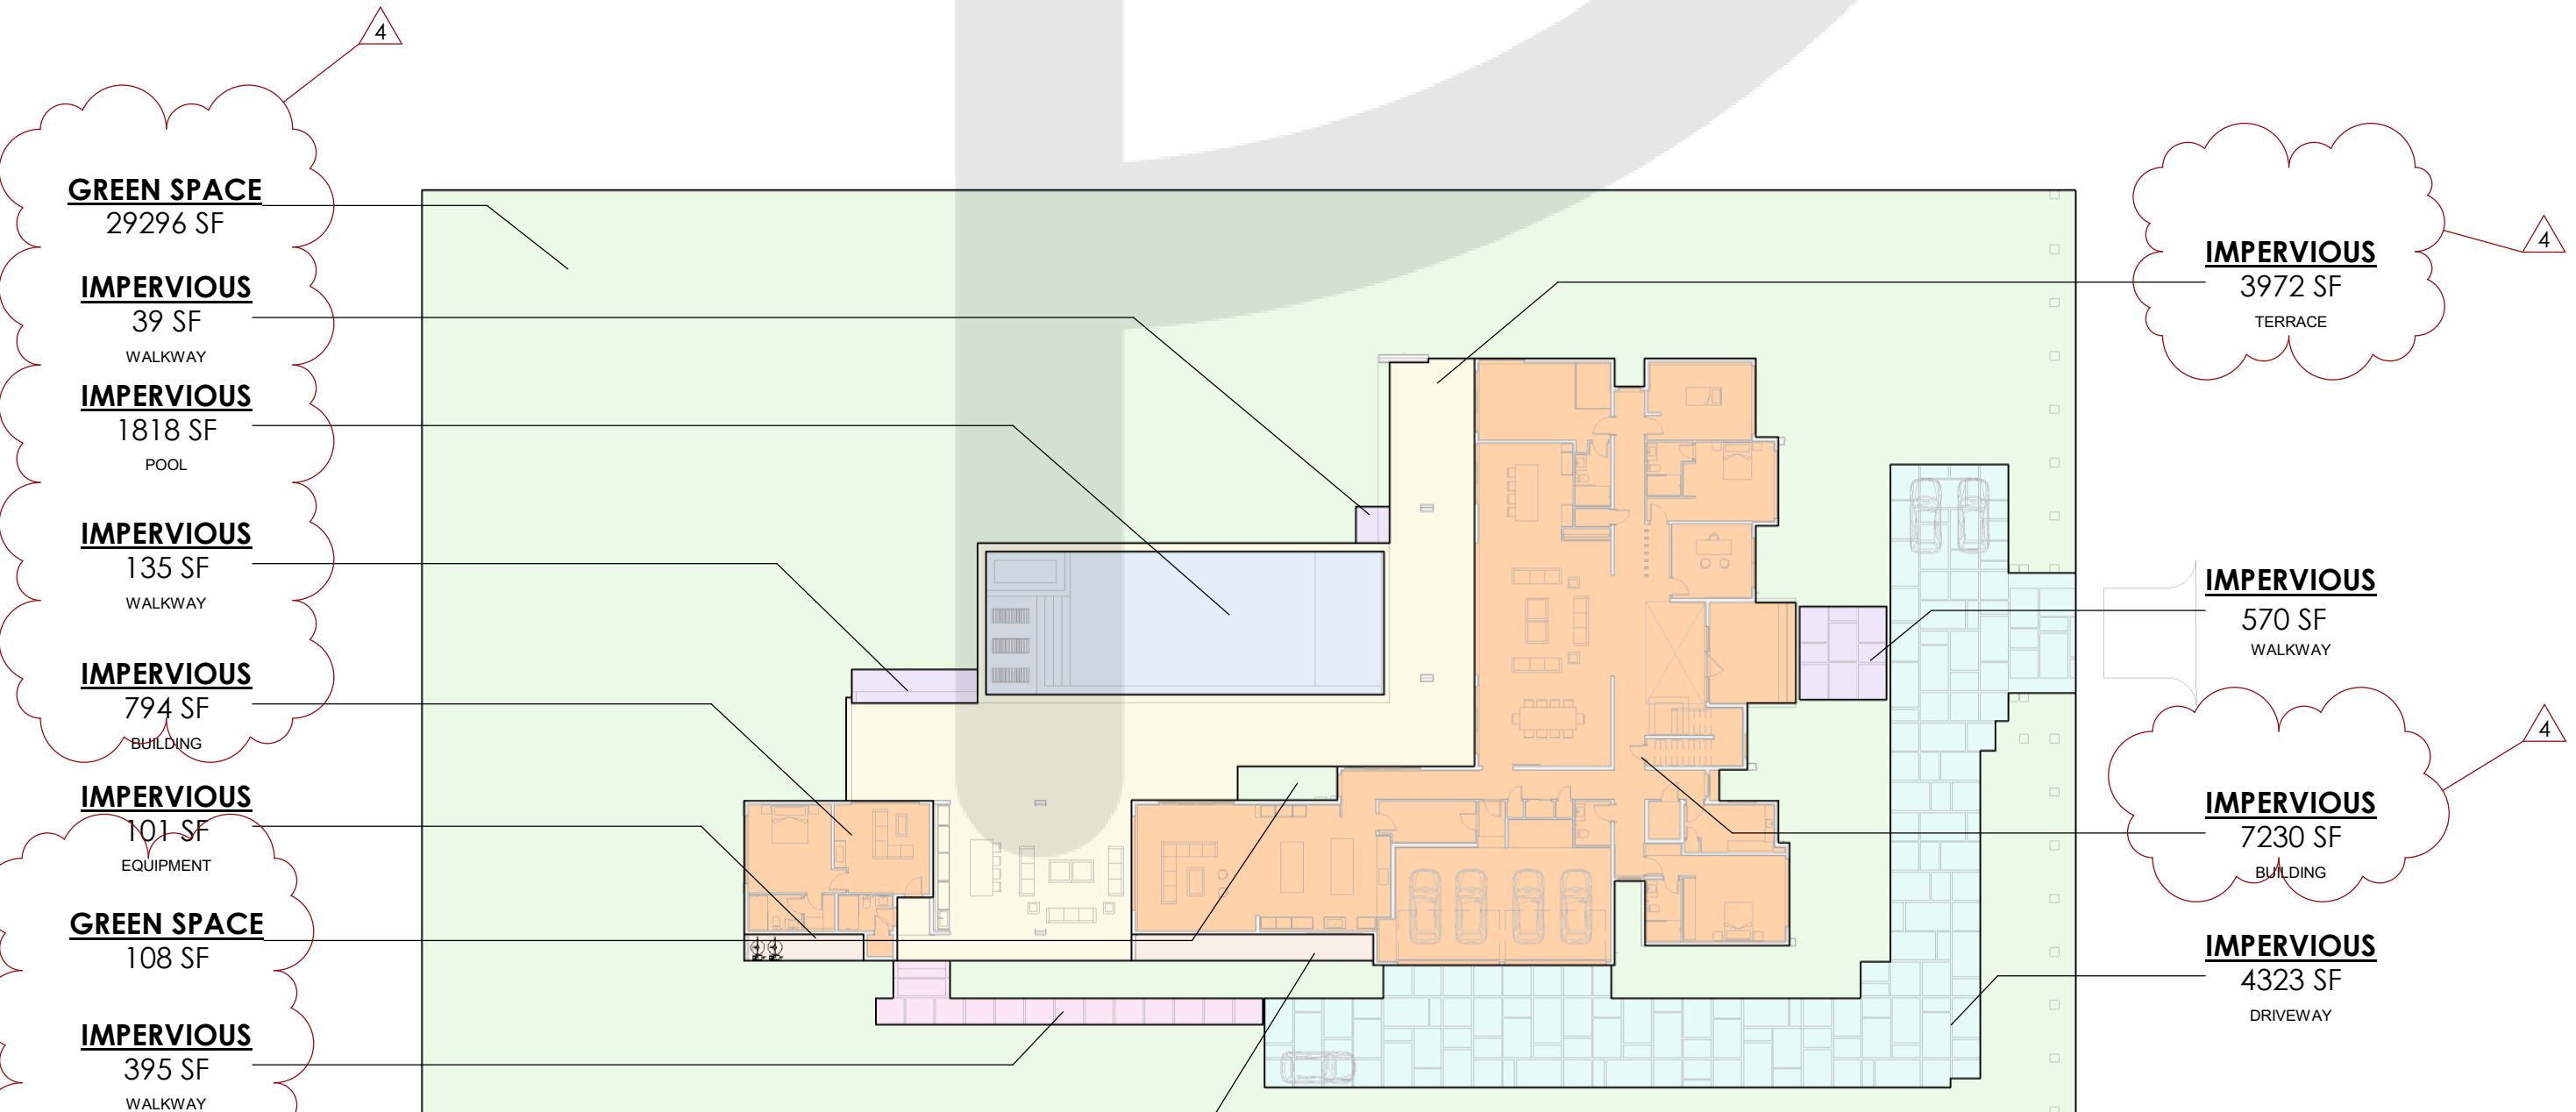

IMPERVIOUS - GREEN SPACE 4
1" = 30'-0"

LOT COVERAGE

	REQUIRED	PROPOSED
	% AREA	% AREA
SITE PLAN		
LOT COVERAGE	20% 9735 SF	20.00% 9735 SF

IMPERVIOUS AREAS

	MAX/MIN	PROPOSED
	% AREA	% AREA
GREEN SPACE	55% 26771 SF	60.4% 29404 SF
IMPERVIOUS	45% 21904 SF	39.6% 19271 SF

IMPERVIOUS AREAS BREAKDOWN

	PROPOSED	COMMENTS
	% AREA	
IMPERVIOUS	16.5%	8024 SF BUILDING
IMPERVIOUS	8.9%	4323 SF DRIVEWAY
IMPERVIOUS	0.6%	306 SF EQUIPMENT
IMPERVIOUS	3.7%	1818 SF POOL
IMPERVIOUS	8.2%	3972 SF TERRACE
IMPERVIOUS	1.7%	829 SF WALKWAY
	39.6%	19271 SF

FLOOR AREA

	AREA
1ST LEVEL TERRACE	885 SF
1ST LEVEL ENTRY	257 SF
1ST LEVEL TERRACE	859 SF
1ST LEVEL GARAGE	937 SF
1ST LEVEL UNDER A/C	6004 SF
1ST LEVEL UNDER A/C	794 SF
	9735 SF
2ND LEVEL TERRACE	204 SF
2ND LEVEL UNDER A/C	4657 SF
	4861 SF
GRAND TOTAL	14596 SF

*1st level: 9735 max / 2nd level 4867 max

SITE INFORMATION

PROPERTY ADDRESS:	10840 SW 67 AVE MIAMI, FL 33156
FOLIO:	20-5011-005-0151
SUBDIVISION:	HELMS COUNTRY ESTS REPLAT
LEGAL DESCRIPTION:	THE SOUTH 112. OF LOT 16, BLOCK I, "REPLAT OF HELMS COUNTRY ESTATES", ACCORDING TO THE PLAT THEREOF, RECORDED IN PLAT BOOK 50, AT PAGE 48, OF THE PUBLIC RECORDS, OF MIAMI-DADE COUNTY, FLORIDA.
LOT AREA:	48675 SF (1.12 acres)

BUILDING INFORMATION

SCOPE OF WORK:	NEW SINGLE FAMILY RESIDENCE TWO-STORY HIGH 8 BEDROOM + 10.5 BATHROOM NEW DRIVEWAY NEW WALKWAY
----------------	--

APPLICABLE CODES:	2023 FLORIDA BUILDING CODE 8th EDITION CODE OF ORDENANCES VILLAGE OF PINECREST
-------------------	---

CONSTRUCTION TYPE:	III B
--------------------	-------

OCCUPANCY CLASSIFICATION:	R-3
---------------------------	-----

CLASSIFICATION OF WORK:	New Construction
-------------------------	------------------

LEVEL OF ALTERATION:	N/A
----------------------	-----

REHABILITATION CATEGORY:	N/A
--------------------------	-----

AREA OF ALTERATION:	0 SF
---------------------	------

FLOOD ZONE:	"AE-10" 10' - 0" NGVD BASE FLOOD ELEVATION (BFE) FINISH FLOOR ELEVATION TO BE LOCAED MIN 12" ABOVE BFE
-------------	--

DESIGN LEVEL (NGVD)	11' - 0"
---------------------	----------



MIK ARCHITECTURE LLC
MATIAS DAROCH
AR 100480

1385 CORAL WAY, SUITE 202
MIAMI, FLORIDA 33146
agdmiami.com
305.758.0882
matias@agdmiami.com




AGD DEVELOPERS LLC
1385 CORAL WAY, SUITE 202
MIAMI, FLORIDA 33146
agdmiami.com
305.758.0882
matias@agdmiami.com

NEW CONSTRUCTION
AGD CALISTONE LLC
10840 SW 67 AVE MIAMI, FL 33156

ISSUES	MAY 2025	1ST ISSUED
2025-09-11	Correction 2	
2025-12-05	Correction 4	

JOB NO.	#084
DRAWN BY	NS
CHECKED BY	MD
SCALE	AS NOTED
FROM	AA 26003995
DATE	

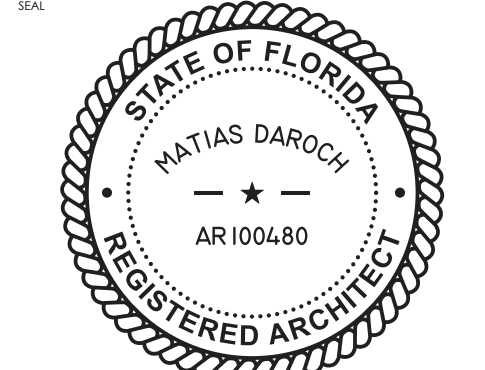

THIS IS A DIGITALLY SIGNED FILE. THE CONTENTS OF THIS DOCUMENT ARE NOT
CONSIDERED SIGNED AND SEALED AND THE SIGNATURE MUST BE VERIFIED ON
THE ORIGINAL DOCUMENT.

THE CONTENT OF THIS SHEET AND ALL OTHER DRAWINGS ISSUED IN THE SET ARE
PROTECTED BY U.S. AND INTERNATIONAL COPYRIGHT LAWS. REPRODUCTION OR
USE WITHOUT PROPER WRITTEN CONSENT IS PROHIBITED BY LAW. SEE ALSO FOR
DETAILS.

SHEET NO.

A-002

AREAS & CODE SUMMARY

DRAINAGE NOTES


- ALL DRAINAGE SHALL BE MAINTAINED ON PROPERTY AND SHALL NOT DRAIN ONTO NEIGHBORING PROPERTIES.
- INSTALL ROOF DRAINS, GUTTERS AND DOWNSPOUT ACCORDING TO PLANS.
- ALL DRAINAGE SHALL BE CONDUCTED TO STREET IN NON-EROSIVE DEVICES 24" MIN.
- BASEMENT WATER SHALL BE DISCHARGED TO LAWN.

TERMITE PROTECTION NOTES

- SOIL SHALL BE TERMITE TREATED PRIOR TO CONSTRUCTION.
- TERMITE PROTECTION SHALL BE PROVIDED BY FLORIDA REGISTERED TERMITICIDES OR OTHER APPROVED METHODS OF TERMITE PROTECTION LABELED FOR USE AS PREVENTATIVE TREATMENT TO NEW CONSTRUCTION.
- CONTRACTOR SHALL POST A WEATHER RESISTANT JOB BOARD TO RECEIVE DUPLICATE TREATMENT CERTIFICATES AND SHALL DISPLAY PRODUCT USED IDENTITY OF APPLICATOR, TIME AND DATE OF TREATMENT, SITE LOCATION, AREA TREATED, CHEMICAL USED, PERCENT CONCENTRATION AND NUMBER OF GALLONS USED.

SOIL STATEMENT

- THE SOIL CONDITIONS AT THIS SITE ARE UNDISTURBED SAND AND ROCK WHICH IS ADEQUATE TO SUPPORT THE DESIGN LOAD OF 2000 PSF. THIS SITE HAS BEEN OBSERVED AND THE FOUNDATION CONDITIONS ARE SIMILAR TO THOSE UPON WHICH THE FOOTING DESIGN IS BASED. THE FOUNDATION HAS BEEN DESIGNED TO A DESIGN LOAD OF 2000 PSF. A LETTER TO THIS EFFECT WILL BE ISSUED TO THE BUILDING INSPECTOR, SIGNED AND SEALED BY THE ARCHITECT. FILL REQUIRED FOR SUPPORT OF SLAB ON GRADE CONDITIONS SHALL BE COMPACTED TO 95% OF MAXIMUM DENSITY UNDER THE SUPERVISION OF A SPECIAL INSPECTOR. A LETTER FROM THE SPECIAL INSPECTOR WILL BE SUBMITTED TO THE BUILDING OFFICIAL AT THE TIME OF INSPECTION.

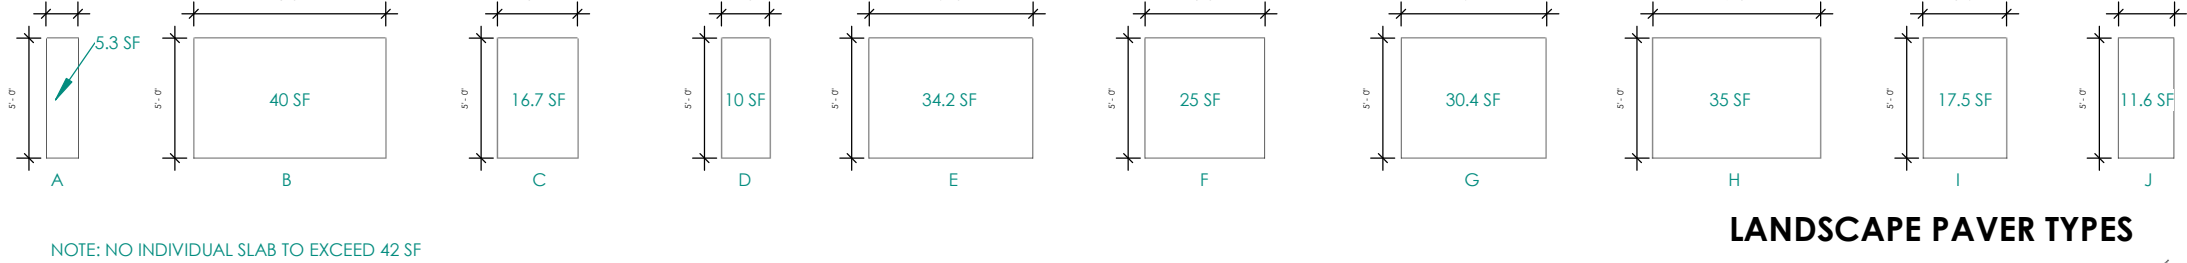

SETBACK DIAGRAM

1" = 40'-0"

2

TYP. DRIVEWAY DETAIL

N.T.S.

3

TYP. WALKWAY DETAIL

N.T.S.

4

Pool Requirements:
Self-locking/self-closing
gates required
Fence: 4' high min. and
non-climbable from outside

TREE PROTECTION REQUIREMENTS DURING CONSTRUCTION

Protective barriers shall be in place prior to the start of any construction. Protective barrier shall be placed around each tree, or cluster of trees no less than six (6) feet (in radius) from the trunk. Protective barrier shall be a minimum of four (4) feet above ground level and shall be constructed of wood, plastic or metal and shall remain in place until development is completed.

Fences and walls that obstruct vision may not exceed 2-1/2 feet in height when located within 10 feet of the edge of any driveway leading to a public right-of-way or within the "safe sight distance triangle."

Any fence or wall erected in an easement or right-of-way may require removal, at the owner's expense, if access to the area is required for any purpose.

SITE INFORMATION

PROPERTY ADDRESS: 10840 SW 67 AVE
MIAMI, FL 33156

FOLIO: 20-5011-005-0151

SUBDIVISION: HELMS COUNTRY ESTS REPLAT

LEGAL DESCRIPTION: THE SOUTH 112, OF LOT 16, BLOCK 1, "REPLAT OF HELMS COUNTRY ESTATES", ACCORDING TO THE PLAT THEREOF, RECORDED IN PLAT BOOK 50, AT PAGE 48, OF THE PUBLIC RECORDS, OF MIAMI-DADE COUNTY, FLORIDA.

LOT AREA: 48675 SF (1.12 acres)

BUILDING INFORMATION

SCOPE OF WORK: NEW SINGLE FAMILY RESIDENCE TWO-STORY HIGH
8 BEDROOM + 10.5 BATHROOM
NEW DRIVEWAY
NEW WALKWAY

APPLICABLE CODES: 2023 FLORIDA BUILDING CODE 8TH EDITION
CODE OF ORDENANCES VILLAGE OF PINECREST

CONSTRUCTION TYPE: III B

OCCUPANCY CLASSIFICATION: R-3

CLASSIFICATION OF WORK: New Construction

LEVEL OF ALTERATION: N/A

REHABILITATION CATEGORY: N/A

AREA OF ALTERATION: 0 SF

FLOOD ZONE: "AE-10"
10' - 0" NGVD BASE FLOOD ELEVATION (BFE) FINISH
FLOOR ELEVATION TO BE LOCATED MIN 12" ABOVE BFE

DESIGN LEVEL (NGVD) 11' - 0"

PINECREST - ZONING EU-1


BUILDING DISPOSITION

LOT OCCUPATION	REQUIRED	PROVIDED
a. LOT AREA	43540 SF (1.0 ac)	48,675 SF
b. LOT WIDTH	125 FT. MIN.	165 FT
c. LOT DEPTH	200 FT. MIN.	295 FT
d. FAR COVERAGE	ONE-STORY STRUCTURE 20% (17,63 SF)	
	TWO-STORY STRUCTURE 20% MAX FIRST FLOOR (9,735 SF) 10% MAX SECOND FLOOR (4,867 SF)	FIRST FLOOR 9,708 SF SECOND FLOOR 4,805 SF
e. LOT COVERAGE	TWO-STORY 20% MAX (9,735 SF)	19.4% - 9,708 SF
f. IMPERVIOUS SURFACES	45% MAX (21,904 SF)	39.4% - 19,289 SF
g. GREEN SPACE	55% MIN (21,477.41 SF)	60.4% - 26,771

g. DENSITY	1 PRINCIPAL DWELLING PER UNIT ACRE	1 DWELLING UNIT
BUILDING SETBACK		
a. PRINCIPAL FRONT	50 FT. MIN.	SEE SETBACK DIAGRAM
b. SIDE STREET	30 FT. MIN.	N/A
c. SIDE INTERIOR	15 FT. MIN. 15% LOT WIDTH EACH SIDE MIN.	SEE SETBACK DIAGRAM
d. REAR	30 FT. MIN.	SEE SETBACK DIAGRAM
ACCESSORY SETBACK		
a. FRONT	50 FT. MIN.	N/A
b. SIDE STREET	30 FT. MIN.	N/A
c. SIDE INTERIOR	19.8 FT. MIN.	N/A
d. REAR	20 & 15 FT. MIN.	N/A

BUILDING CONFIGURATION		
BUILDING HEIGHT	REQUIRED	PROVIDED
a. PRINCIPAL BUILDING	2 STORIES AND 28 FT. TO TOP OF FLAT ROOF	27' 2" FT
b. ACCESSORY BUILDING	14 FT. MAX AT 15 FT REQ. SETBACK 18 FT. MAX AT 20 FT. SETBACK	N/A
PARKING		
	REQUIRED	PROVIDED
OFF-STREET PARKING	2	8

STALL MIN. SIZE	9 X 18 FT	9 X 18 FT
-----------------	-----------	-----------

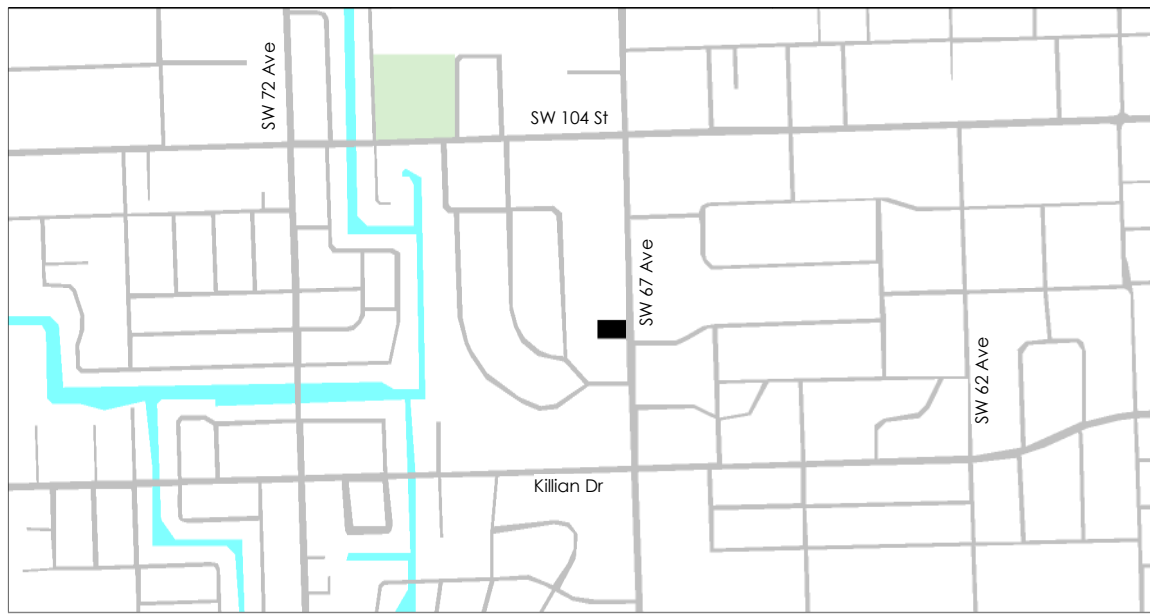

SITE LOCATION

1" = 160'-0"



MIK ARCHITECTURE LLC

MATIAS DAROCH
AR 100480
1380 CORAL WAY, SUITE 202
MIAMI, FLORIDA 33147
+1 786 758 0880
matias@mikarch.com




AGD DEVELOPERS LLC

1380 CORAL WAY, SUITE 202
MIAMI, FLORIDA 33147
agad@agd.com
develop@agd.com

NEW CONSTRUCTION
AGD CALISTONE LLC
10840 SW 67 AVE MIAMI, FL 33156

ISSUES	MAY 2025	131 ISSUES
2025-07-21	Correction 1	
2025-09-11	Correction 2	
2025-09-23	Correction 3	
2025-12-05	Correction 4	

JOB NO: #084
DRAWN BY: NS
CHECKED BY: MD
SCALE: AS NOTED
FROM: AA 26003995
SPE:

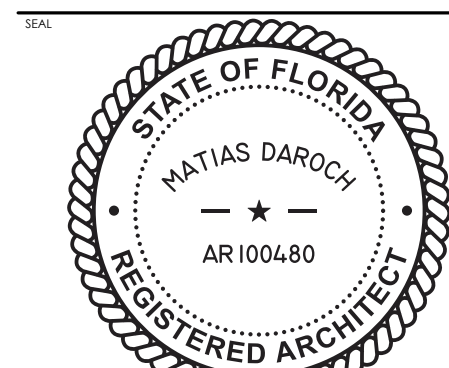

THIS IS A DIGITAL E-SIGNED SEAL. THE POWER OF THIS DOCUMENT ARE NOT
CONSIDERED SIGNED AND SEALED AND THE SIGNATURE MUST BE VERIFIED ON
THE ORIGINAL DOCUMENT.

THE CONTENT OF THIS SHEET AND ALL OTHER DRAWINGS ISSUED BY THE SET ARE
PROTECTED BY U.S. AND INTERNATIONAL COPYRIGHT LAWS. REPRODUCTION OR
USE WITHOUT PROPER WRITTEN CONSENT IS PROHIBITED BY LAW. SEE ALSO FOR
DETAILS.

A-100


SITE PLAN

FLOOD NOTES

- 1 ALL BUILDING MATERIALS BELOW A FOOT ABOVE THE BASE FLOOD ELEVATION, SHALL BE RESISTANT TO FLOOD DAMAGE AS PER TECHNICAL BULLETIN 2 FROM FEMA.
- 2 INSULATED ENGINEERED VENT - SMART VENT MODEL 1540-520. INSTALL AS PER MANUF. INSTRUCTIONS EVERY 200 SF OF ENCLOSED AREA
- 3 DUAL-FUNCTION ENGINEERED FLOOD VENT - SMART VENT MODEL 1540-510. INSTALL AS PER MANUF. INSTRUCTIONS EVERY 200 SF OF ENCLOSED AREA
- 4 GARAGE AREA: 850 SF / 200 SF = 5 FLOOD VENTS.

BL2025-0584 APPROVED
waivers02/11/20262:38:18

PINECREST
BUILDING +
PLANNING

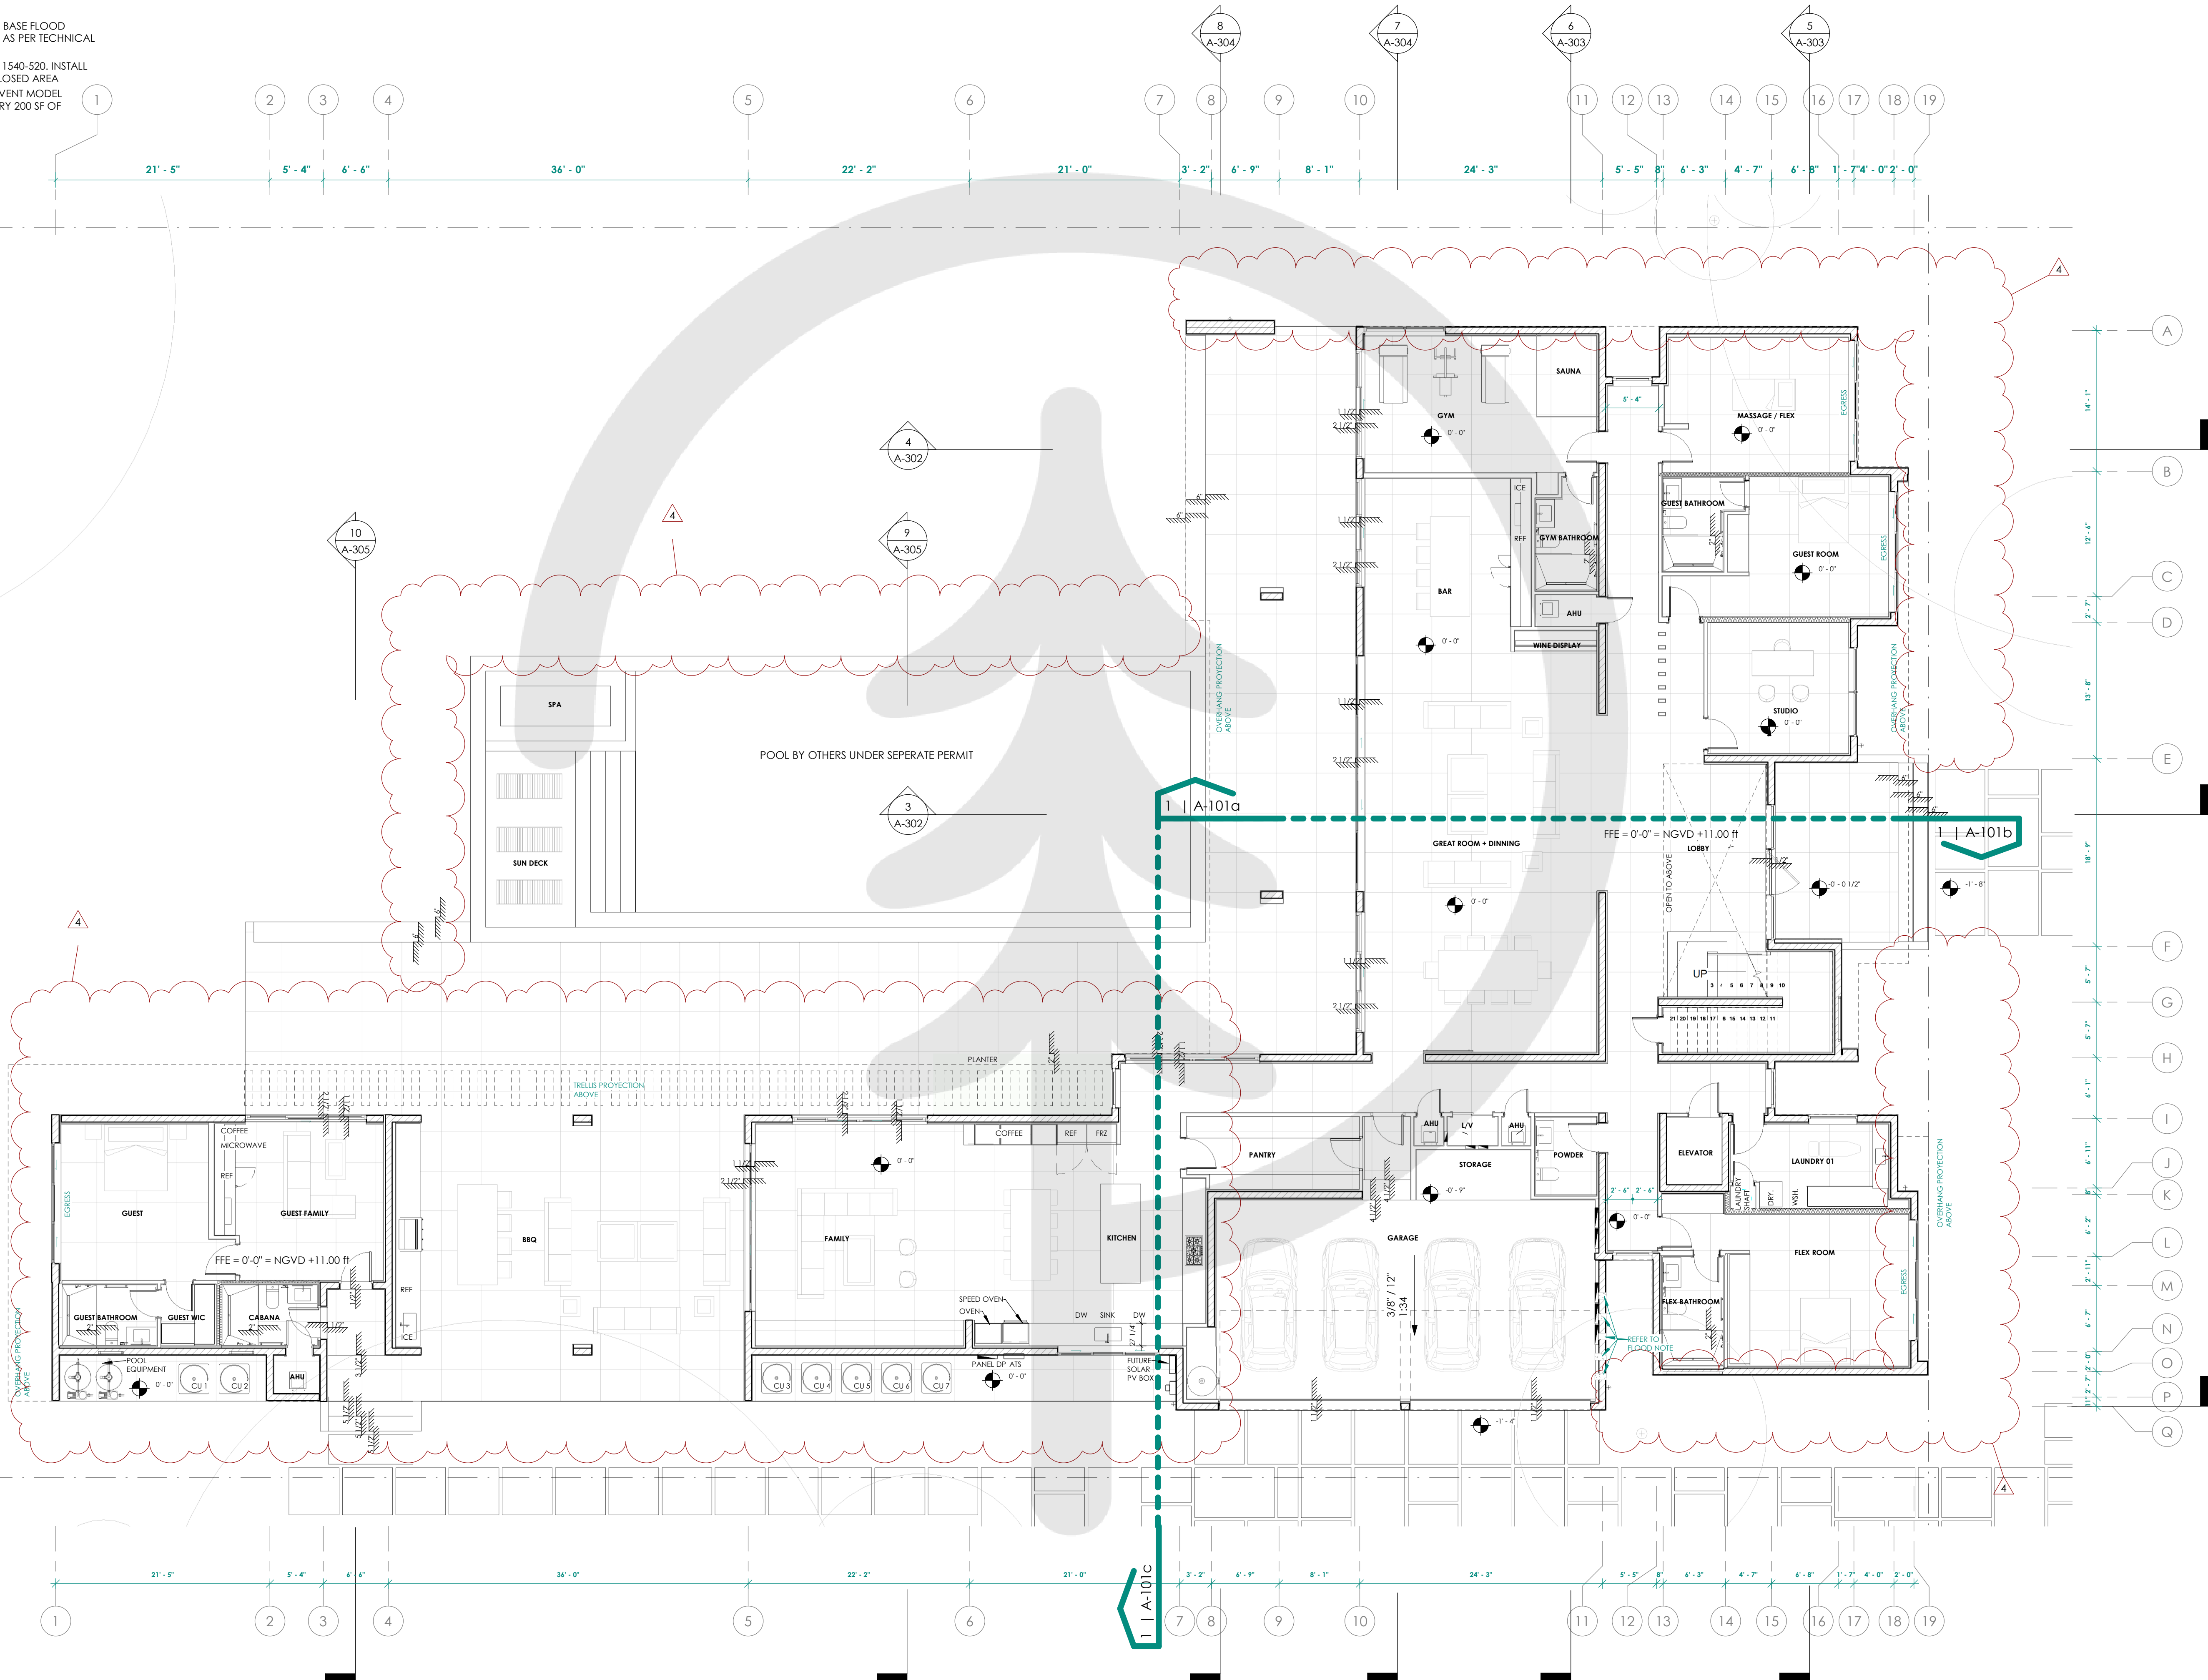

FIRST FLOOR PLAN

1/8" = 1'-0"

1



MIK ARCHITECTURE LLC
MATIAS DAROCH
AR 100480
1383 CORAL WAY, SUITE 202
MIAMI, FLORIDA 33145
+1 786 758 5882
miki@mikarch.com




AGD DEVELOPERS LLC
1383 CORAL WAY, SUITE 202
MIAMI, FLORIDA 33145
agdmiami.com
developers@agdmiami.com

NEW CONSTRUCTION
AGD CALISTONE LLC
10840 SW 67 AVE MIAMI, FL 33156

ISSUES	MAY 2025	1ST ISSUED
	2025-07-21	Correction 1
	2025-09-11	Correction 2
	2025-09-23	Correction 3
	2025-12-05	Correction 4

JOB NO. #084
DRAWN BY NS
CHECKED BY MD
SCALE AS NOTED
FROM AA 26003995
SEP

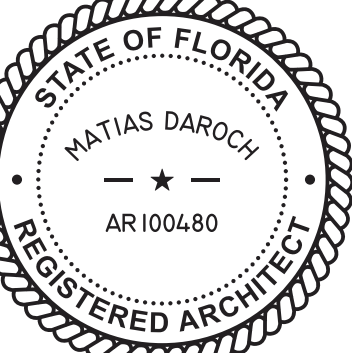



THIS IS A DIGITALLY SIGNED SET. THE PRINTED COPY OF THIS DOCUMENT ARE NOT CONSIDERED SIGNED AND SEALED AND THE SIGNATURE MUST BE VERIFIED ON THE DIGITAL COPY.
THE CONTENT OF THIS SHEET AND ALL OTHER DRAWINGS ISSUED IN THE SET ARE PROTECTED BY U.S. AND INTERNATIONAL COPYRIGHT LAWS. REPRODUCTION OR USE WITHOUT PROPER WRITTEN CONSENT IS PROHIBITED BY LAW. SEE ALSO FOR DETAILS.
SHEET NO.

A-101

FIRST FLOOR PLAN

BL2025-0584 APPROVED
waite02/11/2026 2:38:18 PM

PINECREST
BUILDING
PLANNING

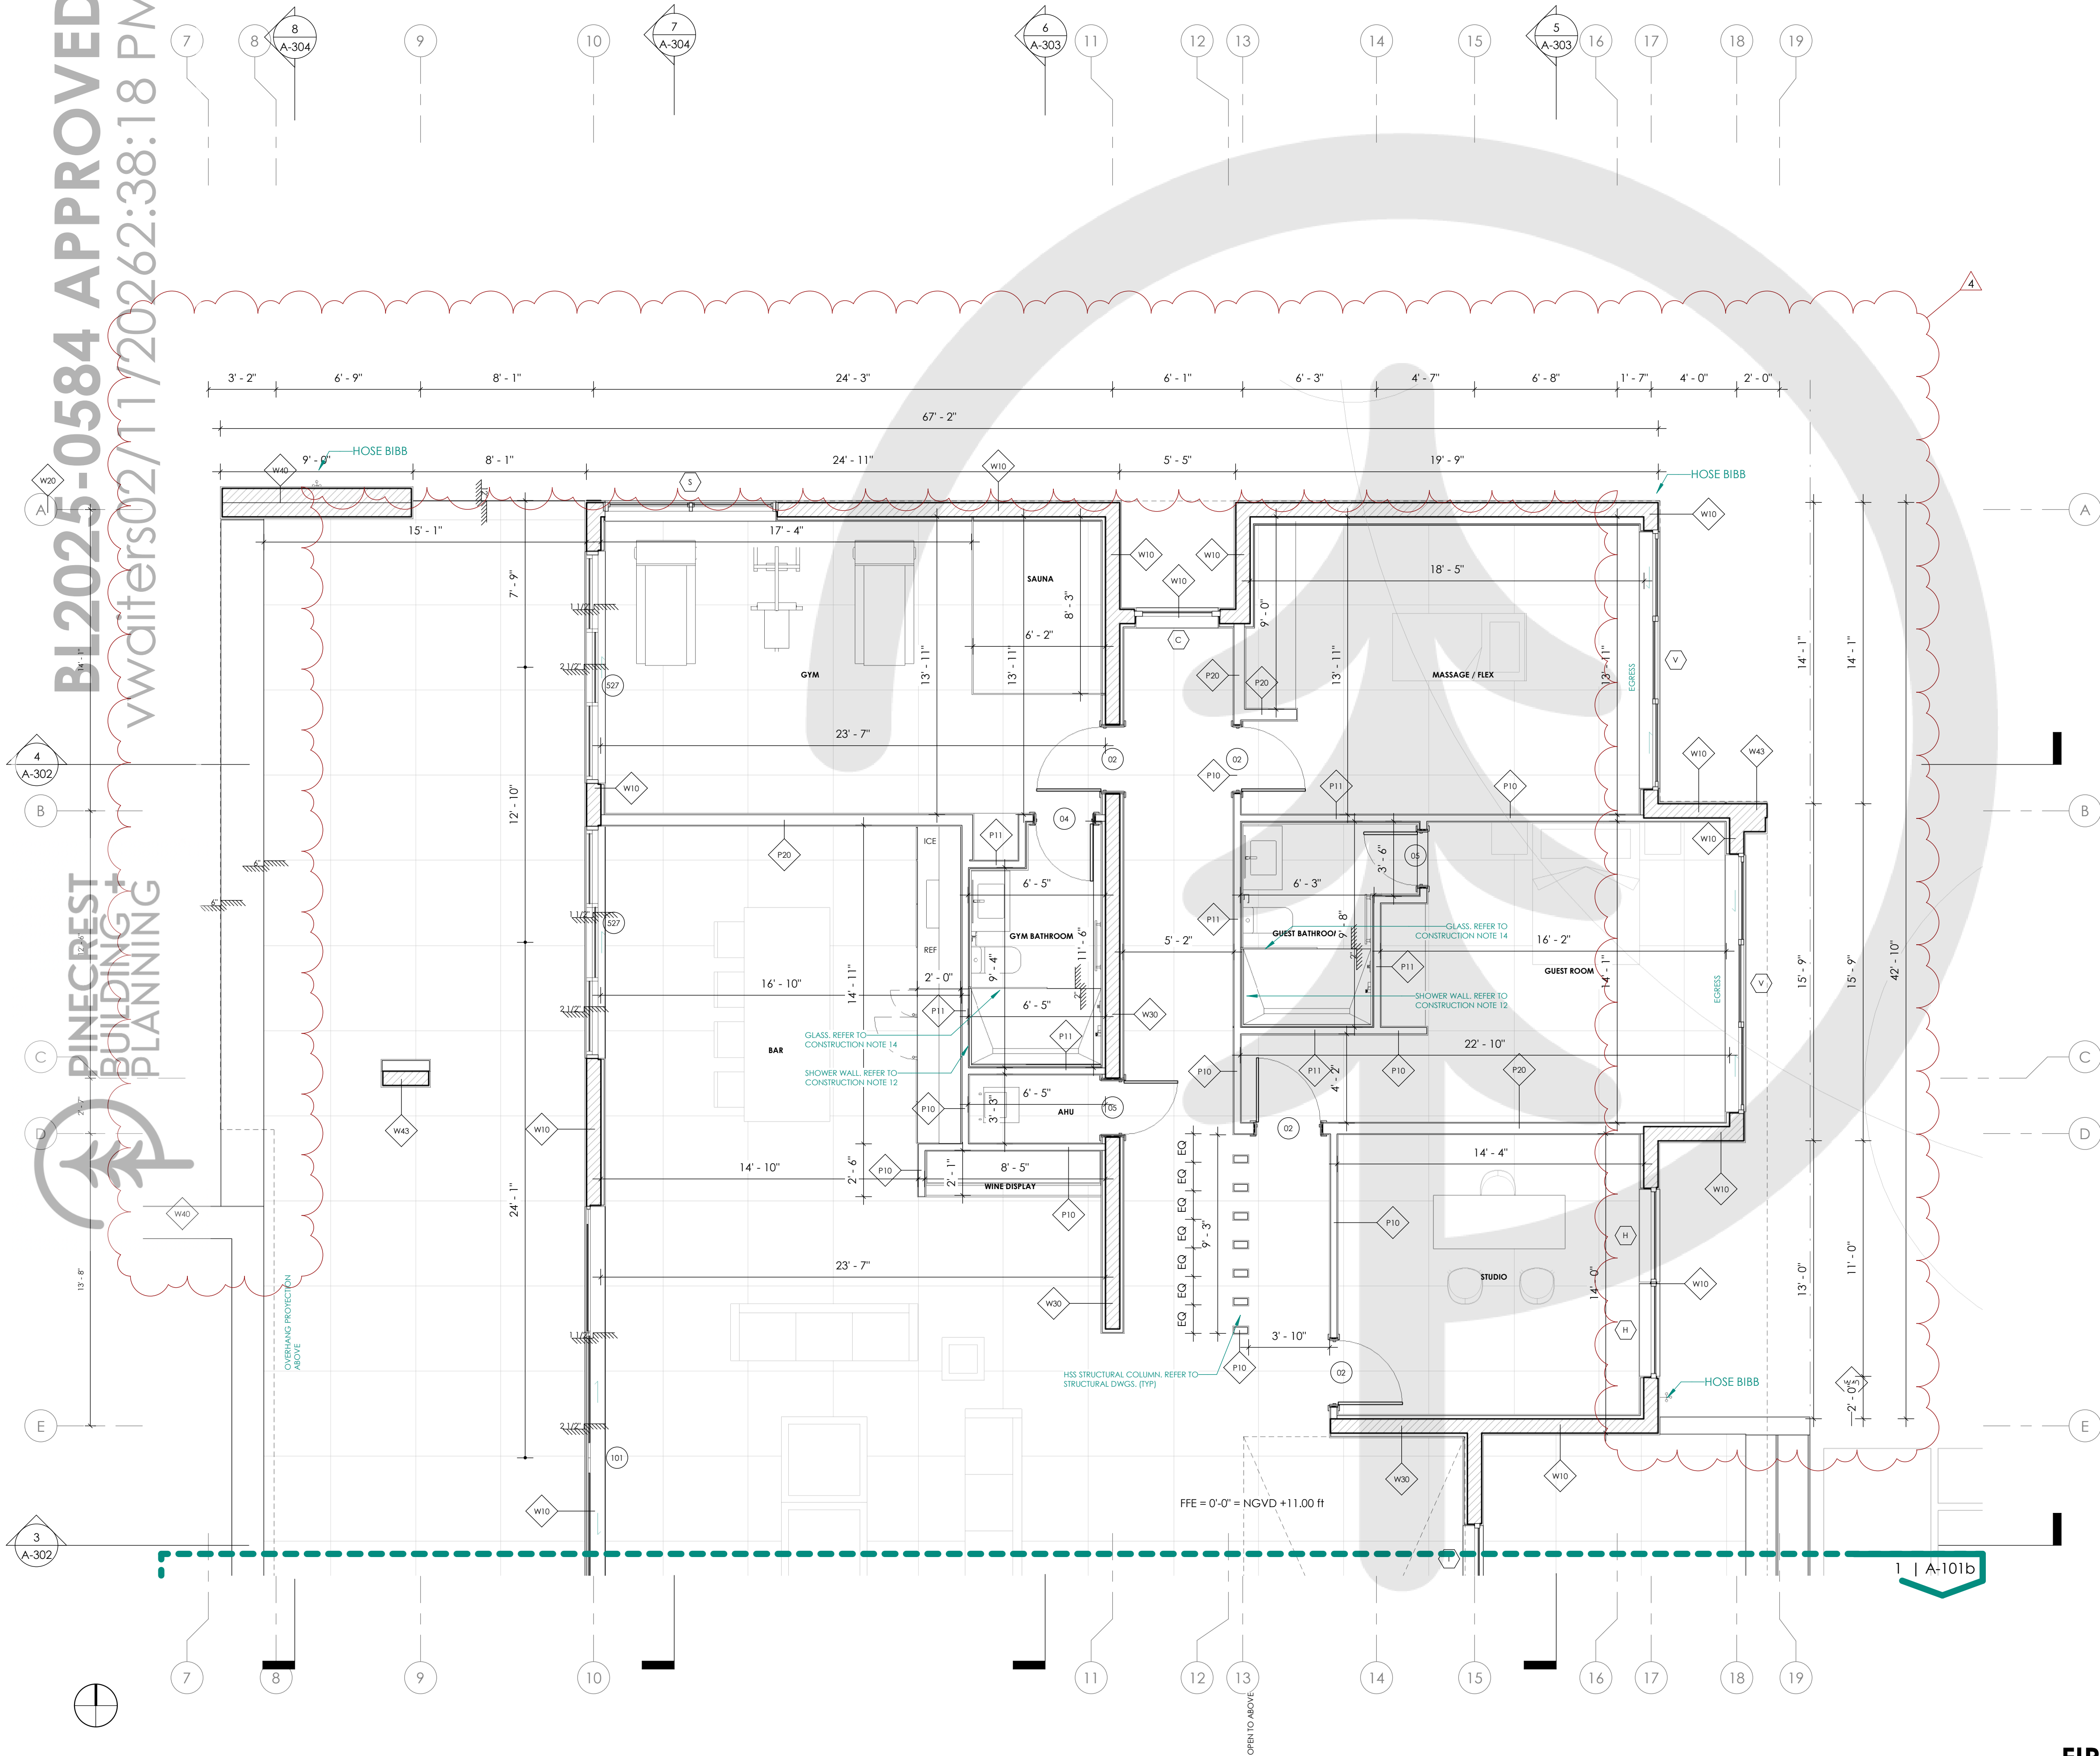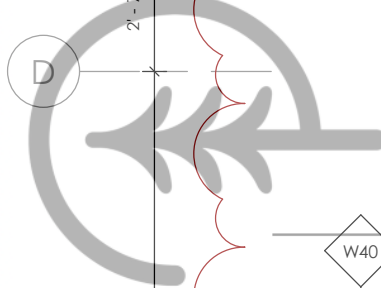


CONSTRUCTION NOTES

- ALL INTERIOR CONSTRUCTION SHALL COMPLY WITH ALL APPLICABLE CODES AND ORDINANCES IN PLACE IN THE LOCATION OF WORK. CORRIDORS AND ALL OTHER CLEARANCES SHOULD BE CHECKED WITH ARCHITECT PRIOR TO THE FABRICATION OF ANY WORK. CONTRACTOR SHALL BE RESPONSIBLE FOR CORRECTING SAME AT HIS OWN EXPENSE.
- ALL ROUGH CARPENTRY WOODWORK SHALL BE TREATED FOR FIRE RETARDATION WITH U.L. APPROVED MATERIAL. FLAME SPREAD RATING NOT TO EXCEED 25.
- CONTRACTOR SHALL FURNISH AND INSTALL NEW ACCESS DOORS WHEREVER REQUIRED FOR PLUMBING, ELECTRICAL, HVAC, SPRINKLER, ETC. SYSTEMS FOR WORK ACCESS AND MAINTENANCE.
- CONTRACTOR SHALL PLACE BACKING IN WALLS THAT SUPPORT UNITIES ACCORDING TO SPECS. AT BATHROOMS, KITCHENS OR WHERE IT IS OTHER NOTED, AND PROVIDE ALL SUCH BLOCKING PRIOR TO CLOSING UP ANY AND ALL WALLS, COLUMNS, ETC. TO MEET SUCH REQUIREMENTS. SEE CARPENTRY SHOP DRAWINGS FOR ALL FIXTURE INFORMATION.
- FILL AND SEAL ALL EXISTING CORE DRILLED HOLES LEFT UNUSED IN THE FLOOR SLAB AND CEILING SLAB.
- MATERIALS USED AS BACKERS FOR WALL TILE IN TUB AND SHOWER AREAS AND WALL PANELS IN SHOWER AREAS SHALL BE OF MATERIALS LISTED IN TABLE R702.4.2 AND INSTALLED IN ACCORDANCE WITH THE MANUFACTURER'S RECOMMENDATIONS. AS PER FBC R702.4.2
- PATCH AND REPAIR OR REPLACE ALL EXISTING AND NEW WORK DAMAGED BY CONSTRUCTION.
- LAMINATE AND OR PLASTER ALL EXPOSED CORE WALLS, PERIMETER COLUMNS, WALL & SLAB SURFACES WHICH ARE DAMAGE OR MISSING WITH ONE NEW LAYER OF GYPSUM BOARD SHIM IS REQUIRED, UNLESS OTHERWISE NOTED.
- GENERAL CONTRACTOR SHALL REPAIR ANY LOOSE OR MISSING FIREPROOFING ON STRUCTURAL ELEMENTS AND OTHER FIRE RATED ELEMENTS OF THE SPACE.
- NEW WALLS ARE DIMENSIONED TO THE FINISH FACE OF WALL THICKNESS UNLESS OTHERWISE NOTED. ALL GYPSUM BOARD TO BE 5/8" THICKNESS, UNLESS OTHERWISE NOTED. GREEN BOARD, TO BE USED IN TOILETS WHERE PAINT IS USED AND DUROCK IN TOILETS WHERE TILE IS USED.
- MIN SHOWER ACCESS SHALL BE 22" CLEAR.
- BATHTUB AND SHOWER FLOORS AND ABOVE BATHTUBS WITH INSTALLED SHOWER HEADS AND IN SHOWER COMPARTMENTS SHALL BE FINISHED WITH A NONABSORBENT SURFACE. SUCH WALL SURFACES SHALL EXTEND TO A HEIGHT OF NOT LESS THAN 6 FEET (1829 MM) ABOVE THE FLOOR. AS PER FBC B 2406 AND/OR FBC R307.2.
- REQUIRED GUARDS SHALL NOT HAVE OPENINGS FROM THE WALKING SURFACE TO THE REQUIRED GUARD HEIGHT THAT ALLOW PASSAGE OF A SPHERE 4 INCHES (102 MM) IN DIAMETER. AS PER FBC R312.1.3.
- ANY GLAZING MATERIAL IN ANY WINDOW ADJACENT TO TUB AND SHOWER COMPARTMENTS, SHOWER ENCLOSURES AND GLAZING LARGER THAN 9 SQ. FT. SHALL BE CATEGORY II SAFETY GLASS. TO COMPLY WITH FBC B 2406.1 AND/OR FBC R308, MANUFACTURER SHALL STORE GLASS ON SITE READILY ACCESSIBLE FOR INSPECTION.
- ALL NEW FINISHES (WALL/CEILING/FLOOR/TRIM/DECOR), ARE TO COMPLY WITH FBCB CHAPTER 8, FOR FLAME SPREAD AND SMOKE DEVELOPMENT CLASSIFICATION.
- OPENINGS FROM A PRIVATE GARAGE DIRECTLY INTO A ROOM USED FOR SLEEPING PURPOSES SHALL NOT BE PERMITTED. OTHER OPENINGS BETWEEN THE GARAGE AND RESIDENCE SHALL BE EQUIPPED WITH SOLID WOOD DOORS NOT LESS THAN 1.38 INCHES (35MM) IN THICKNESS, SOLID OR HONEYCOMB-CORE STEEL DOORS NOT LESS THAN 1.38 INCHES THICK, OR 20-MINUTE FIRE-RATED DOORS.

WALL LEGEND

- TYPICAL NON LOAD BEARING 8" CMU WALL W/ VERTICAL REINFORCING. SEE TYPICAL WALL TYPES AND STRUCTURAL DRAWINGS FOR DETAILS.
- REINFORCED CONCRETE WALL. SEE TYPICAL WALL TYPES AND STRUCTURAL DRAWINGS FOR DETAILS.
- TYP 4" INTERIOR PARTITIONS. SEE TYPICAL WALL TYPES FOR DETAILS.
- TYP 6" INTERIOR PARTITIONS. SEE TYPICAL WALL TYPES FOR DETAILS.

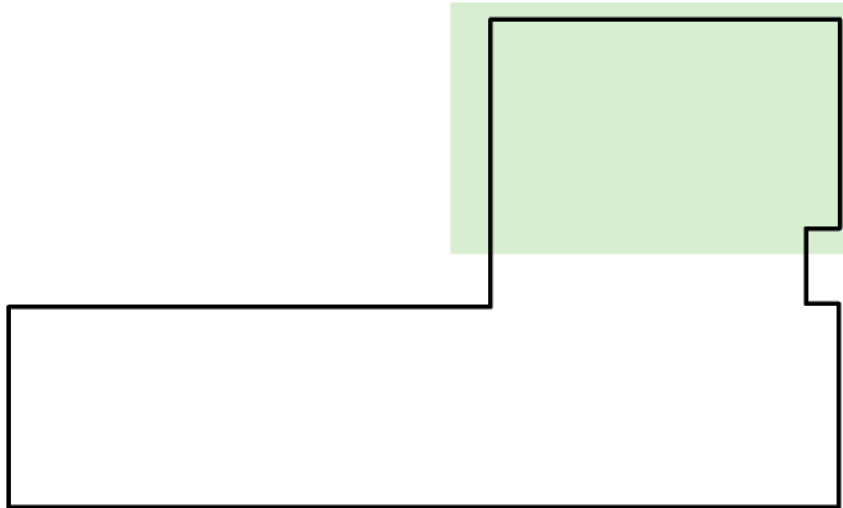

LOCATION DIAGRAM A

FIRST FLOOR PLAN
1/4" = 1'-0"




MIK ARCHITECTURE LLC
MATIAS DAROCH
AR 100480
1380 CORAL WAY, SUITE 202
MIAMI, FLORIDA 33145
+1 786 588 0880
matias@mikarch.com

AGD DEVELOPERS LLC
1380 CORAL WAY, SUITE 202
MIAMI, FLORIDA 33145
agdev.com
dev@agdev.com

NEW CONSTRUCTION
AGD CALISTONE LLC
10840 SW 67 AVE MIAMI, FL 33156

ISSUES	DATE	DESCRIPTION
1	MAY 2025	1ST ISSUED
2	2025-07-23	Correction 1
3	2025-09-23	Correction 3
4	2025-12-05	Correction 4

JOB NO. #084
DRAWN BY NS
CHECKED BY MD
SCALE AS NOTED
FROM AA 26003995
SEP

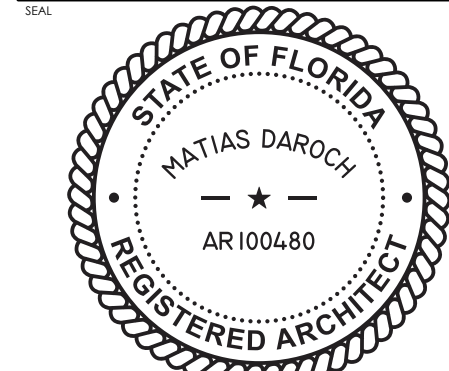


THIS IS A DIGITAL E-SIGNED SEAL. THE CONTENTS OF THIS DOCUMENT ARE NOT CONSIDERED SIGNED AND SEALED UNTIL THE SIGNATURE HAS BEEN VERIFIED ON THE SIGNING DEVICE.

THE CONTENT OF THIS SHEET AND ALL OTHER DRAWINGS ISSUED BY THE SET ARE PROTECTED BY U.S. AND INTERNATIONAL COPYRIGHT LAWS. REPRODUCTION OR USE WITHOUT PROPER WRITTEN CONSENT IS PROHIBITED BY LAW. SEE ALSO FOR DETAILS.


SHEET NO.

A-101a

FIRST FLOOR PLAN

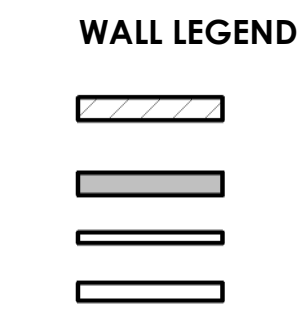

- 1 ALL BUILDING MATERIALS BELOW A FOOT ABOVE THE BASE FLOOD ELEVATION, SHALL BE RESISTANT TO FLOOD DAMAGE AS PER TECHNICAL BULLETING 2 FROM FEMA.
- 2 INSULATED ENGINEERED VENT - SMART VENT MODEL 1540-520. INSTALL AS PER MANUF. INSTRUCTIONS EVERY 200 SF OF ENCLOSED AREA
- 3 DUAL-FUNCTION ENGINEERED FLOOD VENT - SMART VENT MODEL 1540-510. INSTALL AS PER MANUF. INSTRUCTIONS EVERY 200 SF OF ENCLOSED AREA
- 4 GARAGE AREA: 850 SF / 200 SF = 5 FLOOD VENTS.

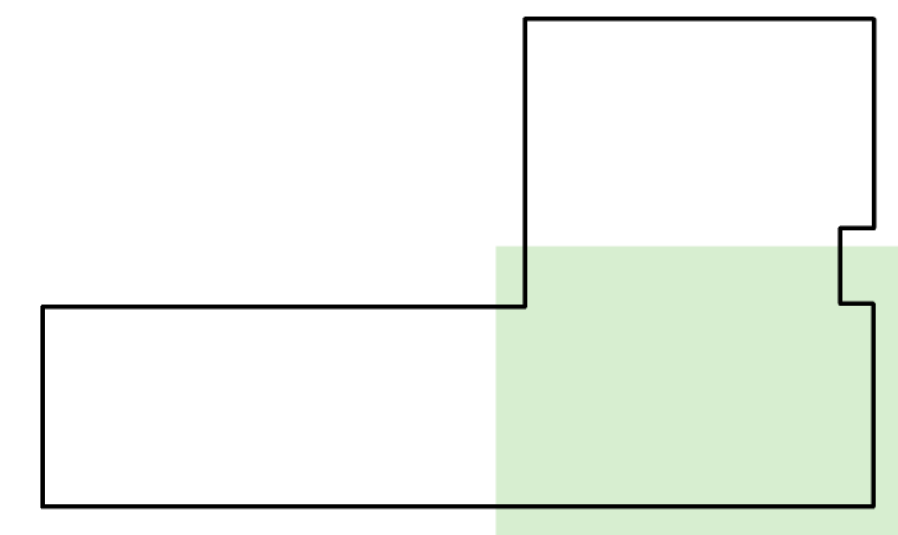


FIRST FLOOR PLAN $\frac{1}{4}" = 1'-0"$ **1**



AGD DEVELOPERS LLC
 1385 CORAL WAY, SUITE 202
 MIAMI, FLORIDA 33145
 agdmiami.com
 developers@agdmiami.com

NEW CONSTRUCTION
AGD CALISTONE LLC
10840 SW 67 AVE MIAMI, FL 33156

ISSUES	MAY 2025	1ST ISSUED
	2025-07-21	Correction 1
	2025-09-23	Correction 3
	2025-12-05	Correction 4
		
		
		
		

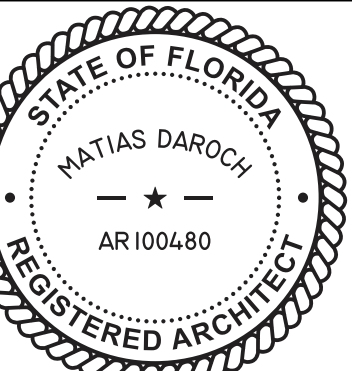

THIS IS A DIGITALLY SIGNED SHEET. PRINTED COPIES OF THIS DOCUMENT ARE CONSIDERED SIGNED AND SEALED AND THE SIGNATURE MUST BE VERIFIED ANY ELECTRONIC COPIES.

THE CONTENT OF THIS SHEET AND ALL OTHER DRAWINGS ISSUED IN THIS SET ARE PROTECTED BY U.S. AND INTERNATIONAL COPYRIGHT LAWS. REPRODUCTION WITHOUT PROPER WRITTEN CONSENT IS PROHIBITED BY LAW. SEE A-001 FOR DETAILS.

ACET 888

A-101b

FLOOR PLAN

CONSTRUCTION NOTES

- ALL INTERIOR CONSTRUCTION SHALL COMPLY WITH ALL APPLICABLE CODES AND ORDINANCES IN PLACE IN THE LOCATION OF WORK. CORRIDORS AND ALL OTHER CLEARANCES SHOULD BE CHECKED WITH ARCHITECT PRIOR TO THE FABRICATION OF ANY WORK. CONTRACTOR SHALL BE RESPONSIBLE FOR CORRECTING SAME AT HIS OWN EXPENSE.
- ALL ROUGH CARPENTRY WOODWORK SHALL BE TREATED FOR FIRE RETARDATION WITH U.L. APPROVED MATERIAL. FLAME SPREAD RATING NOT TO EXCEED 25.
- CONTRACTOR SHALL FURNISH AND INSTALL NEW ACCESS DOORS WHEREVER REQUIRED FOR PLUMBING, ELECTRICAL, HVAC, SPRINKLER, ETC. SYSTEMS FOR WORK ACCESS AND MAINTENANCE.
- CONTRACTOR SHALL PLACE BACKING IN WALLS THAT SUPPORT UNITIES ACCORDING TO SPECS. AT BATHROOMS, KITCHENS OR WHERE IT IS OTHER NOTED, AND PROVIDE ALL SUCH BLOCKING PRIOR TO CLOSING UP ANY AND ALL WALLS, COLUMNS, ETC. TO MEET SUCH REQUIREMENTS. SEE CARPENTRY SHOP DRAWINGS FOR ALL FUTURE INFORMATION.
- FILL AND SEAL ALL EXISTING CORE DRILLED HOLES LEFT UNUSED IN THE FLOOR SLAB AND CEILING SLAB.

CONSTRUCTION NOTES

- MATERIALS USED AS BACKERS FOR WALL TILE IN TUB AND SHOWER AREAS AND WALL PANELS IN SHOWER AREAS SHALL BE OF MATERIALS LISTED IN TABLE R702.4.2 AND INSTALLED IN ACCORDANCE WITH THE MANUFACTURER'S RECOMMENDATIONS, AS PER FBC R702.4.2
- PATCH AND REPAIR OR REPLACE ALL EXISTING AND NEW WORK DAMAGED BY CONSTRUCTION.
- LAMINATE AND OR PLASTER ALL EXPOSED CORE WALLS, PERIMETER COLUMNS, WALL & SLAB SURFACES WHICH ARE DAMAGE OR MISSING WITH ONE NEW LAYER OF GYPSUM BOARD SHIM IS REQUIRED, UNLESS OTHERWISE NOTED.
- GENERAL CONTRACTOR SHALL REPAIR ANY LOOSE OR MISSING FIREPROOFING ON STRUCTURAL ELEMENTS AND OTHER FIRE RATED ELEMENTS OF THE SPACE.
- NEW WALLS ARE DIMENSIONED TO THE FINISH FACE OF WALL THICKNESS UNLESS OTHERWISE NOTED. ALL GYPSUM BOARD TO BE 5/8" THICKNESS, UNLESS OTHERWISE NOTED. GREEN BOARD, TO BE USED IN TOILETS WHERE PAINT IS USED AND DUROCK IN TOILETS WHERE TILE IS USED.


CONSTRUCTION NOTES

- MIN SHOWER ACCESS SHALL BE 22" CLEAR.
- BATHTUB AND SHOWER FLOORS AND ABOVE BATHTUBS WITH INSTALLED SHOWER HEADS AND IN SHOWER COMPARTMENTS SHALL BE FINISHED WITH A NONABSORBENT SURFACE. SUCH WALL SURFACES SHALL EXTEND TO A HEIGHT OF NOT LESS THAN 6 FEET (1829 MM) ABOVE THE FLOOR, AS PER FBC B 2406 AND/OR FBC R307.2.
- REQUIRED GUARDS SHALL NOT HAVE OPENINGS FROM THE WALKING SURFACE TO THE REQUIRED GUARD HEIGHT THAT ALLOW PASSAGE OF A SPHERE 4 INCHES (102 MM) IN DIAMETER. AS PER FBC R312.1.3.
- ANY GLAZING MATERIAL IN ANY WINDOW ADJACENT TO TUB AND SHOWER COMPARTMENTS, SHOWER ENCLOSURES AND GLAZING LARGER THAN 9 SQ. FT. SHALL BE CATEGORY II SAFETY GLASS, TO COMPLY WITH FBC B 2406.1 AND/OR FBC R308. MANUFACTURER SHALL STORE GLASS ON SITE READILY ACCESSIBLE FOR INSPECTION.
- ALL NEW FINISHES (WALL/CEILING/FLOOR/TRIM/DECOR), ARE TO COMPLY WITH FBCB CHAPTER 8, FOR FLAME SPREAD AND SMOKE DEVELOPMENT CLASSIFICATION.

CONSTRUCTION NOTES

- OPENINGS FROM A PRIVATE GARAGE DIRECTLY INTO A ROOM USED FOR SLEEPING PURPOSES SHALL NOT BE PERMITTED. OTHER OPENINGS BETWEEN THE GARAGE AND RESIDENCE SHALL BE EQUIPPED WITH SOLID WOOD DOORS NOT LESS THAN 1.38 INCHES (35MM) IN THICKNESS, SOLID OR HONEYCOMB-CORE STEEL DOORS NOT LESS THAN 1.38 INCHES THICK, OR 20-MINUTE FIRE-RATED DOORS.

WALL LEGEND

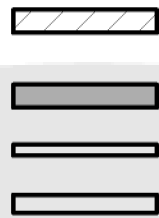


TYPICAL NON-LOAD BEARING 8' CMU WALL W/ VERTICAL REINFORCING. SEE TYPICAL WALL TYPES AND STRUCTURAL DRAWINGS FOR DETAILS.

REINFORCED CONCRETE WALL. SEE TYPICAL WALL TYPES AND STRUCTURAL DRAWINGS FOR DETAILS.

TYP. 4' INTERIOR PARTITIONS. SEE TYPICAL WALL TYPES FOR DETAILS.

TYP. 6' INTERIOR PARTITIONS. SEE TYPICAL WALL TYPES FOR DETAILS.

LOCATION DIAGRAM C

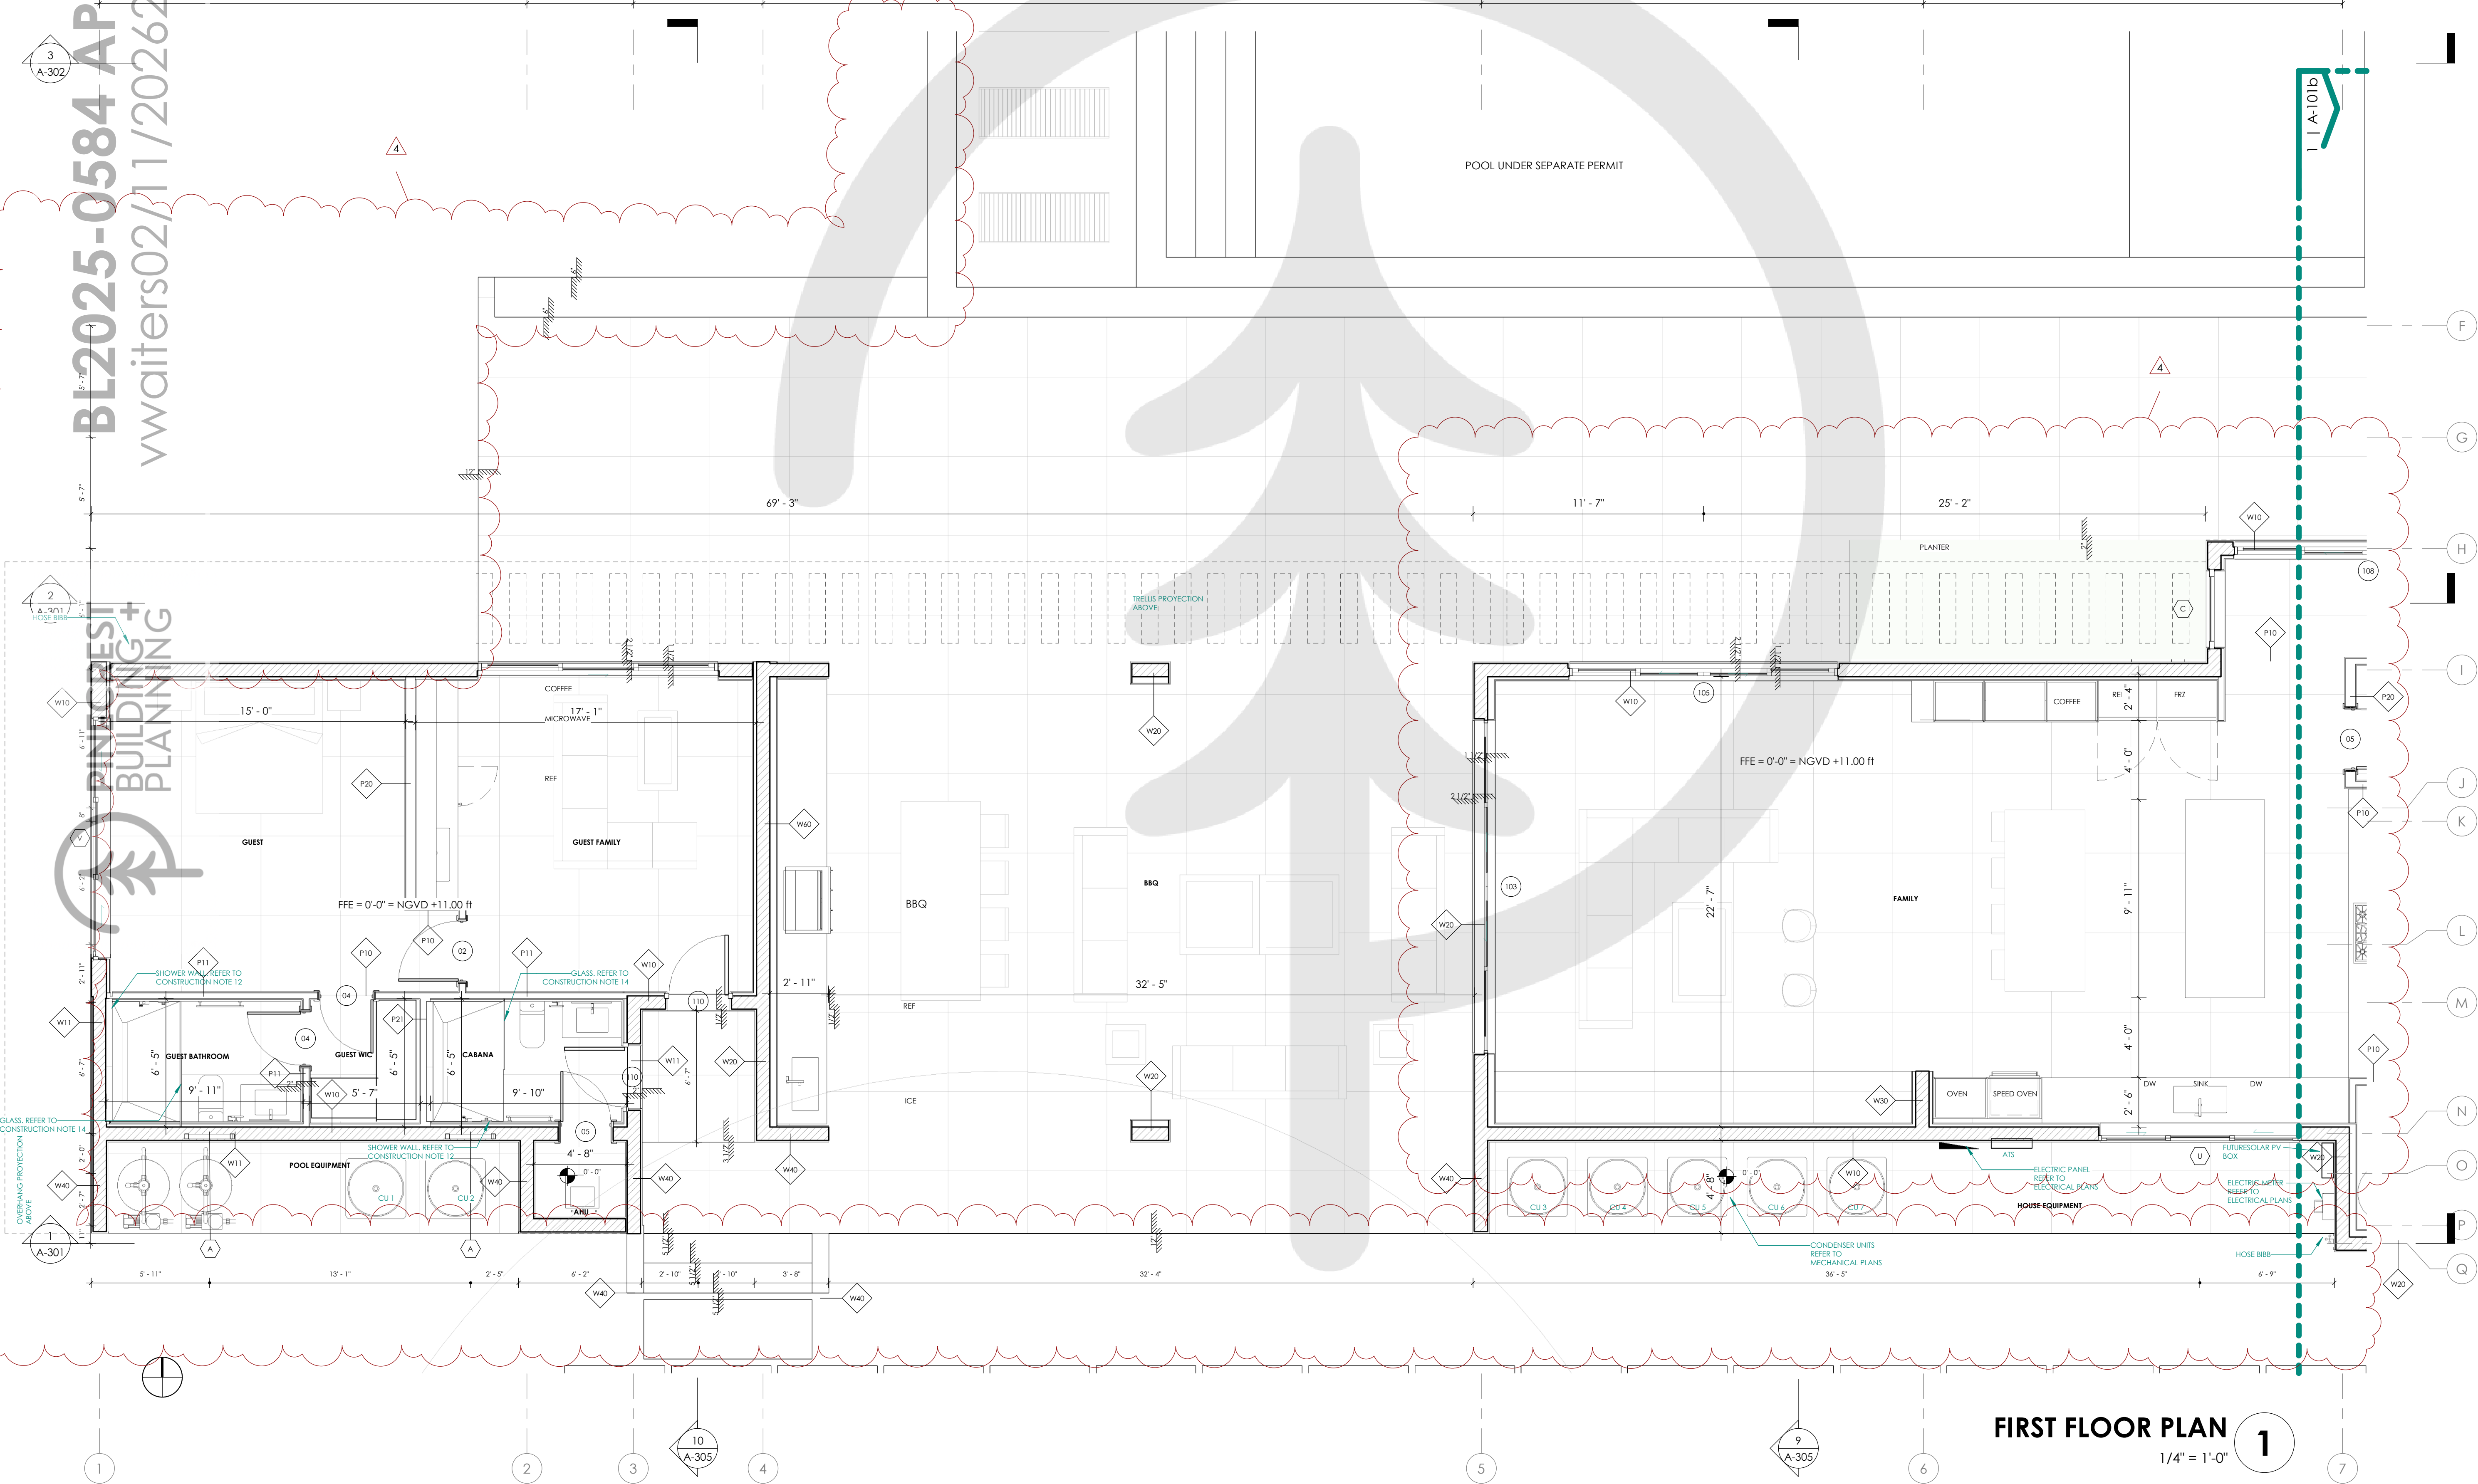

FIRST FLOOR PLAN

1/4" = 1'-0"

1



MIK ARCHITECTURE LLC

MATIAS DAROCH
AR 100480
1383 CORAL WAY, SUITE 202
MIAMI, FLORIDA 33145
+1 786 788 0880
matias@mikarch.com




AGD DEVELOPERS LLC

1383 CORAL WAY, SUITE 202
MIAMI, FLORIDA 33145
agdmiami.com
dev@agdmiami.com

NEW CONSTRUCTION
AGD CALISTONE LLC
10840 SW 67 AVE MIAMI, FL 33156

ISSUES	DATE	DESCRIPTION
1	MAY 2025	1ST ISSUED
2	2025-07-21	Correction 1
3	2025-09-11	Correction 2
4	2025-09-23	Correction 3
5	2025-12-05	Correction 4

JOB NO. #084
DRAWN BY NS
CHECKED BY MD
SCALE AS NOTED
FIGS. AA 26003995
SER.

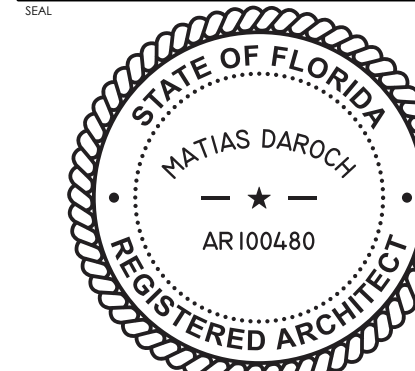

THIS IS A DIGITALLY SIGNED SET. THE CONTENTS OF THIS DOCUMENT ARE NOT CONSIDERED SIGNED AND SEALED UNTIL THE SIGNATURE HAS BEEN VERIFIED ON THE SIGNING CODES.


THE CONTENT OF THIS SHEET AND ALL OTHER DRAWINGS ISSUED BY THE SET ARE PROTECTED BY U.S. AND INTERNATIONAL COPYRIGHT LAWS. REPRODUCTION OR USE WITHOUT PROPER WRITTEN CONSENT IS PROHIBITED BY LAW. SEE ALSO FOR DETAILS.

A-101c

FIRST FLOOR PLAN



BL2025-0584 APPROVED
vwaiters02/11/20262:38:19 PM

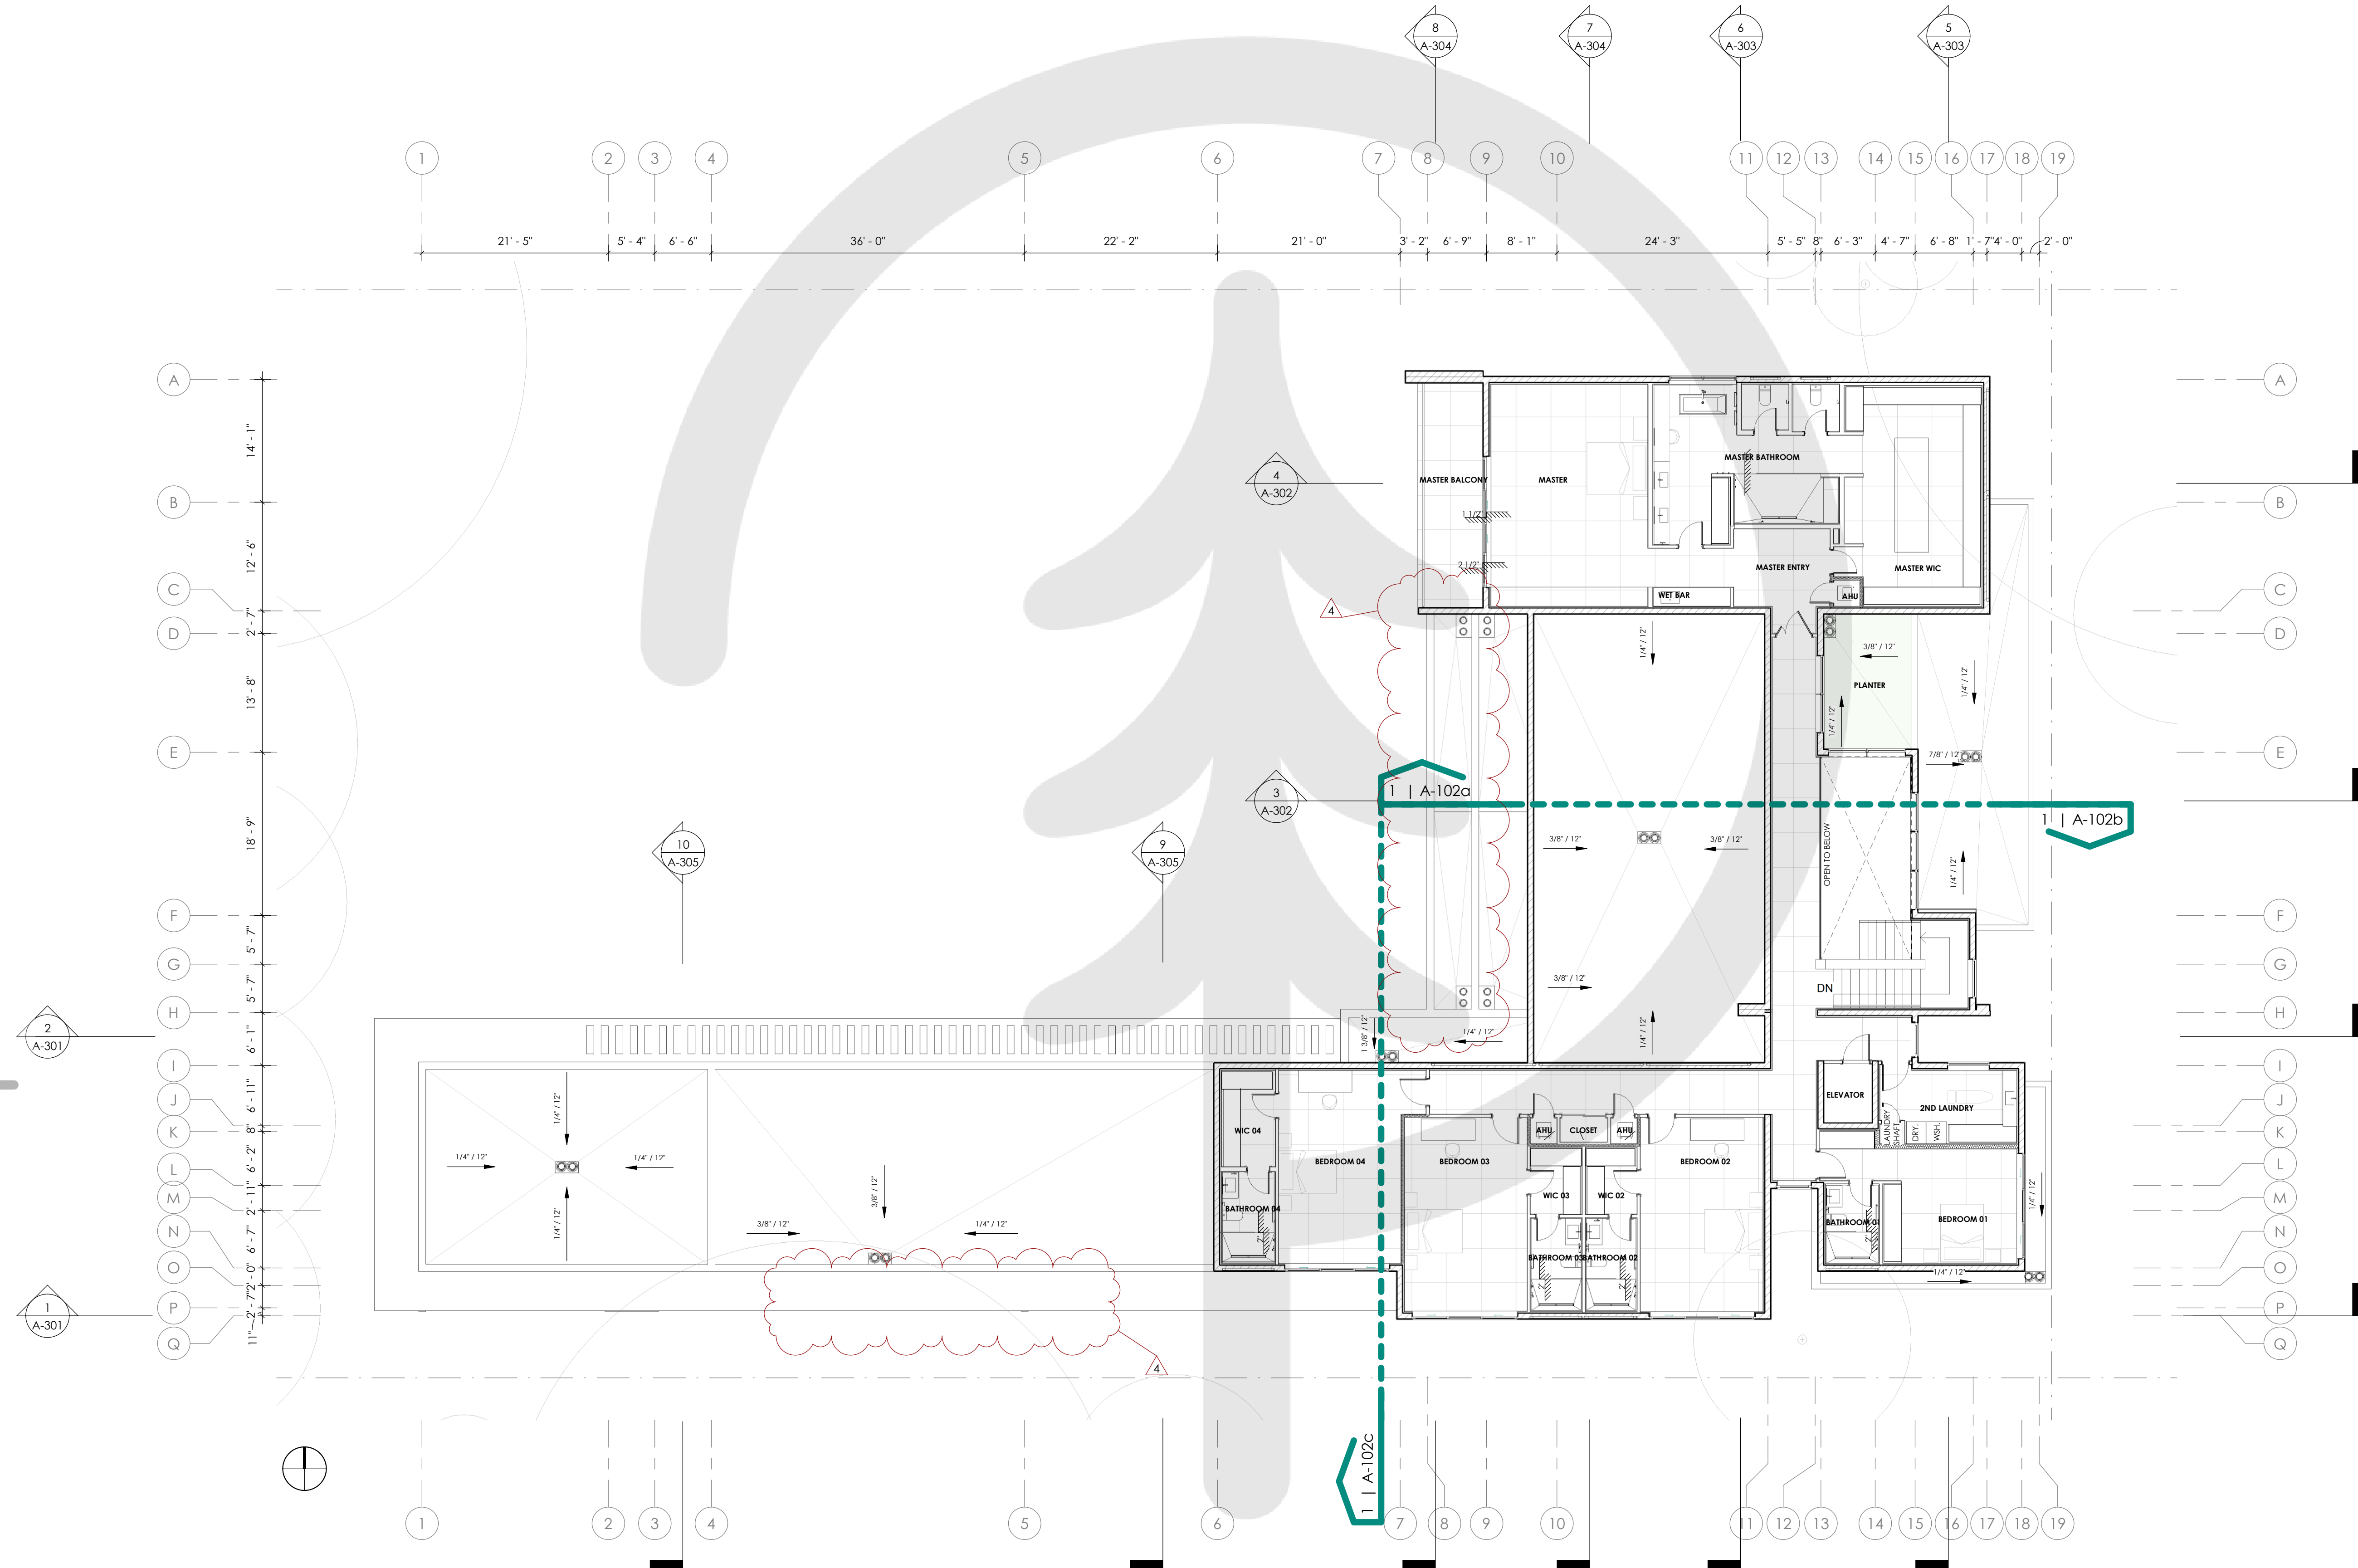

SECOND FLOOR PLAN

1" = 10'-0"

1



MIK ARCHITECTURE LLC
MATIAS DAROCH
AR 100480
1383 CORAL WAY, SUITE 202
MIAMI, FLORIDA 33145
+1 786 758 0882
miki@mikarch.com




AGD DEVELOPERS LLC
1383 CORAL WAY, SUITE 202
MIAMI, FLORIDA 33145
agdmiami.com
developers@agdmiami.com

NEW CONSTRUCTION
AGD CALISTONE LLC
10840 SW 67 AVE MIAMI, FL 33156

ISSUES	MAY 2025	131 ISSUED
	2025-12-05	Correction 4

JOB NO.	#084
DRAWN BY	NS
CHECKED BY	MD
SCALE	AS NOTED
FROM	AA 26003995
DATE	

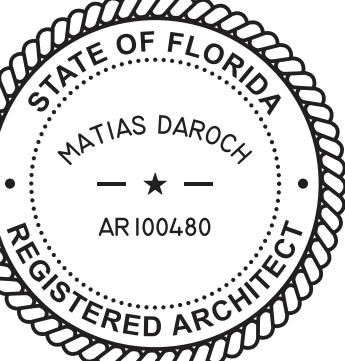



THIS IS A DIGITALLY SIGNED FILE. THE CONTENTS OF THIS DOCUMENT ARE NOT
PROTECTED BY U.S. AND INTERNATIONAL COPYRIGHT LAWS. REPRODUCTION OR
USE WITHOUT PROPER WRITTEN CONSENT IS PROHIBITED BY LAW. SEE ALSO FOR
DETAILS.

A-102

SECOND FLOOR PLAN

BL2025-0584 APPROVED
vwa02/11/20262:38:19 PM

PINECREST
BUILDING +
PLANNING

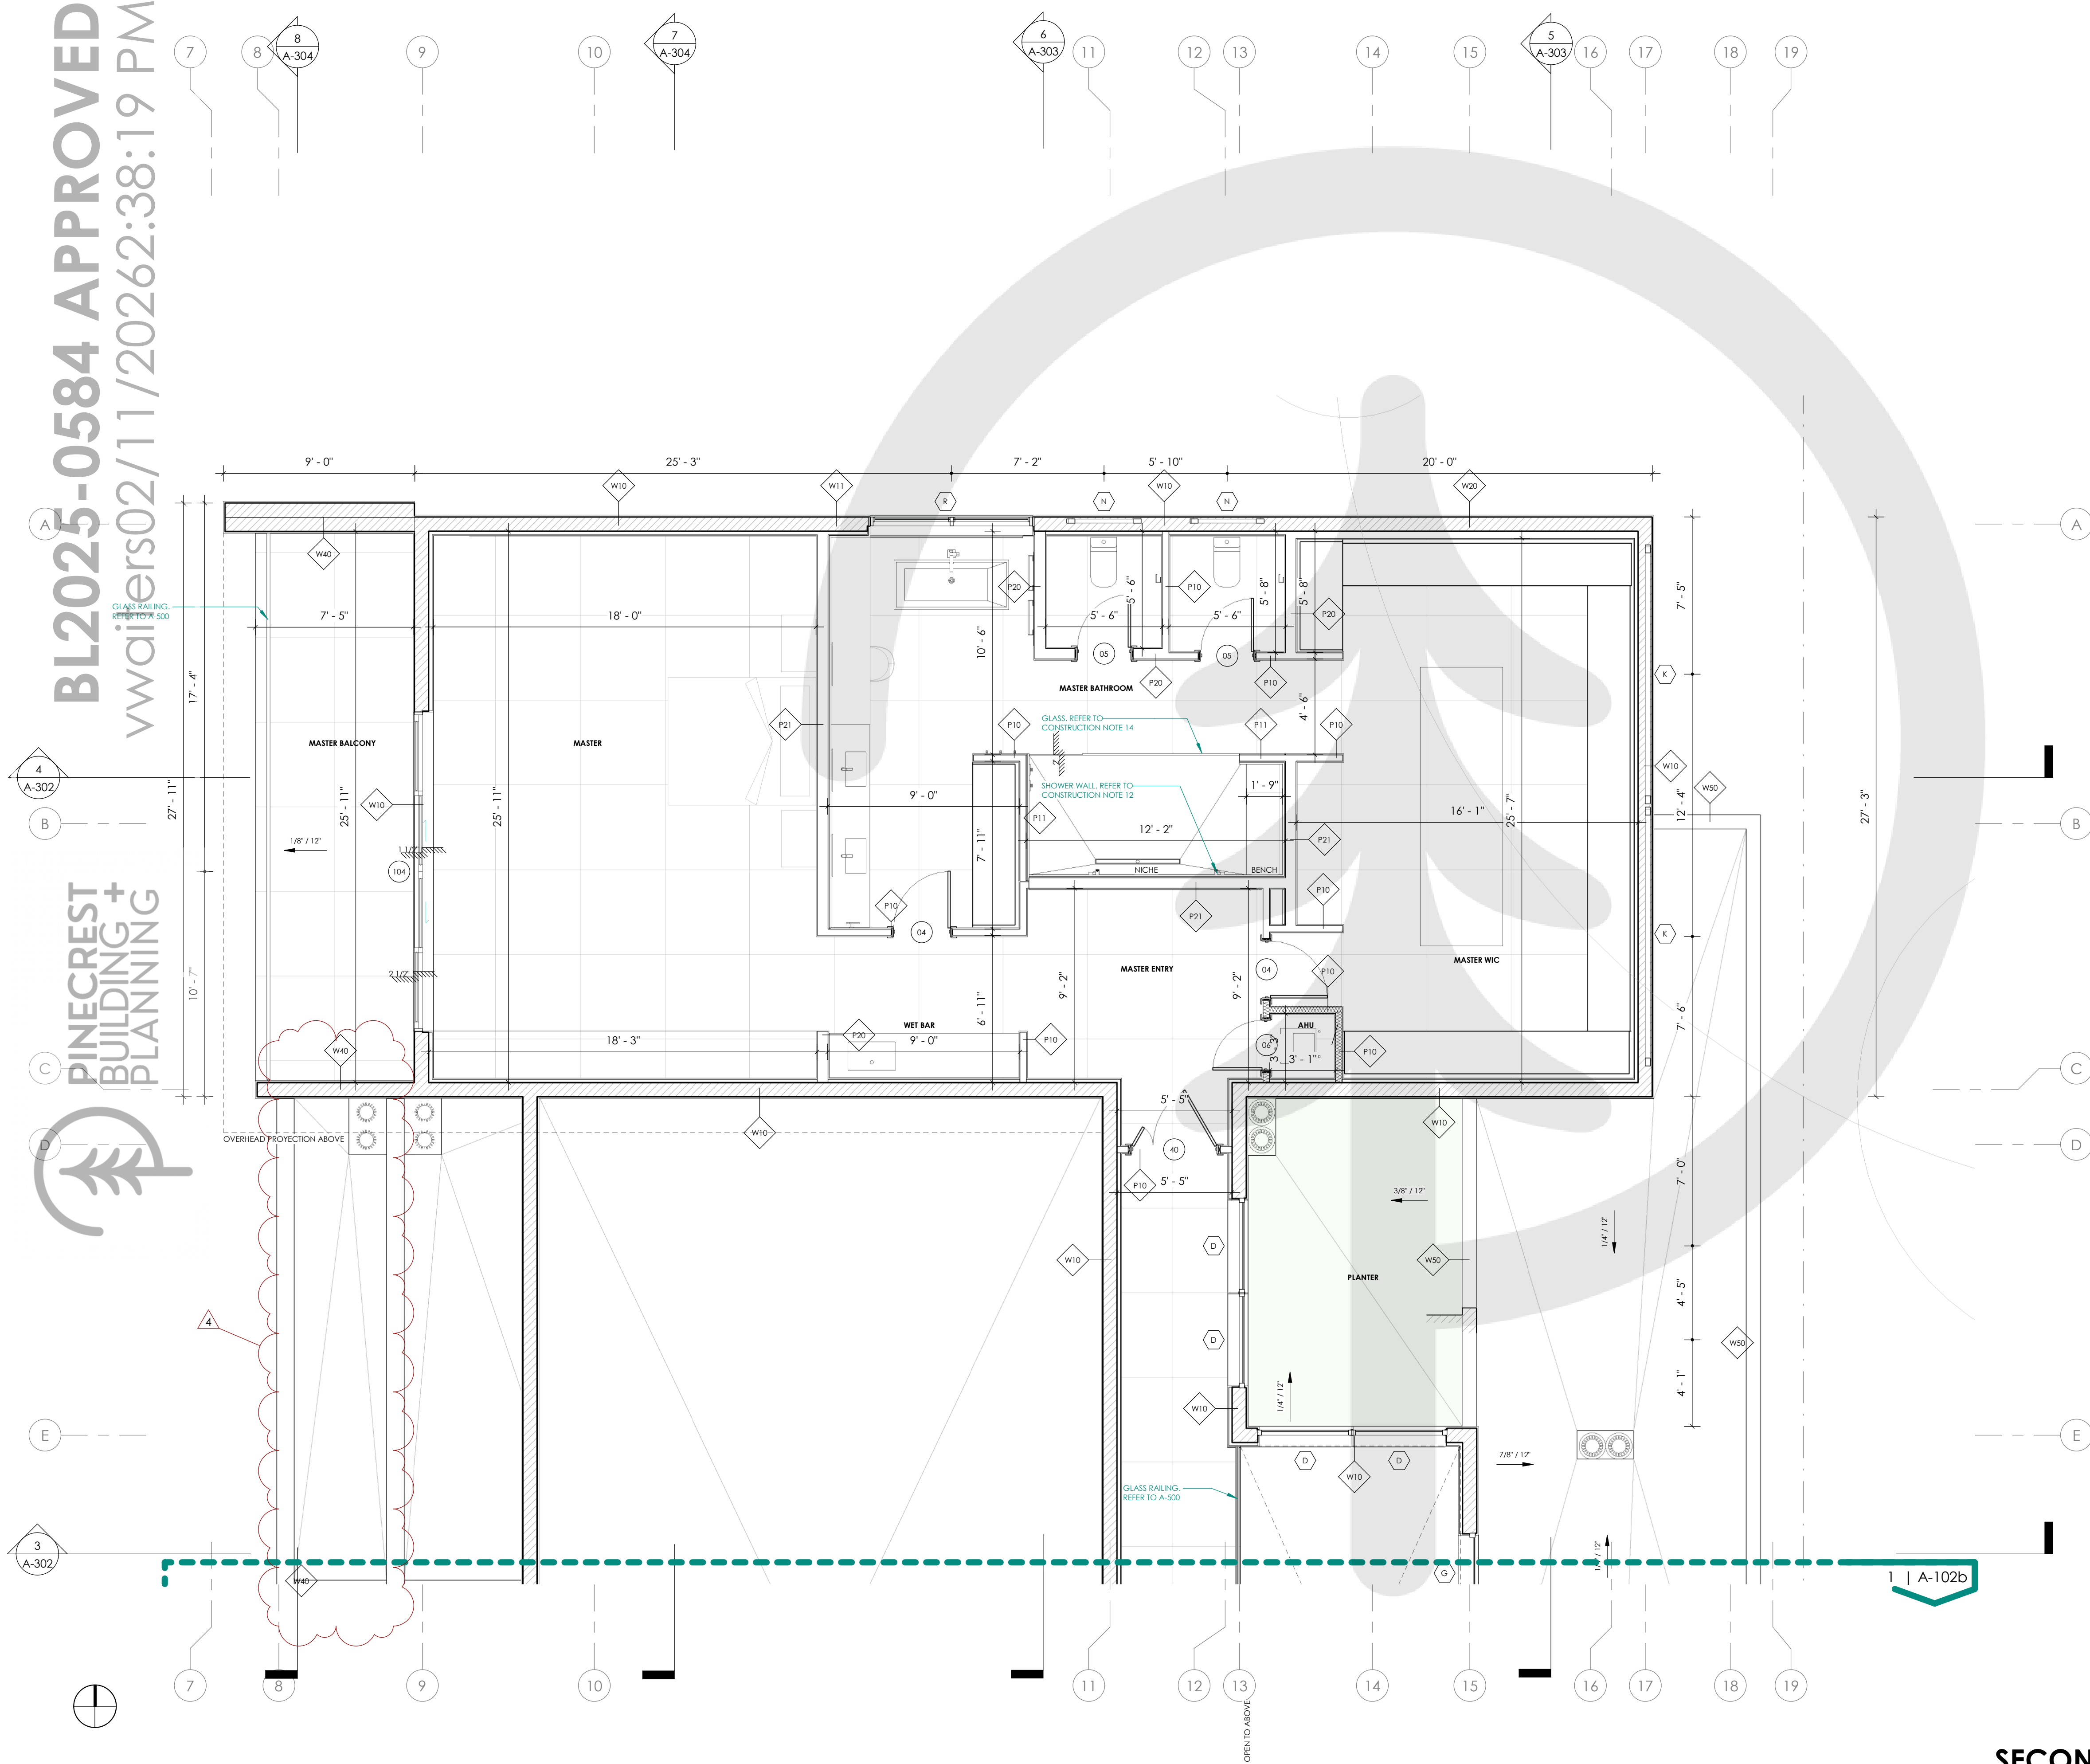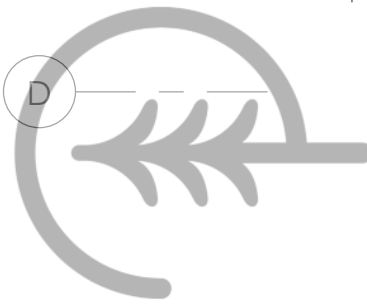


CONSTRUCTION NOTES

- ALL INTERIOR CONSTRUCTION SHALL COMPLY WITH ALL APPLICABLE CODES AND ORDINANCES IN PLACE IN THE LOCATION OF WORK. CORRIDORS AND ALL OTHER CLEARANCES SHOULD BE CHECKED WITH ARCHITECT PRIOR TO THE FABRICATION OF ANY WORK. CONTRACTOR SHALL BE RESPONSIBLE FOR CORRECTING SAME AT HIS OWN EXPENSE.
- ALL ROUGH CARPENTRY WOODWORK SHALL BE TREATED FOR FIRE RETARDATION WITH U.L. APPROVED MATERIAL. FLAME SPREAD RATING NOT TO EXCEED 25.
- CONTRACTOR SHALL FURNISH AND INSTALL NEW ACCESS DOORS WHEREVER REQUIRED FOR PLUMBING, ELECTRICAL, HVAC, SPRINKLER, ETC. SYSTEMS FOR WORK ACCESS AND MAINTENANCE.
- CONTRACTOR SHALL PLACE BACKING IN WALLS THAT SUPPORT UNITIES ACCORDING TO SPECS. AT BATHROOMS, KITCHENS OR WHERE IT IS OTHER NOTED, AND PROVIDE ALL SUCH BLOCKING PRIOR TO CLOSING UP ANY AND ALL WALLS, COLUMNS, ETC. TO MEET SUCH REQUIREMENTS. SEE CARPENTRY SHOP DRAWINGS FOR ALL FIXTURE INFORMATION.
- FILL AND SEAL ALL EXISTING CORE DRILLED HOLES LEFT UNUSED IN THE FLOOR SLAB AND CEILING SLAB.
- MATERIALS USED AS BACKERS FOR WALL TILE IN TUB AND SHOWER AREAS AND WALL PANELS IN SHOWER AREAS SHALL BE OF MATERIALS LISTED IN TABLE R702.4.2 AND INSTALLED IN ACCORDANCE WITH THE MANUFACTURER'S RECOMMENDATIONS. AS PER FBC R702.4.2
- PATCH AND REPAIR OR REPLACE ALL EXISTING AND NEW WORK DAMAGED BY CONSTRUCTION.
- LAMINATE AND OR PLASTER ALL EXPOSED CORE WALLS, PERIMETER COLUMNS, WALL & SLAB SURFACES WHICH ARE DAMAGE OR MISSING WITH ONE NEW LAYER OF GYPSUM BOARD SHIM IS REQUIRED, UNLESS OTHERWISE NOTED.
- GENERAL CONTRACTOR SHALL REPAIR ANY LOOSE OR MISSING FIREPROOFING ON STRUCTURAL ELEMENTS AND OTHER FIRE RATED ELEMENTS OF THE SPACE.
- NEW WALLS ARE DIMENSIONED TO THE FINISH FACE OF WALL THICKNESS UNLESS OTHERWISE NOTED. ALL GYPSUM BOARD TO BE 5/8" THICKNESS, UNLESS OTHERWISE NOTED. GREEN BOARD, TO BE USED IN TOILETS WHERE PAINT IS USED AND DUROCK IN TOILETS WHERE TILE IS USED.
- MIN SHOWER ACCESS SHALL BE 22" CLEAR.
- BATHTUB AND SHOWER FLOORS AND ABOVE BATH-TUBS WITH INSTALLED SHOWER HEADS AND IN SHOWER COMPARTMENTS SHALL BE FINISHED WITH A NONABSORBENT SURFACE. SUCH WALL SURFACES SHALL EXTEND TO A HEIGHT OF NOT LESS THAN 6 FEET (1829 MM) ABOVE THE FLOOR. AS PER FBC B 2406 AND/OR FBC R307.2.
- REQUIRED GUARDS SHALL NOT HAVE OPENINGS FROM THE WALKING SURFACE TO THE REQUIRED GUARD HEIGHT THAT ALLOW PASSAGE OF A SPHERE 4 INCHES (102 MM) IN DIAMETER. AS PER FBC R312.1.3.
- ANY GLAZING MATERIAL IN ANY WINDOW ADJACENT TO TUB AND SHOWER COMPARTMENTS, SHOWER ENCLOSURES AND GLAZING LARGER THAN 9 SQ. FT. SHALL BE CATEGORY II SAFETY GLASS. TO COMPLY WITH FBC B 2406.1 AND/OR FBC R308, MANUFACTURER SHALL STORE GLASS ON SITE READILY ACCESSIBLE FOR INSPECTION.
- ALL NEW FINISHES (WALL/CEILING/FLOOR/TRIM/DECOR), ARE TO COMPLY WITH FBCB CHAPTER 8, FOR FLAME SPREAD AND SMOKE DEVELOPMENT CLASSIFICATION.
- OPENINGS FROM A PRIVATE GARAGE DIRECTLY INTO A ROOM USED FOR SLEEPING PURPOSES SHALL NOT BE PERMITTED. OTHER OPENINGS BETWEEN THE GARAGE AND RESIDENCE SHALL BE EQUIPPED WITH SOLID WOOD DOORS NOT LESS THAN 1.38 INCHES (35MM) IN THICKNESS, SOLID OR HONEYCOMB-CORE STEEL DOORS NOT LESS THAN 1.38 INCHES THICK, OR 20-MINUTE FIRE-RATED DOORS.

WALL LEGEND

- TYPICAL NON LOAD BEARING 8" CMU WALL W/ VERTICAL REINFORCING. SEE TYPICAL WALL TYPES AND STRUCTURAL DRAWINGS FOR DETAILS.
- REINFORCED CONCRETE WALL. SEE TYPICAL WALL TYPES AND STRUCTURAL DRAWINGS FOR DETAILS.
- TYP 4" INTERIOR PARTITIONS. SEE TYPICAL WALL TYPES FOR DETAILS.
- TYP 6" INTERIOR PARTITIONS. SEE TYPICAL WALL TYPES FOR DETAILS.

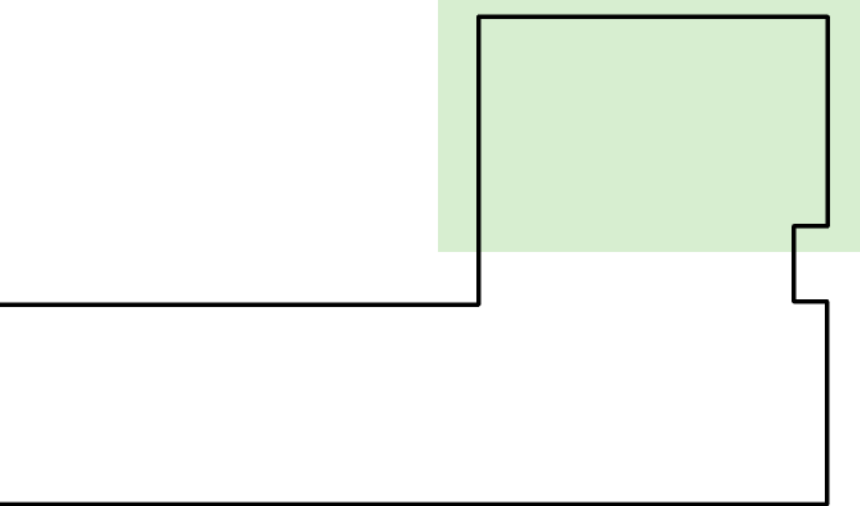

LOCATION DIAGRAM A

SECOND FLOOR PLAN
1/4" = 1'-0"




MIK ARCHITECTURE LLC
MATIAS DAWOCH
AR 100480
1385 CORAL WAY, SUITE 202
MIAMI, FLORIDA 33145
+1 786 588 0882
matias@mikarch.com

AGD DEVELOPERS LLC
1385 CORAL WAY, SUITE 202
MIAMI, FLORIDA 33145
agdmiami.com
develop@agdmiami.com

NEW CONSTRUCTION
AGD CALISTONE LLC
10840 SW 67 AVE MIAMI, FL 33156

ISSUES	MAY 2025	131 ISSUED
1	2025-12-05	Correction 4
JOB NO.	#084	
DRAWN BY	NS	
CHECKED BY	MD	
SCALE	AS NOTED	
FROM	AA 26003995	
DATE		

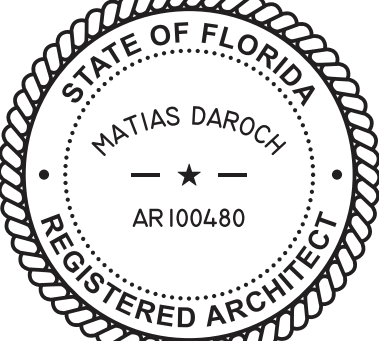

THIS IS A DIGITALLY SIGNED SET. THE CONTENTS OF THIS DOCUMENT ARE NOT CONSIDERED SIGNED AND SEALED AND THE SIGNATURE MUST BE VERIFIED ON THE ORIGINAL COPIES.

THE CONTENT OF THIS SHEET AND ALL OTHER DRAWINGS ISSUED BY THE SET ARE PROTECTED BY U.S. AND INTERNATIONAL COPYRIGHT LAWS. REPRODUCTION OR USE WITHOUT PROPER WRITTEN CONSENT IS PROHIBITED BY LAW. SEE ALSO FOR DETAILS.


THEY ARE:

A-102a

SECOND FLOOR PLAN



BL2025-0584 APPROVED
vwaiters02/11/20262:38:19 PM

PINECREST
BUILDING +
PLANNING

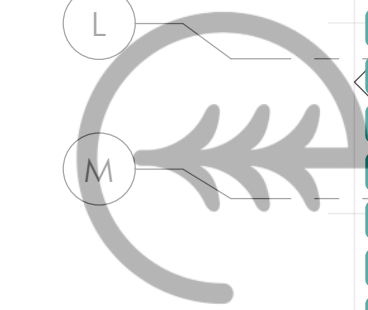

N
O

A-301

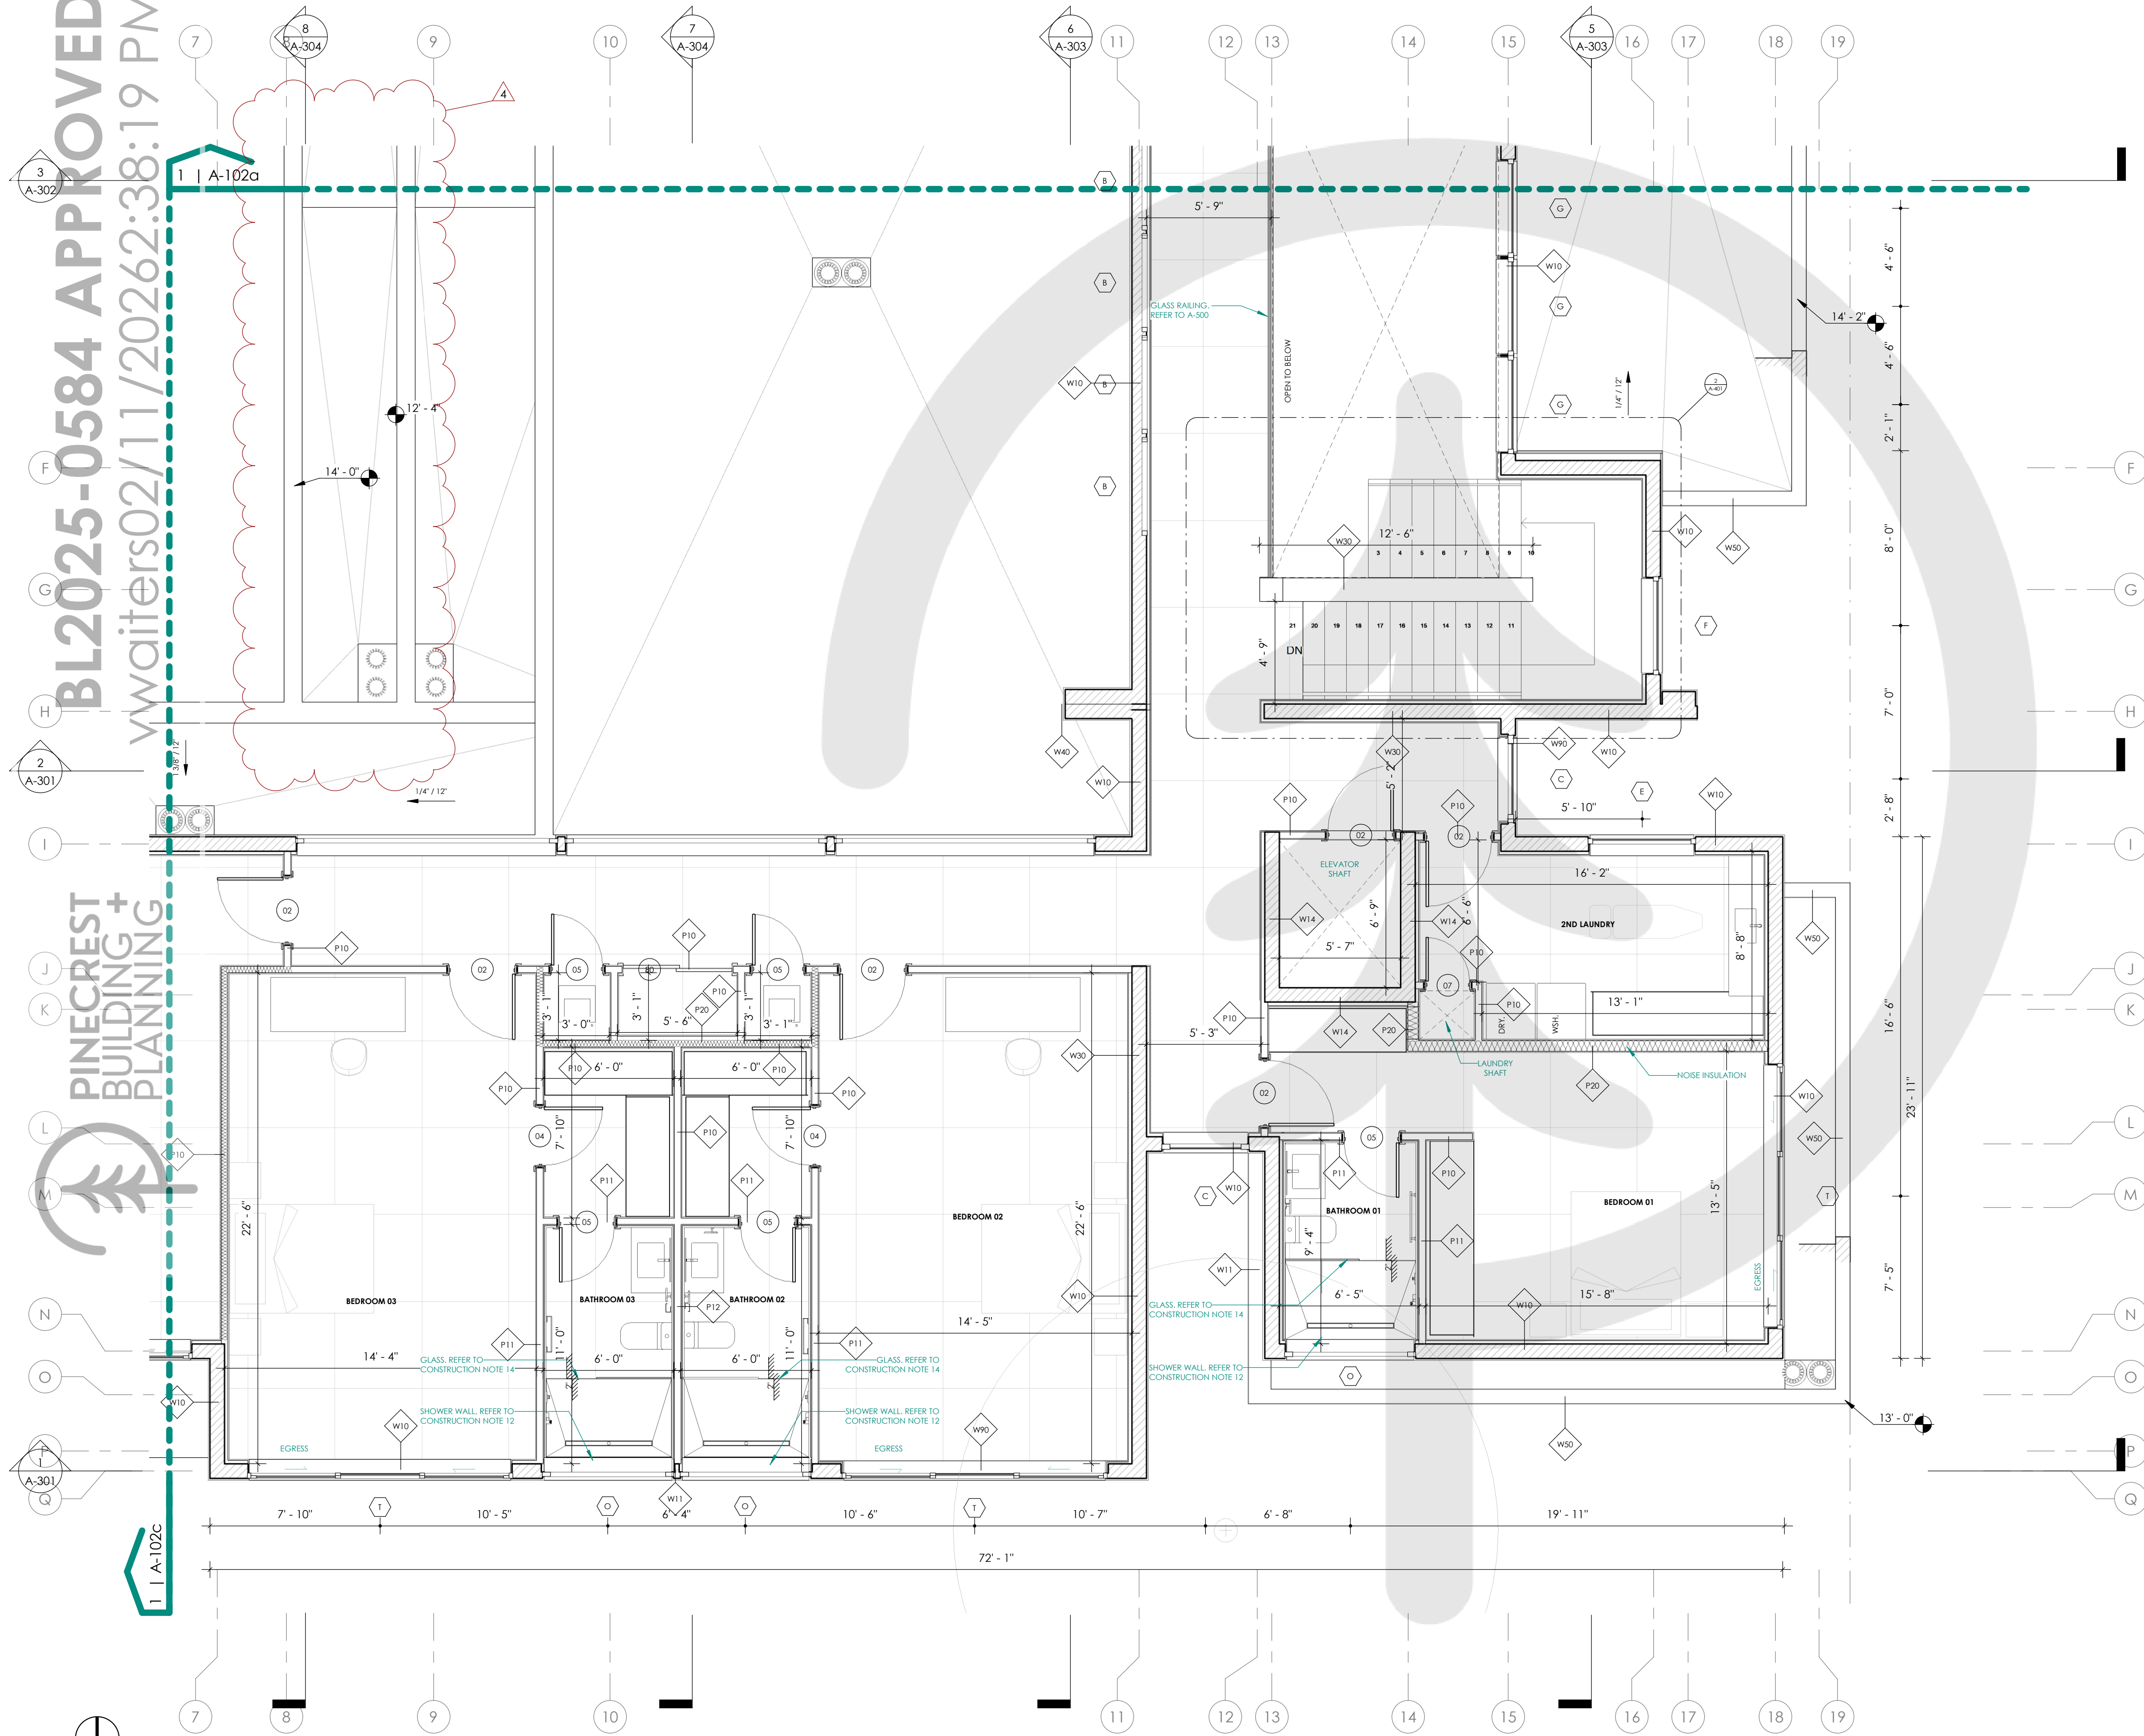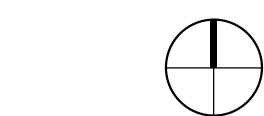


CONSTRUCTION NOTES

- ALL INTERIOR CONSTRUCTION SHALL COMPLY WITH ALL APPLICABLE CODES AND ORDINANCES IN PLACE IN THE LOCATION OF WORK. CORRIDORS AND ALL OTHER CLEARANCES SHOULD BE CHECKED WITH ARCHITECT PRIOR TO THE FABRICATION OF ANY WORK. CONTRACTOR SHALL BE RESPONSIBLE FOR CORRECTING SAME AT HIS OWN EXPENSE.
- ALL ROUGH CARPENTRY WOODWORK SHALL BE TREATED FOR FIRE RETARDATION WITH U.L. APPROVED MATERIAL. FLAME SPREAD RATING NOT TO EXCEED 25.
- CONTRACTOR SHALL FURNISH AND INSTALL NEW ACCESS DOORS WHEREVER REQUIRED FOR PLUMBING, ELECTRICAL, HVAC, SPRINKLER, ETC. SYSTEMS FOR WORK ACCESS AND MAINTENANCE.
- CONTRACTOR SHALL PLACE BACKING IN WALLS THAT SUPPORT UNITIES ACCORDING TO SPECS. AT BATHROOMS, KITCHENS OR WHERE IT IS OTHER NOTED, AND PROVIDE ALL SUCH BLOCKING PRIOR TO CLOSING UP ANY AND ALL WALLS, COLUMNS, ETC. TO MEET SUCH REQUIREMENTS. SEE CARPENTRY SHOP DRAWINGS FOR ALL FIXTURE INFORMATION.
- FILL AND SEAL ALL EXISTING CORE DRILLED HOLES LEFT UNUSED IN THE FLOOR SLAB AND CEILING SLAB.
- MATERIALS USED AS BACKERS FOR WALL TILE IN TUB AND SHOWER AREAS AND WALL PANELS IN SHOWER AREAS SHALL BE OF MATERIALS LISTED IN TABLE R702.4.2 AND INSTALLED IN ACCORDANCE WITH THE MANUFACTURER'S RECOMMENDATIONS. AS PER FBC R702.4.2
- PATCH AND REPAIR OR REPLACE ALL EXISTING AND NEW WORK DAMAGED BY CONSTRUCTION.
- LAMINATE AND OR PLASTER ALL EXPOSED CORE WALLS, PERIMETER COLUMNS, WALL & SLAB SURFACES WHICH ARE DAMAGE OR MISSING WITH ONE NEW LAYER OF GYPSUM BOARD SHIM IS REQUIRED, UNLESS OTHERWISE NOTED.
- GENERAL CONTRACTOR SHALL REPAIR ANY LOOSE OR MISSING FIREPROOFING ON STRUCTURAL ELEMENTS AND OTHER FIRE RATED ELEMENTS OF THE SPACE.
- NEW WALLS ARE DIMENSIONED TO THE FINISH FACE OF WALL THICKNESS UNLESS OTHERWISE NOTED. ALL GYPSUM BOARD TO BE 5/8" THICKNESS, UNLESS OTHERWISE NOTED. GREEN BOARD, TO BE USED IN TOILETS WHERE PAINT IS USED AND DUROCK IN TOILETS WHERE TILE IS USED.
- MIN SHOWER ACCESS SHALL BE 22" CLEAR.
- BATHTUB AND SHOWER FLOORS AND ABOVE BATHTUBS WITH INSTALLED SHOWER HEADS AND IN SHOWER COMPARTMENTS SHALL BE FINISHED WITH A NONABSORBENT SURFACE. SUCH WALL SURFACES SHALL EXTEND TO A HEIGHT OF NOT LESS THAN 6 FEET (1829 MM) ABOVE THE FLOOR. AS PER FBC B 2406 AND/OR FBC R307.2.
- REQUIRED GUARDS SHALL NOT HAVE OPENINGS FROM THE WALKING SURFACE TO THE REQUIRED GUARD HEIGHT THAT ALLOW PASSAGE OF A SPHERE 4 INCHES (102 MM) IN DIAMETER. AS PER FBC R312.1.3.
- ANY GLAZING MATERIAL IN ANY WINDOW ADJACENT TO TUB AND SHOWER COMPARTMENTS, SHOWER ENCLOSURES AND GLAZING LARGER THAN 9 SQ. FT. SHALL BE CATEGORY II SAFETY GLASS. TO COMPLY WITH FBC B 2406.1 AND/OR FBC R308, MANUFACTURER SHALL STORE GLASS ON SITE READILY ACCESSIBLE FOR INSPECTION.
- ALL NEW FINISHES (WALL/CEILING/FLOOR/TRIM/DECOR), ARE TO COMPLY WITH FBCB CHAPTER 8, FOR FLAME SPREAD AND SMOKE DEVELOPMENT CLASSIFICATION.
- OPENINGS FROM A PRIVATE GARAGE DIRECTLY INTO A ROOM USED FOR SLEEPING PURPOSES SHALL NOT BE PERMITTED. OTHER OPENINGS BETWEEN THE GARAGE AND RESIDENCE SHALL BE EQUIPPED WITH SOLID WOOD DOORS NOT LESS THAN 1.38 INCHES (35MM) IN THICKNESS, SOLID OR HONEYCOMB-CORE STEEL DOORS NOT LESS THAN 1.38 INCHES THICK, OR 20-MINUTE FIRE-RATED DOORS.

WALL LEGEND



TYPICAL NON-LOAD BEARING 8' CMU WALL W/ VERTICAL REINFORCING. SEE TYPICAL WALL TYPES AND STRUCTURAL DRAWINGS FOR DETAILS.
REINFORCED CONCRETE WALL. SEE TYPICAL WALL TYPES AND STRUCTURAL DRAWINGS FOR DETAILS.
TYP. 4' INTERIOR PARTITIONS. SEE TYPICAL WALL TYPES FOR DETAILS.
TYP. 6' INTERIOR PARTITIONS. SEE TYPICAL WALL TYPES FOR DETAILS.

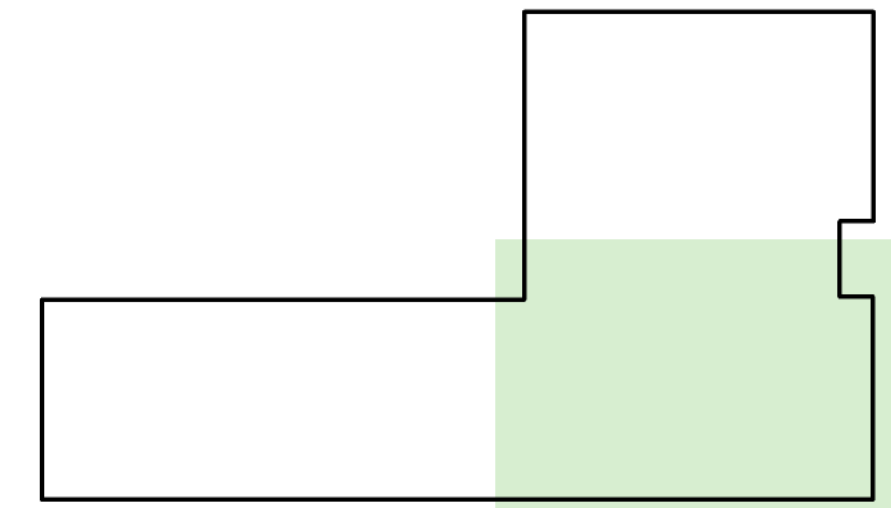

LOCATION DIAGRAM B

SECOND FLOOR PLAN 1

1/4" = 1'-0"



MIK ARCHITECTURE LLC
MATIAS DAROCH
AR 100480
1385 CORAL WAY, SUITE 202
MIAMI, FLORIDA 33146
+1 786 758 5882
matias@mikarch.com




AGD DEVELOPERS LLC
1385 CORAL WAY, SUITE 202
MIAMI, FLORIDA 33146
agdev.com
dev@agdev.com

NEW CONSTRUCTION
AGD CALISTONE LLC
10840 SW 67 AVE MIAMI, FL 33156

ISSUES MAY 2025 1ST ISSUED
A 2025-12-05 Correction 4

JOB NO. #084
DRAWN BY NS
CHECKED BY MD
SCALE AS NOTED
FROM AA 26003995
SEP

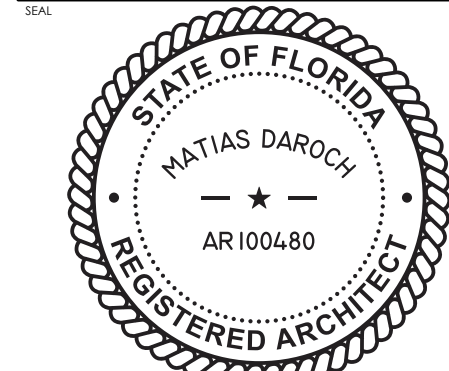

THIS IS A DIGITALLY SIGNED SHEET. THE CONTENTS OF THIS DOCUMENT ARE NOT CONSIDERED SIGNED AND SEALED UNTIL THE SIGNATURE HAS BEEN VERIFIED ON THE SIGNING CODES.

THE CONTENT OF THIS SHEET AND ALL OTHER DRAWINGS ISSUED BY THE SET ARE PROTECTED BY U.S. AND INTERNATIONAL COPYRIGHT LAWS. REPRODUCTION OR USE WITHOUT PROPER WRITTEN CONSENT IS PROHIBITED BY LAW. SEE ALSO FOR DETAILS.

SHEET NO.

A-102b

SECOND FLOOR PLAN

CONSTRUCTION NOTES

- ALL INTERIOR CONSTRUCTION SHALL COMPLY WITH ALL APPLICABLE CODES AND ORDINANCES IN PLACE IN THE LOCATION OF WORK. CORRIDORS AND ALL OTHER CLEARANCES SHOULD BE CHECKED WITH ARCHITECT PRIOR TO THE FABRICATION OF ANY WORK. CONTRACTOR SHALL BE RESPONSIBLE FOR CORRECTING SAME AT HIS OWN EXPENSE.
- ALL ROUGH CARPENTRY WOODWORK SHALL BE TREATED FOR FIRE RETARDATION WITH U.L. APPROVED MATERIAL. FLAME SPREAD RATING NOT TO EXCEED 25.
- CONTRACTOR SHALL FURNISH AND INSTALL NEW ACCESS DOORS WHEREVER REQUIRED FOR PLUMBING, ELECTRICAL, HVAC, SPRINKLER, ETC. SYSTEMS FOR WORK ACCESS AND MAINTENANCE.
- CONTRACTOR SHALL PLACE BACKING IN WALLS THAT SUPPORT UNITIES ACCORDING TO SPECS. AT BATHROOMS, KITCHENS OR WHERE IT IS OTHER NOTED, AND PROVIDE ALL SUCH BLOCKING PRIOR TO CLOSING UP ANY AND ALL WALLS, COLUMNS, ETC. TO MEET SUCH REQUIREMENTS. SEE CARPENTRY SHOP DRAWINGS FOR ALL FIXTURE INFORMATION.
- FILL AND SEAL ALL EXISTING CORE DRILLED HOLES LEFT UNUSED IN THE FLOOR SLAB AND CEILING SLAB.

CONSTRUCTION NOTES

- MATERIALS USED AS BACKERS FOR WALL TILE IN TUB AND SHOWER AREAS AND WALL PANELS IN SHOWER AREAS SHALL BE OF MATERIALS LISTED IN TABLE R702.4.2 AND INSTALLED IN ACCORDANCE WITH THE MANUFACTURER'S RECOMMENDATIONS. AS PER FBC R702.4.2
- PATCH AND REPAIR OR REPLACE ALL EXISTING AND NEW WORK DAMAGED BY CONSTRUCTION.
- LAMINATE AND OR PLASTER ALL EXPOSED CORE WALLS, PERIMETER COLUMNS, WALL & SLAB SURFACES WHICH ARE DAMAGE OR MISSING WITH ONE NEW LAYER OF GYPSUM BOARD SHIM IS REQUIRED, UNLESS OTHERWISE NOTED.
- GENERAL CONTRACTOR SHALL REPAIR ANY LOOSE OR MISSING FIREPROOFING ON STRUCTURAL ELEMENTS AND OTHER FIRE RATED ELEMENTS OF THE SPACE.
- NEW WALLS ARE DIMENSIONED TO THE FINISH FACE OF WALL THICKNESS UNLESS OTHERWISE NOTED. ALL GYPSUM BOARD TO BE 5/8" THICKNESS. UNLESS OTHERWISE NOTED, GREEN BOARD, TO BE USED IN TOILETS WHERE PAINT IS USED AND DUROCK IN TOILETS WHERE TILE IS USED.

CONSTRUCTION NOTES

- MIN SHOWER ACCESS SHALL BE 22" CLEAR.
- BATHTUB AND SHOWER FLOORS AND ABOVE BATHTUBS WITH INSTALLED SHOWER HEADS AND IN SHOWER COMPARTMENTS SHALL BE FINISHED WITH A NONABSORBENT SURFACE. SUCH WALL SURFACES SHALL EXTEND TO A HEIGHT OF NOT LESS THAN 6 FEET (1829 MM) ABOVE THE FLOOR. AS PER FBC B 2406 AND/OR FBC R307.2.
- REQUIRED GUARDS SHALL NOT HAVE OPENINGS FROM THE WALKING SURFACE TO THE REQUIRED GUARD HEIGHT THAT ALLOW PASSAGE OF A SPHERE 4 INCHES (102 MM) IN DIAMETER. AS PER FBC R312.1.3.
- ANY GLAZING MATERIAL IN ANY WINDOW ADJACENT TO TUB AND SHOWER COMPARTMENTS, SHOWER ENCLOSURES AND GLAZING LARGER THAN 9 SQ. FT. SHALL BE CATEGORY II SAFETY GLASS. TO COMPLY WITH FBC B 2406.1 AND/OR FBC R308. MANUFACTURER SHALL STORE GLASS ON SITE READILY ACCESSIBLE FOR INSPECTION.
- ALL NEW FINISHES (WALL/CEILING/FLOOR/TRIM/DECOR), ARE TO COMPLY WITH FBCB CHAPTER 8, FOR FLAME SPREAD AND SMOKE DEVELOPMENT CLASSIFICATION.

CONSTRUCTION NOTES

- OPENINGS FROM A PRIVATE GARAGE DIRECTLY INTO A ROOM USED FOR SLEEPING PURPOSES SHALL NOT BE PERMITTED. OTHER OPENINGS BETWEEN THE GARAGE AND RESIDENCE SHALL BE EQUIPPED WITH SOLID WOOD DOORS NOT LESS THAN 1.38 INCHES (35MM) IN THICKNESS, SOLID OR HONEYCOMB-CORE STEEL DOORS NOT LESS THAN 1.38 INCHES THICK, OR 20-MINUTE FIRE-RATED DOORS.

WALL LEGEND




TYPICAL NON-LOAD BEARING 8" CMU WALL W/ VERTICAL REINFORCING. SEE TYPICAL WALL TYPES AND STRUCTURAL DRAWINGS FOR DETAILS.


REINFORCED CONCRETE WALL. SEE TYPICAL WALL TYPES AND STRUCTURAL DRAWINGS FOR DETAILS.

TYP 4" INTERIOR PARTITIONS. SEE TYPICAL WALL TYPES FOR DETAILS.

TYP 6" INTERIOR PARTITIONS. SEE TYPICAL WALL TYPES FOR DETAILS.

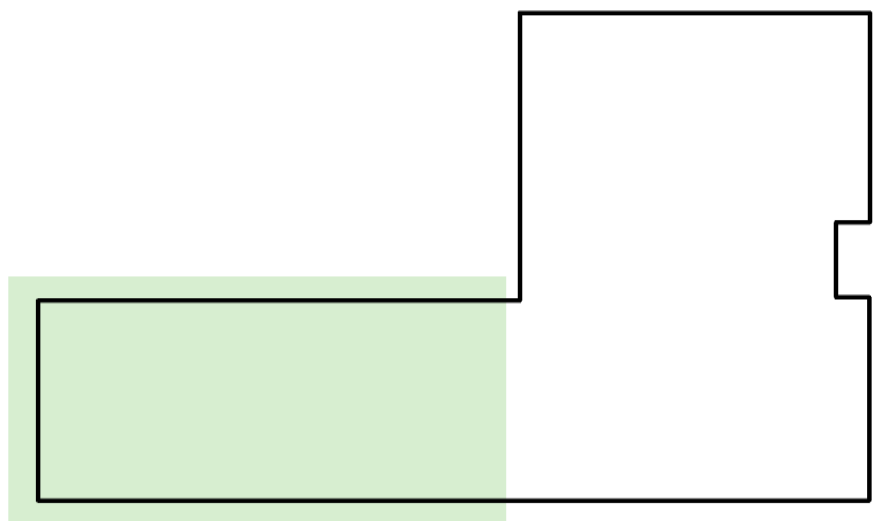

LOCATION DIAGRAM C

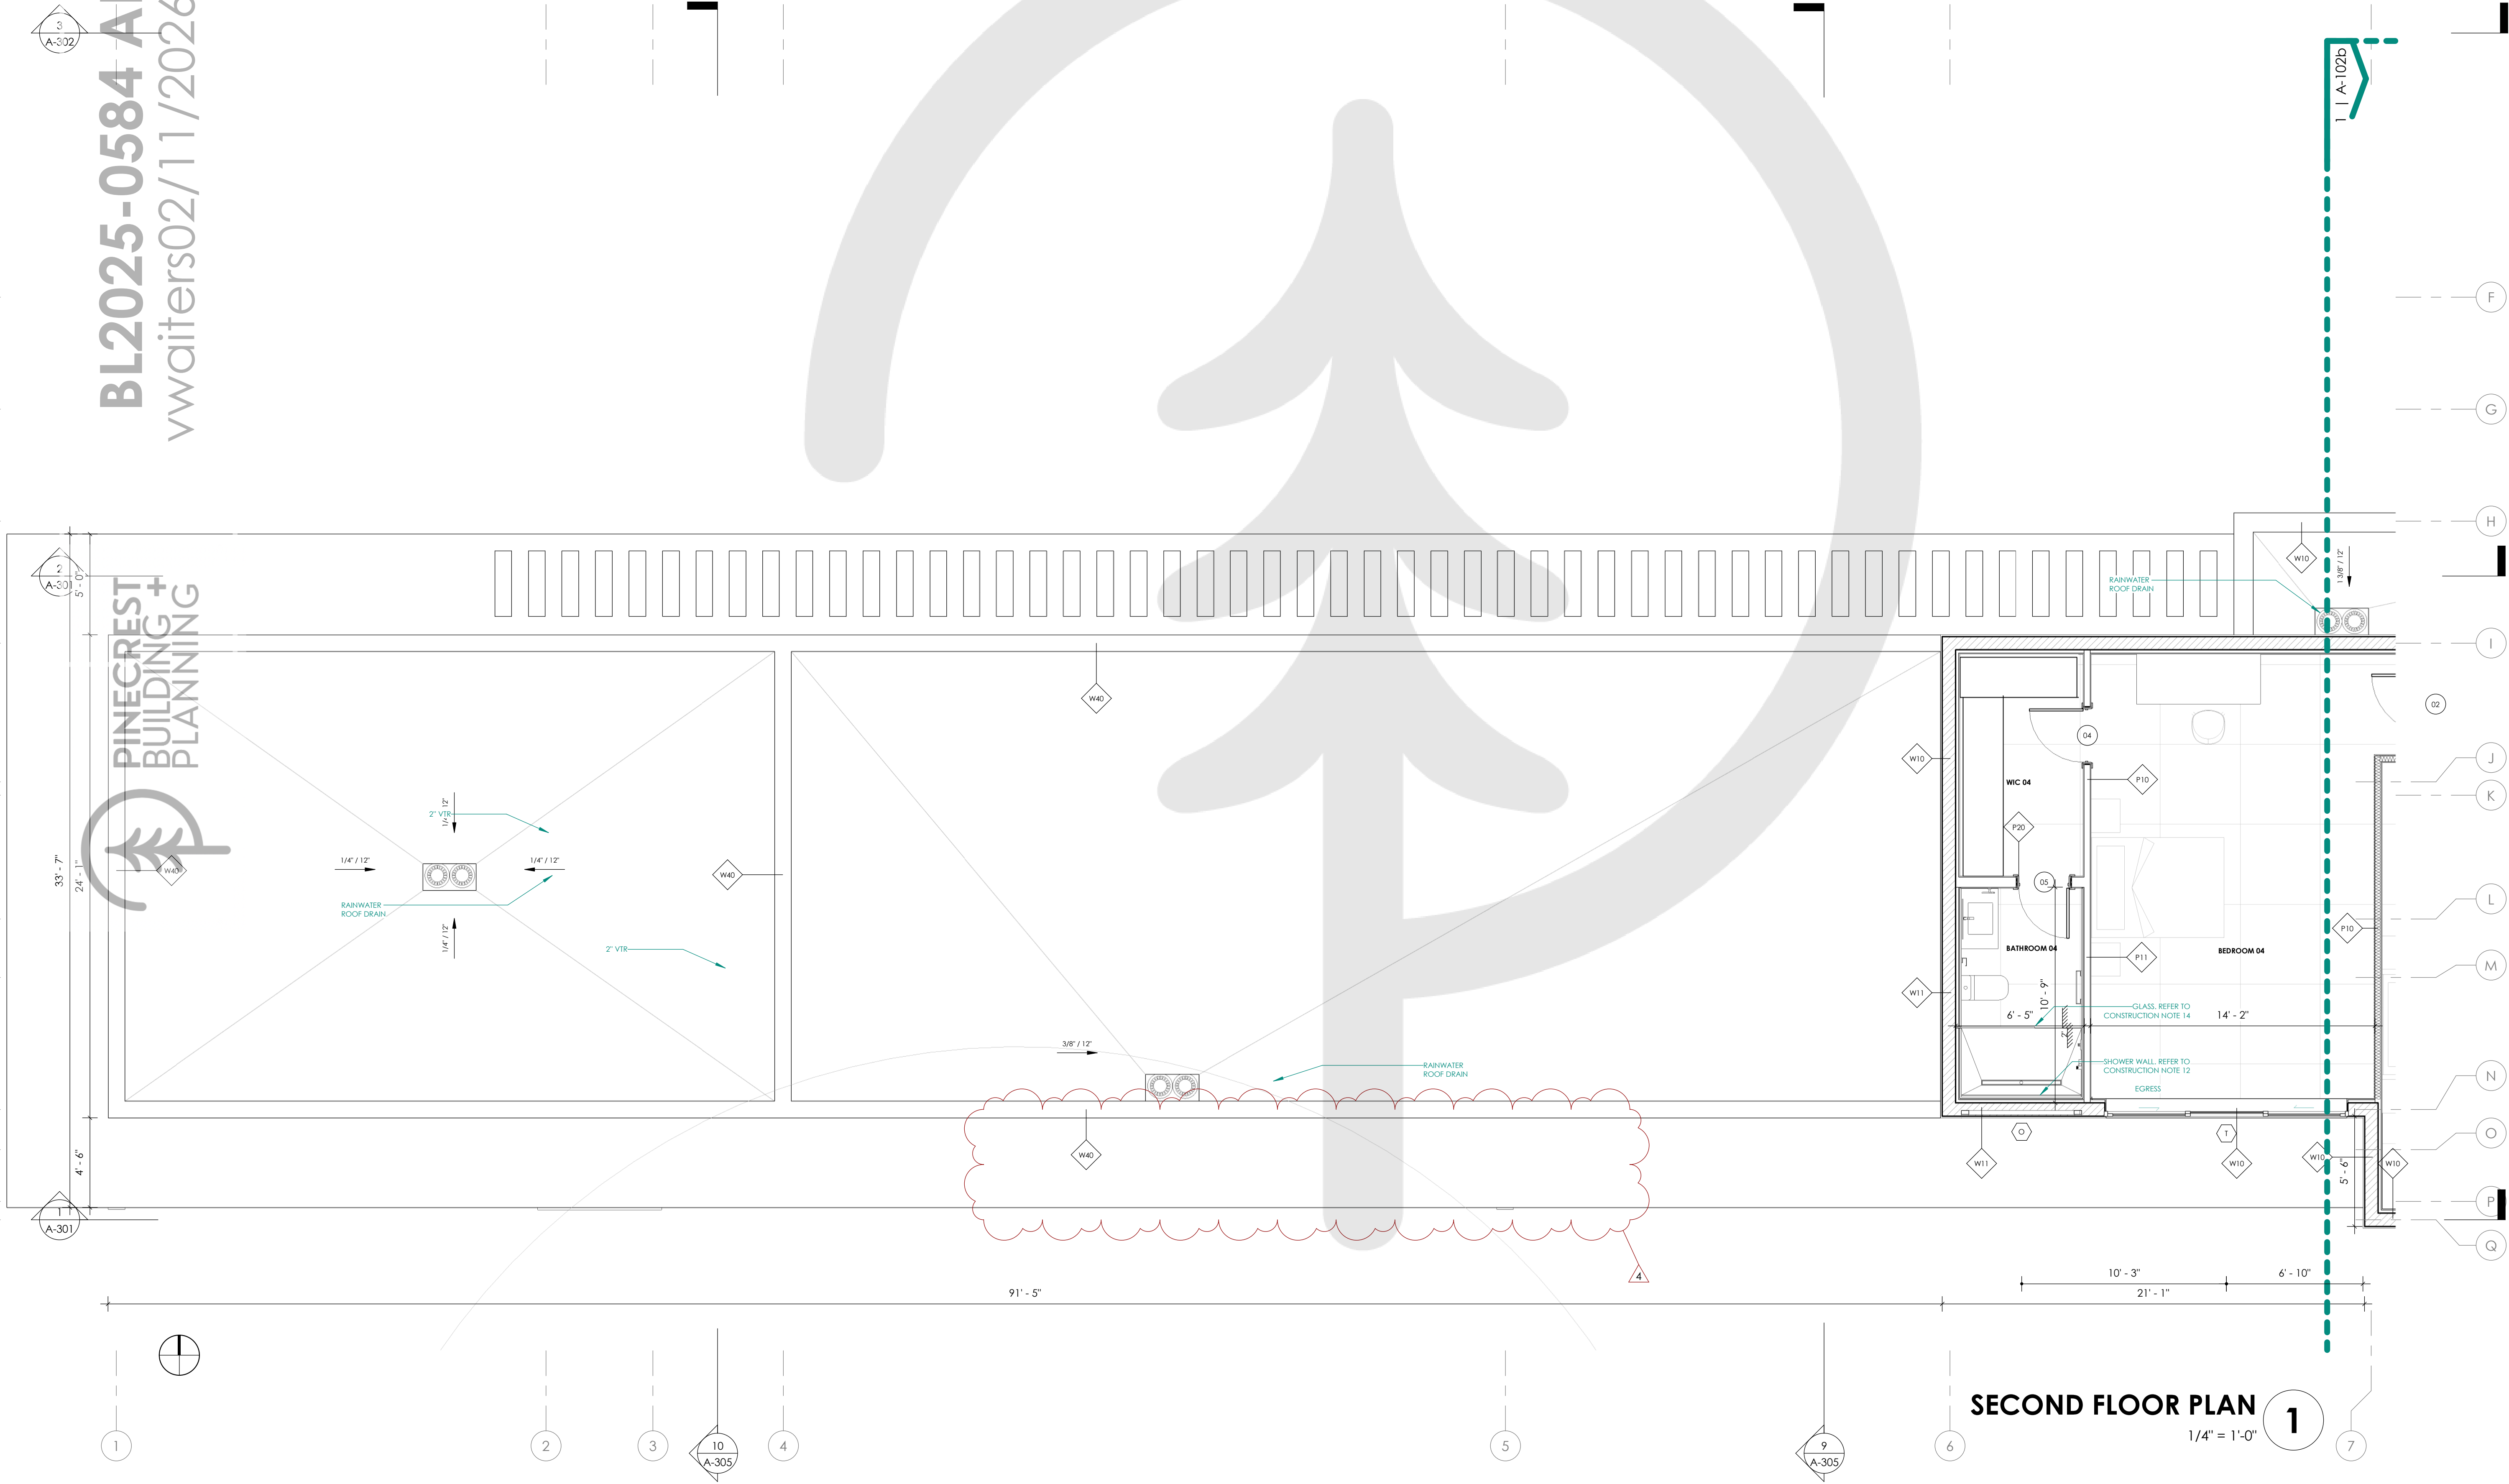

SECOND FLOOR PLAN

1/4" = 1'-0"

1



MIK ARCHITECTURE LLC

MATIAS DAROCH
AR 100480
1383 CORAL WAY, SUITE 202
MIAMI, FLORIDA 33145
+1 786 758 5882
matias@mikarch.com




AGD DEVELOPERS LLC

1383 CORAL WAY, SUITE 202
MIAMI, FLORIDA 33145
agdmiami.com
developers@agdmiami.com

NEW CONSTRUCTION
AGD CALISTONE LLC
10840 SW 67 AVE MIAMI, FL 33156

ISSUES MAY 2025 131 ISSUED
2025-12-05 Correction 4

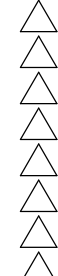

JOB NO.

#084

DRAWN BY

NS

CHECKED BY

MD


SCALE

AS NOTED

FROM

AA 26003995

SEP

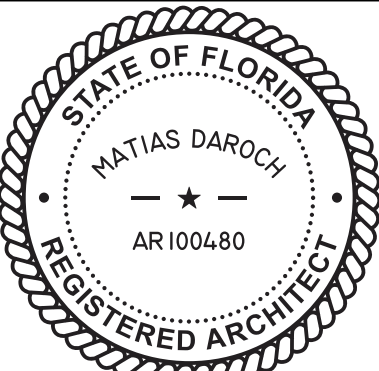

THIS IS A DIGITALLY SIGNED SET. THE CONTENTS OF THIS DOCUMENT ARE NOT CONSIDERED SIGNED AND SEALED UNTIL THE SIGNATURE HAS BEEN VERIFIED ON ANY SIGNED COPY.


THE CONTENT OF THIS SHEET AND ALL OTHER DRAWINGS ISSUED BY THE SET ARE PROTECTED BY U.S. AND INTERNATIONAL COPYRIGHT LAWS. REPRODUCTION OR USE WITHOUT PROPER WRITTEN CONSENT IS PROHIBITED BY LAW. SEE ALSO FOR DETAILS.

A-102c

SECOND FLOOR PLAN

BL2025-0584 APPROVED
vwaiters02/11/20262:38:20 PM

PINECREST
BUILDING +
PLANNING

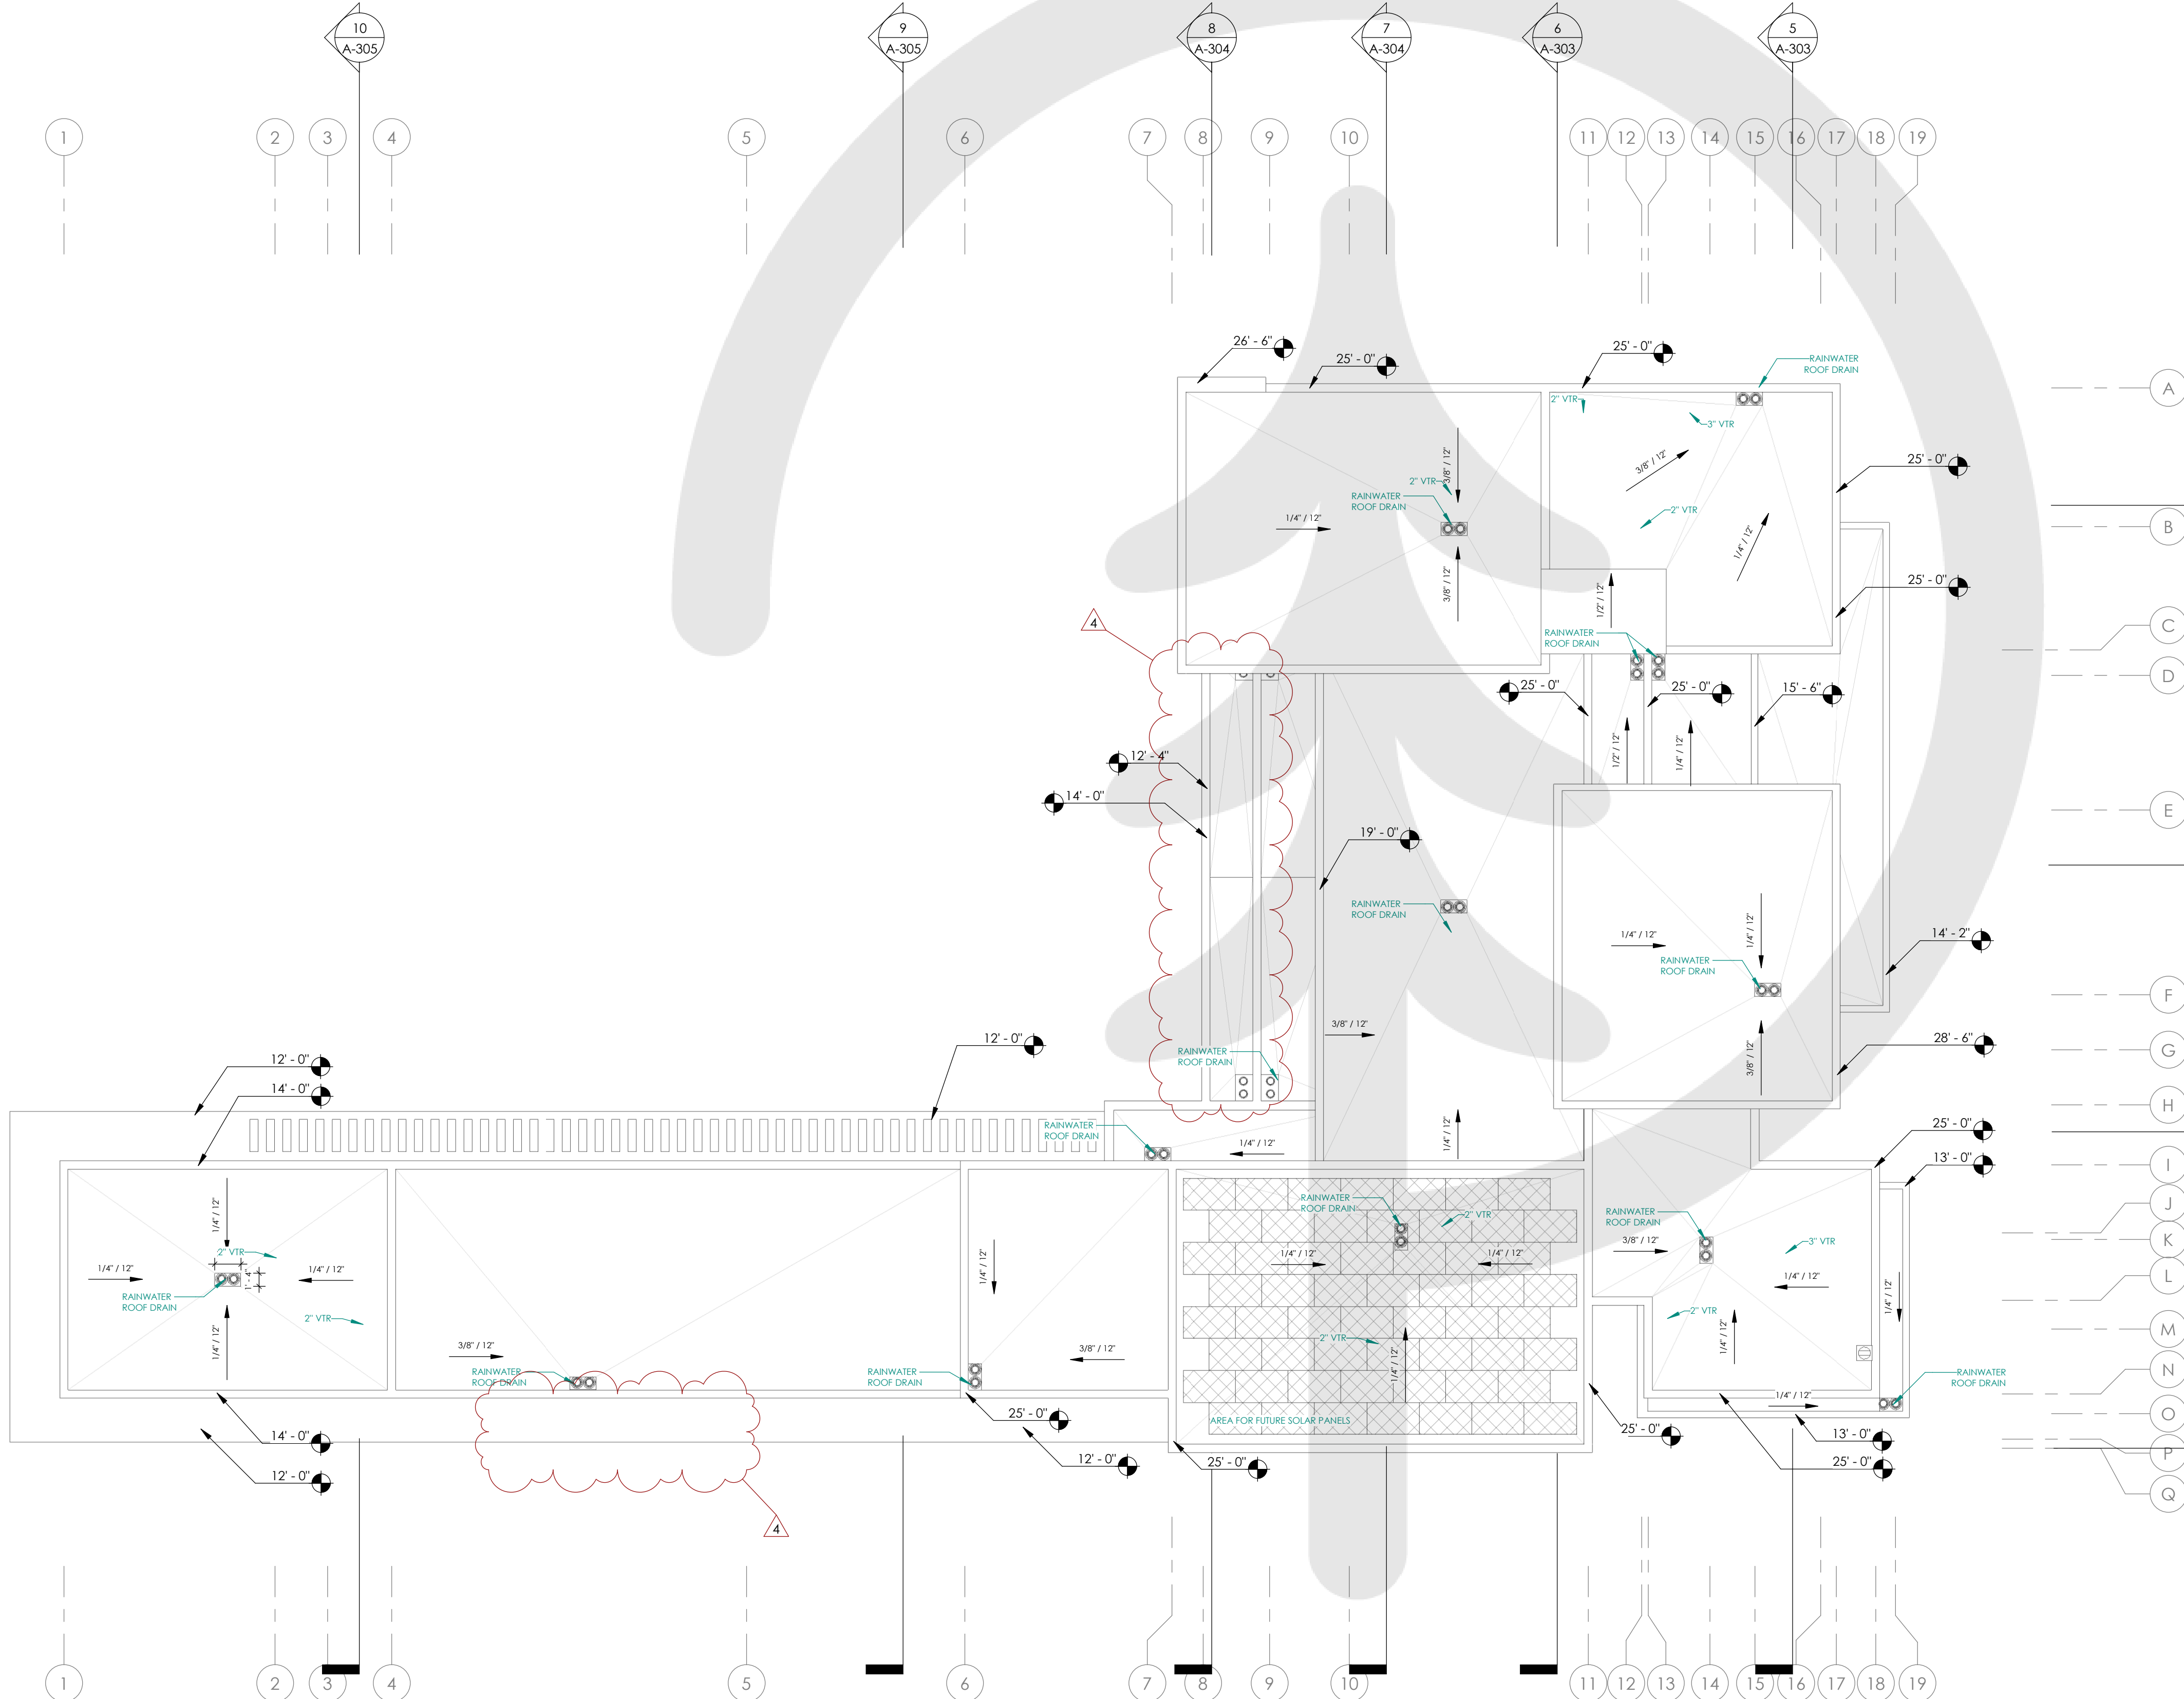


ROOF PLAN

1" = 10'-0"


1

ROOF NOTES

1. ROOF SYSTEM IS DESIGNED TO PREVENT THE ACCUMULATION OF NO MORE THAN FIVE (5) INCHES OF WATER ON ANY PORTION OF THE ROOF. UNLESS ROOFS ARE SLOPED TO DRAIN OVER ROOF EDGES, DESIGN AND INSTALLATION OF ROOF DRAINAGE SYSTEMS SHALL COMPLY WITH SECTION 1503 AND THE FLORIDA BUILDING CODE, PLUMBING, CHAPTER 11.
2. WHERE ROOF DRAINS ARE REQUIRED, SECONDARY (EMERGENCY OVERFLOW) ROOF DRAINS OR SCUPPERS SHALL BE PROVIDED WHERE THE ROOF PERIMETER CONSTRUCTION EXTENDS ABOVE THE ROOF IN SUCH A MANNER THAT WATER WILL BE ENTRAPPED IF THE PRIMARY DRAINS ALLOW BUILDUP FOR ANY REASON. WHERE PRIMARY AND SECONDARY ROOF DRAINS ARE MANUFACTURED AS A SINGLE ASSEMBLY, THE INLET AND OUTLET FOR EACH DRAIN SHALL BE INDEPENDENT.
3. SECONDARY ROOF DRAIN SYSTEMS SHALL HAVE THE END POINT OF DISCHARGE SEPARATE FROM THE PRIMARY SYSTEM. DISCHARGE SHALL BE ABOVE GRADE, IN A LOCATION THAT WOULD NORMALLY BE OBSERVED BY THE BUILDING OCCUPANTS OR MAINTENANCE PERSONNEL.
4. SECONDARY (EMERGENCY) ROOF DRAIN SYSTEMS SHALL BE SIZED IN ACCORDANCE WITH SECTION 1104 BASED ON THE RAINFALL RATE FOR WHICH THE PRIMARY SYSTEM IS SIZED. SCUPPERS SHALL BE SIZED TO PREVENT THE DEPTH OF PONDING WATER FROM EXCEEDING THAT FOR WHICH THE ROOF WAS DESIGNED AS DETERMINED BY SECTION 1101.7. SCUPPERS SHALL HAVE AN OPENING DIMENSION OF NOT LESS THAN 4 INCHES (102 MM). THE FLOW THROUGH THE PRIMARY SYSTEM SHALL NOT BE CONSIDERED WHEN SIZING THE SECONDARY ROOF DRAIN SYSTEM, AS PER FBC, P 1108.
5. OVERFLOW DRAINS AND SCUPPERS, WHERE ROOF DRAINS ARE REQUIRED, OVERFLOW DRAINS OR OVERFLOW SCUPPERS SIZED IN ACCORDANCE WITH FLORIDA BUILDING CODE, PLUMBING SHALL BE INSTALLED WITH THE INLET FLOW LINE (LOCATED NOT LESS THAN 2 INCHES (51 MM) OR MORE THAN 4 INCHES (102 MM) ABOVE THE LOW POINT OF THE FINISHED 2 INCHES (51 MM) OR MORE THAN 4 INCHES (102 MM) ABOVE THE LOW POINT OF THE FINISHED ROOFING SURFACE, EXCLUDING SUMPS. OVERFLOW SCUPPERS SHALL BE A MINIMUM OF 4 INCHES (102 MM) IN ANY DIMENSION AND SHALL BE LOCATED AS CLOSE AS PRACTICAL TO REQUIRED VERTICAL LEADERS, CONDUCTORS OR DOWNSPOUTS. OVERFLOW DRAINS AND SCUPPERS SHALL ALSO COMPLY WITH THE FLORIDA BUILDING CODE, PLUMBING AND SECTION 1617 OF THIS CODE.
6. INSTALL BUILT-UP ROOFING MEMBRANE SYSTEM ACCORDING TO ROOFING SYSTEM MANUFACTURE'S WRITTEN INSTRUCTIONS AND APPLICABLE RECOMMENDATIONS OF NRCA "QUALITY CONTROL GUIDELINES FOR THE APPLICATION OF BUILT-UP ROOFING".
7. ROOF DRAINAGE DEVICES WITH OVERFLOW TO HAVE LEAF AND DEBRIS SCREENS. ROOF DRAINAGE TO BE CONVEYED TO STREET VIA NON-EROSIVE DEVICES.

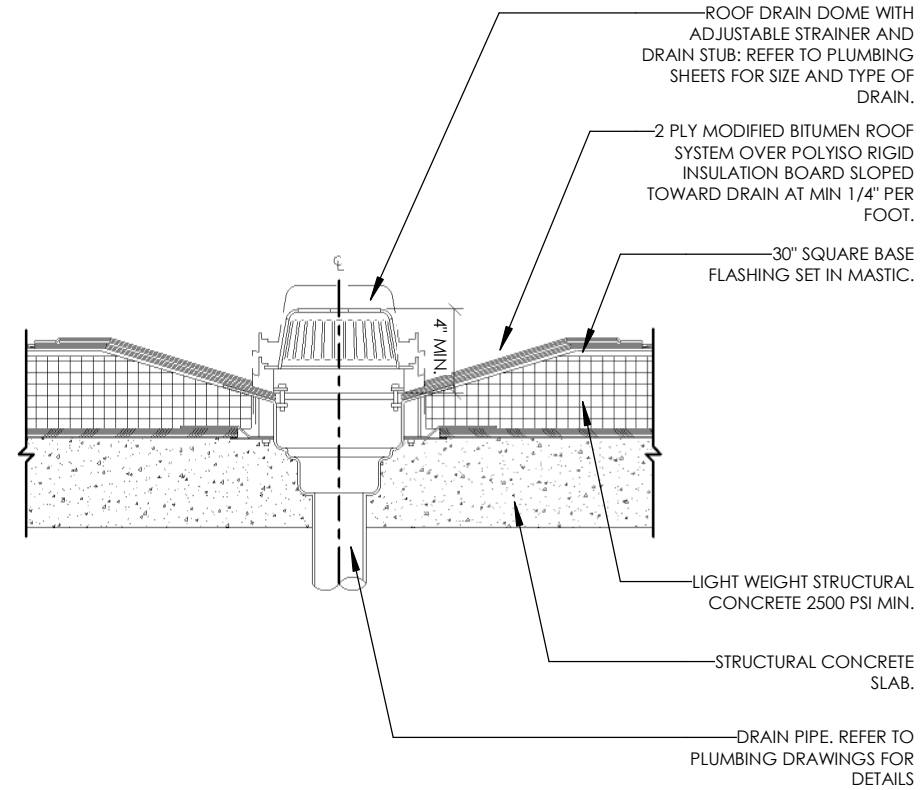

TYP. ROOF DRAIN DETAIL
N.T.S.

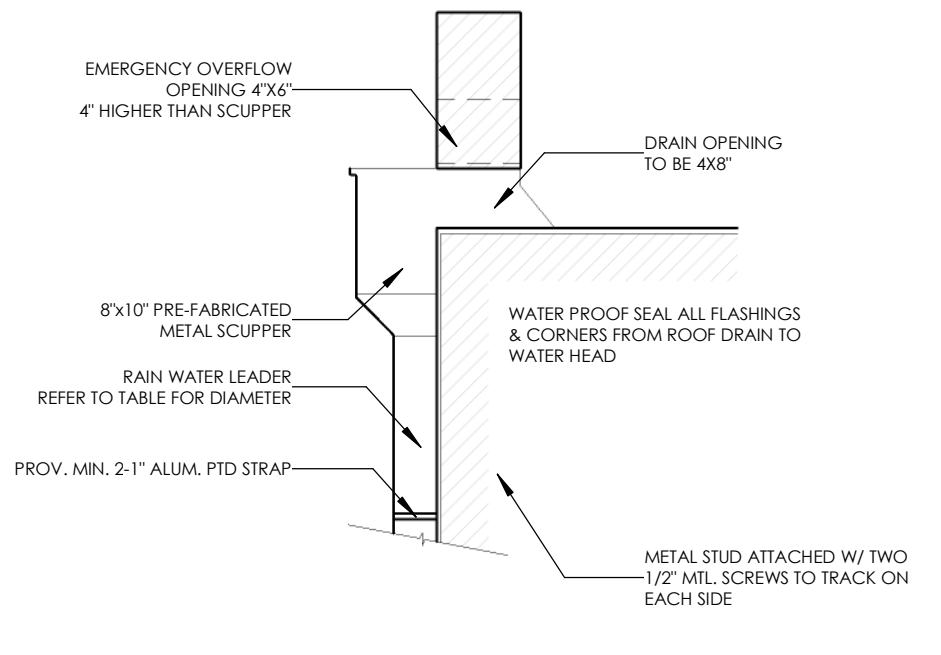

TYP. ROOF SCUPPER DETAIL
N.T.S.



MIK ARCHITECTURE LLC
MATIAS DARCHO
AR 100480
1383 CORAL WAY, SUITE 202
MIAMI, FLORIDA 33145
+1 786 758 0882
marcho@mikarch.com




AGD DEVELOPERS LLC
1383 CORAL WAY, SUITE 202
MIAMI, FLORIDA 33145
agdmiami.com
develop@agdmiami.com

NEW CONSTRUCTION
AGD CALISTONE LLC
10840 SW 67 AVE MIAMI, FL 33156

ISSUES
MAY 2025 131 ISSUED
2025-09-23 Correction 3
2025-12-05 Correction 4


#084
DRAWN BY NS
CHECKED BY MD
SCALE AS NOTED
FROM AA 26003995
SER.

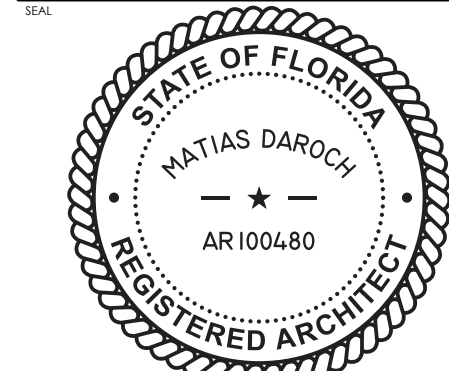

THIS IS A DIGITALLY SIGNED SET. THE "P" SYMBOL OF THIS DOCUMENT ARE NOT CONSIDERED SIGNED AND SEALED AND THE SIGNATURE MUST BE VERIFIED ON THE ORIGINAL PAPER. DETAILS

A-103


ROOF PLAN

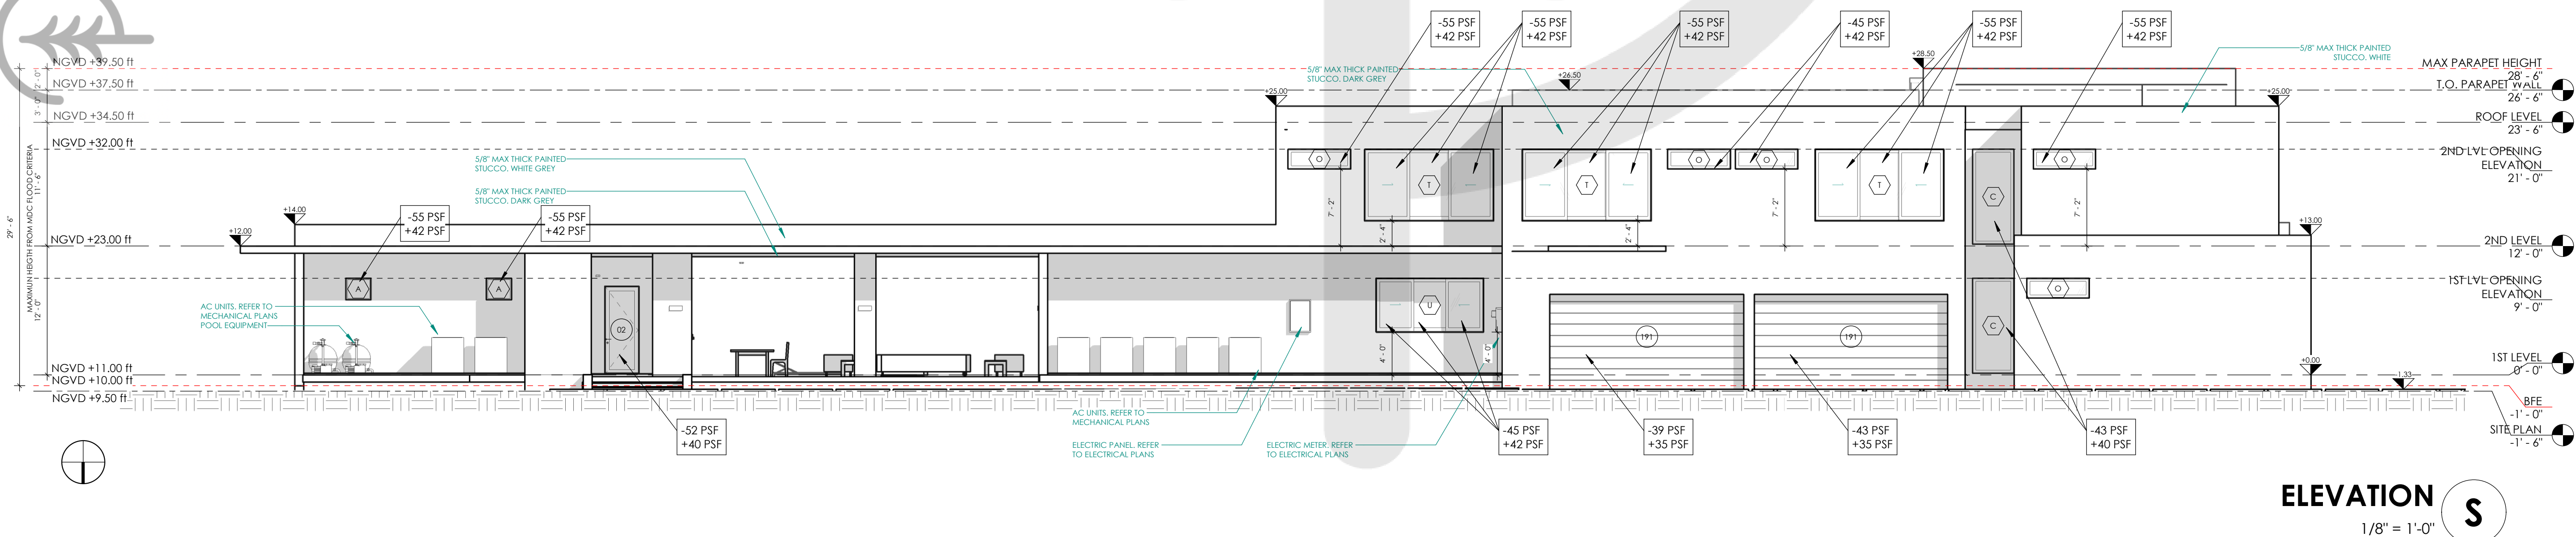


ELEVATION

APPROVED
PL2025-0564
waiters02/11/2025 2:38:20 PM

FINCREST
BUILDING +
PLANNING

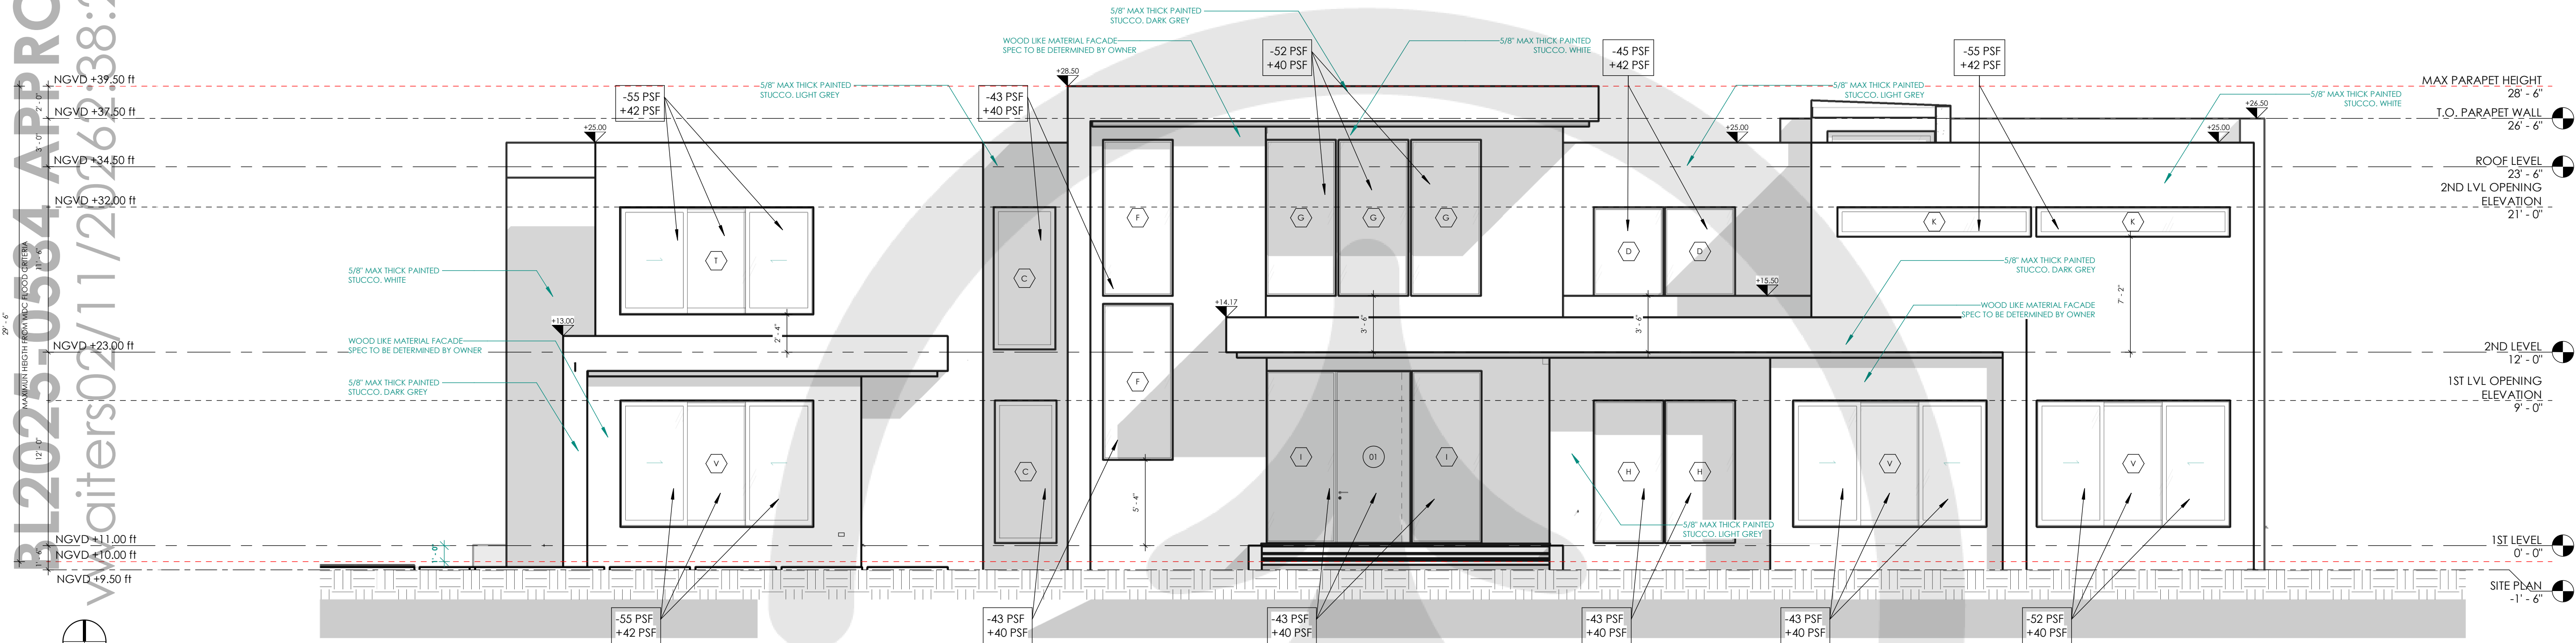

ELEVATION E
3/16" = 1'-0"

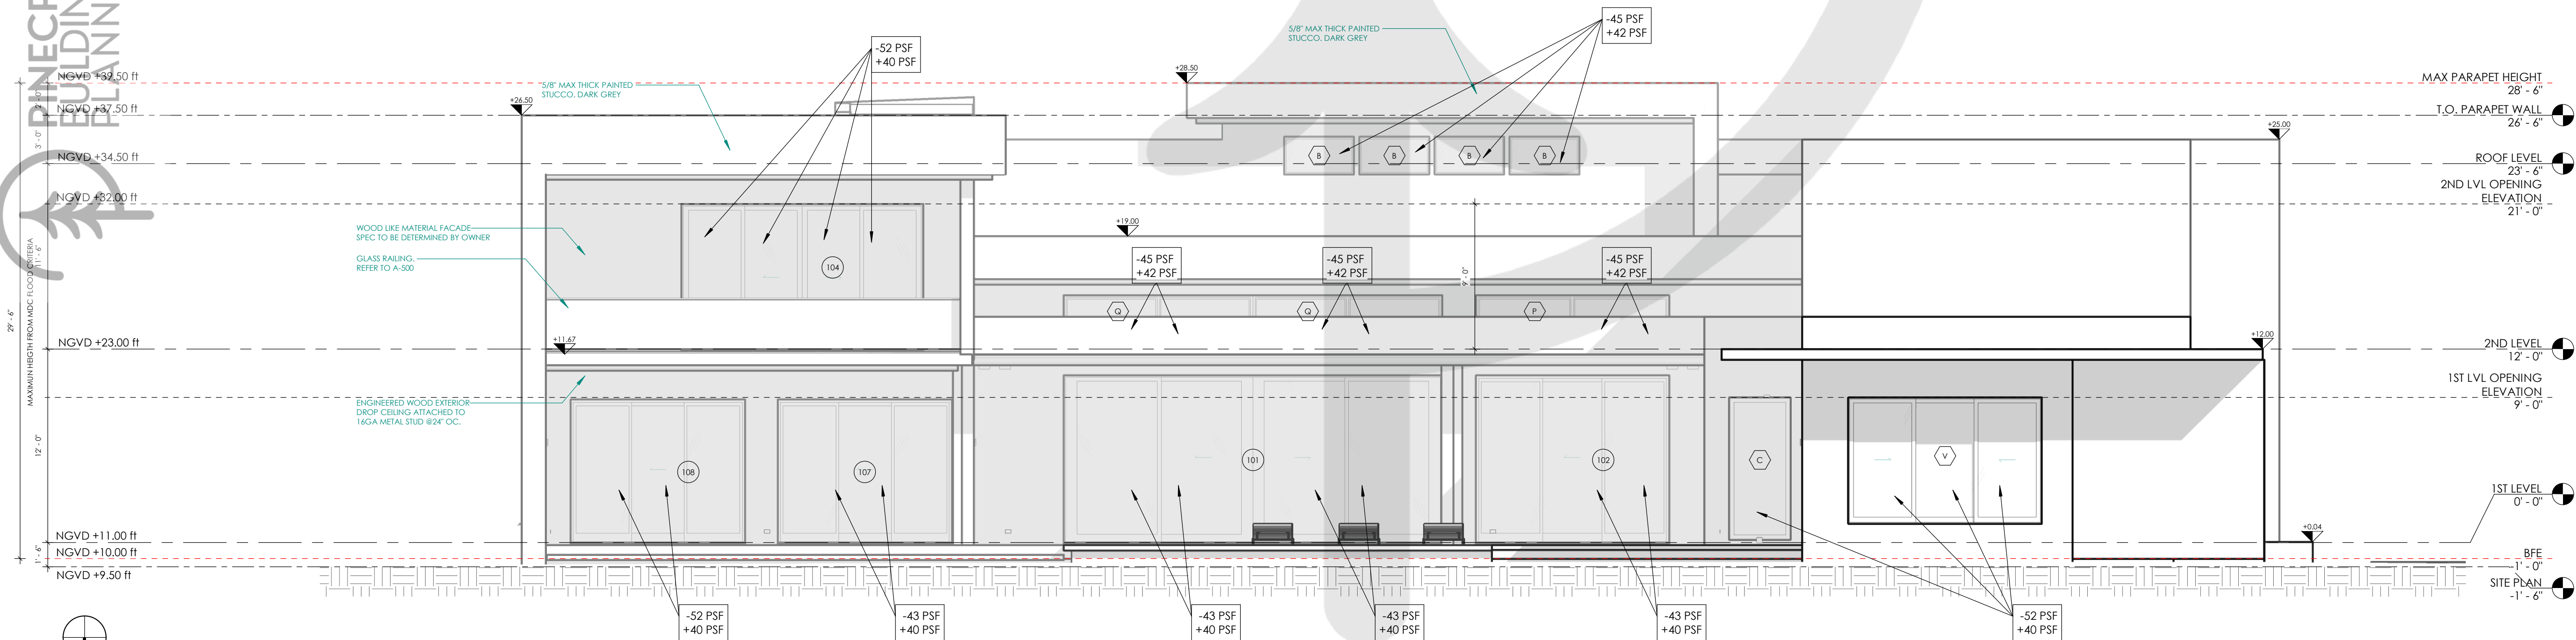

ELEVATION W
3/16" = 1'-0"



MIK ARCHITECTURE LLC
MATIAS DAROCH
AR 100480
1383 CORAL WAY, SUITE 202
MIAMI, FLORIDA 33145
+1 786 758 0882
miki@mikarch.com




AGD DEVELOPERS LLC
1383 CORAL WAY, SUITE 202
MIAMI, FLORIDA 33145
agdmiami.com
developers@agdmiami.com

NEW CONSTRUCTION
AGD CALISTONE LLC
10840 SW 67 AVE MIAMI, FL 33156

ISSUES	MAY 2025	1ST ISSUED
1	2025-09-11	Correction 2

JOB NO.	#084
DRAWN BY	NS
CHECKED BY	MD
SCALE	AS NOTED
FROM	AA 26003995
SER.	

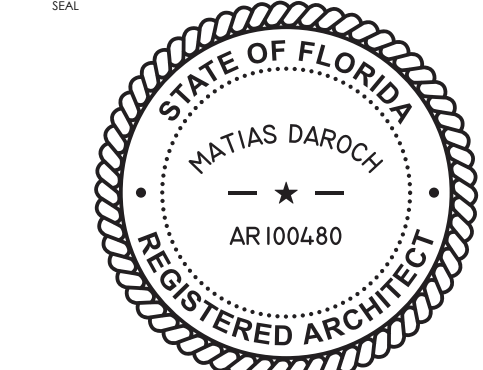

THIS IS A DIGITALLY SIGNED SHEET. THE CONTENTS OF THIS DOCUMENT ARE NOT CONSIDERED SIGNED AND SEALED UNTIL THE SIGNATURE HAS BEEN VERIFIED ON THE OFFICIAL WEBSITE.


THE CONTENT OF THIS SHEET AND ALL OTHER DRAWINGS ISSUED BY THE SET ARE PROTECTED BY U.S. AND INTERNATIONAL COPYRIGHT LAWS. REPRODUCTION OR USE WITHOUT PROPER WRITTEN CONSENT IS PROHIBITED BY LAW. SEE ALSO FOR DETAILS.

SHEET NO.

A-202


ELEVATIONS

BL2025-0584 APPROVED
wwaiter02/11/2025 03:38:20 PM

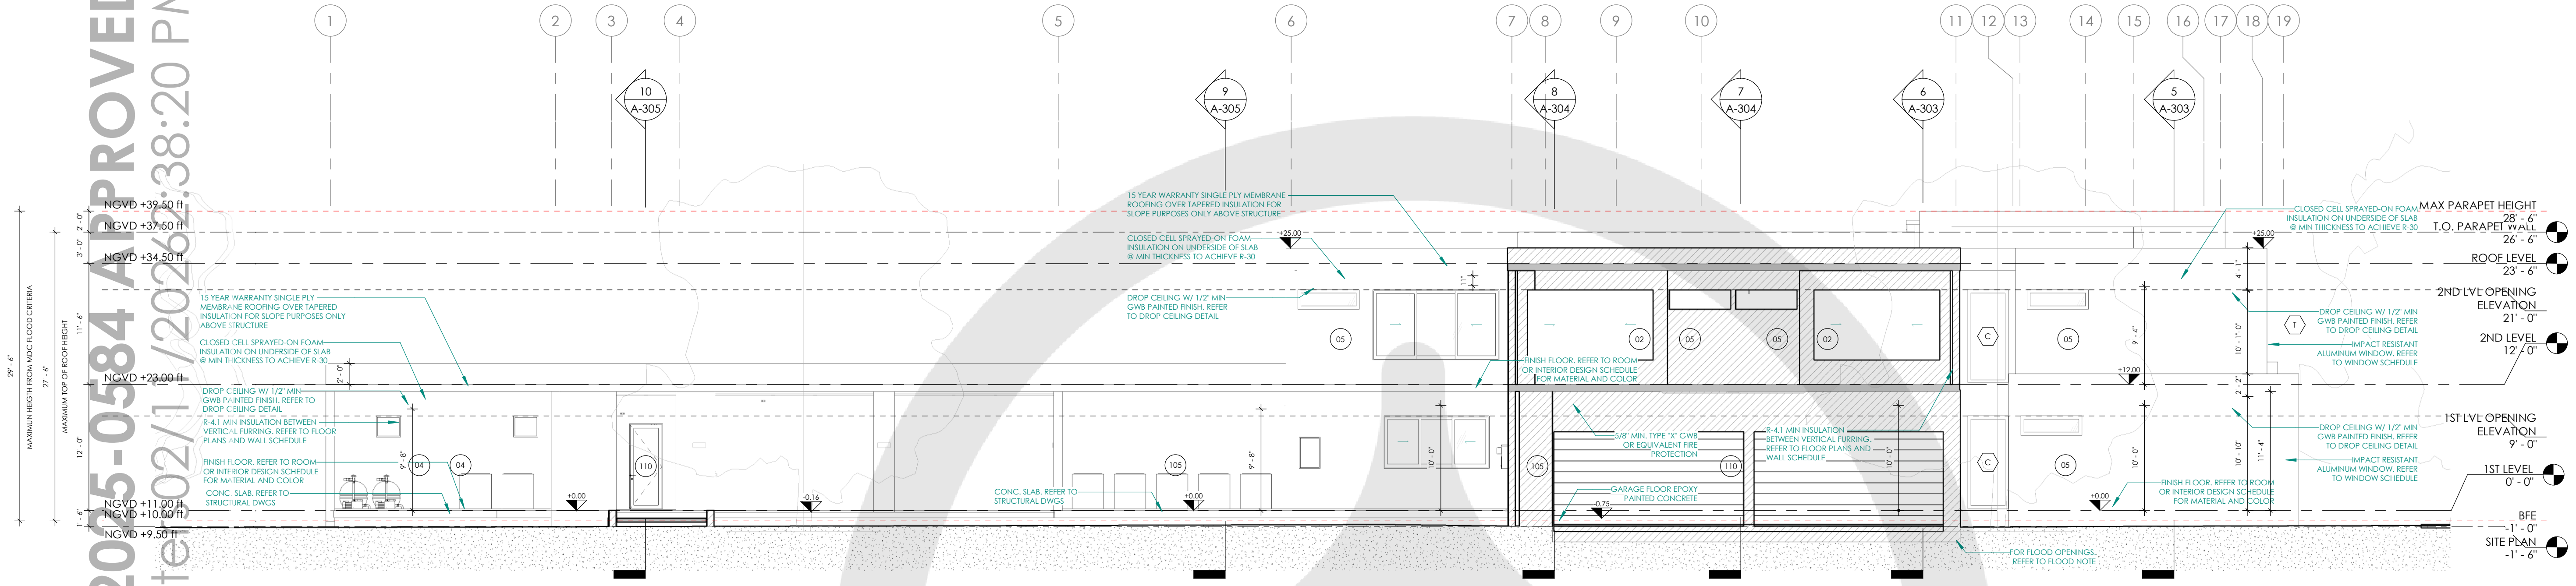


Section 1
1/8" = 1'-0"

PINECREST
BUILDING +
PLANNING

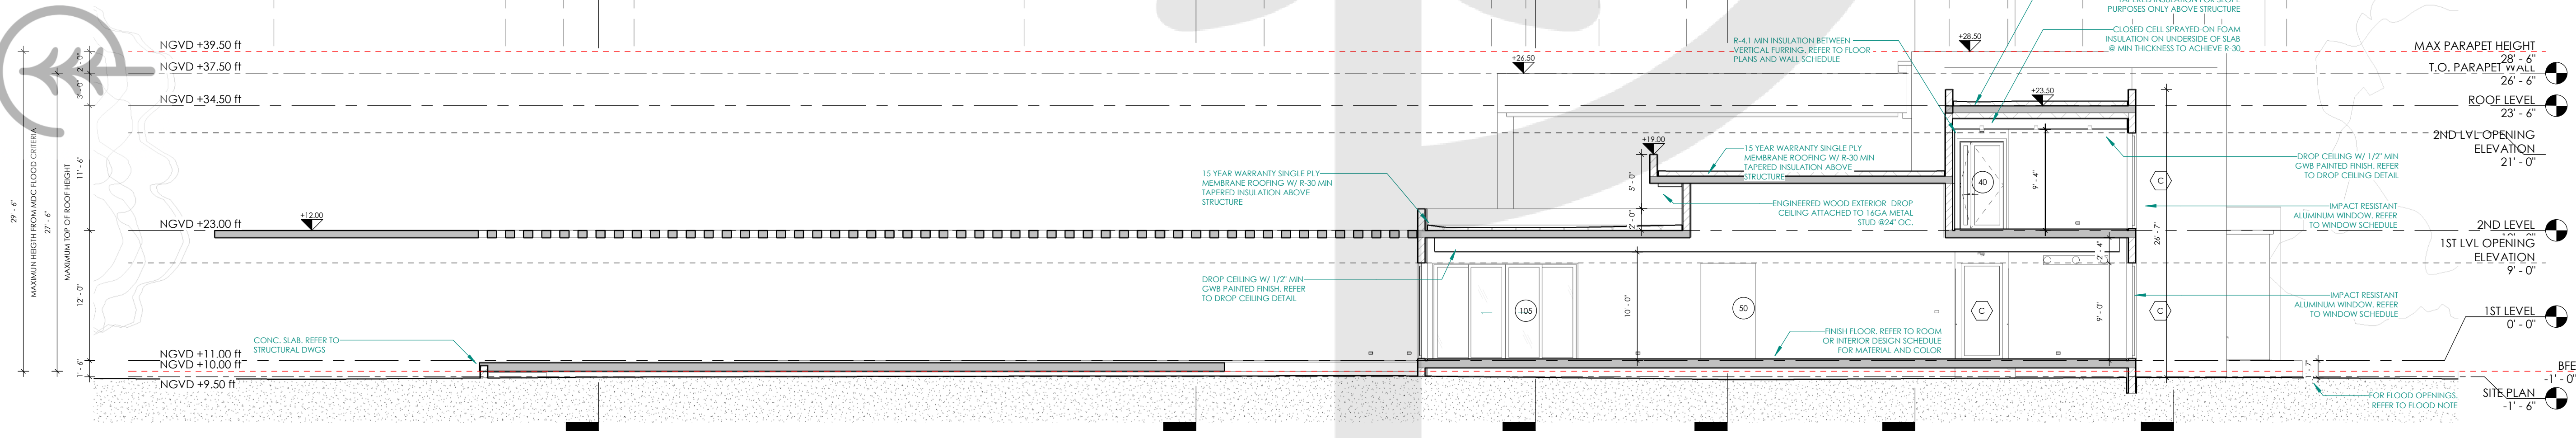

Section 2
1/8" = 1'-0"

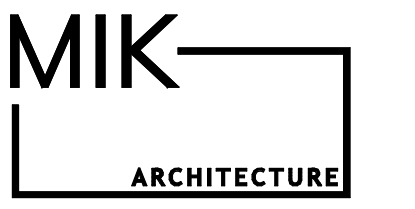


MIK ARCHITECTURE LLC
MATIAS DAROCH
AR 100480
1383 CORAL WAY, SUITE 202
MIAMI, FLORIDA 33146
+1 786 758 0882
miki@mikarch.com



AGD DEVELOPERS LLC
1383 CORAL WAY, SUITE 202
MIAMI, FLORIDA 33146
agdmiami.com
developers@agdmiami.com

NEW CONSTRUCTION
AGD CALISTONE LLC
10840 SW 67 AVE MIAMI, FL 33156

ISSUES	MAY 2025	1ST ISSUED
	2025-09-11	Correction 2
JOB NO.	#084	
DRAWN BY	NS	
CHECKED BY	MD	
SCALE	AS NOTED	
FROM ARCHIVE	AA 26003995	
SER.		

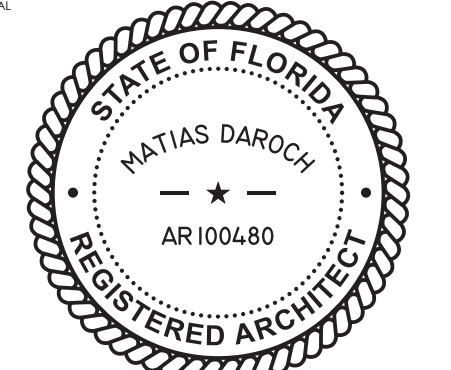

THIS IS A DIGITALLY SIGNED SET. THE NUMBER OF THE DOCUMENT ARE NOT CONSIDERED SIGNED AND SEALED AND THE SIGNATURE MUST BE VERIFIED ON THE ORIGINAL COPIES.

THE CONTENT OF THIS SHEET AND ALL OTHER DRAWINGS ISSUED BY THE SET ARE PROTECTED BY U.S. AND INTERNATIONAL COPYRIGHT LAWS. REPRODUCTION OR USE WITHOUT PROPER WRITTEN CONSENT IS PROHIBITED BY LAW. SEE ALSO FOR DETAILS.


SHEET NO.

A-301


SECTIONS

BL2025-0534 APPROVED
waitef02/11/2026 2:38:20 PM

PINECREST
BUILDING +
PLANNING

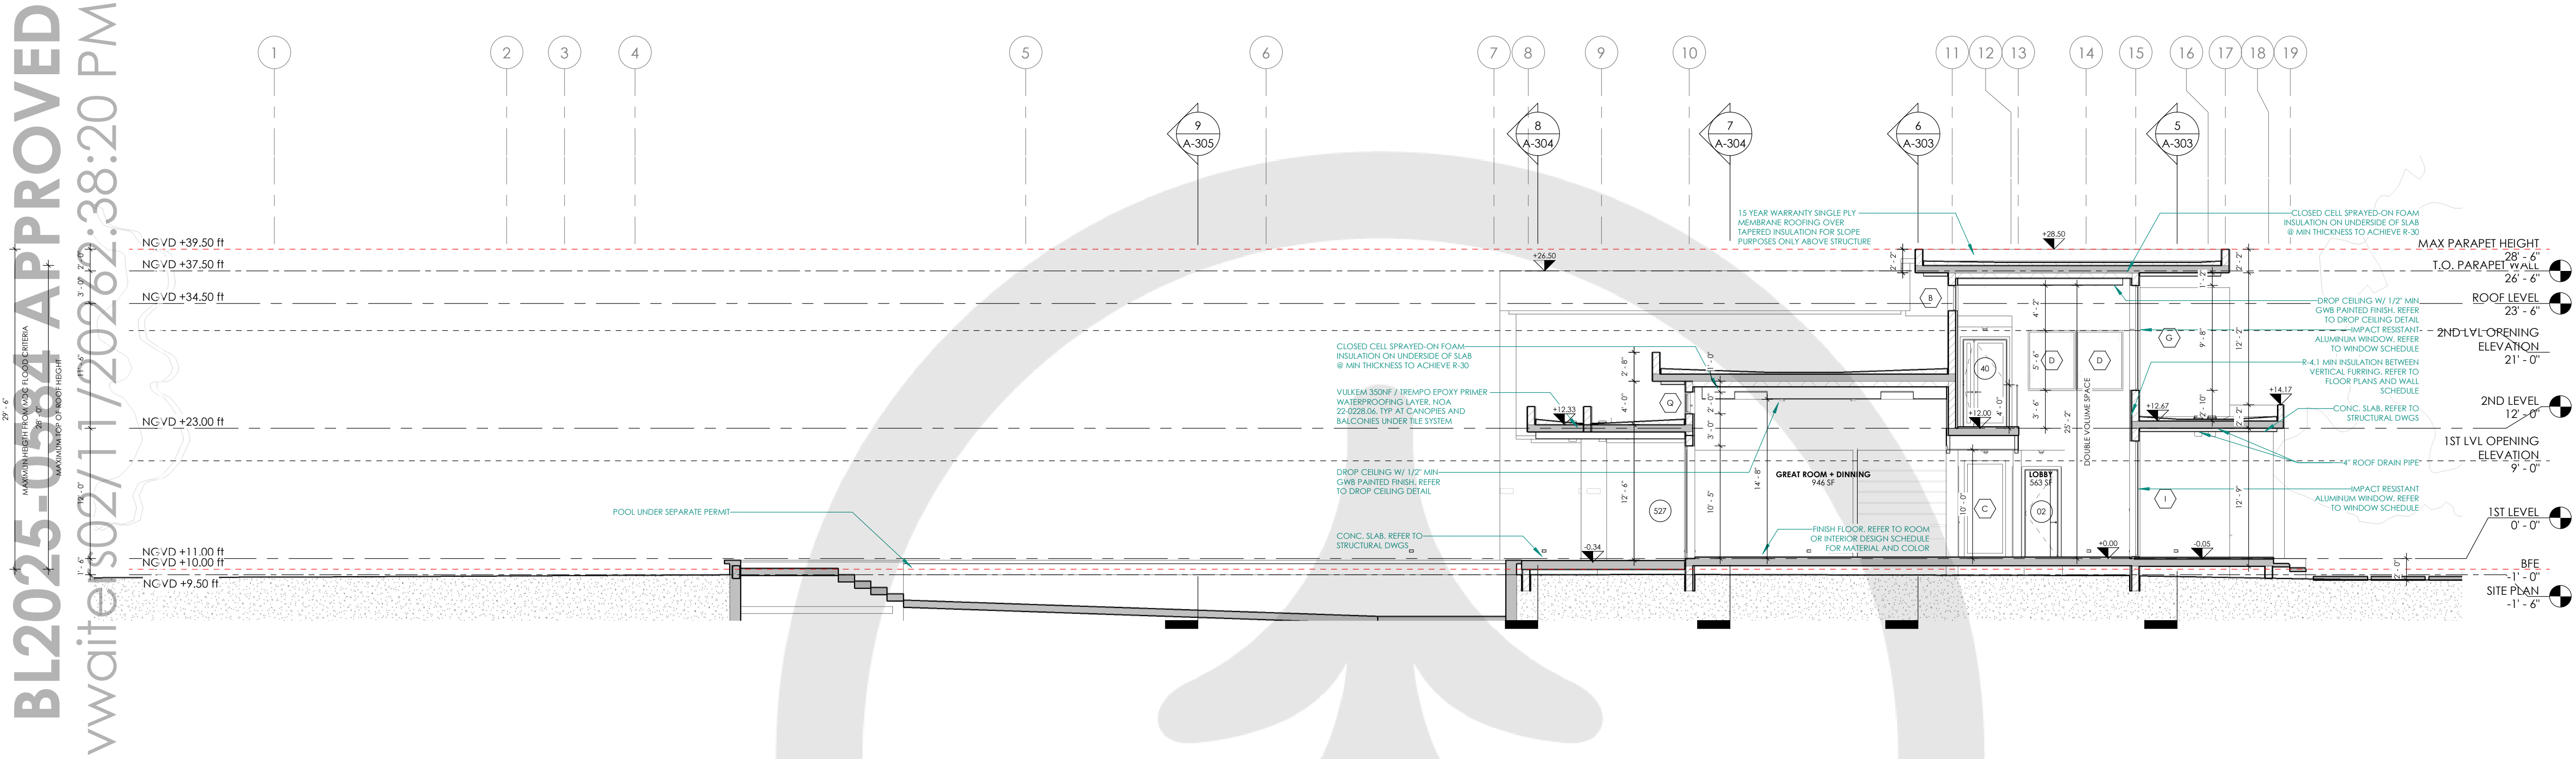

Section 3
1/8" = 1'-0"

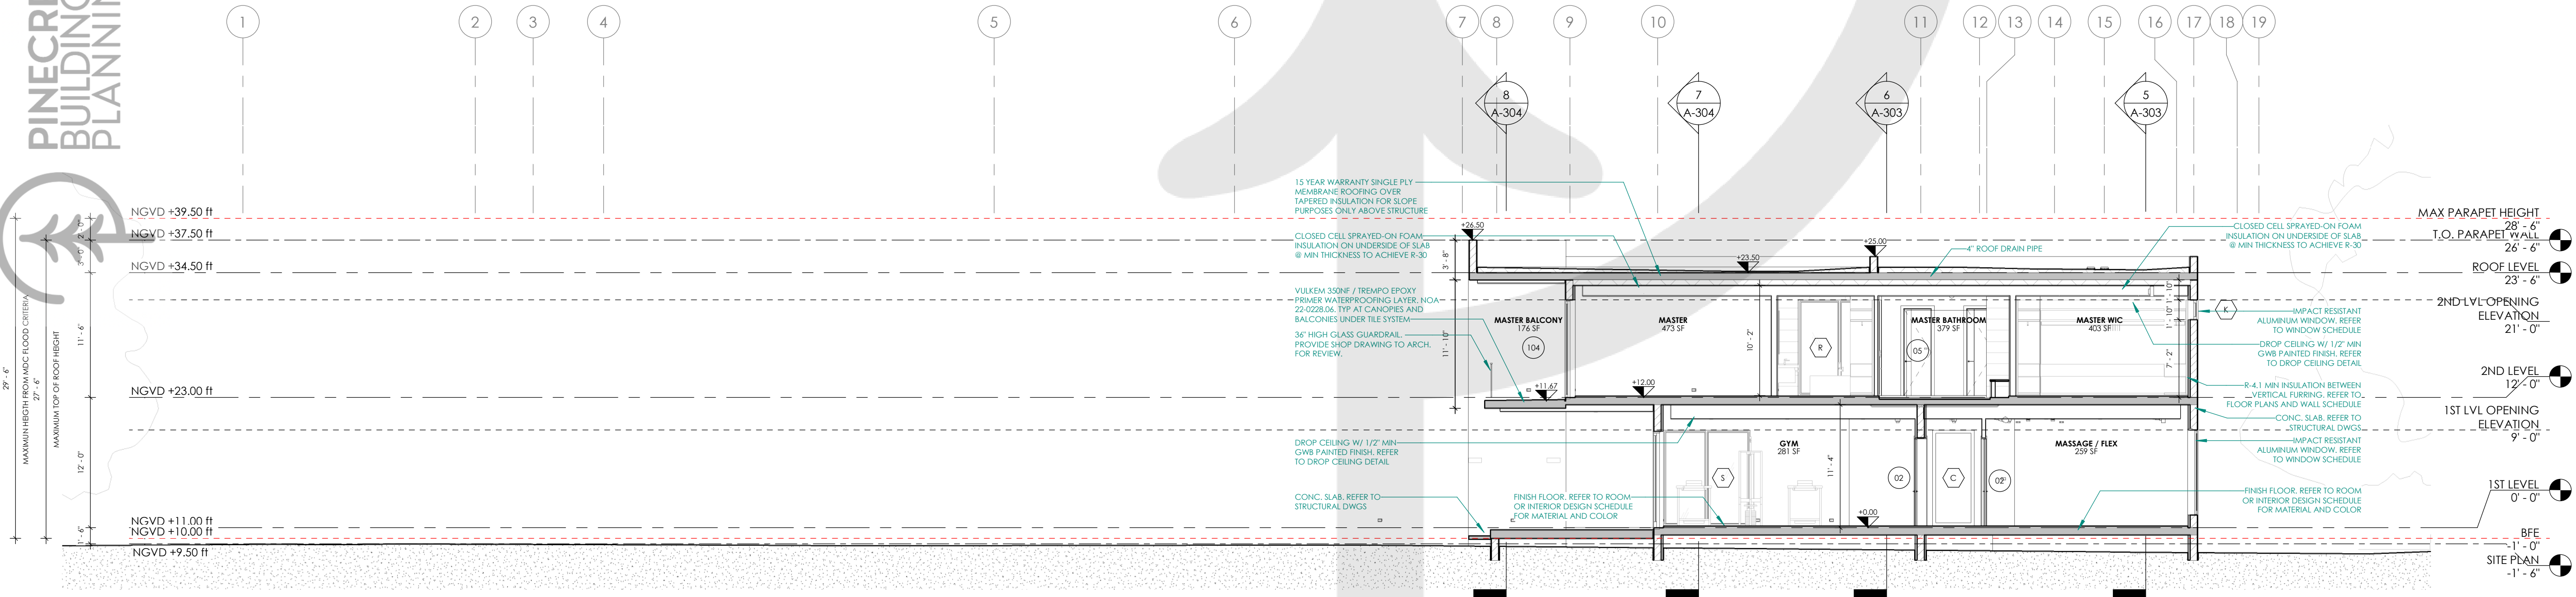

Section 4
1/8" = 1'-0"




MIK ARCHITECTURE LLC
MATIAS DAROCH
AR 100480
1383 CORAL WAY, SUITE 202
MIAMI, FLORIDA 33147
+1 786 758 5882
miki@mikarch.com



AGD DEVELOPERS LLC
1383 CORAL WAY, SUITE 202
MIAMI, FLORIDA 33147
agdmiami.com
develop@agdmiami.com

NEW CONSTRUCTION
AGD CALISTONE LLC
10840 SW 67 AVE MIAMI, FL 33156

ISSUES	MAY 2025	1ST ISSUED
	2025-09-11	Correction 2
DATE		
NO.	#084	
DRAWN BY	NS	
CHECKED BY	MD	
SCALE	AS NOTED	
FROM	AA 26003995	
DATE		

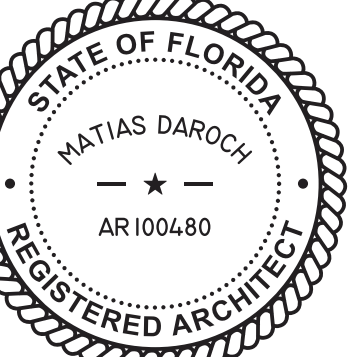

THIS IS A DIGITALLY SIGNED SHEET. THE CONTENTS OF THIS DOCUMENT ARE NOT CONSIDERED SIGNED AND SEALED UNTIL THE SIGNATURE HAS BEEN VERIFIED ON THE SIGNING CODES.

THE CONTENT OF THIS SHEET AND ALL OTHER DRAWINGS ISSUED BY THE SET ARE PROTECTED BY U.S. AND INTERNATIONAL COPYRIGHT LAWS. REPRODUCTION OR USE WITHOUT PROPER WRITTEN CONSENT IS PROHIBITED BY LAW. SEE ALSO FOR DETAILS.


SHEET NO.

A-302


SECTIONS

BL2025-0584 APPROVED
02/11/2025 2:38:21 PM
waiters02/11/2025 2:38:21 PM


PINECREST
BUILDING +
PLANNING

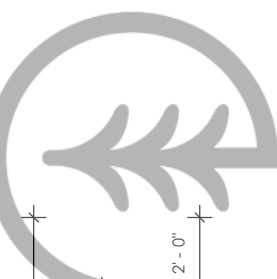

29'-4"
MAXIMUM HEIGHT FROM MDC FLOOD CRITERIA
27'-4"
MAXIMUM TOP OF ROOF HEIGHT

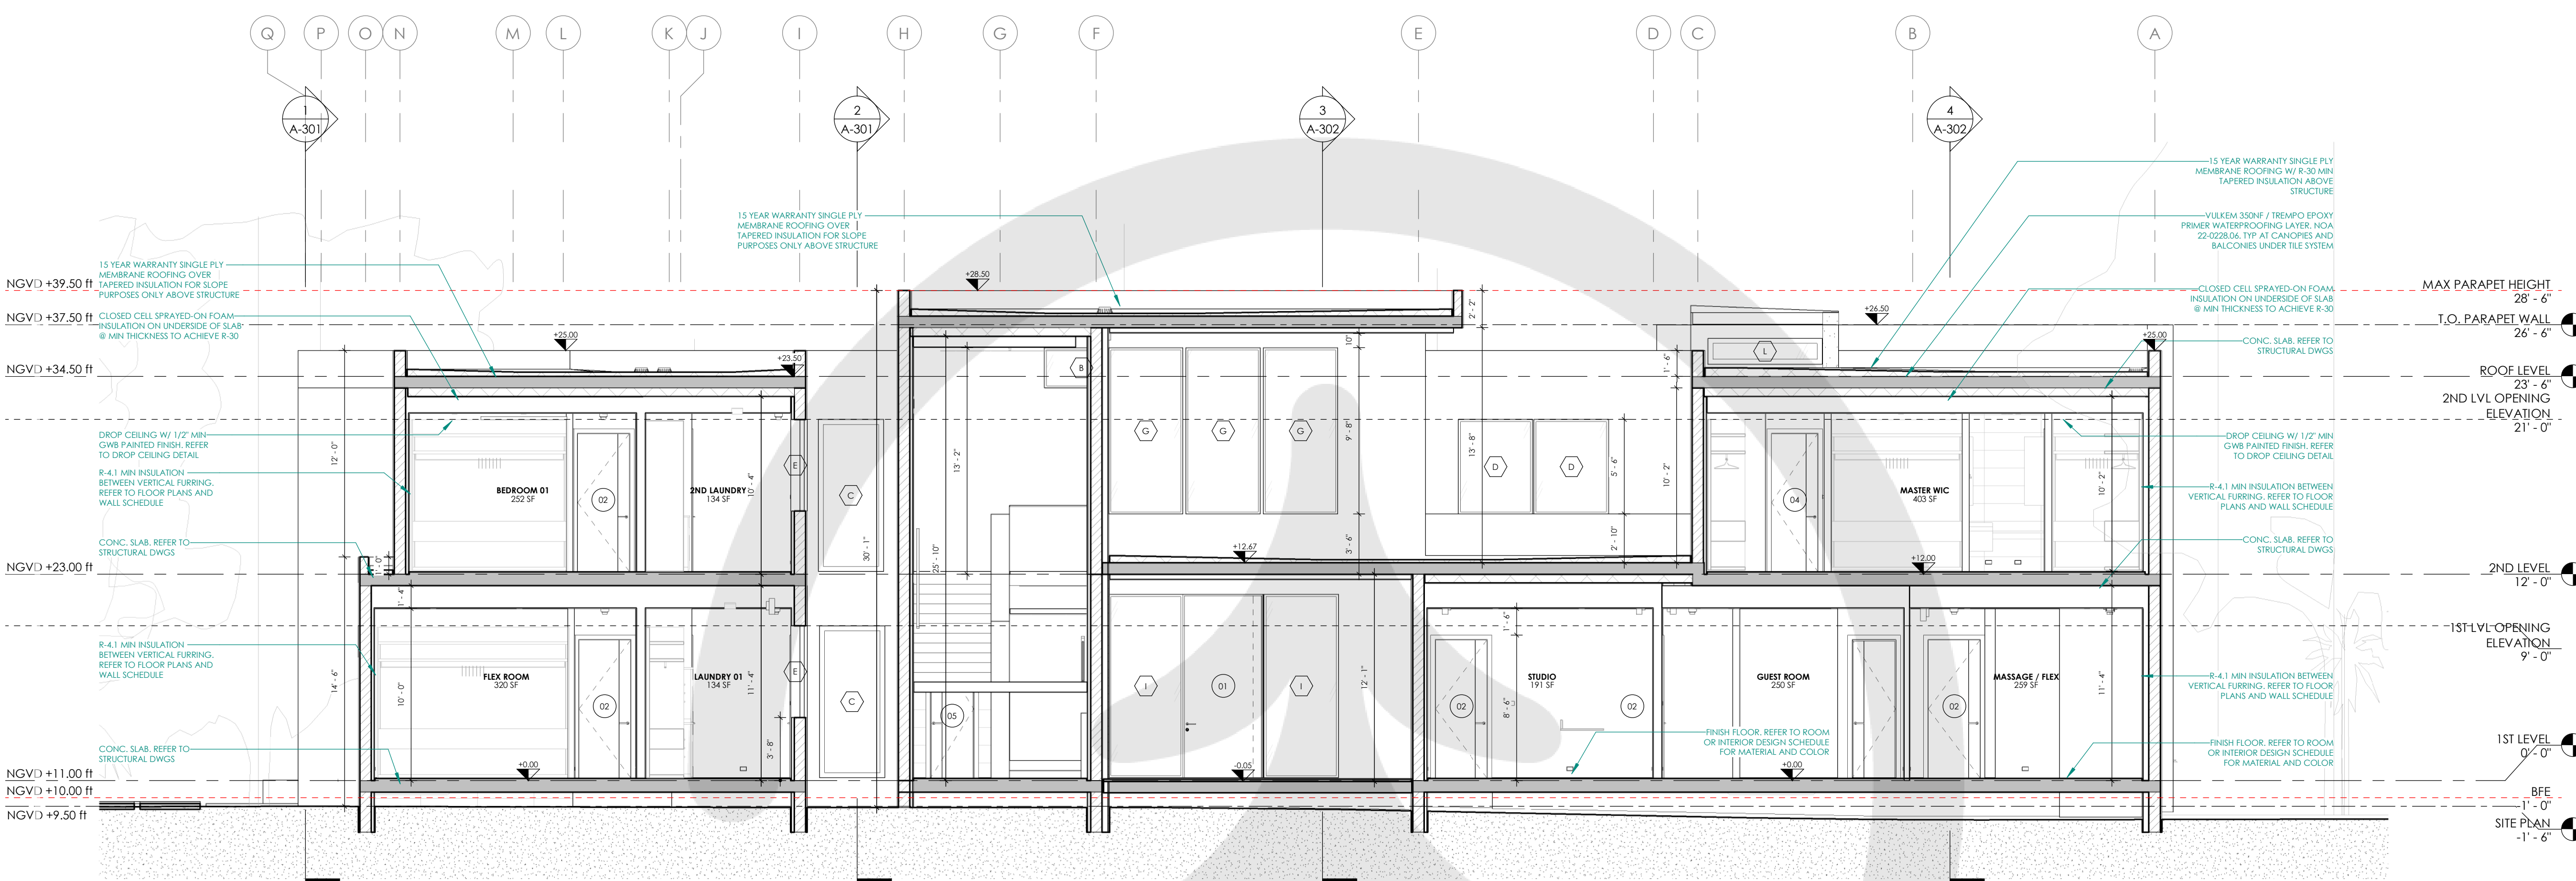

Section 5
3/16" = 1'-0"

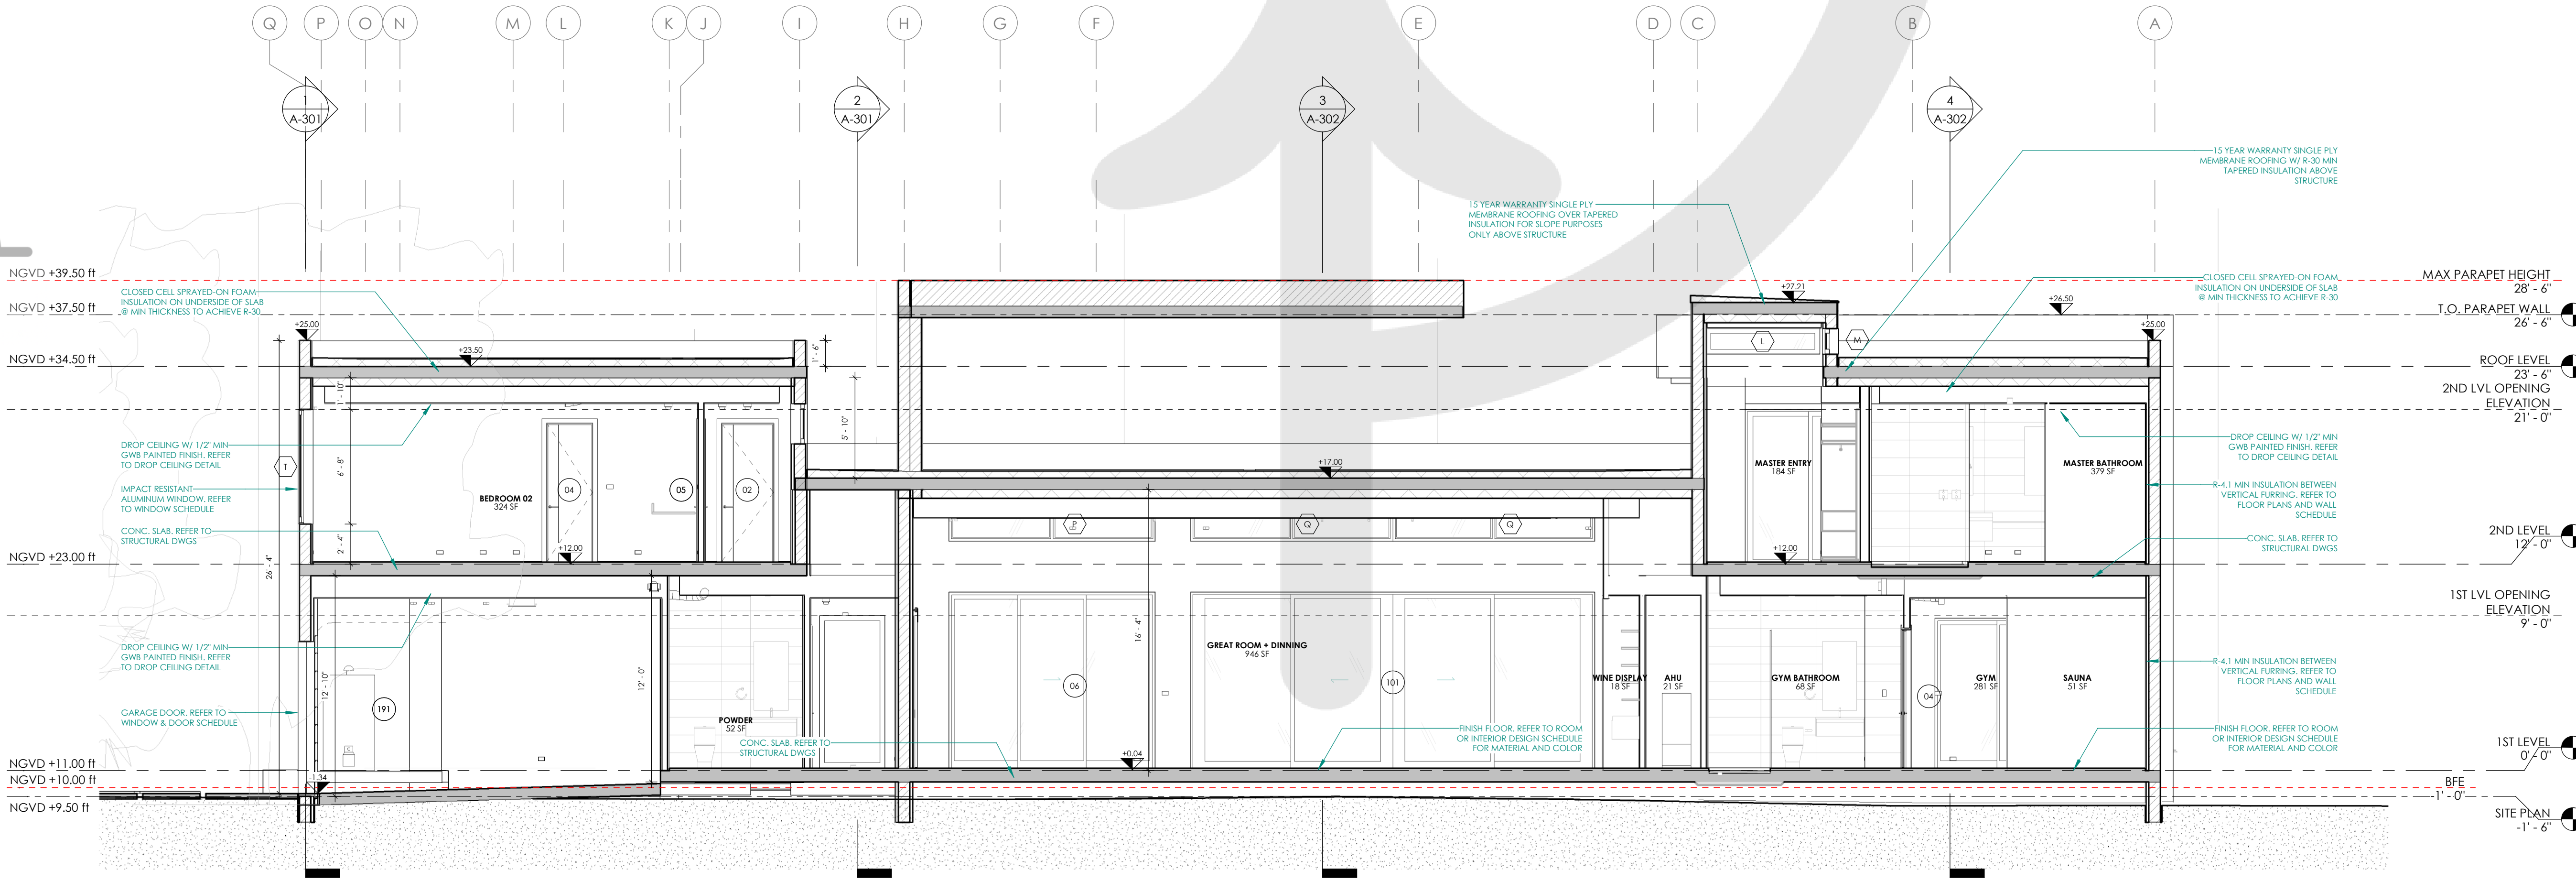

Section 6
3/16" = 1'-0"

MIK
ARCHITECTURE

MIK ARCHITECTURE LLC
MATIAS DAROCH
AR 100480
1385 CORAL WAY, SUITE 202
MIAMI, FLORIDA 33145
+1 786 758 0882
miki@mikarch.com

AGD
AGD DEVELOPERS LLC

1385 CORAL WAY, SUITE 202
MIAMI, FLORIDA 33145
agdmiami.com
developers@agdmiami.com

NEW CONSTRUCTION
AGD CALISTONE LLC
10840 SW 67 AVE MIAMI, FL 33156

ISSUES
MAY 2025
2025-09-11

1ST ISSUED
Correction 2

JOB NO.
#084

DRAWN BY
NS

CHECKED BY
MD

SCALE
AS NOTED

FROM
LAYOUT
AA 26003995

SER.

STATE OF FLORIDA
REGISTERED ARCHITECT
MATIAS DAROCH
AR 100480

THIS IS A DIGITAL E-SIGNED DOCUMENT. THE CONTENT OF THIS DOCUMENT ARE NOT
CONSIDERED SIGNED AND SEALED AND THE SIGNATURE MUST BE VERIFIED ON
THE ORIGINAL DOCUMENT.

THE CONTENT OF THIS SHEET AND ALL OTHER DRAWINGS ISSUED BY THE SET ARE
PROTECTED BY U.S. AND INTERNATIONAL COPYRIGHT LAWS. REPRODUCTION OR
USE WITHOUT PROPER WRITTEN CONSENT IS PROHIBITED BY LAW. SEE ALSO FOR
DETAILS.

SHEET NO.


A-303

SECTIONS


12/11/2025 13:43:53 PM 2:2025-09-11 Correction 2

BL2025-0584 APPROVED
WATERS02/11/2026 2:38:21 PM

PINECREST
BUILDING +
PLANNING

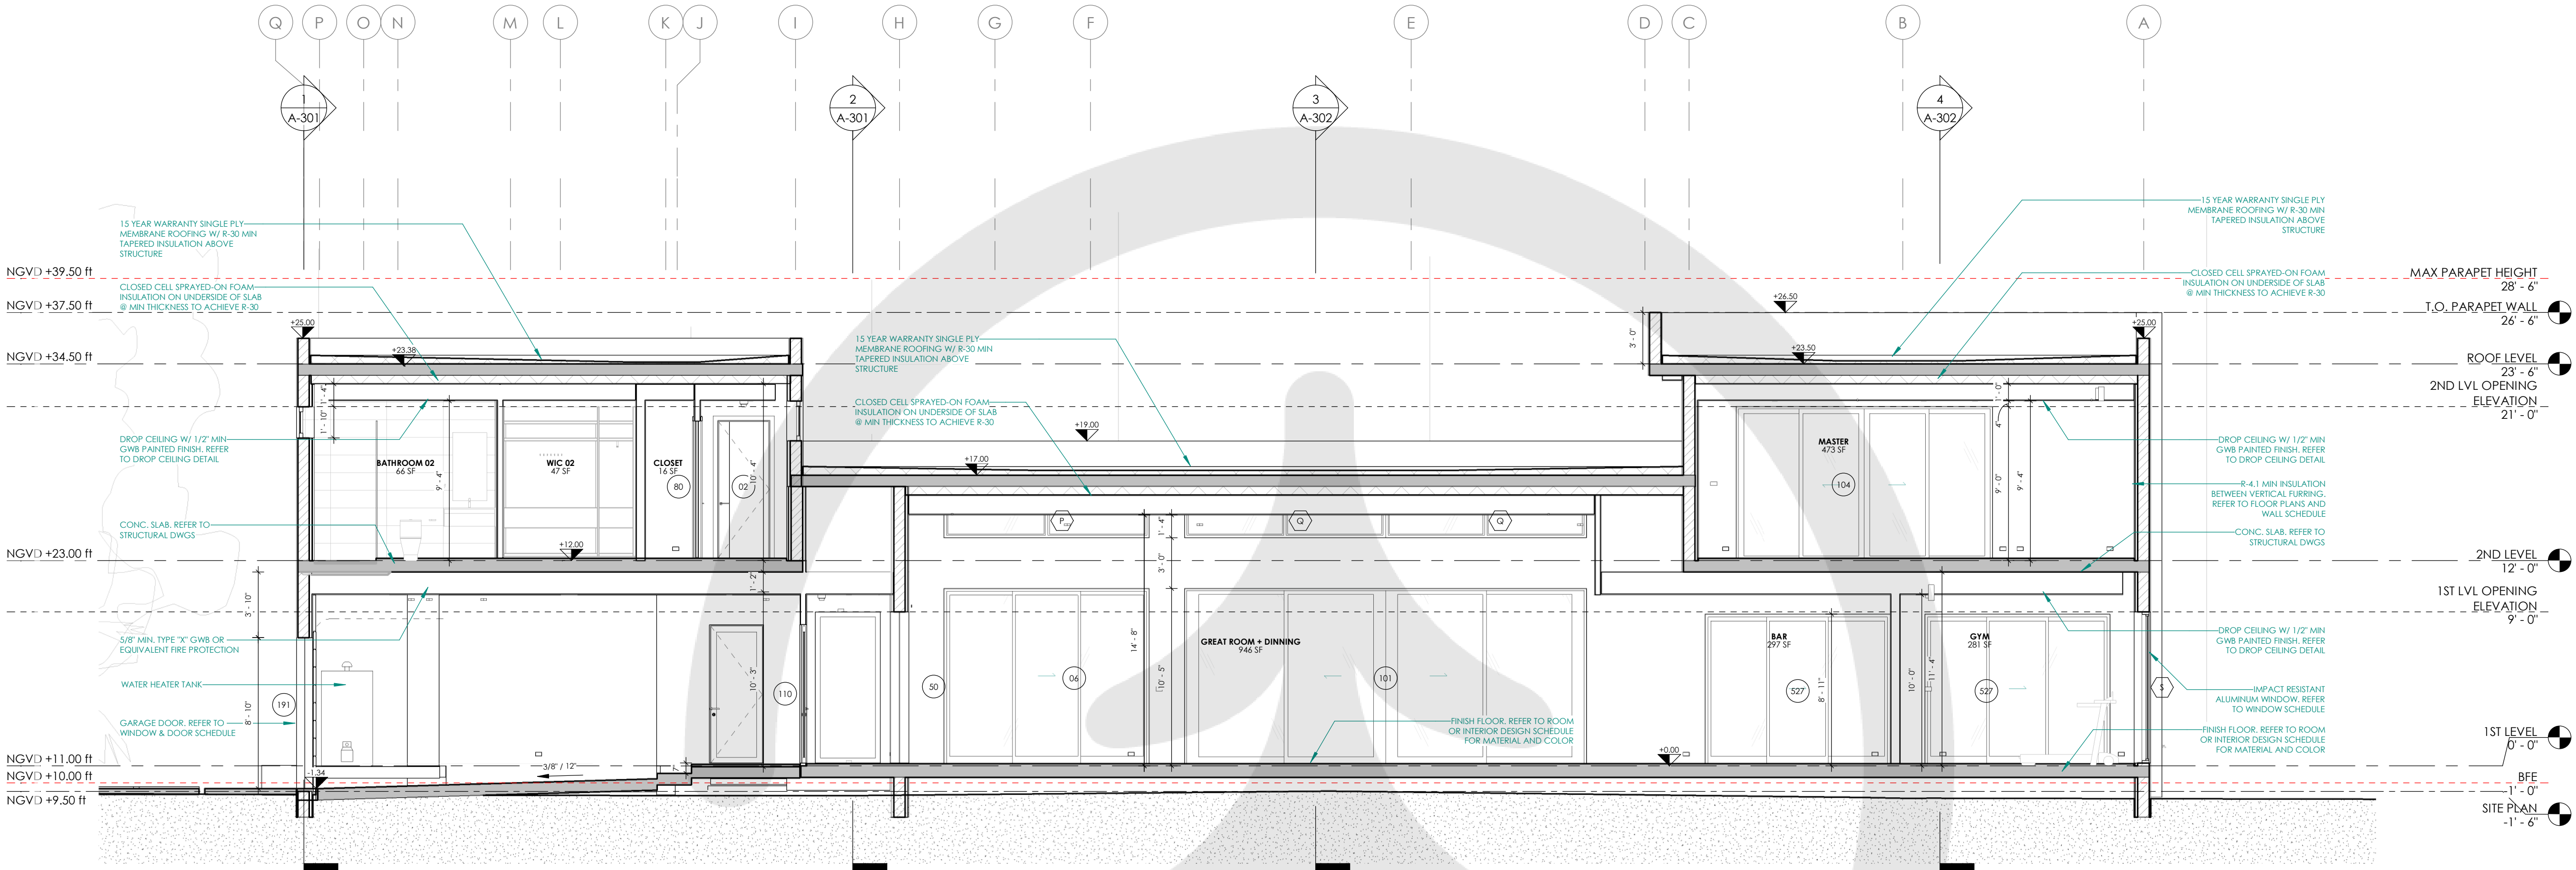

Section 7
3/16" = 1'-0"

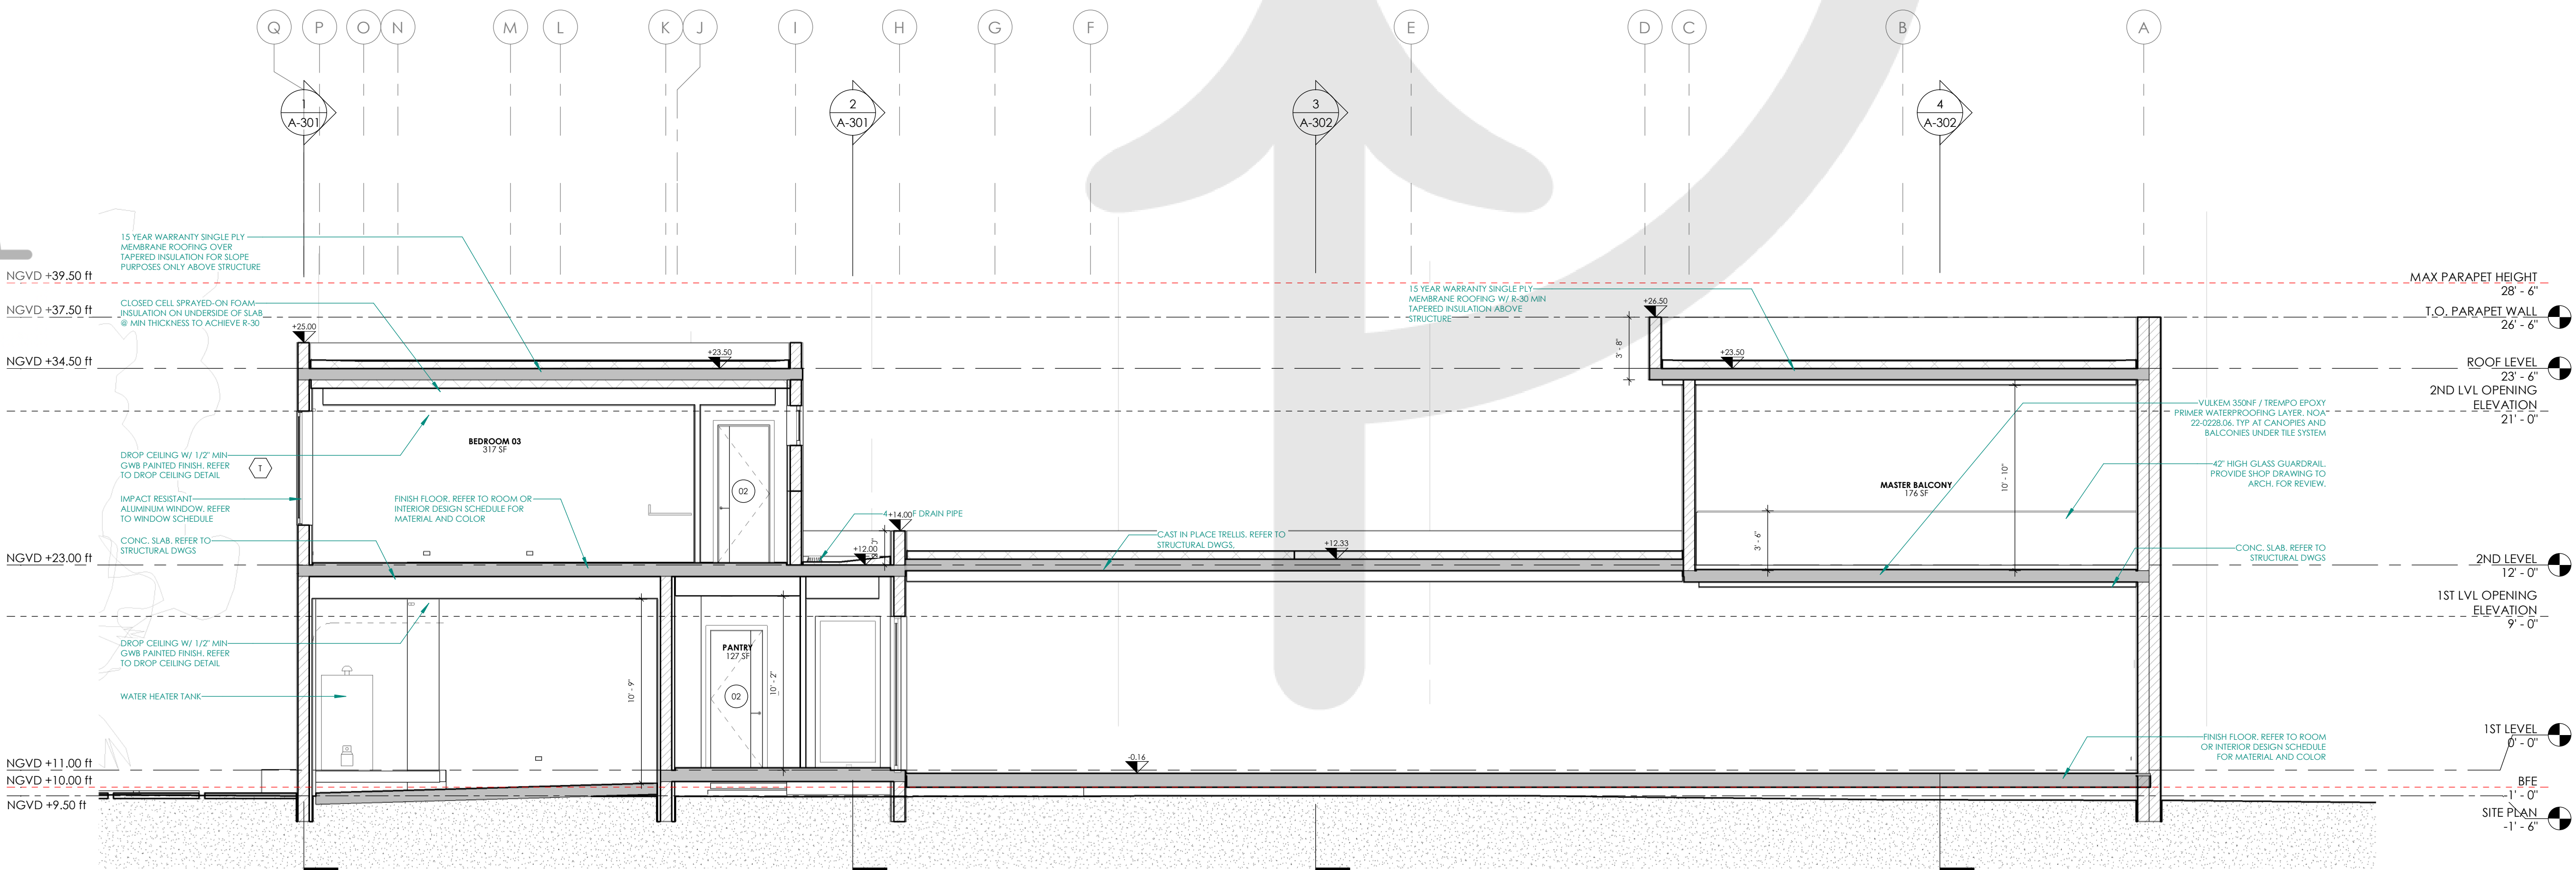

Section 8
3/16" = 1'-0"



MIK ARCHITECTURE LLC
MATIAS DAROCH
AR 100480
1380 CORAL WAY, SUITE 202
MIAMI, FLORIDA 33145
+1 786 758 0882
mikiarchitect.com




AGD DEVELOPERS LLC
1380 CORAL WAY, SUITE 202
MIAMI, FLORIDA 33145
agdmiami.com
developers@agdmiami.com

NEW CONSTRUCTION
AGD CALISTONE LLC
10840 SW 67 AVE MIAMI, FL 33156

ISSUES	MAY 2025	1ST ISSUED
2025-09-11	Correction 2	

JOB NO.	#084
DRAWN BY	NS
CHECKED BY	MD
SCALE	AS NOTED
FROM	AA 26003995
SER.	

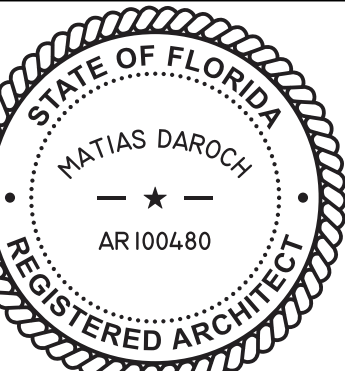

THIS IS A DIGITAL E-SIGNED SHEET. THE PRINTED COPY OF THIS DOCUMENT ARE NOT CONSIDERED SIGNED AND SEALED AND THE SIGNATURE MUST BE VERIFIED ON THE E-SIGNED COPY.



THE CONTENT OF THIS SHEET AND ALL OTHER DRAWINGS ISSUED BY THE SET ARE PROTECTED BY U.S. AND INTERNATIONAL COPYRIGHT LAWS. REPRODUCTION OR USE WITHOUT PROPER WRITTEN CONSENT IS PROHIBITED BY LAW. SEE ALSO FOR DETAILS.

SHEET NO.


A-304

SECTIONS

PINECREST
BUILDING+
PLANNING

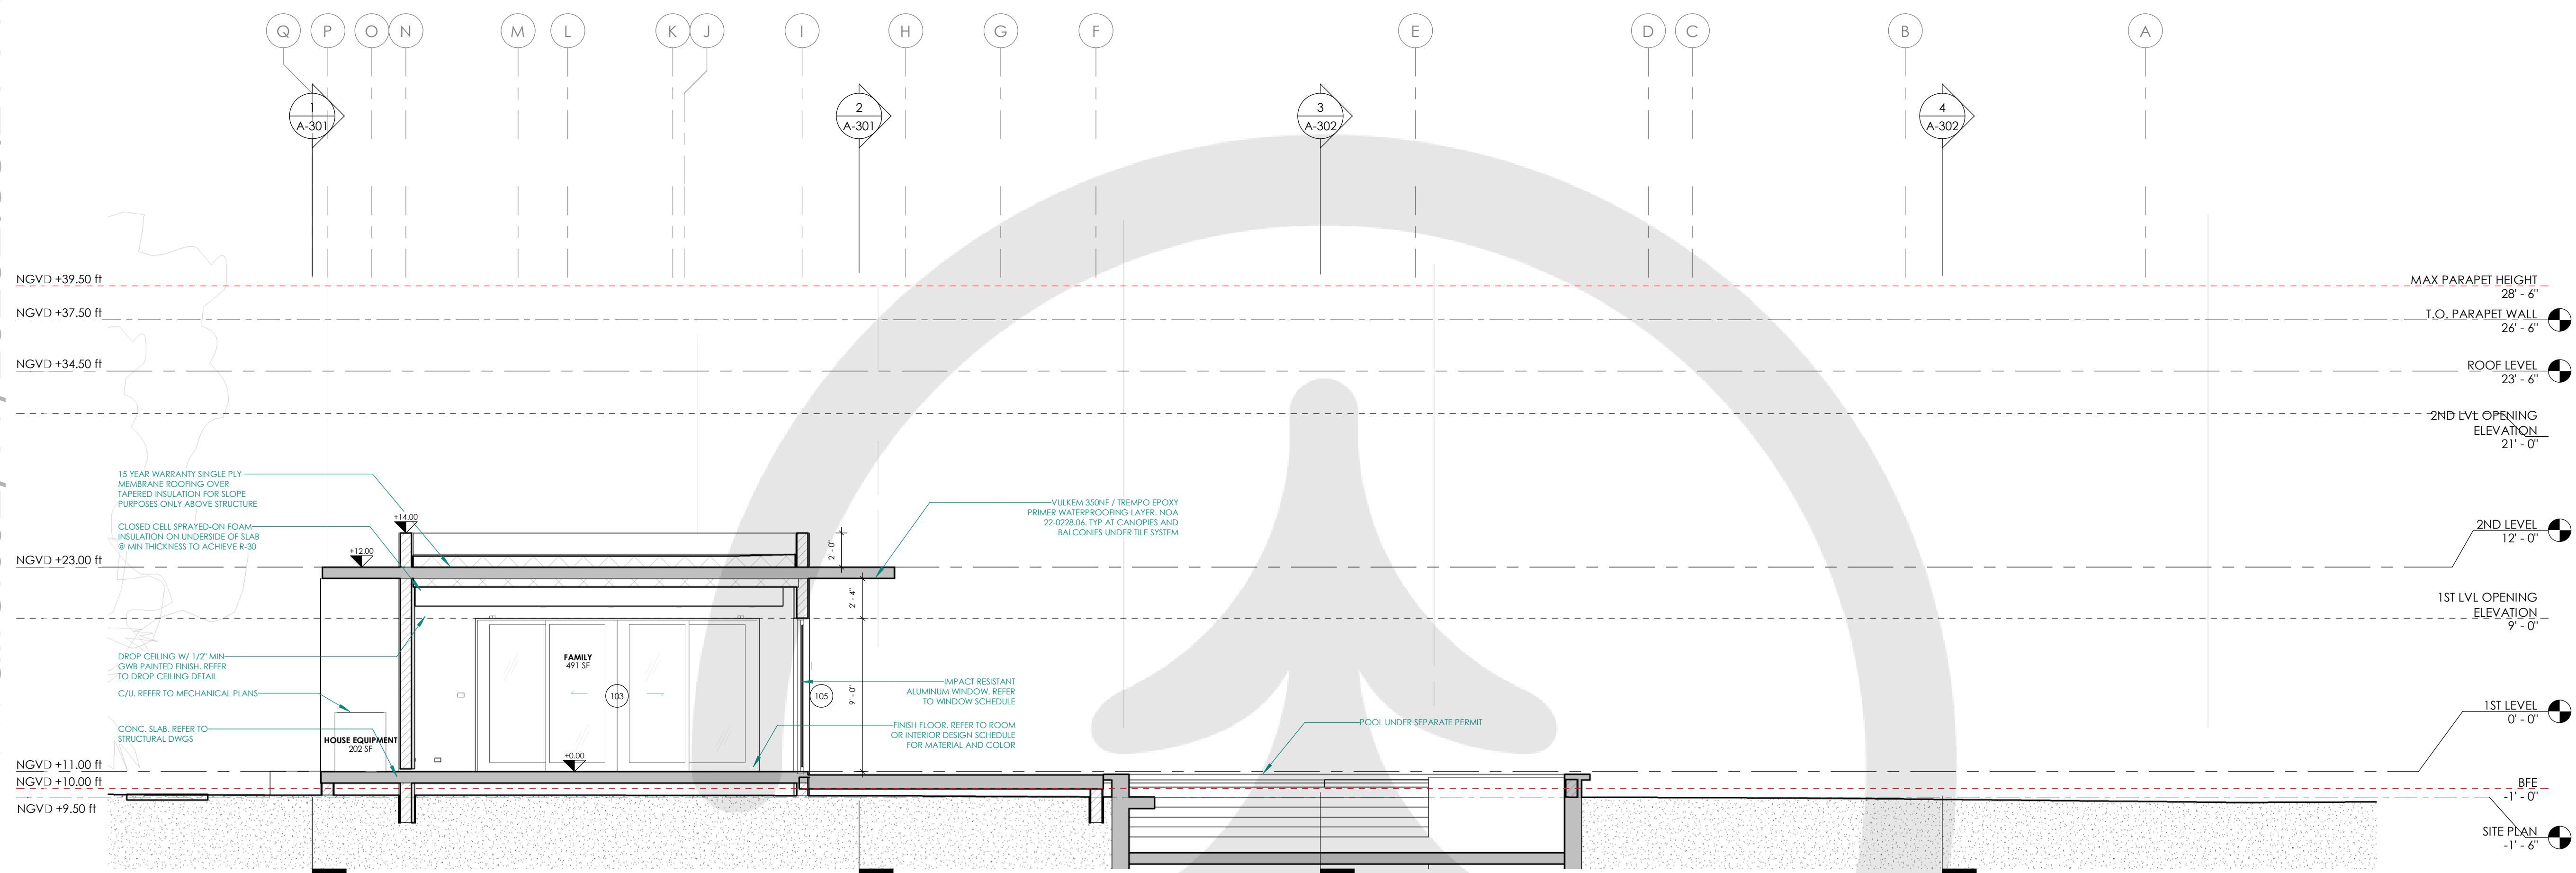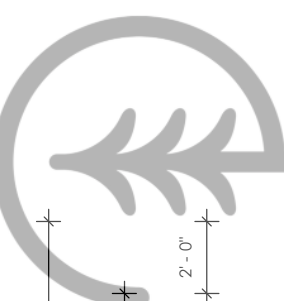


Section 9

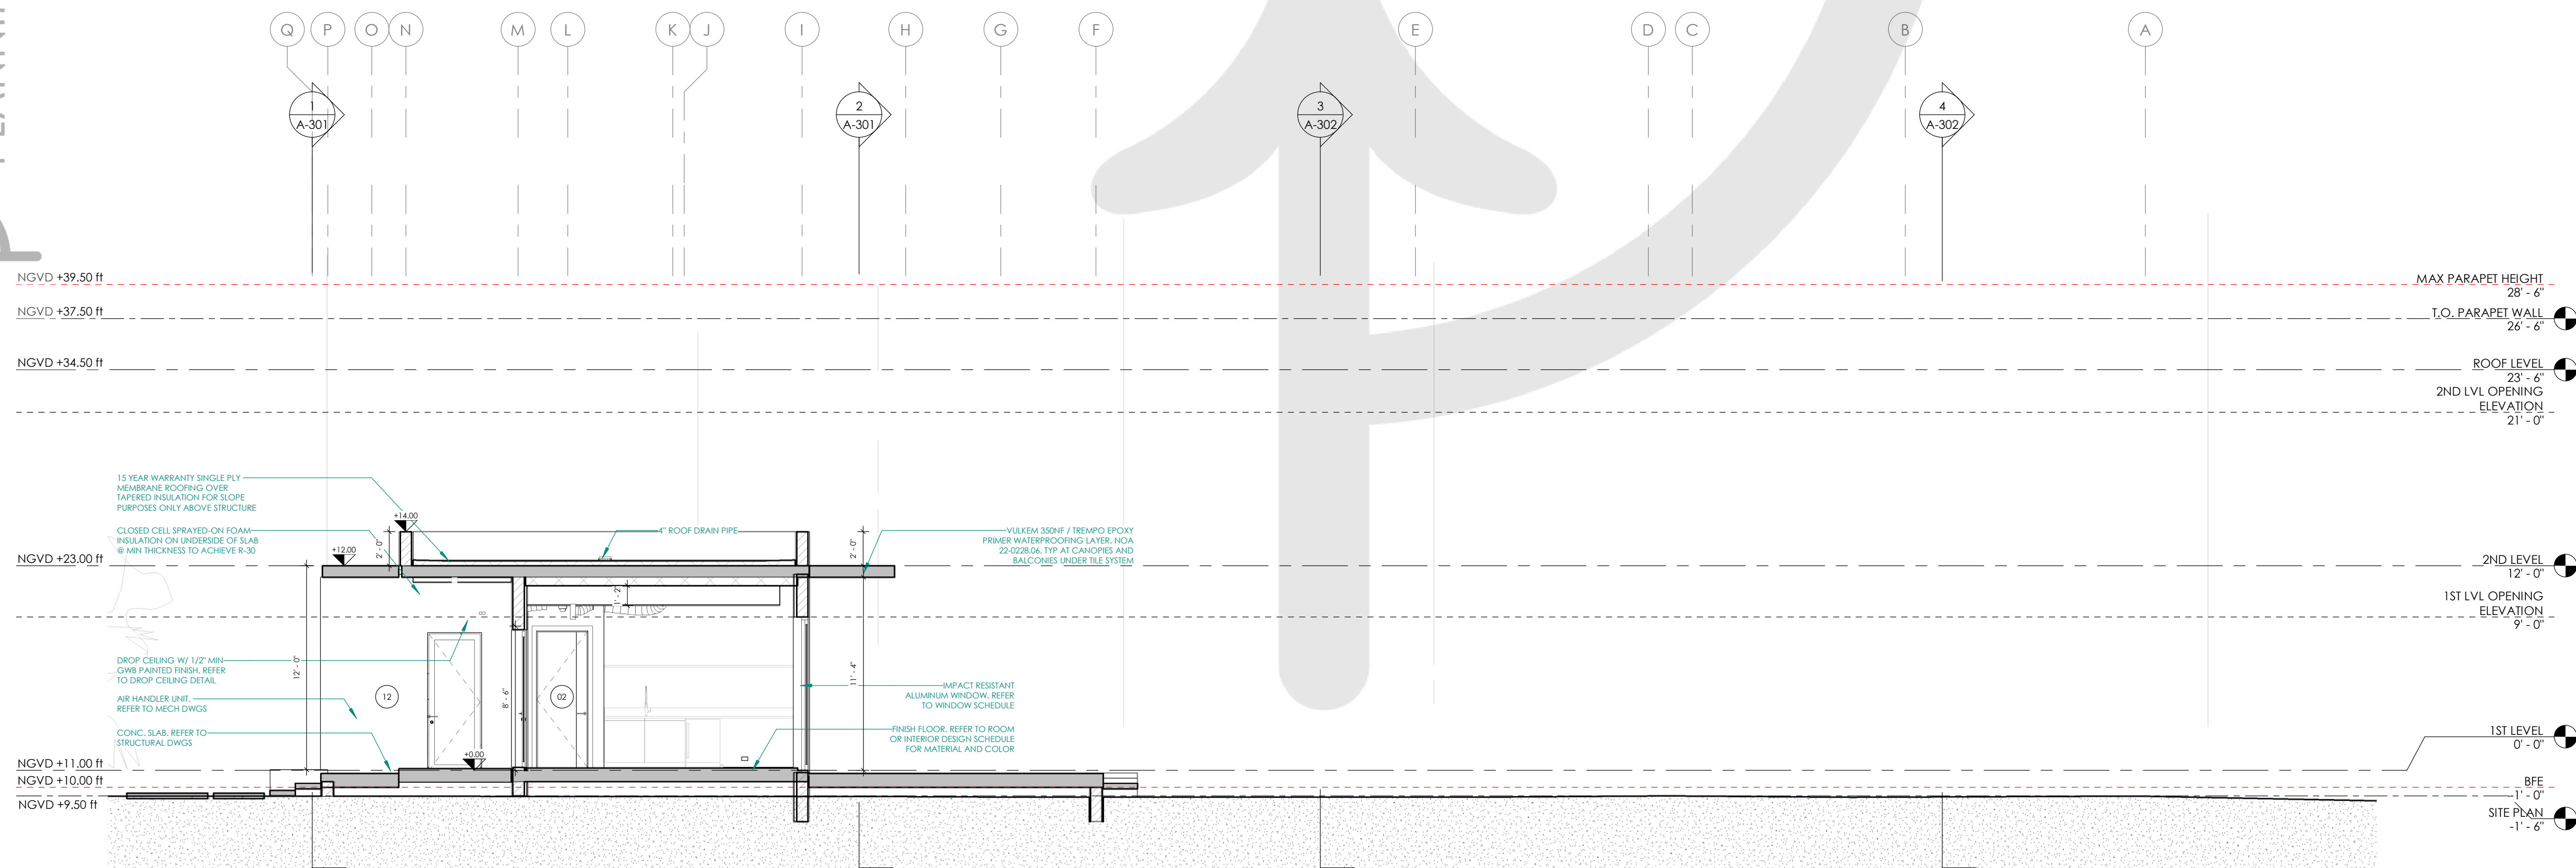

Section 10
3/16" = 1'-0"

ISSUES
MAY 2025
2025-09-11

JOB NO.	#084
DRAWN BY	NS
CHECKED BY	MD
SCALE	AS NOTED
FIRM LICENSE	AA 26003995

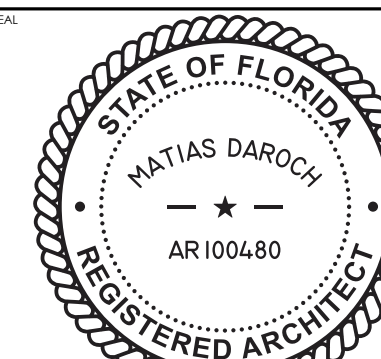


THIS IS A DIGITALLY SIGNED SHEET. PRINTED COPIES OF THIS DOCUMENT ARE CONSIDERED SIGNED AND SEALED AND THE SIGNATURE MUST BE VERIFIED ANY ELECTRONIC COPIES.

THE CONTENT OF THIS SHEET AND ALL OTHER DRAWINGS ISSUED IN THIS SET PROTECTED BY U.S. AND INTERNATIONAL COPYRIGHT LAWS. REPRODUCTION USE WITHOUT PROPER WRITTEN CONSENT IS PROHIBITED BY LAW. SEE A-001 DETAILS


A-305

SECTIONS

BL2025-0584 APPROVED
vwaiters02/11/20262:38:21 PM

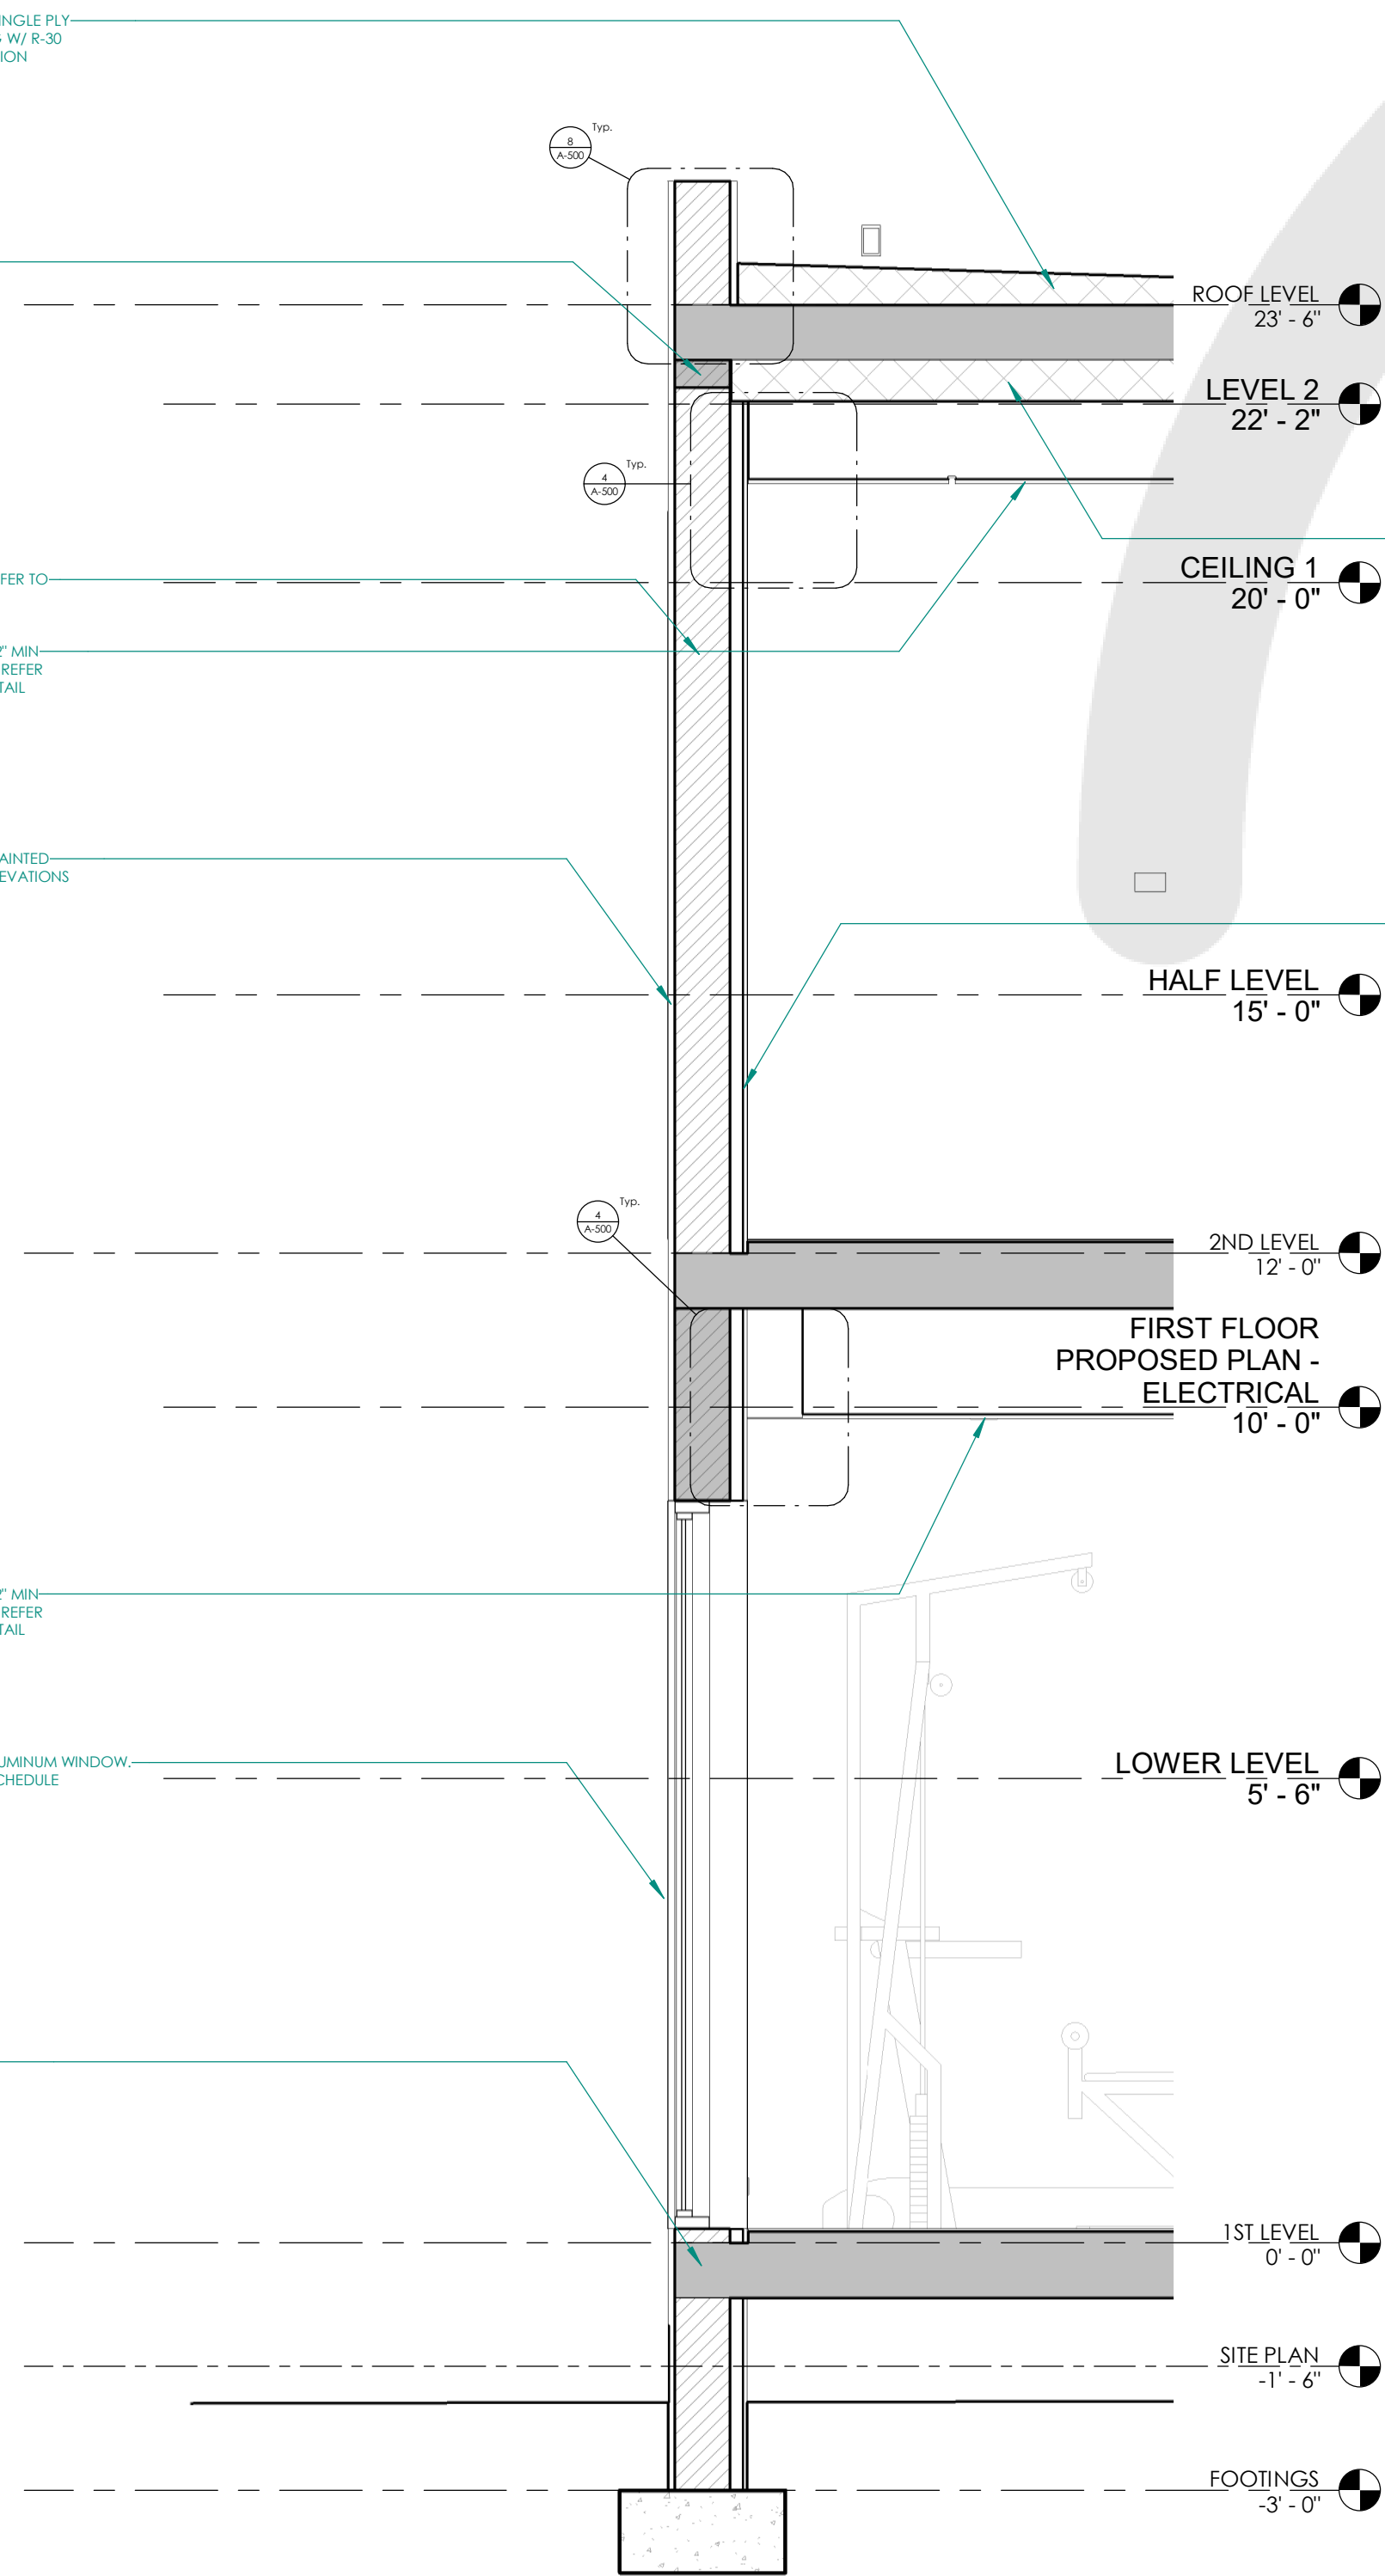

WALL SECTION 1
1/2" = 1'-0"

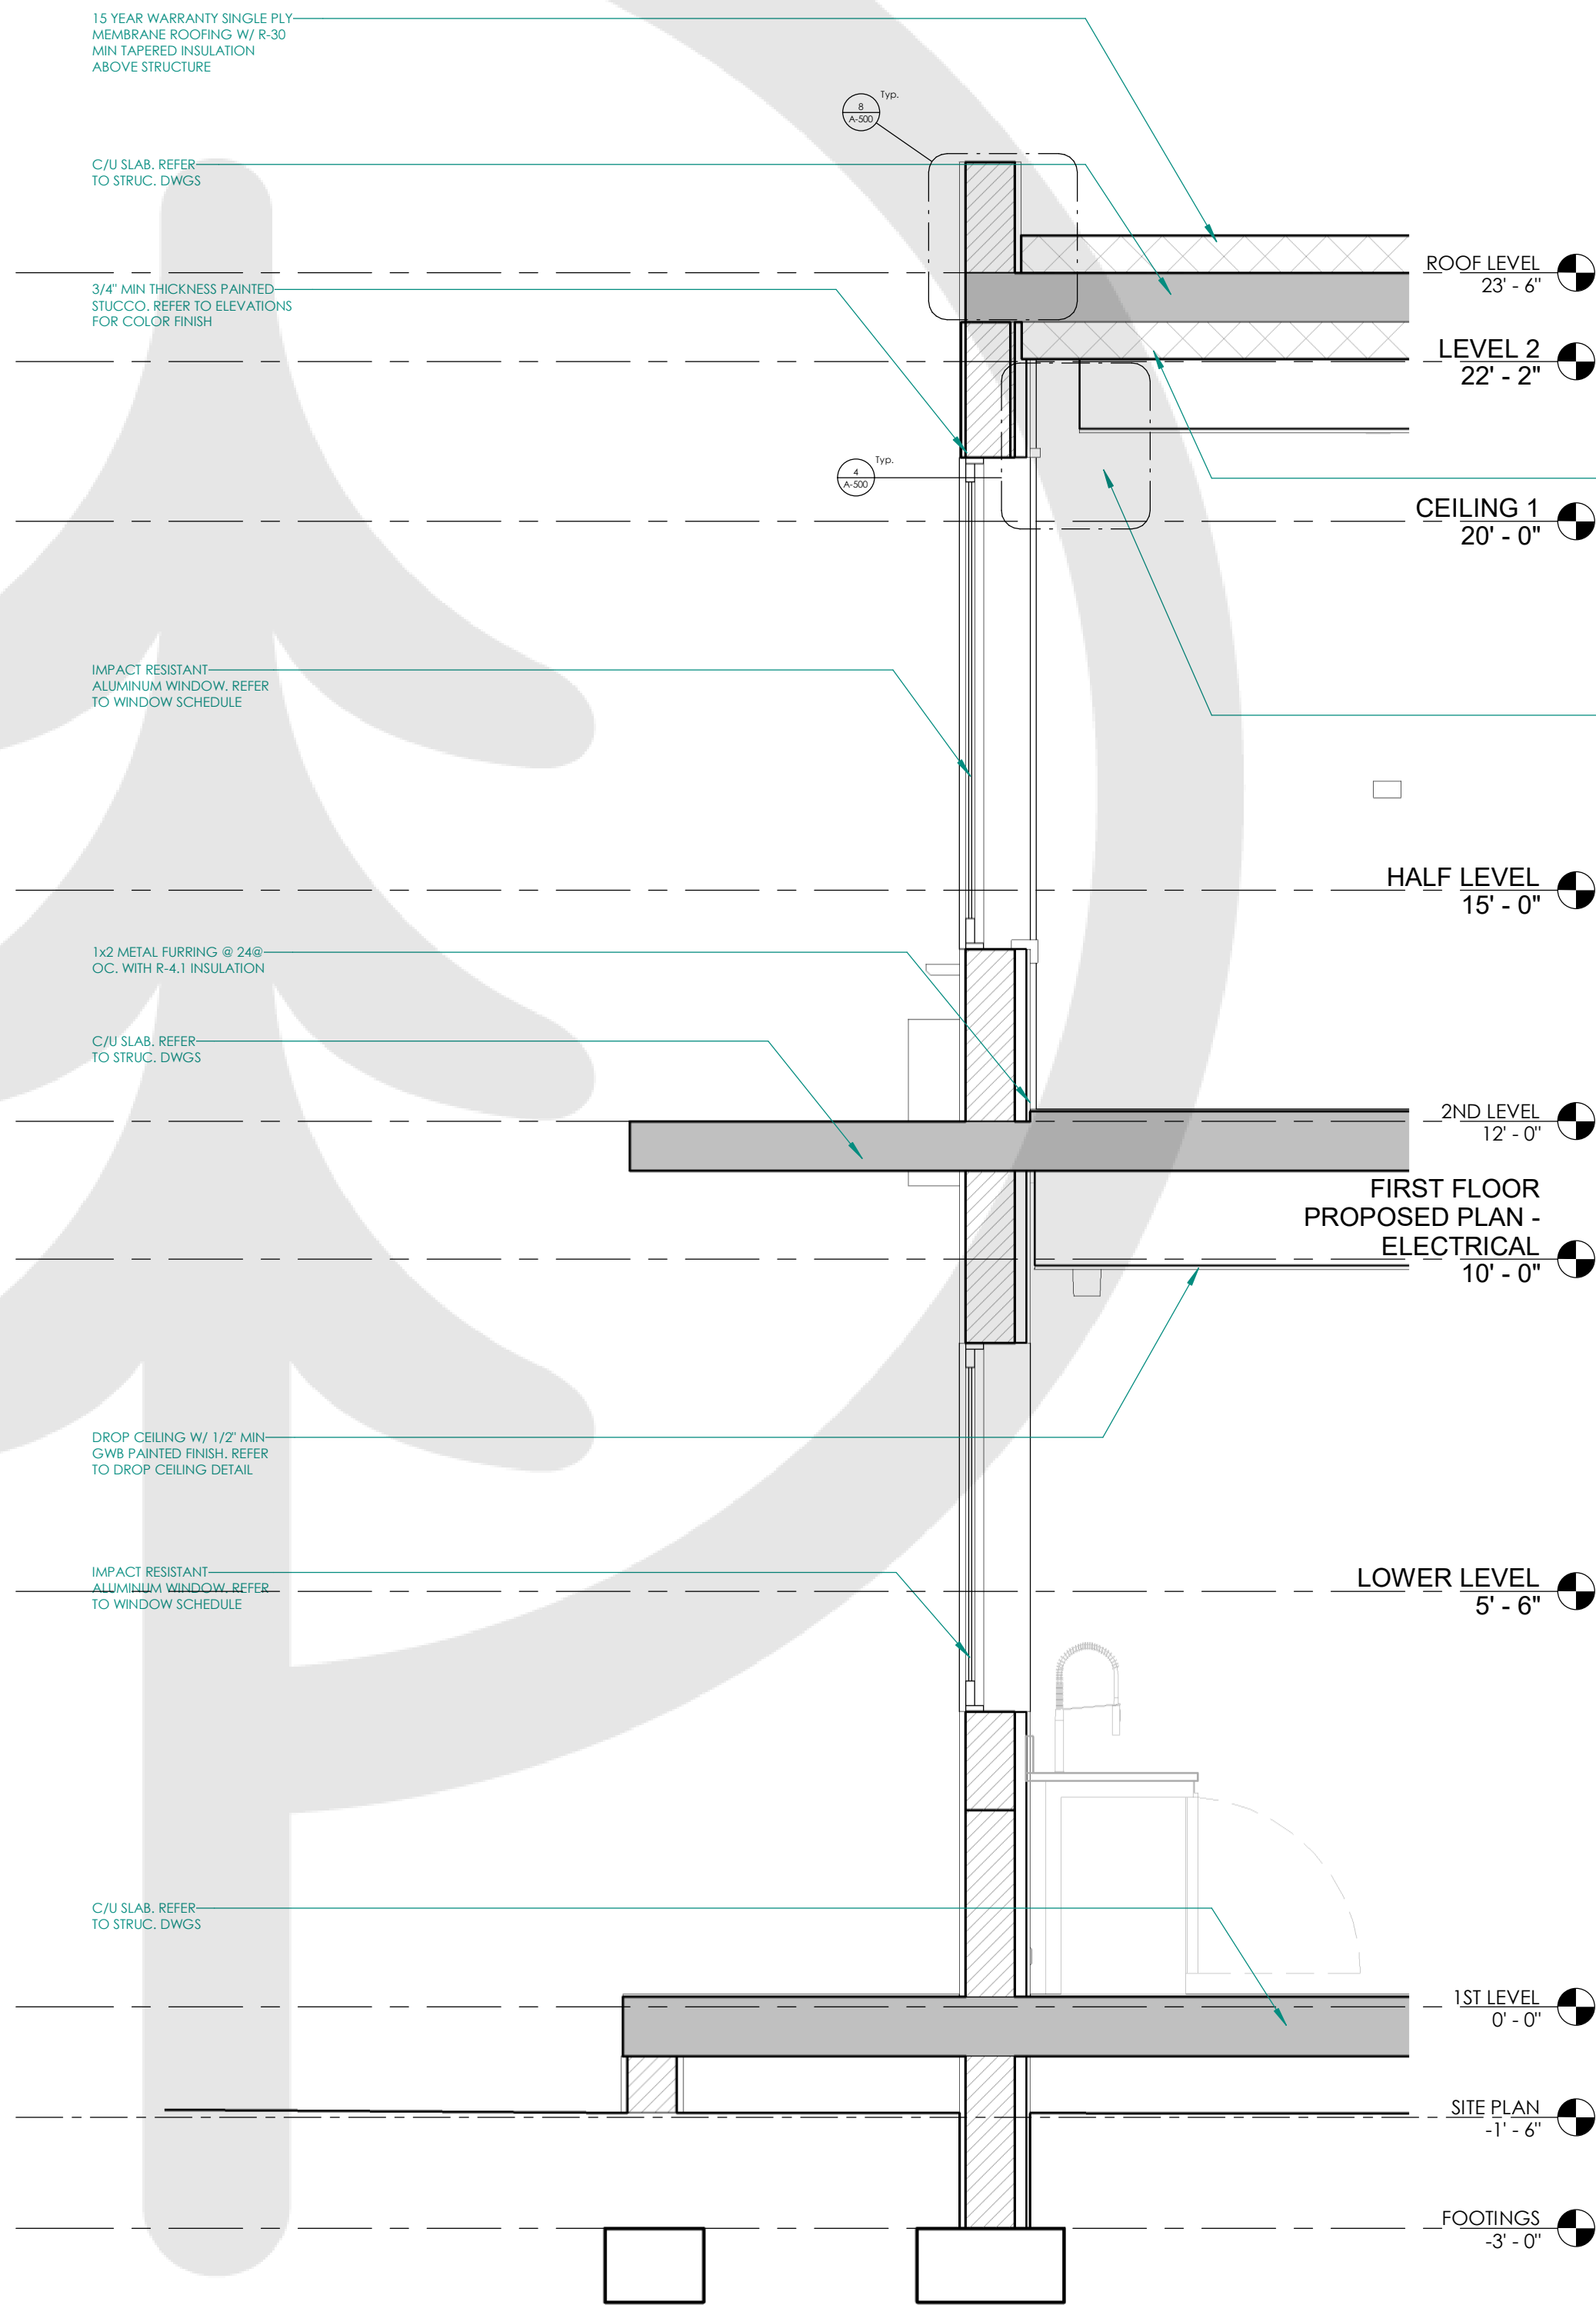

WALL SECTION 2
1/2" = 1'-0"



MIK ARCHITECTURE LLC
MATIAS DAROCH
AR 100480
1383 CORAL WAY, SUITE 202
MIAMI, FLORIDA 33145
+1 786 758 0882
miki@mikarch.com




AGD DEVELOPERS LLC
1383 CORAL WAY, SUITE 202
MIAMI, FLORIDA 33145
agdmiami.com
developers@agdmiami.com

NEW CONSTRUCTION
AGD CALISTONE LLC
10840 SW 67 AVE MIAMI, FL 33156

ISSUES	MAY 2025	1ST ISSUED
▲		
▲		
JOB NO.	#084
DRAWN BY	NS
CHECKED BY	MD
SCALE	AS NOTED
FROM LICENSE	AA 26003995
SIN.	

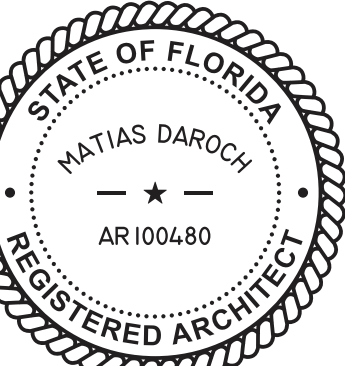

THIS IS A DIGITALLY SIGNED FILE. THE CONTENTS OF THIS DOCUMENT ARE NOT CONSIDERED SIGNED AND SEALED AND THE SIGNATURE MUST BE VERIFIED ON ANY DIGITALLY SIGNED FILE.

THE CONTENT OF THIS SHEET AND ALL OTHER DRAWINGS ISSUED BY THE SET ARE PROTECTED BY U.S. AND INTERNATIONAL COPYRIGHT LAWS. REPRODUCTION OR USE WITHOUT PROPER WRITTEN CONSENT IS PROHIBITED BY LAW. SEE ALSO FOR DETAILS.

SHEET NO.

A-306

WALL SECTIONS

1/21/2025 12:59 PM

BL2025-0584 APPROVED
waite02/11/2024 6:28:21 PM

STAIR CALLOUT - 1ST LEVEL

1/4" = 1'-0"

1

STAIR CALLOUT - 2ND LEVEL

1/4" = 1'-0"

2

TYP. RAILING & GUARDRAIL DIM.

1" = 1'-0"

7

TYP. HANDRAIL

N.T.S.

8

STAIR SECTION

1/4" = 1'-0"

3

STAIR SECTION

1/4" = 1'-0"

4

STAIR SECTION

1/4" = 1'-0"

5

3D

6



MIK ARCHITECTURE LLC
MATIAS DAROCH
AR 100480
1383 CORAL WAY, SUITE 202
MIAMI, FLORIDA 33146
+1 786 758 5882
miki@mikarch.com



AGD DEVELOPERS LLC
1383 CORAL WAY, SUITE 202
MIAMI, FLORIDA 33146
agdmiami.com
developers@agdmiami.com

NEW CONSTRUCTION
AGD CALISTONE LLC
10840 SW 67 AVE MIAMI, FL 33156

ISSUES MAY 2025 1ST ISSUED



JOB NO. #084


DRAWN BY NS

CHECKED BY MD

SCALE AS NOTED

FROM AA 26003995

SEP

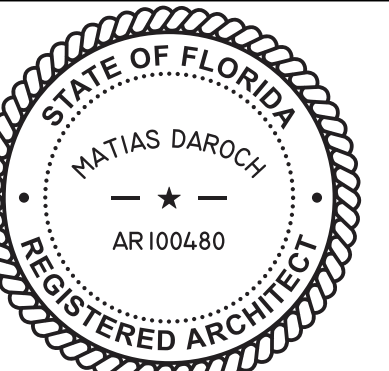

THIS IS A DIGITALLY SIGNED FILE. THE CONTENTS OF THIS DOCUMENT ARE NOT
CONSIDERED SIGNED AND SEALED AND THE SIGNATURE MUST BE VERIFIED ON
THE ORIGINAL COPY.
THE CONTENT OF THIS SHEET AND ALL OTHER DRAWINGS ISSUED BY THE SET ARE
PROTECTED BY U.S. AND INTERNATIONAL COPYRIGHT LAWS. REPRODUCTION OR
USE WITHOUT PROPER WRITTEN CONSENT IS PROHIBITED BY LAW. SEE ALSO FOR
DETAILS.
SHEET NO.

A-401

STAIR CALLOUT

BL2025-0584 APPROVED
vwaiters02/11/2026 2:38:21 PM

PINECREST
BUILDING
PLANNING



PARTITION WALL ACCORDING TO
PLANS & WALL SCHEDULE
1/2" CEMENTITIOUS BOARD
TILE FINISH
CONT. CAULKING @ TUB
1x4 WD. STRINGER ATTACHED TO STUDS

BATHTUB TO BE SELECTED BY OWNER.
INSTALL ACCORDING TO MANUF.
INSTRUCTIONS
1 1/2" POLYSTYRENE UNDERLAYMENT
UNDER TUB U.O.N. BY MANUFACTURER
STRUCTURAL FLOOR
REFER TO STRUCT. PLANS

TYP. BATHTUB DETAIL ①
1 1/2" = 1'-0"

FINISH FLOORING, REFER TO
ROOM SCHEDULE
SUBFLOOR, REFER TO ROOM
SCHEDULE
FLOOR STRUCTURE, REFER TO
STRUCTURAL PLANS
WALL PARTITION OR STRUCT. WALL
REFER TO WALL SCHEDULE AND ARCH.
FLOOR PLANS
5/8" GWB, ATTACHED TO PARTITION OR
WALL FURRING
1" x 6" TYP. VINYL OR WOOD
BASEBOARD, INSTALL AS PER
MANUFACTURER INSTRUCTIONS

TYP. BASEBOARD WOOD DETAIL ⑤
1 1/2" = 1'-0"

CAT II SAFETY GLASS
MAX
Ø 1"
36" MIN
TO FINISH FLOOR
4" MIN. TO PANEL EDGE
Ø 2" MAX.
STAINLESS STEEL
TALON SPIGOT

TYP. GUARDRAIL RESIDENTIAL GLASS ⑨
1 1/2" = 1'-0"

20"
MIN. NET CLEAR WIDTH
24"
MIN. NET CLEAR HEIGHT
24" TO 44"
SEL. HEIGHT
TOP OF FINISH FLOOR
NET CLEAR OPENING SHOULD
RESULT FROM NORMAL
OPERATION OF THE WINDOW.
EMERGENCY ESCAPE AND
RESCUE OPENINGS ARE TO
HAVE A MINIMUM NET CLEAR
OPENING OF 5.7 SF. GRADE
FLOOR OPENINGS MAY BE
REDUCED IN NET AREA TO 5 SF.

TYP. EGRESS WINDOW DETAIL ②
1" = 1'-0"

FINISH FLOORING
SUBFLOORING
5/8" GWB ATTACHED TO
PARTITION OR FURRING
1x4 TYP. VINYL OR WOOD BASEBOARD

TYP. BASEBOARD REGLET DETAIL ⑥
1 1/2" = 1'-0"

5/8" PLYWOOD
5/8" GYPSUM
METAL STUD FURRING
20" MIN.
5" TO 180X
FROM FFE

TYP. BACKING DETAIL ⑩
3" = 1'-0"

3/4" SHELL REEF SLAB, BRUSHED
FINISH
CONCRETE SLAB & STAIRS
(REFER TO STRUCT. DETAILS)
1'-0" 1'-0"
5 ML VAPOR BARRIER SHEET TO BE
PLACED CONTINUOUSLY UNDER
CONCRETE SLAB
98% COMPACTED
CLEAN FILL

TYP. STEPS EXTERIOR TERRACE ③
N.T.S.

3/4" SHELL REEF SLAB, BRUSHED
FINISH
CONCRETE SLAB & STAIRS
(REFER TO STRUCT. DETAILS)
5 ML VAPOR BARRIER SHEET TO BE
PLACED CONTINUOUSLY UNDER
CONCRETE SLAB
98% COMPACTED
CLEAN FILL

TYP. STEPS INTERIOR ⑦
1 1/2" = 1'-0"

CONCRETE SLAB, REFER TO
STRUCTURAL PLANS.
STUCCO 3/4" WIDTH
METAL STUD ATTACHED W/
TWO 1/2" MIN. SCREWS TO
TRACK ON EACH SIDE
PLASTIC COMPONENTS
ULTRA-TRAC 708-75 OR SIMILAR
3/4" x 3/4"

TYP. DRIP EDGE ⑪
1 1/2" = 1'-0"

8" MIN.
VAPOR BARRIER TO NOT PLANS

TYP. CURTAIN POCKET DETAIL ④
1 1/2" = 1'-0"

SLOPE TO INSIDE
PARAPET WALL
STUCCO FINISH
STUCCO STOP
METAL TERMINATION BAR
BASE FLASHING MEMB. FASTENED
THROUGH TERMINATION BAR
CANT STRIP
COUNTER FLASHING
ROOF MEMB.
VAPOR BARRIER
REFER TO ROOF PLAN
ROOF INSULATION
ROOF STRUCTURE

TYP. PARAPET WALL FLASHING ⑧
1 1/2" = 1'-0"

MIK
ARCHITECTURE

MIK ARCHITECTURE LLC
MATIAS DAROCH
AR 100480
1383 CORAL WAY, SUITE 202
MIAMI, FLORIDA 33147
+1 786 758 0882
mik@mikarch.com

AGD

AGD DEVELOPERS LLC
1383 CORAL WAY, SUITE 202
MIAMI, FLORIDA 33147
agdmiami.com
developers@agdmiami.com

NEW CONSTRUCTION
AGD CALISTONE LLC
10840 SW 67 AVE MIAMI, FL 33156

ISSUES
MAY 2025 1ST ISSUED



JOB NO. #084
DRAWN BY AA
CHECKED BY MD
SCALE AS NOTED
FROM AA 26003995
DATE




THIS IS A DIGITAL E-SIGNED SEAL. THE PRINTED COPIES OF THIS DOCUMENT ARE NOT
CONSIDERED SIGNED AND SEALED AND THE SIGNATURE SHOULD BE VERIFIED ON
THE ORIGINAL DOCUMENT.
THE CONTENT OF THIS SHEET AND ALL OTHER DRAWINGS ISSUED BY THE SET ARE
PROTECTED BY U.S. AND INTERNATIONAL COPYRIGHT LAWS. REPRODUCTION OR
USE WITHOUT PROPER WRITTEN CONSENT IS PROHIBITED BY LAW. SEE ALSO FOR
DETAILS.
SHEET NO.

A-500

TYP. DETAIL


12/11/2025 12:35:55 PM

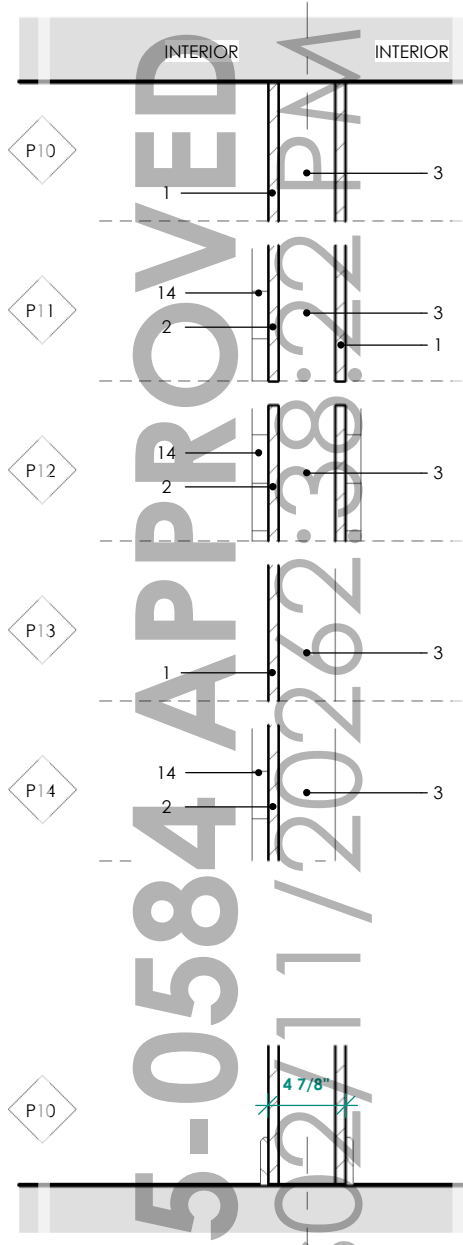


TYP. 4\"/>

FOR 1 HOUR FIRE RATING (FR.1HR) PARTITION COMPLY WITH ANSUL 263 DESIGN ASSEMBLY No. U465. ONLY APPLICABLE FOR P10.

FOR 1 HOUR FIRE RATING (FR.1HR) PARTITION IN WET AREAS COMPLY WITH ANSUL 263 DESIGN ASSEMBLY No. U433. ONLY APPLICABLE FOR P11 & P12.

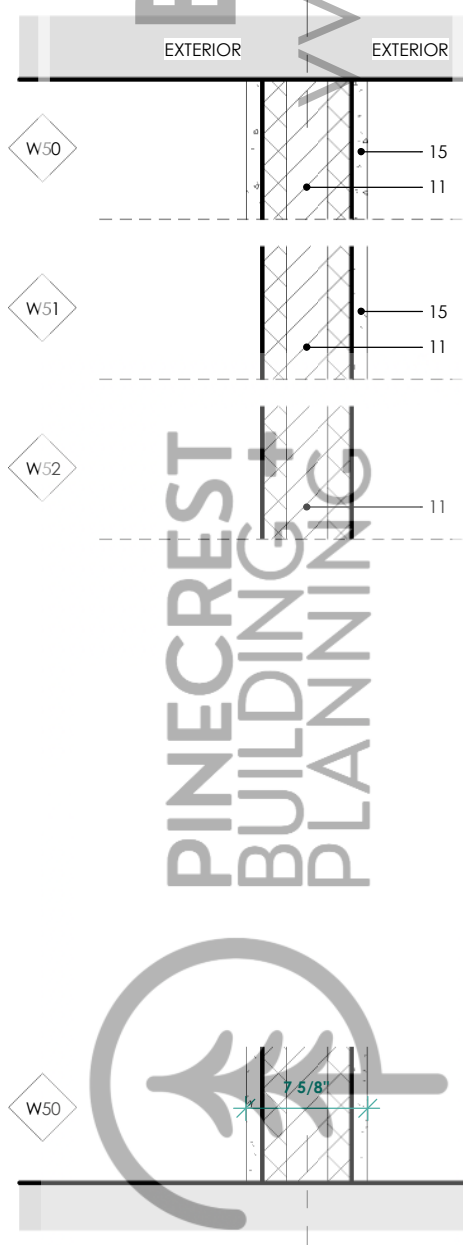


TYP. 6\"/>

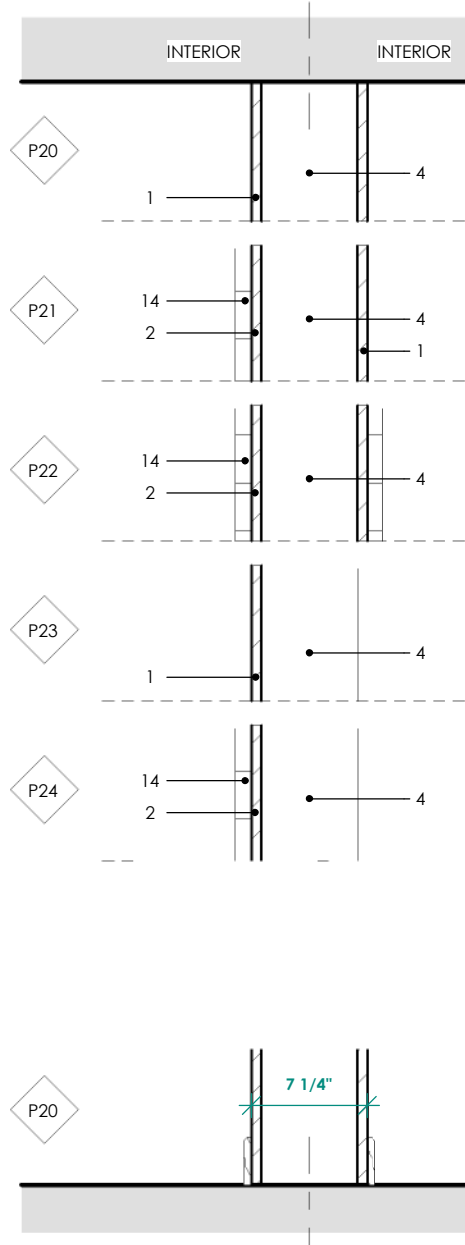

TYP. 6\"/>


FOR 1 HOUR FIRE RATING (FR.1HR) PARTITION COMPLY WITH ANSUL 263 DESIGN ASSEMBLY No. U465. ONLY APPLICABLE FOR P20.

FOR 1 HOUR FIRE RATING (FR.1HR) PARTITION IN WET AREAS COMPLY WITH ANSUL 263 DESIGN ASSEMBLY No. U433. ONLY APPLICABLE FOR P21 & P22.

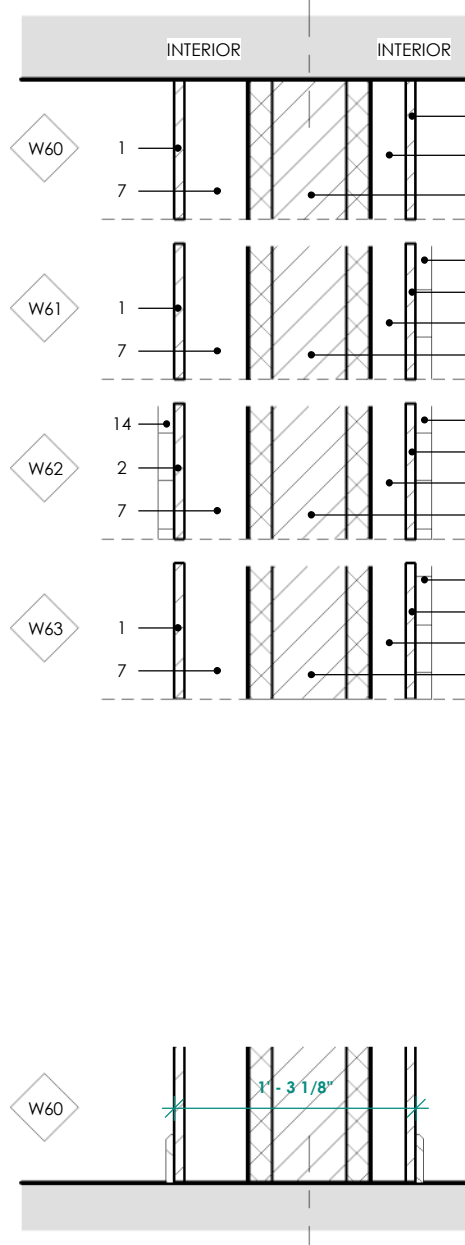


TYP. 8\"/>

FOR 2 HOUR FIRE RATING (FR.2HR) BEARING WALL COMPLY WITH ANSUL 263 DESIGN ASSEMBLY No. U910.

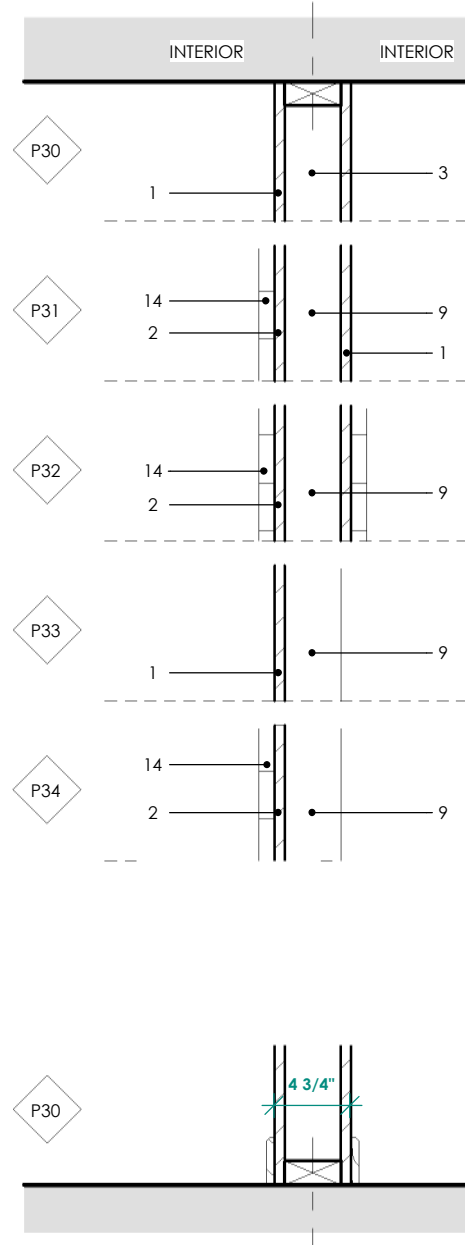


TYP. 4\"/>

FOR 1 HOUR FIRE RATING (FR.1HR) PARTITION COMPLY WITH ANSUL 263 DESIGN ASSEMBLY No. U209. ONLY APPLICABLE FOR P30, P31 & P32.

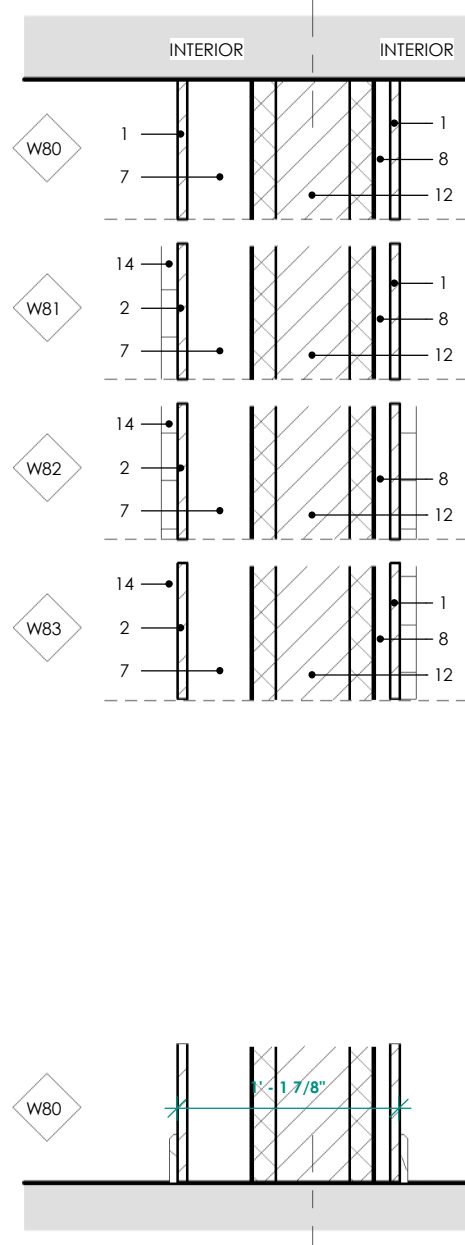


TYP. 8\"/>

FOR 2 HOUR FIRE RATING (FR.2HR) BEARING WALL COMPLY WITH ANSUL 263 DESIGN ASSEMBLY No. U910.

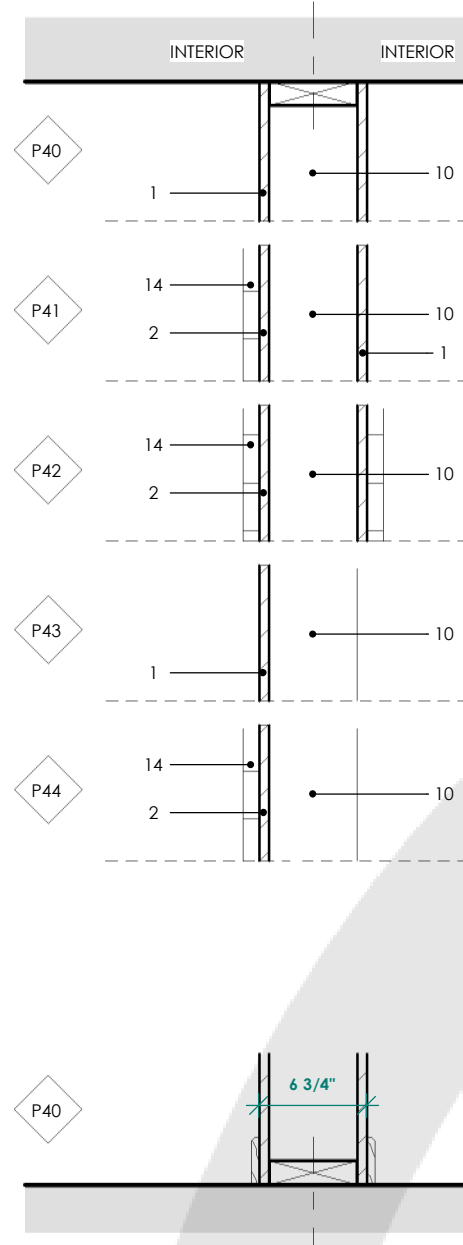


TYP. 6\"/>

FOR 1 HOUR FIRE RATING (FR.1HR) PARTITION COMPLY WITH ANSUL 263 DESIGN ASSEMBLY No. U209. ONLY APPLICABLE FOR P40, P41 & P42.

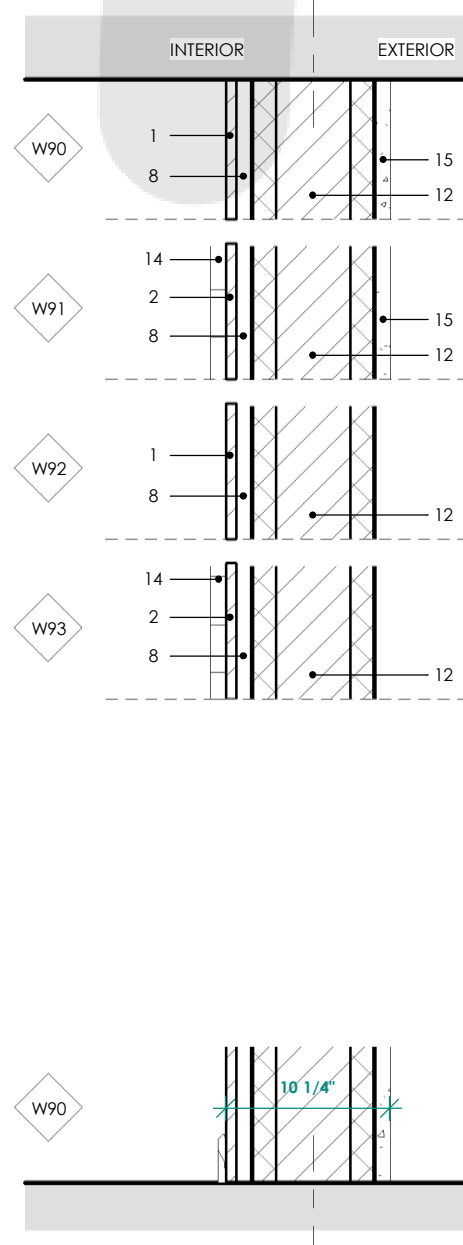


TYP. 8\"/>

FOR 2 HOUR FIRE RATING (FR.2HR) BEARING WALL COMPLY WITH ANSUL 263 DESIGN ASSEMBLY No. U906.

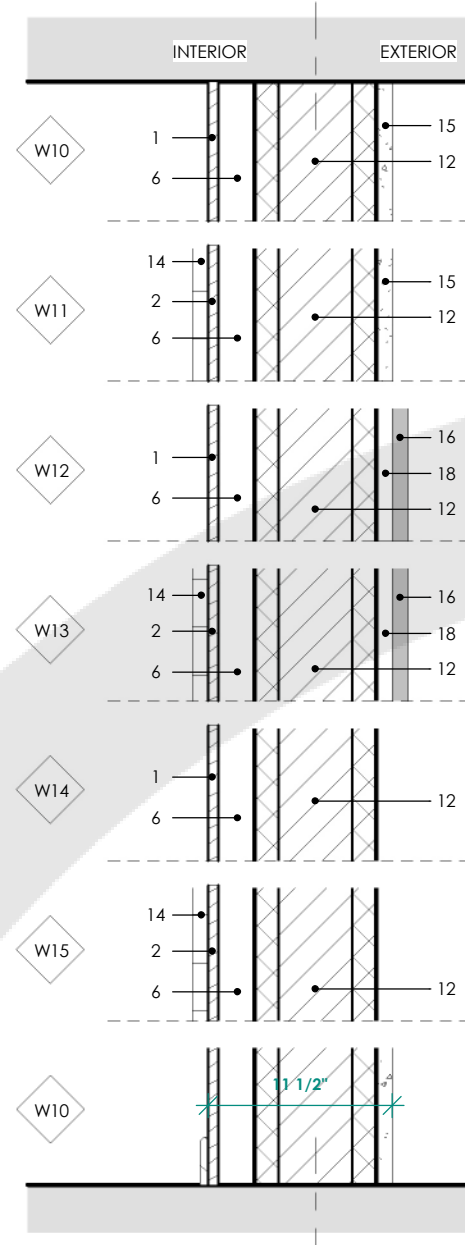


TYP. 8\"/>

FOR 2 HOUR FIRE RATING (FR.2HR) BEARING WALL COMPLY WITH ANSUL 263 DESIGN ASSEMBLY No. U906.

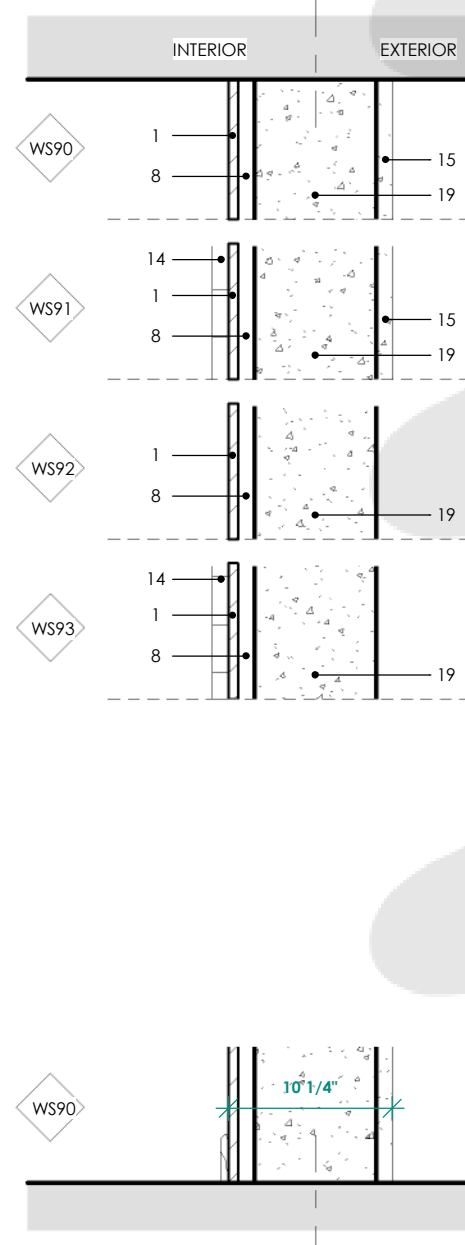


TYP. 8\"/>

FOR 2 HOUR FIRE RATING (FR.2HR) BEARING WALL COMPLY WITH ANSUL 263 DESIGN ASSEMBLY No. U906.

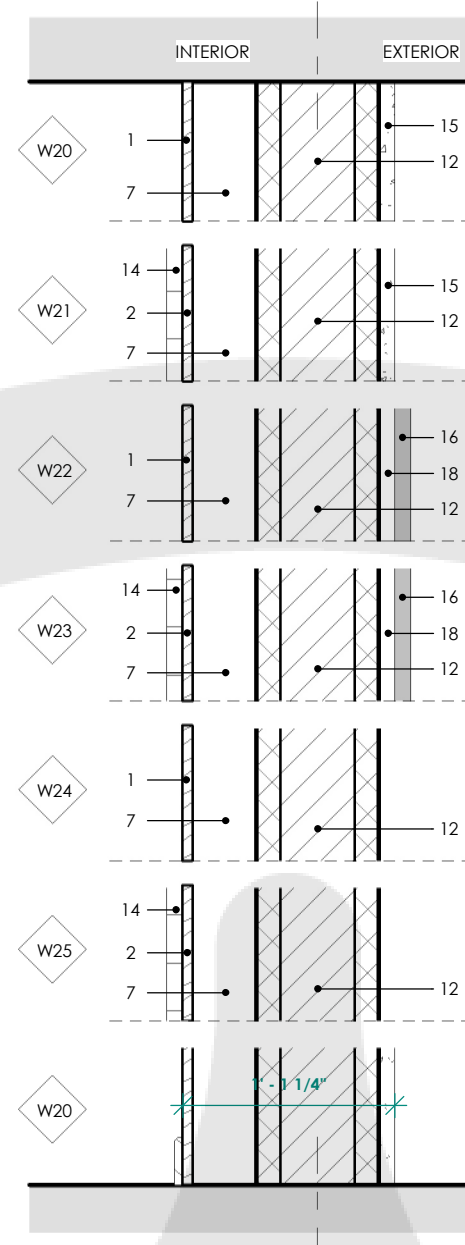


TYP. 8\"/>

FOR 2 HOUR FIRE RATING (FR.2HR) BEARING WALL COMPLY WITH ANSUL 263 DESIGN ASSEMBLY No. U906.

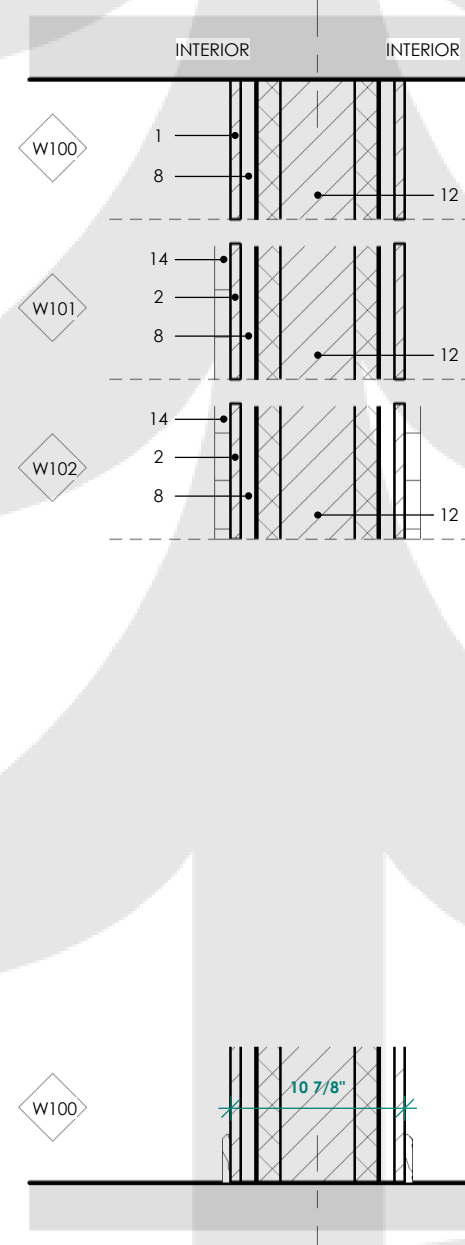


TYP. 8\"/>

FOR 2 HOUR FIRE RATING (FR.2HR) BEARING WALL COMPLY WITH ANSUL 263 DESIGN ASSEMBLY No. U910.

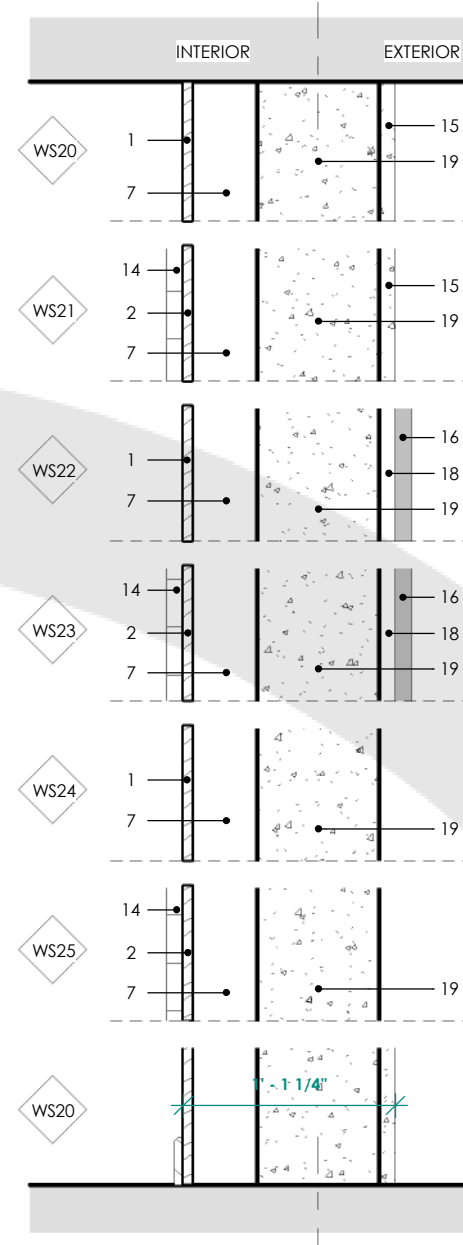


TYP. 8\"/>

FOR 2 HOUR FIRE RATING (FR.2HR) BEARING WALL COMPLY WITH ANSUL 263 DESIGN ASSEMBLY No. U906.

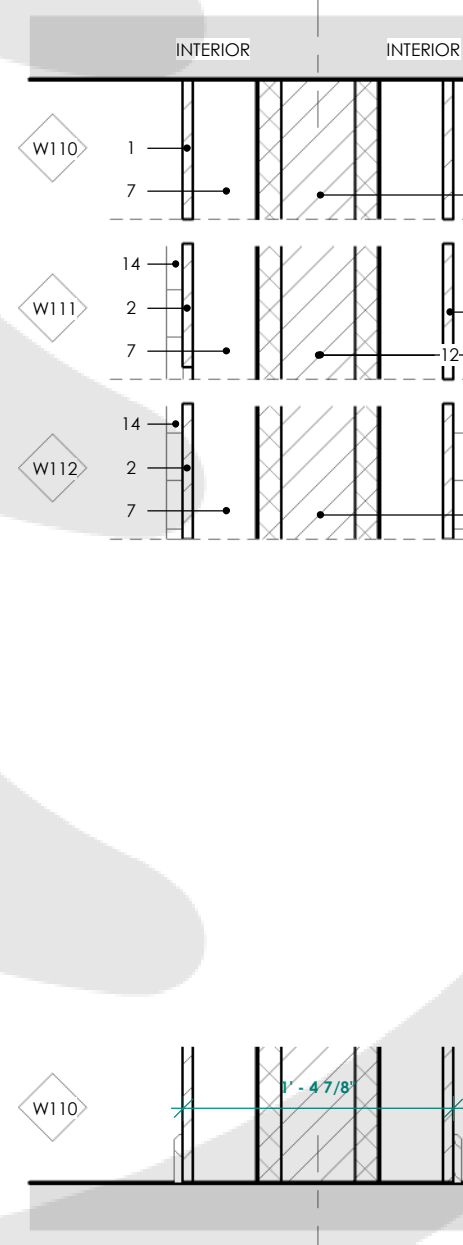

TYP. 8\"/>

FOR 2 HOUR FIRE RATING (FR.2HR) BEARING WALL COMPLY WITH ANSUL 263 DESIGN ASSEMBLY No. U910.

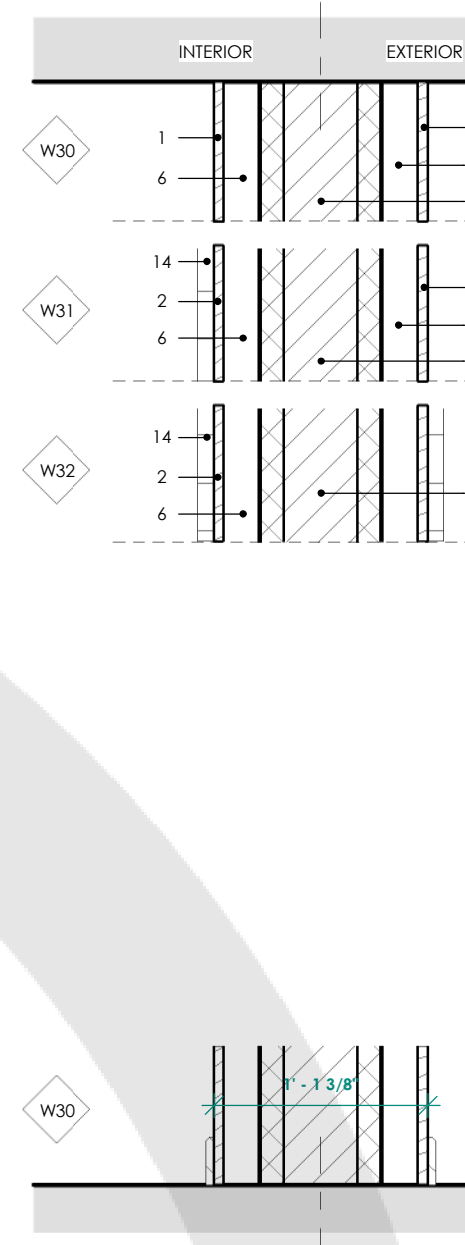


TYP. 8\"/>

FOR 2 HOUR FIRE RATING (FR.2HR) BEARING WALL COMPLY WITH ANSUL 263 DESIGN ASSEMBLY No. U906.




TYP. 8\"/>

FOR 2 HOUR FIRE RATING (FR.2HR) BEARING WALL COMPLY WITH ANSUL 263 DESIGN ASSEMBLY No. U910.

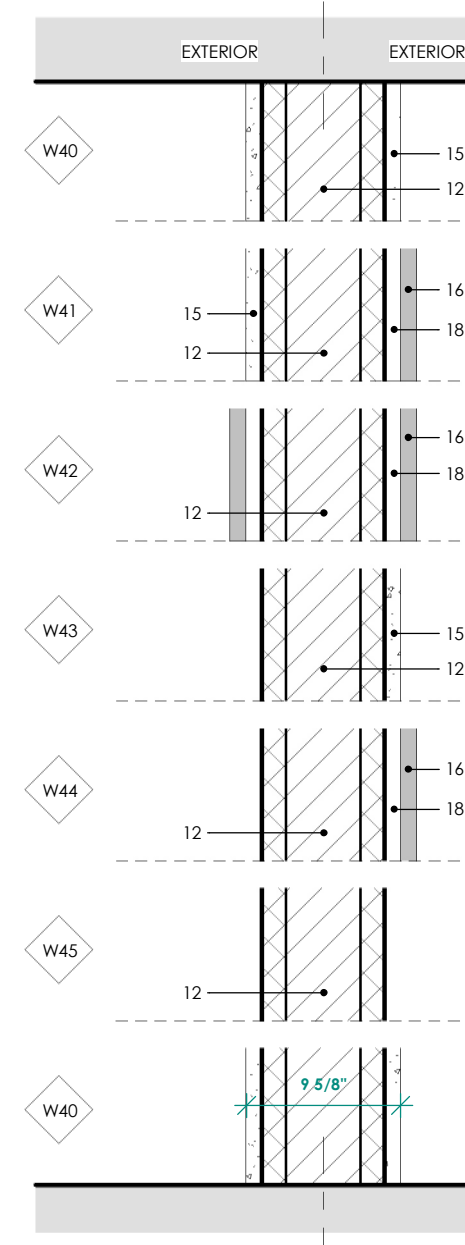


TYP. 8\"/>

FOR 2 HOUR FIRE RATING (FR.2HR) BEARING WALL COMPLY WITH ANSUL 263 DESIGN ASSEMBLY No. U906.

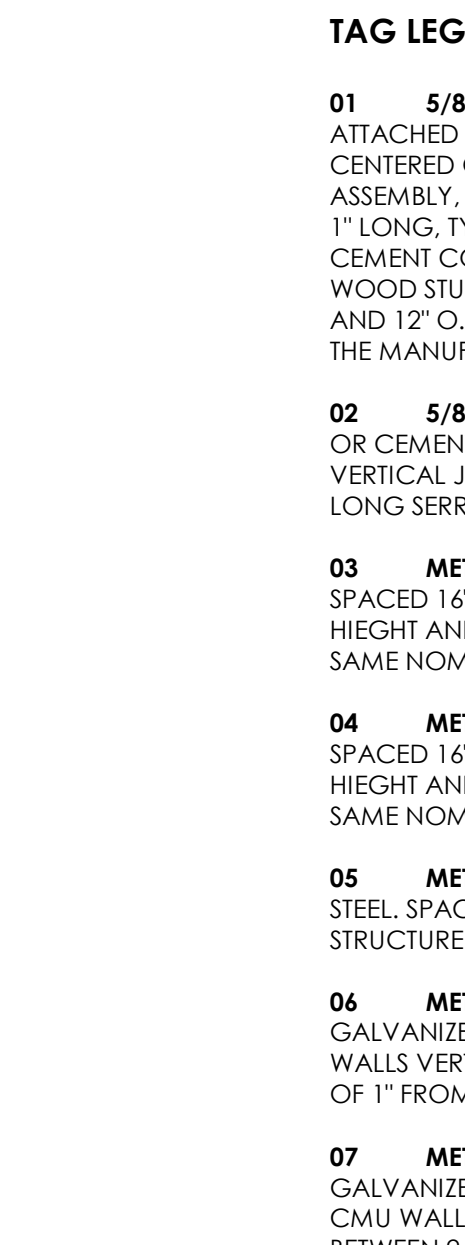


TYP. 8\"/>

FOR 2 HOUR FIRE RATING (FR.2HR) BEARING WALL COMPLY WITH ANSUL 263 DESIGN ASSEMBLY No. U910.

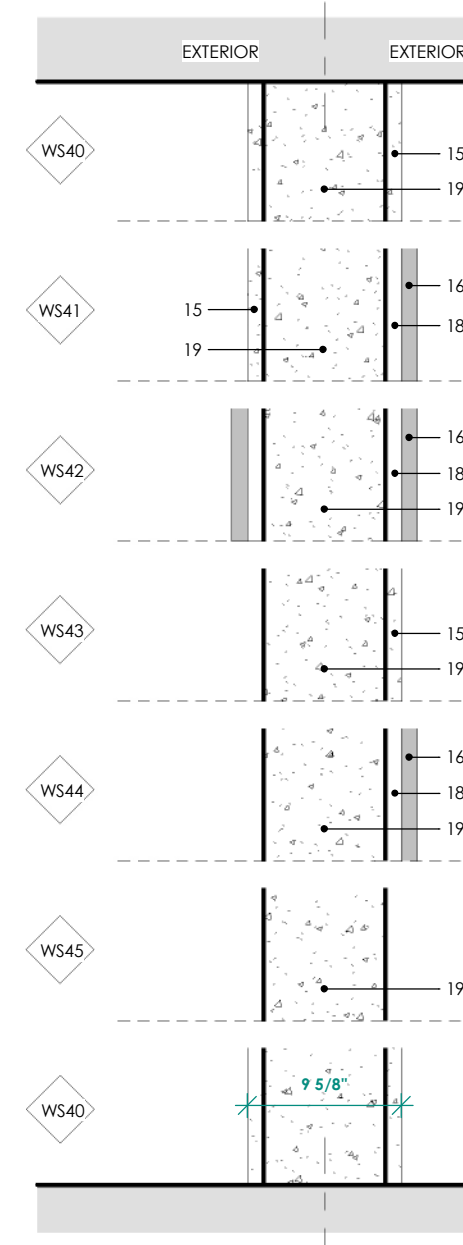


TYP. 8\"/>

FOR 2 HOUR FIRE RATING (FR.2HR) BEARING WALL COMPLY WITH ANSUL 263 DESIGN ASSEMBLY No. U906.

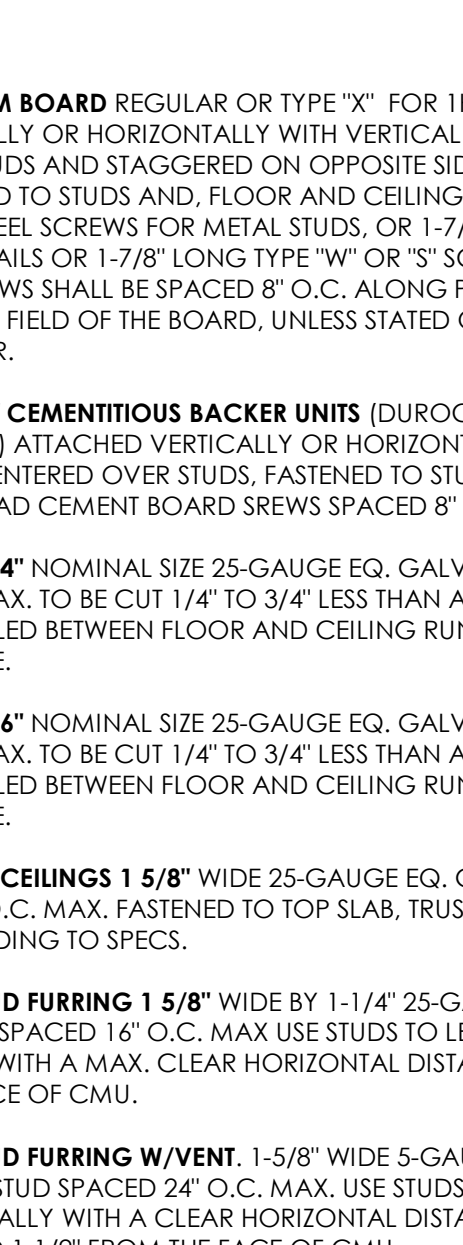

TYP. 8\"/>


FOR 2 HOUR FIRE RATING (FR.2HR) BEARING WALL COMPLY WITH ANSUL 263 DESIGN ASSEMBLY No. U910.

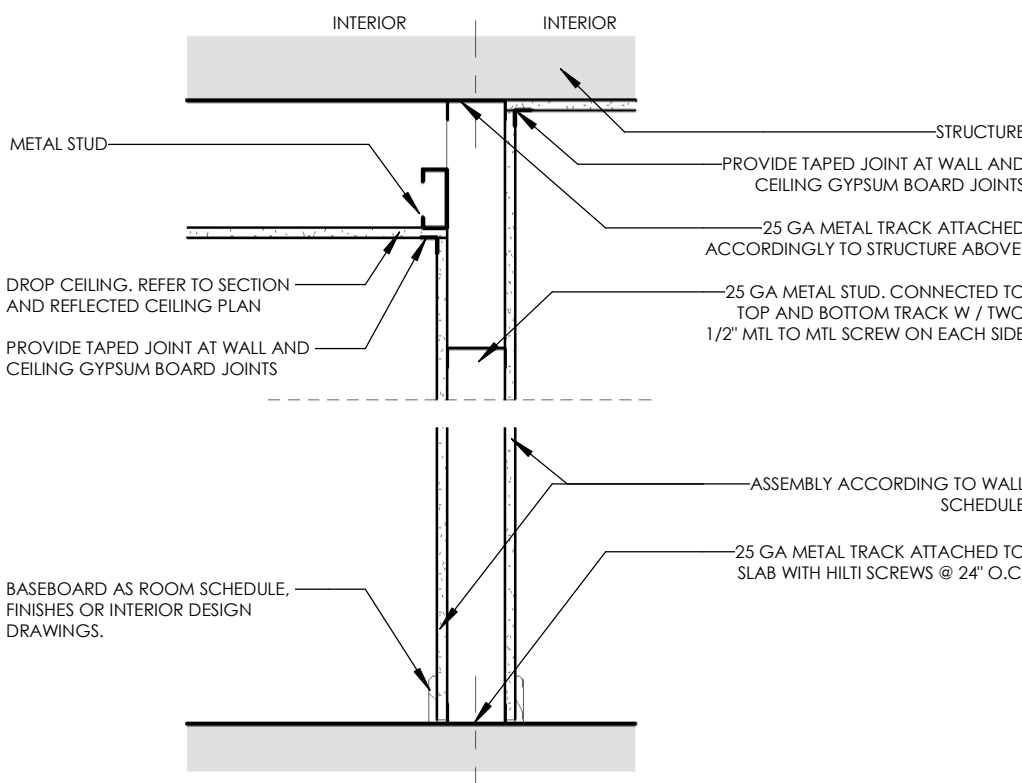

TYP. METAL PARTITION
1\"/>

TAG LEGEND

- 01 5/8\"/>**
- 02 5/8\"/>**
- 03 METAL STUD 4\"/>**
- 04 METAL STUD 6\"/>**
- 05 METAL STUD CEILINGS 1 5/8\"/>**
- 06 METALIC STUD FURRING 1 5/8\"/>**
- 07 METALIC STUD FURRING W/VENT. 1-5/8\"/>**
- 08 WOOD FURRING 2\"/>**
- 09 WOOD STUD 2\"/>**
- 10 WOOD STUD 2\"/>**
- 11 CMU 6\"/>**
- 12 CMU 8\"/>**
- 13 DOBLE CMU 8\"/>**
- 14 TILE / PORCELAIN / STONE. REFER TO SPECS AND INSTALL ACCORDING TO MANUFACTURER RECOMMENDATIONS.**
- 15 STUCCO 1\"/>**
- 16 STONE REFER TO SPECS AND INSTALL ACCORDING TO MANUFACTURER RECOMMENDATIONS.**
- 17 INSULATION 3-1/2\"/>**
- 18 THINSET OR SIMILAR TILE ADHESIVE. INSTALL ACCORDING TO MANUFACTURER RECOMMENDATIONS.**
- 19 CONCRETE WALL 8\"/>**
- 20 PLYWOOD 3/4\"/>**

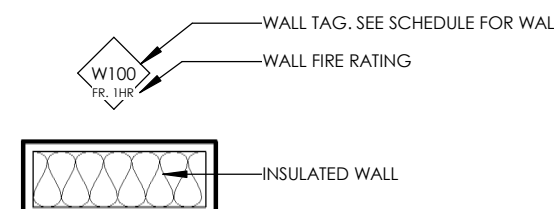


MIK ARCHITECTURE LLC
MATIAS DABOCH
AR 100480
1383 CORAL WAY, SUITE 303
MIAMI, FLORIDA 33147
+1 786 758 5882
miki@mikarch.com



AGD DEVELOPERS LLC
1383 CORAL WAY, SUITE 303
MIAMI, FLORIDA 33147
agdmiami.com
develop@magnam.com

NEW CONSTRUCTION
AGD CALISTONE LLC
10840 SW 67 AVE MIAMI, FL 33156

ISSUES	MAY 2025	137 ISSUED
1		
2		
3		
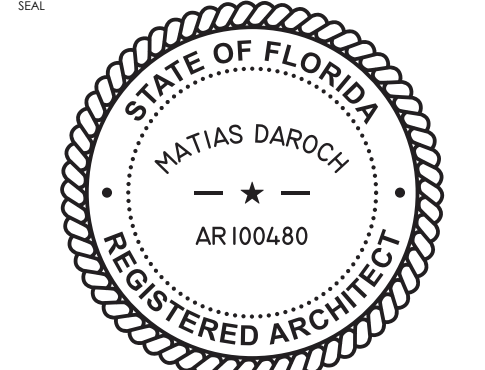

THIS IS A DIGITALLY SIGNED FILE. THE CONTENTS OF THIS DOCUMENT ARE NOT CONSIDERED SIGNED AND SEALED UNTIL THE SIGNATURE IS VERIFIED ON THE SIGNED WORK COPY.

THE CONTENT OF THIS SHEET AND ALL OTHER DRAWINGS ISSUED BY THE SET ARE PROTECTED BY U.S. AND INTERNATIONAL COPYRIGHT LAWS. REPRODUCTION OR USE WITHOUT PROPER WRITTEN CONSENT IS PROHIBITED BY LAW. SEE ALSO FOR DETAILS.

SHEET NO.

A-503

WALL DETAILS

12/1/2025 12:36:08 PM

DOOR SCHEDULE

ID	QTY	ROUGH OPENING R. O. WIDTH R. O. HEIGHT	OPERATION	SHGC	U-FACTOR	N.O.A.	MANUFACTURER	MODEL	REMARKS
01	1	10'-8"	4'-7"				T.B.D	T.B.D	
02	15	3'-3"	8'-1 1/2"				T.B.D	T.B.D	
03	1	3'-1"	8'-1 1/2"				T.B.D	T.B.D	
04	8	2'-11"	8'-1 1/2"				T.B.D	T.B.D	
05	16	VARIES	8'-1 1/2"				T.B.D	T.B.D	
06	1	12'-0"	10'-6"			FL22267.1	ES WINDOWS	ES-SGD2020	
07	2	2'-3"	8'-1 1/2"			N/A	T.B.D	T.B.D	
40	1	4'-4"	8'-2"			16-0617.03	ES WINDOWS	ES-EL300	UNEVEN PANELS
50	1	5'-0"	8'-10"				TATA Doors	TATA Barn Door	
80	1	5'-3"	8'-1 1/2"						
81	1	4'-3"	8'-1 1/2"						
101	1	23'-6"	10'-6"	0.34	1.04	FL22267.1	ES WINDOWS	ES-SGD2020	
103	1	16'-8"	9'-1 1/2"	0.34	1.04	FL22267.1	ES WINDOWS	ES-SGD2020	
104	9	16'-0"	9'-1 1/2"	0.34	1.04	21-0728.01	ES WINDOWS	ES-EL400	
105	2	13'-5"	9'-1 1/2"	0.34	1.04	21-0728.01	ES WINDOWS	ES-EL400	
106	1	12'-0"	9'-1 1/2"			21-0728.01	ES WINDOWS	ES-EL400	
110	4	3'-2"	8'-1"	0.34	1.04	16-0617.03	ES WINDOWS	ES-EL300	FIRE RATED - REFER TO CONSTRUCTION NOTE 16
191	2	18'-0"	9'-0"			22-1108.05	CLOPLY CORP	INSULATED W8 DP46	
527	2	10'-10"	9'-0"			FL22267.1	ES WINDOWS	ES-SGD2020	

WINDOW SCHEDULE

ID	QTY	DIMENSIONS SILL HEIGHT	ROUGH OPENING R.O. WIDTH R. O. HEIGHT	OPERATION	SHGC	U-FACTOR	N.O.A.	MANUFACTURER	MODEL	REMARKS
A	2	84"	32" 26"	FIXED	0.23	0.37	21-0708.03	ES WINDOWS	ES-EL150	CAT II SAFETY GLASS
B	4	130"	56" 30"	FIXED	0.23	0.37	21-0708.03	ES WINDOWS	ES-EL150	CAT II SAFETY GLASS
C	6	0"	50" 108"	FIXED	0.23	0.37	21-0708.03	ES WINDOWS	ES-EL150	CAT II SAFETY GLASS
D	4	42"	56" 68"	FIXED	0.23	0.37	21-0708.03	ES WINDOWS	ES-EL150	CAT II SAFETY GLASS
E	2	44"	61" 66"	FIXED	0.23	0.37	21-0708.03	ES WINDOWS	ES-EL150	CAT II SAFETY GLASS
F	2	VARIES	56" 118"	FIXED	0.23	0.37	21-0708.03	ES WINDOWS	ES-EL150	CAT II SAFETY GLASS
G	3	42"	56" 118"	FIXED	0.23	0.37	21-0708.03	ES WINDOWS	ES-EL150	CAT II SAFETY GLASS
H	2	0"	56" 108"	FIXED	0.23	0.37	21-0708.03	ES WINDOWS	ES-EL150	CAT II SAFETY GLASS
I	2	0"	56" 130"	FIXED	0.23	0.37	21-0708.03	ES WINDOWS	ES-EL150	CAT II SAFETY GLASS
J	3	84"	146" 30"	FIXED	0.23	0.37	20-1116.02	ES WINDOWS	ES-P252	CAT II SAFETY GLASS
K	2	86"	148" 24"	FIXED	0.23	0.37	21-0708.03	ES WINDOWS	ES-EL150	CAT II SAFETY GLASS
L	2	8 1/2"	84" 20"	FIXED	0.23	0.37	21-0708.03	ES WINDOWS	ES-EL150	CAT II SAFETY GLASS
M	1	8 1/2"	134" 20"	FIXED	0.23	0.37	21-0708.03	ES WINDOWS	ES-EL150	CAT II SAFETY GLASS
N	2	86"	44" 24"	FIXED	0.23	0.37	20-1116.02	ES WINDOWS	ES-P252	CAT II SAFETY GLASS
O	5	86"	74" 24"	FIXED	0.23	0.37	20-1116.02	ES WINDOWS	ES-P252	CAT II SAFETY GLASS
P	1	16"	146" 26"	STOREFRONT	0.23	0.37	20-1118.02	ES WINDOWS	ES-8000T	CAT II SAFETY GLASS
Q	2	16"	143" 26"	STOREFRONT	0.23	0.37	20-1118.02	ES WINDOWS	ES-8000T	CAT II SAFETY GLASS
R	1	0"	94" 108"	STOREFRONT	0.23	0.37	20-1118.02	ES WINDOWS	ES-8000T	CAT II SAFETY GLASS
S	1	0"	98" 108"	STOREFRONT	0.23	0.37	20-1118.02	ES WINDOWS	ES-8000T	CAT II SAFETY GLASS
T	4	26"	144" 80"	SLIDING GLASS WINDOW 2 PANEL 2 TRACKS	0.23	0.37	21-0608.03	ES WINDOWS	ES-EL200	CAT II SAFETY GLASS
U	1	48"	120" 60"	SLIDING GLASS WINDOW 2 PANEL 2 TRACKS	0.23	0.37	21-0608.03	ES WINDOWS	ES-EL200	CAT II SAFETY GLASS
V	4	12"	144" 94"	SLIDING GLASS WINDOW 3 PANEL 2 TRACKS	0.23	0.37	21-0608.03	ES WINDOWS	ES-EL200	CAT II SAFETY GLASS

1ST LEVEL SCHEDULE 1

1/16" = 1'-0"

2ND LEVEL SCHEDULE 2

1/16" = 1'-0"

ROOF LEVEL SCHEDULE 3

1/16" = 1'-0"

GENERAL GLAZING NOTES

- GLAZING IN HAZARDOUS LOCATIONS SHALL BE TEMPERED INGRESS AND EGRESS DOORS; PANELS IN SLIDING OR SWINGING DOORS; DOORS AND ENCLOSURE FOR HOT TUB BATHUB AND SHOWERS; GLAZING IN WALL ENCLOSING THESE COMPARTMENTS WITHIN 5' OF STANDING SURFACE; IN WALL ENCLOSING STAIRWAY LANDING, EACH LIGHT OF SAFETY GLAZING (PANEL) MATERIAL INSTALLED IN HAZARDOUS LOCATIONS SHALL BE IDENTIFIED BY A PERMANENT LABEL THAT SPECIFIES THE LABELER, AND STATES THAT SAFETY GLAZING MATERIAL HAS BEEN UTILIZED IN SUCH INSTALLATIONS.
- GLAZING LESS 24 INCHES FROM EITHER SIDE OF AN EXTERIOR DOOR ON THE SAME PLANE AND 24 INCHES FROM THE HINGE SIDE OF THE DOOR WHEN LESS THAN 180 DEGREES FROM THE DOOR PLANE SHALL BE CATEGORY II AS PER FBC, R 308.4
- PROVIDED IMPACT GLASS FOR ALL IMPACT MISSILES AT ALL WINDOWS 30 FEET ABOVE GRADE.
- ALL SILL HEIGHTS TO BE 42" A.F.F. UNLESS OTHERWISE NOTED.
- ALL FIXED GLAZING PANELS TO BE TEMPERED GLASS.
- ALL GLAZING 0'-0" A.F.F. TO BE SPANDREL GLASS.

GENERAL DOOR NOTES

- ALL PRODUCTS APPROVAL DOCUMENTATION SHALL BE SUBMITTED TO THE BUILDING DEPARTMENT AS REQUIRED.
- ALL EXTERIOR DOORS TO HAVE MIAMI DADE COUNTY PRODUCT APPROVAL, UNLESS OTHERWISE NOTED.
- FORCE ENTRY REQUIREMENTS: ALL EXTERIOR DOORS SHALL COMPLY WITH THE REQUIREMENTS OF CHAPTER 36 OF THE S.F.B.C. FOR GROUP OCCUPANCIES.
- STRUCTURAL PERFORMANCE: DOORS SHALL BE DESIGNED AND CONSTRUCTED TO PRESERVE THE ENCLOSED BUILDING ENVELOPE AGAINST WIND PRESSURE AS SET FORTH IN SECTION 2309 OF THE S.F.B.C. AND IMPACT LOADS AS SET FORTH IN SECTION 2315 OF THE S.F.B.C.
- ALL DOOR DIMENSIONS SHOWN ON THIS SHEET ARE UNIT SIZES, UNLESS OTHERWISE NOTED, PROVIDE MASONRY OPENING PER MANUFACTURER'S RECOMMENDATION.
- WINDOW SUPPLIER SHALL FIELDS VERIFY ALL EXISTING DOOR OPENINGS AND CONTRACTOR SHALL MAKE ALL REQUIRED ADJUSTMENTS TO EXISTING MASONRY OPENING SIZES TO ACCOMMODATE AVAILABLE DOORS.
- IF THE EXISTING MASONRY OPENING SIZES MUST BE ADJUSTED TO ENSURE NEW DOORS, THE CONTRACTOR SHALL BE RESPONSIBLE FOR PATCHING AND REPAIRING INTERIOR AND EXTERIOR WALL SURFACES TO BEGIN TO EXIST.
- ALL INTERIOR DOORS SHALL HAVE APPROPRIATE THRESHOLDS AT DOORWAY WHEN FINISH FLOORING MATERIAL IS DIFFERENT FROM ROOM TO ADJOINING ROOM.
- ALL EXTERIOR DOORS SHALL HAVE ALUM. THRESHOLDS, DOOR SWEEPERS, & WEATHER STRIPPING ALL AROUND.
- ALL INTERIOR DOOR FRAMES TO MATCH ADJOINING DOOR FINISHES.
- FOR TYPICAL FRAME DETAILS, REFER TO MANUFACTURER SPECS.
- EVERY CLOSET DOOR LATCH SHALL BE SUCH THAT CHILDREN CAN OPEN THE DOOR FROM THE INSIDE, AS PER NFPA 101.
- EVERY BATHROOM DOOR LOCK SHALL BE DESIGNED TO PERMIT THE OPENING OF THE LOCKED DOOR FROM THE OUTSIDE IN AN EMERGENCY AS PER NFPA 101.
- ALL NEW DOORS SHALL HAVE 3 PAIRS OF HINGES OR AS RECOMMENDED BY MANUFACTURER.
- HARDWARE SHALL BE: APPROVED IN EQUAL FINISH /COLOR. CONTRACTOR OR HARDWARE SUPPLIER SHALL SUBMIT A HARDWARE SCHEDULE FOR APPROVAL PRIOR TO INSTALLATION.
- ALL DOUBLE DOORS SHALL HAVE MULTI POINT FLUSH-BOLT AT ASTRALAG. PROVIDE ALLOWANCE FOR ALL HARDWARE.

MEANS OF EGRESS

- ALL EGRESS WINDOWS SHALL HAVE A MIN. NET CLEAR OPENING OF 5.7 SF; WHILE GRADE FLOOR OPENING MY BE REDUCED TO 5 SF, HAVE A MIN. NET WIDTH OF 20" AND A MIN. NET HEIGHT OF 24". THE BOTTOM OF THE OPENING SHALL NOT BE GREATER THAN 44" MEASURED FROM THE FINISH FLOOR OF THAT STORY AS PER FBC-B 1030, FBC R311 FOR SLEEPING ROOMS IN R-2 AND R-3 OCCUPANCIES BELOW THE FOURTH STORY.
- NO DOOR IN THE PATH OF TRAVEL OF MEANS OF ESCAPE SHALL BE LESS THAN 80" HEIGHT AND 32" WIDE MEASURED FROM FACE OF DOOR TO STOP WHEN OPENED 90°. BATHROOM DOORS MAY BE 24" WIDE UNLESS A LARGER DOOR OPENING IN REQUIRED TO SATISFY REQUIREMENTS, AS PER FBC B 1010.1
- EVERY CLOSET DOOR LATCH SHALL BE SUCH THAT CHILDREN CAN OPEN THE DOOR FROM INSIDE THE CLOSET.
- EVERY BATHROOM DOOR LOCK SHALL BE DESIGN TO PERMIT THE OPENING OF THE LOCKED DOOR FROM THE OUTSIDE IN AN EMERGENCY.
- NO DOOR IN ANY MEANS OF ESCAPE SHALL BE LOCKED AGAINST EGRESS WHEN THE BUILDING IS OCCUPIED. ALL LOCKING WHICH IMPEDE OR PROHIBIT EGRESS OR WHICH CANNOT BE EASILY DISENGAGED SHALL BE PROHIBITED.

BURGLARY SECURITY & FORCED ENTRY

- ALL LOCKS AND EXTERIOR DOORS: SHALL BE CAPABLE OF RESISTING A FORCE OF 300 LB. APPLIED IN ANY MOVABLE DIRECTION AND IN ACCORDANCE WITH THE RESISTANCE STANDARDS SET FORTH IN THE BUILDING CODE BOOK.
- ALL SINGLE EXTERIOR SWING DOOR: SHALL HAVE A LOCK TO BE KEY OPERATED FROM EXTERIOR WITH A MINIMUM OF 6000 POSSIBLE KEY CHANGES OR LOCKING AUXILIARY SINGLE DEADBOLTS WITH INSERTS.
- HINGES ON EXTERIOR OFFSET TYPE SWING DOORS: SHALL HAVE NON-REMOVABLE PINS.
- JAMBS ON ALL EXTERIOR OFFSET TYPE DOORS IN-SWING DOORS: SHALL BE RABBETED, OR OF SIMILAR FABRICATION TO PREVENT DEFEATING THE PURPOSE OF THE STRIKE AND THE INTEGRITY OF LOCKS AND LATCHES.
- SINGLE SWINGING EXTERIOR DOORS: IF WOOD SHALL BE OF SOLID CORE OF NO LESS THAN 1-3/8" THICK.
- EXTERIOR WINDOWS, SHALL BE LOCKED WITH DEVICE IN THE INSIDE CAPABLE OF WITHSTANDING A FORCE OF 150 LBS APPLIED IN AN OPERABLE.
- WINDOW SUB-BUCKS: SHALL BE OF TREATED MATERIAL AT LEAST 2" NOMINAL THICKNESS & SECURED IN AT LEAST 6 POINTS ON EACH LEG WITH 3" OR EQUIVALENT FASTENERS.




MIK ARCHITECTURE LLC
MATIAS DANCICH
AR 100480




AGD DEVELOPERS LLC
1385 CORAL WAY, SUITE 202
MIAMI, FL 33146
agdmiami.com
dev@agdmiami.com

NEW CONSTRUCTION
AGD CALISTONE LLC
10840 SW 67 AVE MIAMI, FL 33156

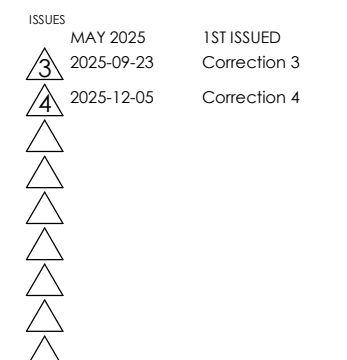

JOB NO. #084
DRAWN BY NS
CHECKED BY MD
SCALE AS NOTED
FROM AA 26003995

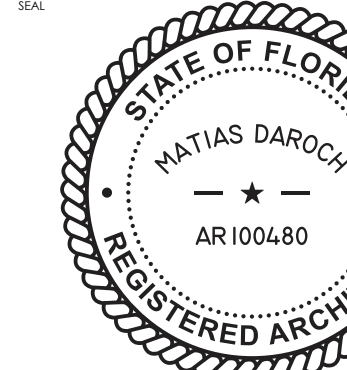

THIS IS A DIGITALLY SIGNED FILE. THE CONTENTS OF THIS DOCUMENT ARE NOT CONSIDERED SIGNED AND SEALED UNTIL THE SIGNATURE HAS BEEN VERIFIED ON THE SIGNING DEVICE.






THE CONTENT OF THIS SHEET AND ALL OTHER DRAWINGS ISSUED BY THE SET ARE PROTECTED BY U.S. AND INTERNATIONAL COPYRIGHT LAWS. REPRODUCTION OR USE WITHOUT WRITTEN CONSENT IS PROHIBITED BY LAW. SEE ALSO FOR DETAILS.

A-601

SCHEDULE



PINECREST
BUILDING +
PLANNING

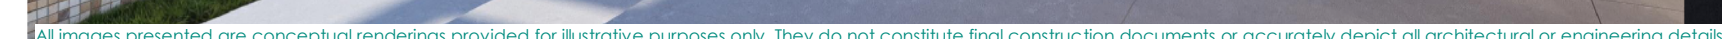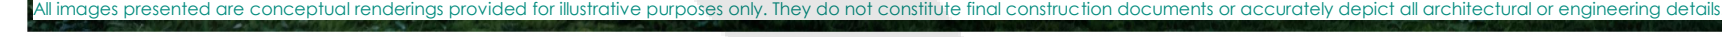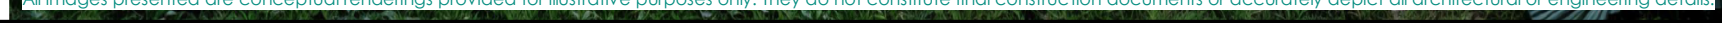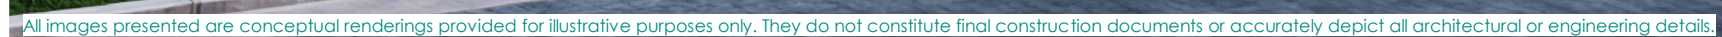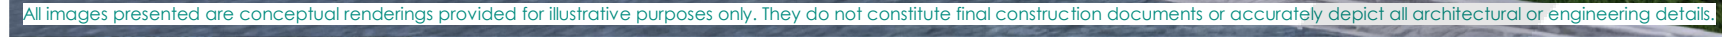

NEW CONSTRUCTION
AGD CALISTONE LLC
10840 SW 67 AVE MIAMI, FL 33156

ENDERS

22/1/2023 12:36:24 PM