



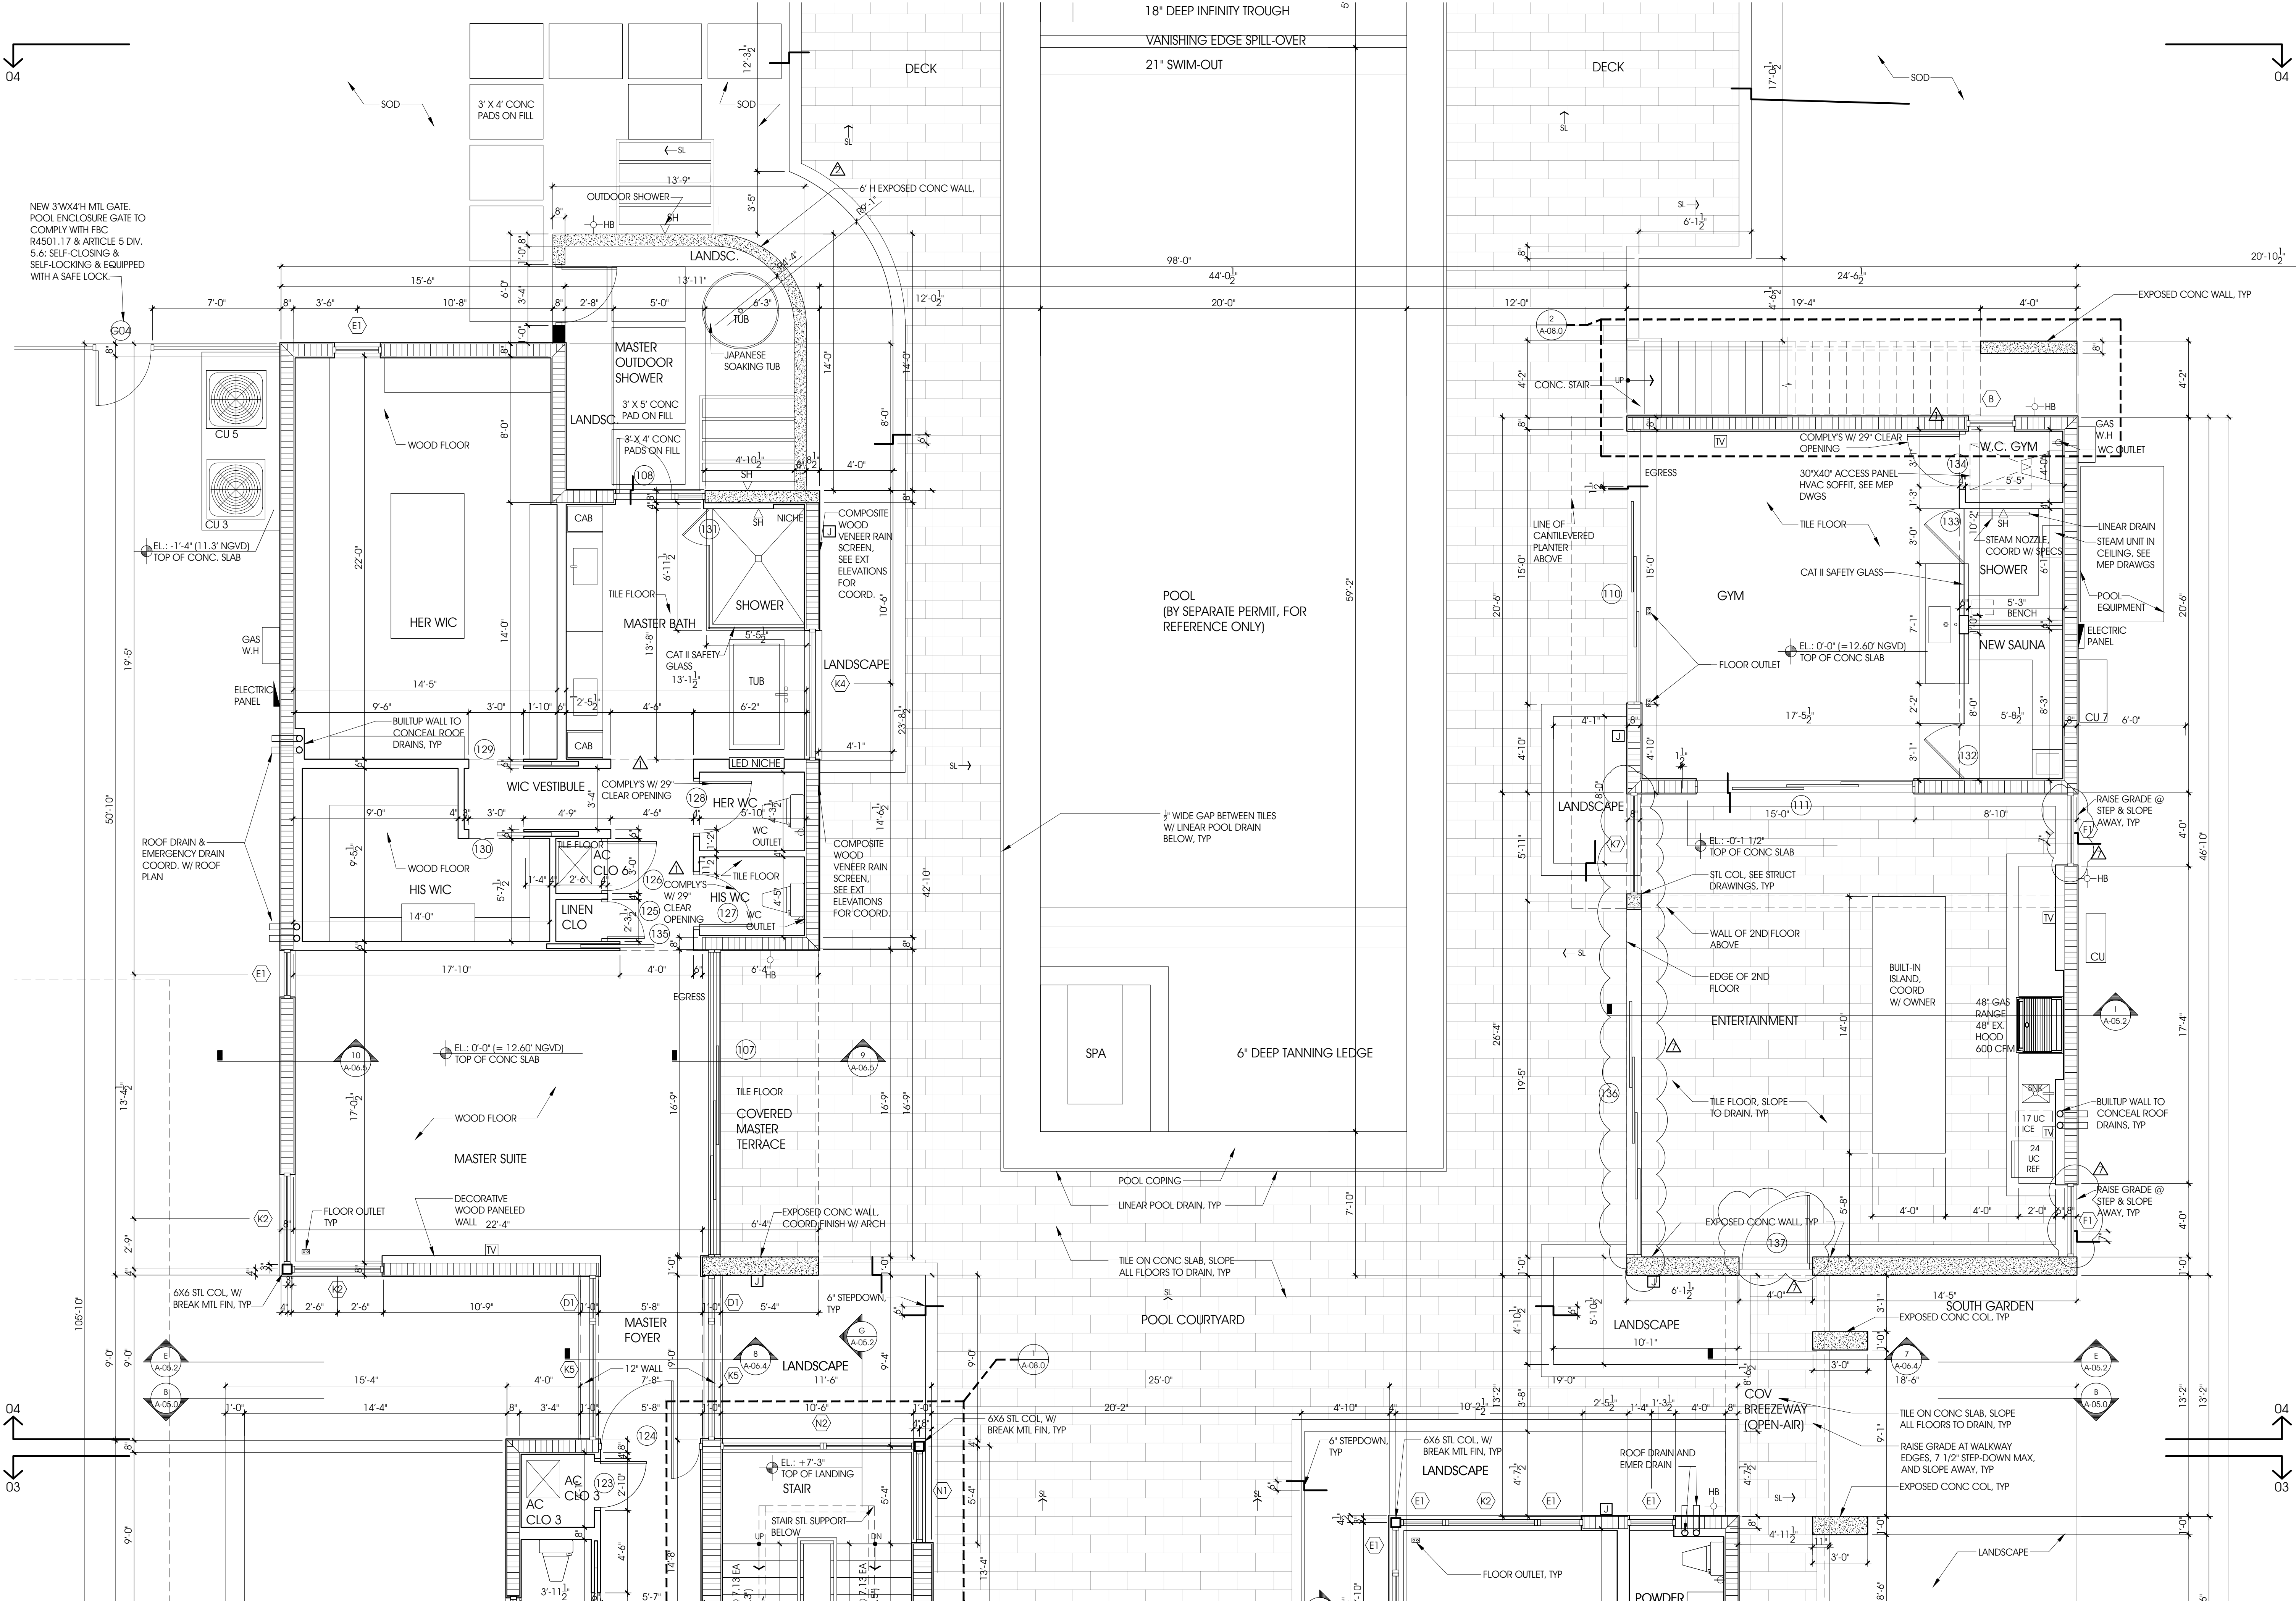

PARTIAL FIRST FLOOR PLAN: 04
SCALE: 1/4" = 1'-0"

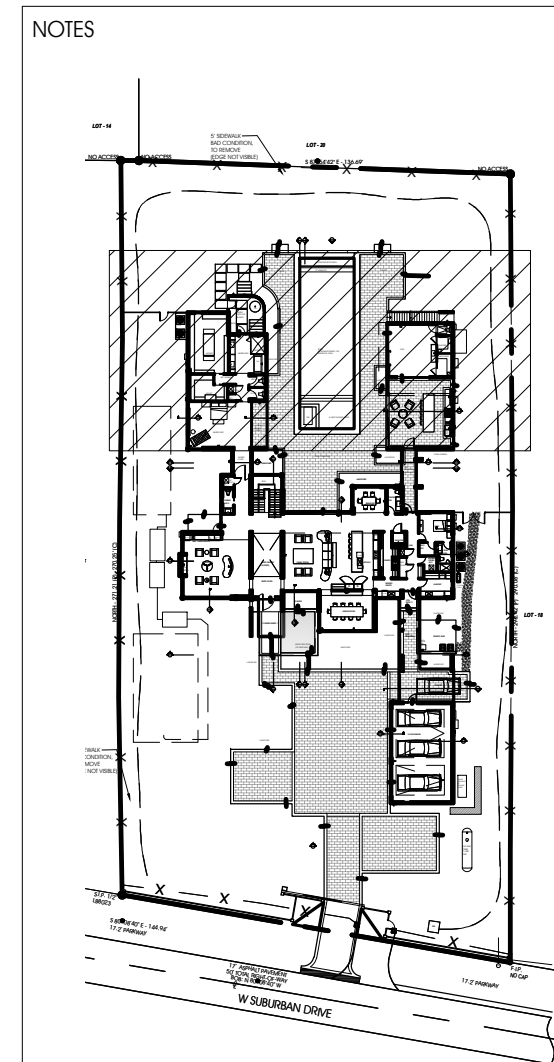

KEY PLAN
SCALE: 1/4" = 1'-0"

LOCUS
ARCHITECTURE
INCORPORATED
500 South Dixie Highway, Suite 307
Coral Gables, Florida 33146
Tel: (305) 740-0120
Email: locus@locusarchitecture.net
License: AR 13937

CONSULTANT(S)

NO.	REVISION/SUBMISSION	DATE
	OWNER REVIEW	04-08-24
	PERMIT SUBMITTAL	06-07-24
	REVIEW COMMENT	08-19-24
	REVIEW COMMENT	11-04-24
	OWNER REVISION	03-31-26

PROJECT

New 2-Story Residence:
6100 W Suburban Dr, Pinecrest, FL 33156

DRAWING
Partial First Floor Plan: 04

SEAL

Nelson de Leon
AR 13937

SCALE
DRAWN
REVIEWED
NDL
PROJ. NO.
351
SHEET NO.

A-02.3