

NOTES

LOCUS
ARCHITECTURE
INCORPORATED

500 South Dixie Highway, Suite 307
Coral Gables, Florida 33146
Tel: (305) 740-0120
Email: locus@locusarchitecture.net
License: AR 13937

CONSULTANT(S)

NO.	REVISION/SUBMISSION	DATE
	OWNER REVIEW	04-08-24
	PERMIT SUBMITTAL	06-07-24
△	REVIEW COMMENT	08-19-24
△	OWNER REVISION	03-31-26

PROJECT

New 2-Story Residence:
6100 W Suburban Dr, Pinecrest, FL 33156

DRAWING

Door Schedule

SEAL



Nelson de Leon
AR 13937

SHEET NO.

SCALE

DRAWN

REVIEWED
NDL

PROJ. NO.
351

FIRST FLOOR MAIN HOUSE DOOR SCHEDULE

DOOR #	DOORS						FRAMES						IMPACT GLASS	HOW GROUP	REMARKS
	TYPE	MAT.	FIN.	SIZE			TYPE	MAT.	FIN.	DETAILS					
				WIDTH	HEIGHT	THICK				JAMB	HEAD	SILL			
100	A	MTL	-	12'-0"	10'-0"	-	-	MTL	-	-	-	-	-	-	GARAGE DOOR
101	A2	MTL	-	18'-0"	10'-0"	-	-	MTL	-	-	-	-	-	-	GARAGE DOOR
102	B	MTL/GL	-	3'-0"	8'-0"	-	-	MTL	-	-	-	-	YES	-	2'-0" SIDELIGHT. COORDINATE SIDELIGHT POSITION WITH FLOOR PLAN
103	C	WD	STAIN	6'-4"	11'-8"	-	-	WD	-	-	-	-	-	-	ENTRY CUSTOM PIVOT DOOR
104	B	MTL/GL	-	3'-0"	8'-0"	-	-	MTL	-	-	-	-	YES	-	2'-0" SIDELIGHT. COORDINATE SIDELIGHT POSITION WITH FLOOR PLAN
105	B	MTL/GL	-	3'-0"	8'-0"	-	-	MTL	-	-	-	-	YES	-	2'-0" SIDELIGHT. COORDINATE SIDELIGHT POSITION WITH FLOOR PLAN
106	D	MTL/GL	-	20'-0"	10'-0"	-	-	MTL	-	-	-	-	YES	-	FOUR TRACKS SLIDING DOOR
107	E	MTL/GL	-	16'-9"	10'-0"	-	-	MTL	-	-	-	-	YES	-	THREE TRACKS SLIDING DOOR
108	B	MTL/GL	-	3'-0"	10'-0"	-	-	MTL	-	-	-	-	YES	-	2'-0" SIDELIGHT. COORDINATE SIDELIGHT POSITION WITH FLOOR PLAN
109	B	MTL/GL	-	3'-0"	10'-0"	-	-	MTL	-	-	-	-	YES	-	3'-4" SIDELIGHT. COORDINATE SIDELIGHT POSITION WITH FLOOR PLAN
110	E	MTL/GL	-	15'-0"	10'-0"	-	-	MTL	-	-	-	-	YES	-	THREE TRACKS SLIDING DOOR
111	E	MTL/GL	-	15'-0"	10'-0"	-	-	MTL	-	-	-	-	YES	-	THREE TRACKS SLIDING DOOR
112	F	WD	PAINT	3'-0"	8'-0"	1 3/4"	-	WD	-	-	-	-	-	-	
113	G	GL	-	2'-6"	8'-0"	-	-	-	-	-	-	-	-	-	CAT II SAFETY GLASS, FBC2406.4.3.2 - R4410.1. WINE CELLER CUSTOM DOOR
114	H	WD	PAINT	2'-6"	8'-0"	1 3/4"	-	WD	-	-	-	-	-	-	FULLY LOUVERED
115	H	WD	PAINT	2'-6"	8'-0"	1 3/4"	-	WD	-	-	-	-	-	-	FULLY LOUVERED
116	F	WD	PAINT	3'-0"	8'-0"	1 3/4"	-	WD	-	-	-	-	-	-	ELEVATOR
117	F	WD	PAINT	2'-6"	8'-0"	1 3/4"	-	WD	-	-	-	-	-	-	
118	F	WD	PAINT	2'-6"	8'-0"	1 3/4"	-	WD	-	-	-	-	-	-	
119	F	WD	PAINT	2'-6"	8'-0"	1 3/4"	-	WD	-	-	-	-	-	-	
120	G	GL	-	2'-4"	8'-0"	-	-	-	-	-	-	-	-	-	CAT II SAFETY GLASS, FBC2406.4.3.2 - R4410.1
121	F	WD	PAINT	2'-6"	8'-0"	1 3/4"	-	WD	-	-	-	-	-	-	
122	I	WD	PAINT	2'-10"	8'-0"	1 3/4"	-	WD	-	-	-	-	-	-	POCKET DOOR
123	H	WD	PAINT	2'-10"	8'-0"	1 3/4"	-	WD	-	-	-	-	-	-	FULLY LOUVERED
124	J	WD	PAINT	5'-6"	8'-0"	1 3/4"	-	WD	-	-	-	-	-	-	CUSTOM PIVOT INTERIOR DOOR
125	H	WD	PAINT	2'-4"	8'-0"	1 3/4"	-	WD	-	-	-	-	-	-	FULLY LOUVERED
126	H	WD	PAINT	2'-4"	8'-0"	1 3/4"	-	WD	-	-	-	-	-	-	FULLY LOUVERED
127	F	WD	PAINT	2'-10"	8'-0"	1 3/4"	-	WD	-	-	-	-	-	-	COMPLYS W/ 29" CLEAR OPENING 
128	F	WD	PAINT	2'-10"	8'-0"	1 3/4"	-	WD	-	-	-	-	-	-	COMPLYS W/ 29" CLEAR OPENING
129	I	WD	PAINT	3'-0"	8'-0"	1 3/4"	-	WD	-	-	-	-	-	-	POCKET DOOR
130	I	WD	PAINT	3'-0"	8'-0"	1 3/4"	-	WD	-	-	-	-	-	-	POCKET DOOR
131	G	GL	-	2'-4"	8'-0"	-	-	-	-	-	-	-	-	-	CAT II SAFETY GLASS, FBC2406.4.3.2 - R4410.1
132	G	GL	-	3'-0"	8'-0"	-	-	-	-	-	-	-	-	-	COORDINATE W/ SALINA SPEC'S. CAT II SAFETY GLASS, FBC2406.4.3.2-R4410.1
133	G	GL	-	3'-0"	8'-0"	-	-	-	-	-	-	-	-	-	CAT II SAFETY GLASS, FBC2406.4.3.2-R4410.1
134	F	WD	PAINT	2'-10"	8'-0"	-	-	-	-	-	-	-	-	-	COMPLYS W/ 29" CLEAR OPENING 
135	I	WD	PAINT	4'-0"	8'-0"	1 3/4"	-	WD	-	-	-	-	-	-	POCKET DOOR
136	D	MTL/GL	-	19'-0"	10'-0"	-	-	MTL	-	-	-	-	YES	-	FOUR TRACKS SLIDING DOOR
137	B2	MTL/GL	-	4'-0"	10'-0"	-	-	MTL	-	-	-	-	YES	-	

SECOND FLOOR DOOR SCHEDULE



200	E	MTL/GL	-	15'-9"	10'-0"	-	-	MTL	-	-	-	-	YES	-	THREE TRACKS SLIDING DOOR
201	I	WD	PAINT	3'-0"	8'-0"	1 3/4"	-	WD	-	-	-	-	-	-	POCKET DOOR
202	F	WD	PAINT	3'-0"	8'-0"	1 3/4"	-	WD	-	-	-	-	-	-	ELEVATOR
203	F	WD	PAINT	3'-0"	8'-0"	1 3/4"	-	WD	-	-	-	-	-	-	
204	F	WD	PAINT	2'-6"	8'-0"	1 3/4"	-	WD	-	-	-	-	-	-	
205	F	WD	PAINT	2'-6"	8'-0"	1 3/4"	-	WD	-	-	-	-	-	-	
206	G	GL	PAINT	2'-4"	8'-0"	-	-	-	-	-	-	-	-	-	CAT II SAFETY GLASS, FBC2406.4.3.2 - R4410.1
207	H	WD	PAINT	2'-6"	8'-0"	1 3/4"	-	WD	-	-	-	-	-	-	FULLY LOUVERED
208	F	WD	PAINT	3'-0"	8'-0"	1 3/4"	-	WD	-	-	-	-	-	-	
209	I	WD	PAINT	3'-0"	8'-0"	1 3/4"	-	WD	-	-	-	-	-	-	POCKET DOOR
210	G	GL	PAINT	2'-4"	8'-0"	-	-	-	-	-	-	-	-	-	CAT II SAFETY GLASS, FBC2406.4.3.2 - R4410.1
211	F	WD	PAINT	3'-0"	8'-0"	1 3/4"	-	WD	-	-	-	-	-	-	
212	F	WD	PAINT	2'-6"	8'-0"	1 3/4"	-	WD	-	-	-	-	-	-	
213	F	WD	PAINT	2'-6"	8'-0"	1 3/4"	-	WD	-	-	-	-	-	-	
214	G	GL	PAINT	2'-4"	8'-0"	-	-	-	-	-	-	-	-	-	CAT II SAFETY GLASS, FBC2406.4.3.2 - R4410.1
215	F	WD	PAINT	2'-6"	8'-0"	1 3/4"	-	WD	-	-	-	-	-	-	
216	H	WD	PAINT	2'-6"	8'-0"	1 3/4"	-	WD	-	-	-	-	-	-	FULLY LOUVERED
217	H	WD	PAINT	3'-0"	8'-0"	1 3/4"	-	WD	-	-	-	-	-	-	FULLY LOUVERED
218	I	WD	PAINT	3'-0"	8'-0"	1 3/4"	-	WD	-	-	-	-	-	-	POCKET DOOR
219	F	WD	PAINT	2'-6"	8'-0"	1 3/4"	-	WD	-	-	-	-	-	-	
220	G	GL	PAINT	2'-4"	8'-0"	-	-	-	-	-	-	-	-	-	CAT II SAFETY GLASS, FBC2406.4.3.2 - R4410.1
221	F	WD	PAINT	3'-0"	8'-0"	1 3/4"	-	WD	-	-	-	-	-	-	
222	F	WD	PAINT	2'-6"	8'-0"	1 3/4"	-	WD	-	-	-	-	-	-	
223	F	WD	PAINT	2'-6"	8'-0"	1 3/4"	-	WD	-	-	-	-	-	-	
224	G	GL	PAINT	2'-4"	8'-0"	-	-	-	-	-	-	-	-	-	CAT II SAFETY GLASS, FBC2406.4.3.2 - R4410.1

SITE DOOR SCHEDULE

G-01	K	MTL	-	12'-0"	6'-0"	-	-	MTL	-	-	-	-	-	-	AUTOMATIC SLIDING GATES
G-02	L	MTL	-	3'-0"	5'-0"	-	-	MTL	-	-	-	-	-	-	ENTRY GATE DOOR WITH MAGNETIC LOCK
G-03	M	MTL	-	(2) 4'-0"	4'-0"	-	-	MTL	-	-	-	-	-	-	POOL ENCL. GATE SELF-CLOSING & SELF-LOCKING & EQUIPPED W/ SAFE LOCK
G-04	L	MTL	-	3'-0"	4'-0"	-	-	MTL	-	-	-	-	-	-	POOL ENCL. GATE SELF-CLOSING & SELF-LOCKING & EQUIPPED W/ SAFE LOCK

NOTES:

- ALL EXTERIOR DOORS BY ES WINDOWS-PRESTIGE SERIES.
- ALL EXTERIOR DOORS SHALL BE IMPACT RESISTANT 7/16", GREY TINTED GLASS, BLACK FRAMES.
- ALL GLASS TO MEET OR EXCEED CAT II SAFETY GLASS, FBC2406.4.3.2 - R4410.1
- HARDWARE AS SELECTED BY OWNER. GC TO PROVIDE SAMPLES FOR APPROVAL.
- ALL GLASS SHOWER DOORS WILL BE 1/2" TEMPERED SAFETY GLASS.
- ALL INTERIOR DOORS SHALL BE SOLID CORE. (COORDINATE STYLE WITH OWNER).
- GC TO VERIFY ALL OPENINGS, PROVIDE NOA AND SHOP DRAWINGS FOR ARCHITECT'S REVIEW.
- GC TO COORDINATE DOOR SWING OR SLIDE DIRECTION WITH ARCHITECTURAL PLANS.
- INTERIOR DOOR HARDWARE BY EMTEK OR AS SELECTED BY OWNER.
- WINDOWS AND DOORS U-FACTOR AND SHGC TO COMPLY W/ MEP ENERGY CALCULATIONS. (U=1.09, SHGC=0.37) △

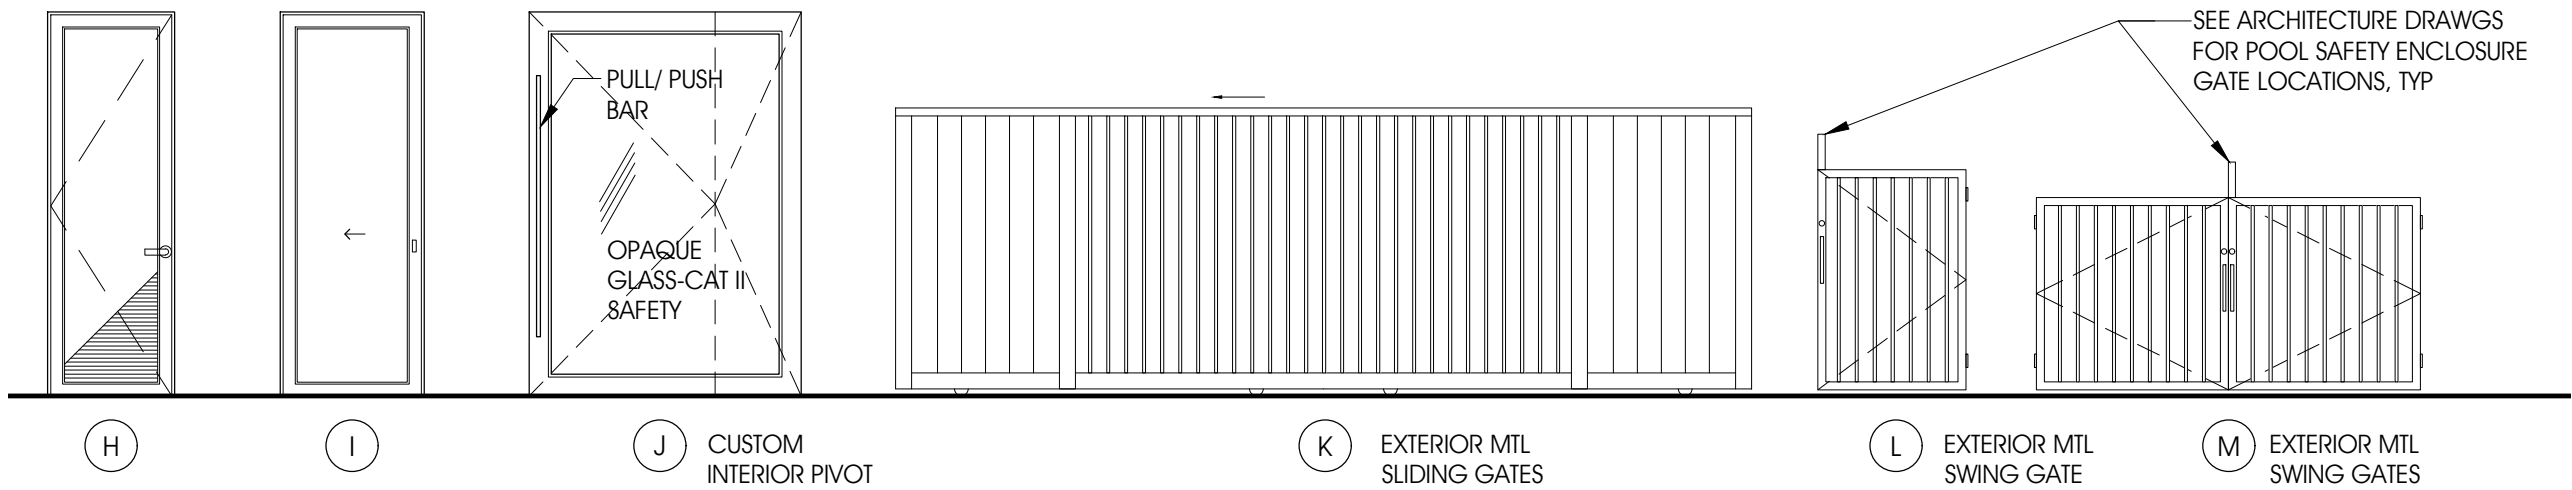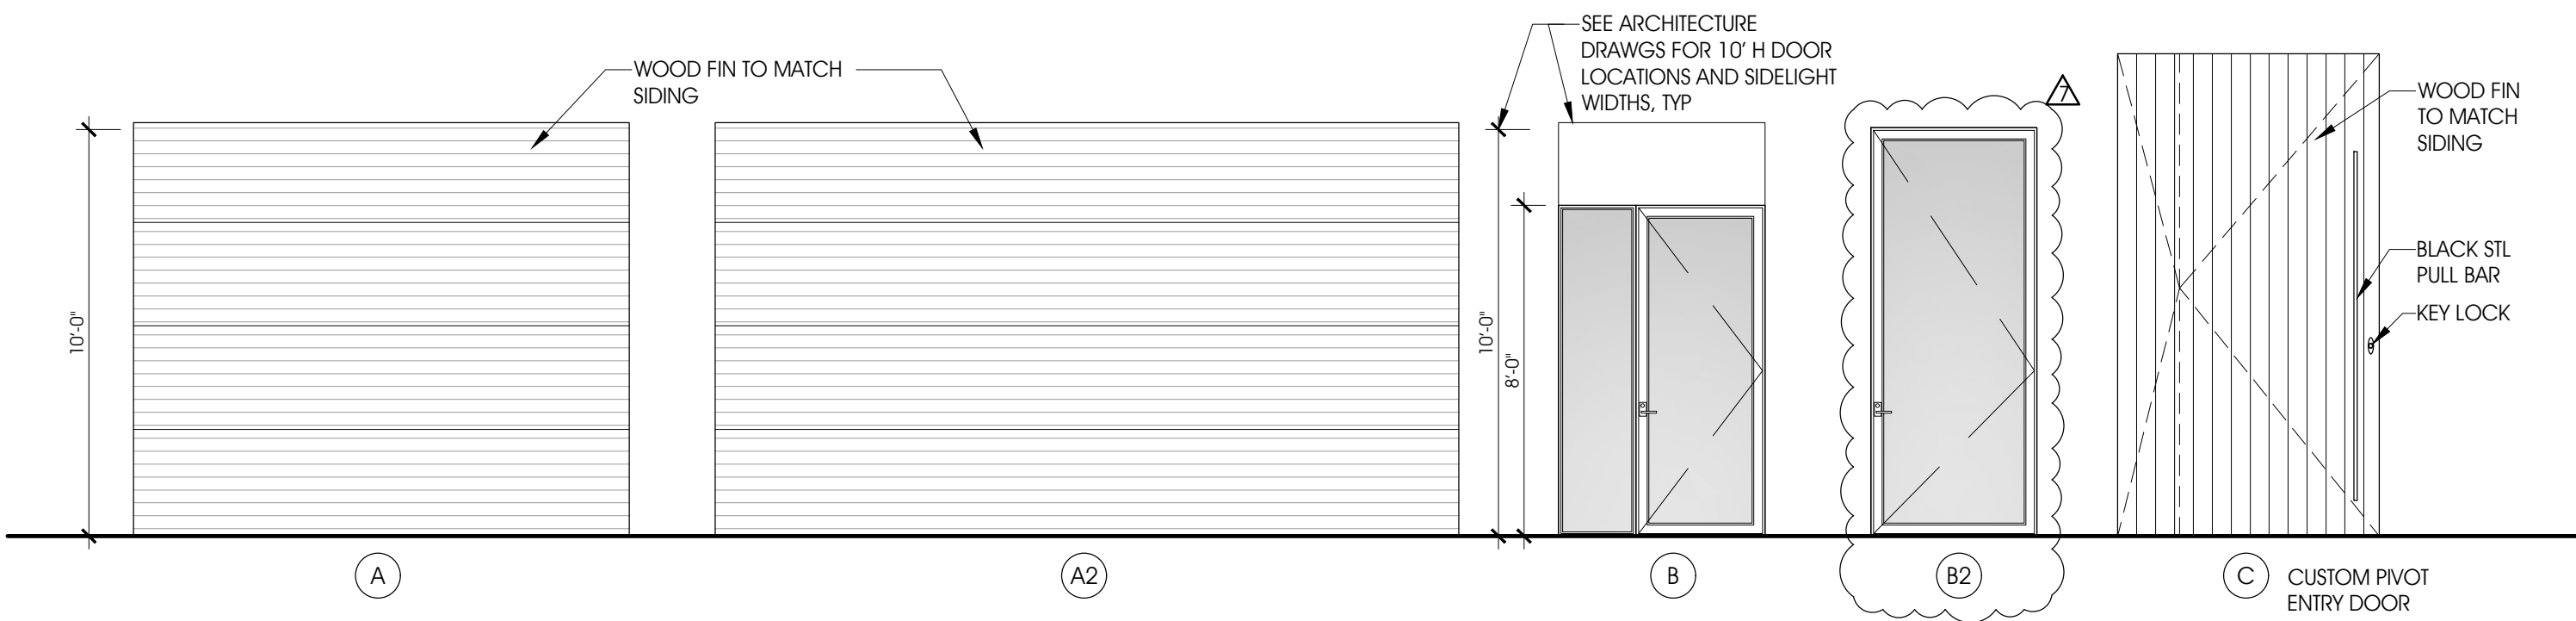

DOOR ELEVATIONS

SCALE: 1/4" = 1'-0"