



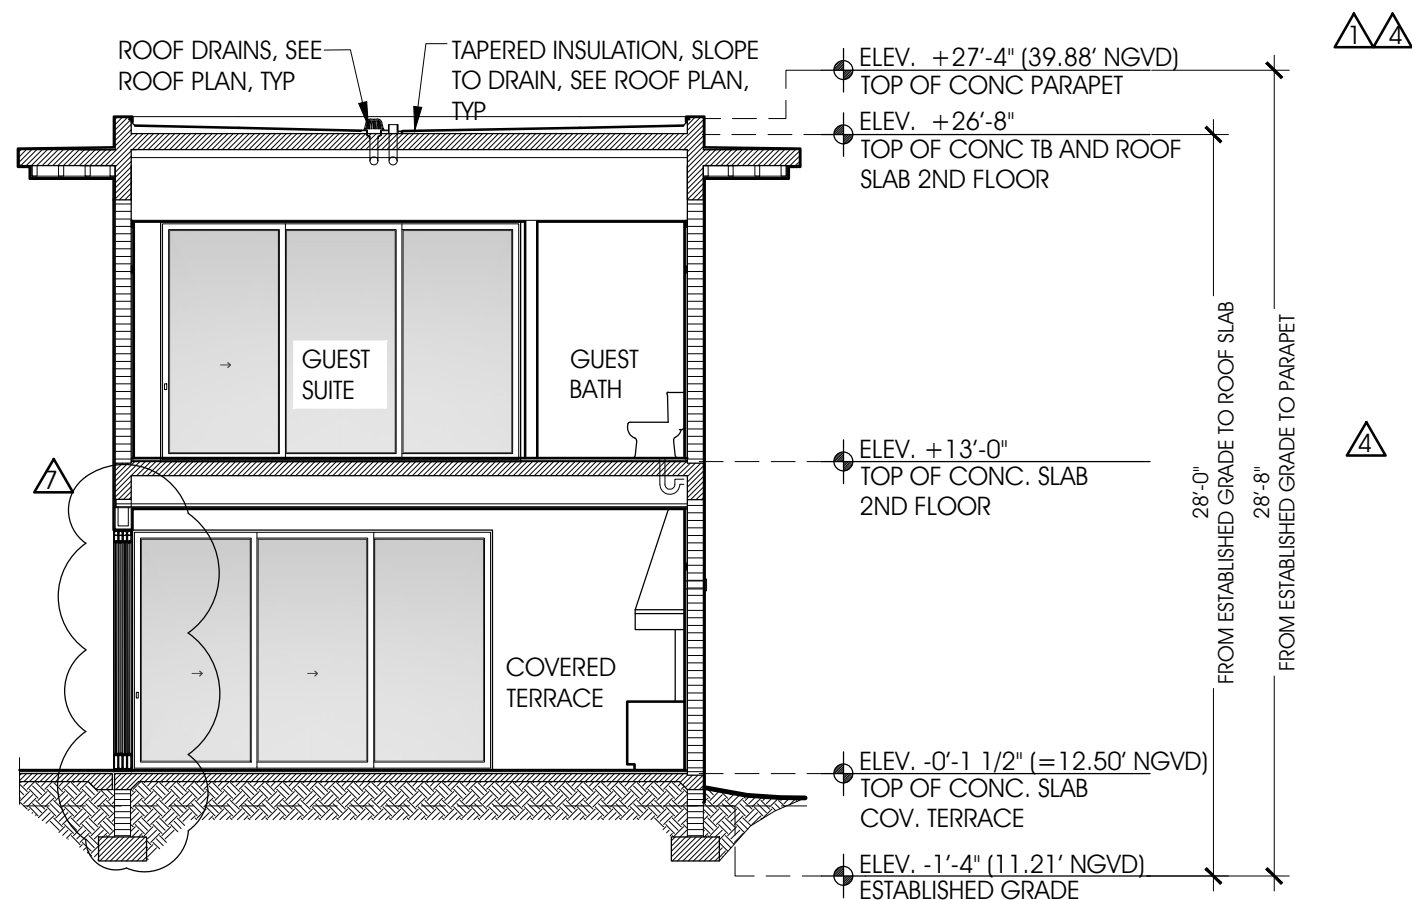


BUILDING SECTION : I-I

SCALE: 1/8" = 1'-0"

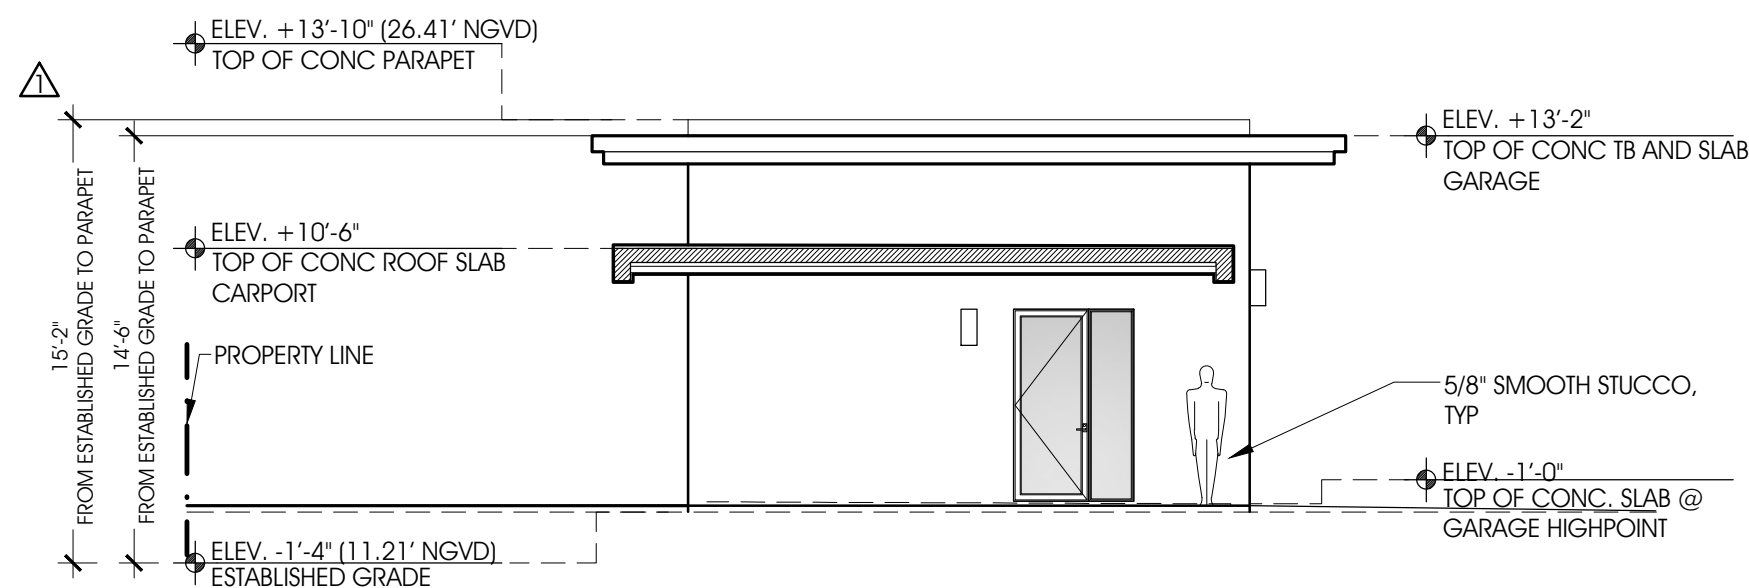


BUILDING SECTION : H-H

SCALE: 1/8" = 1'-0"

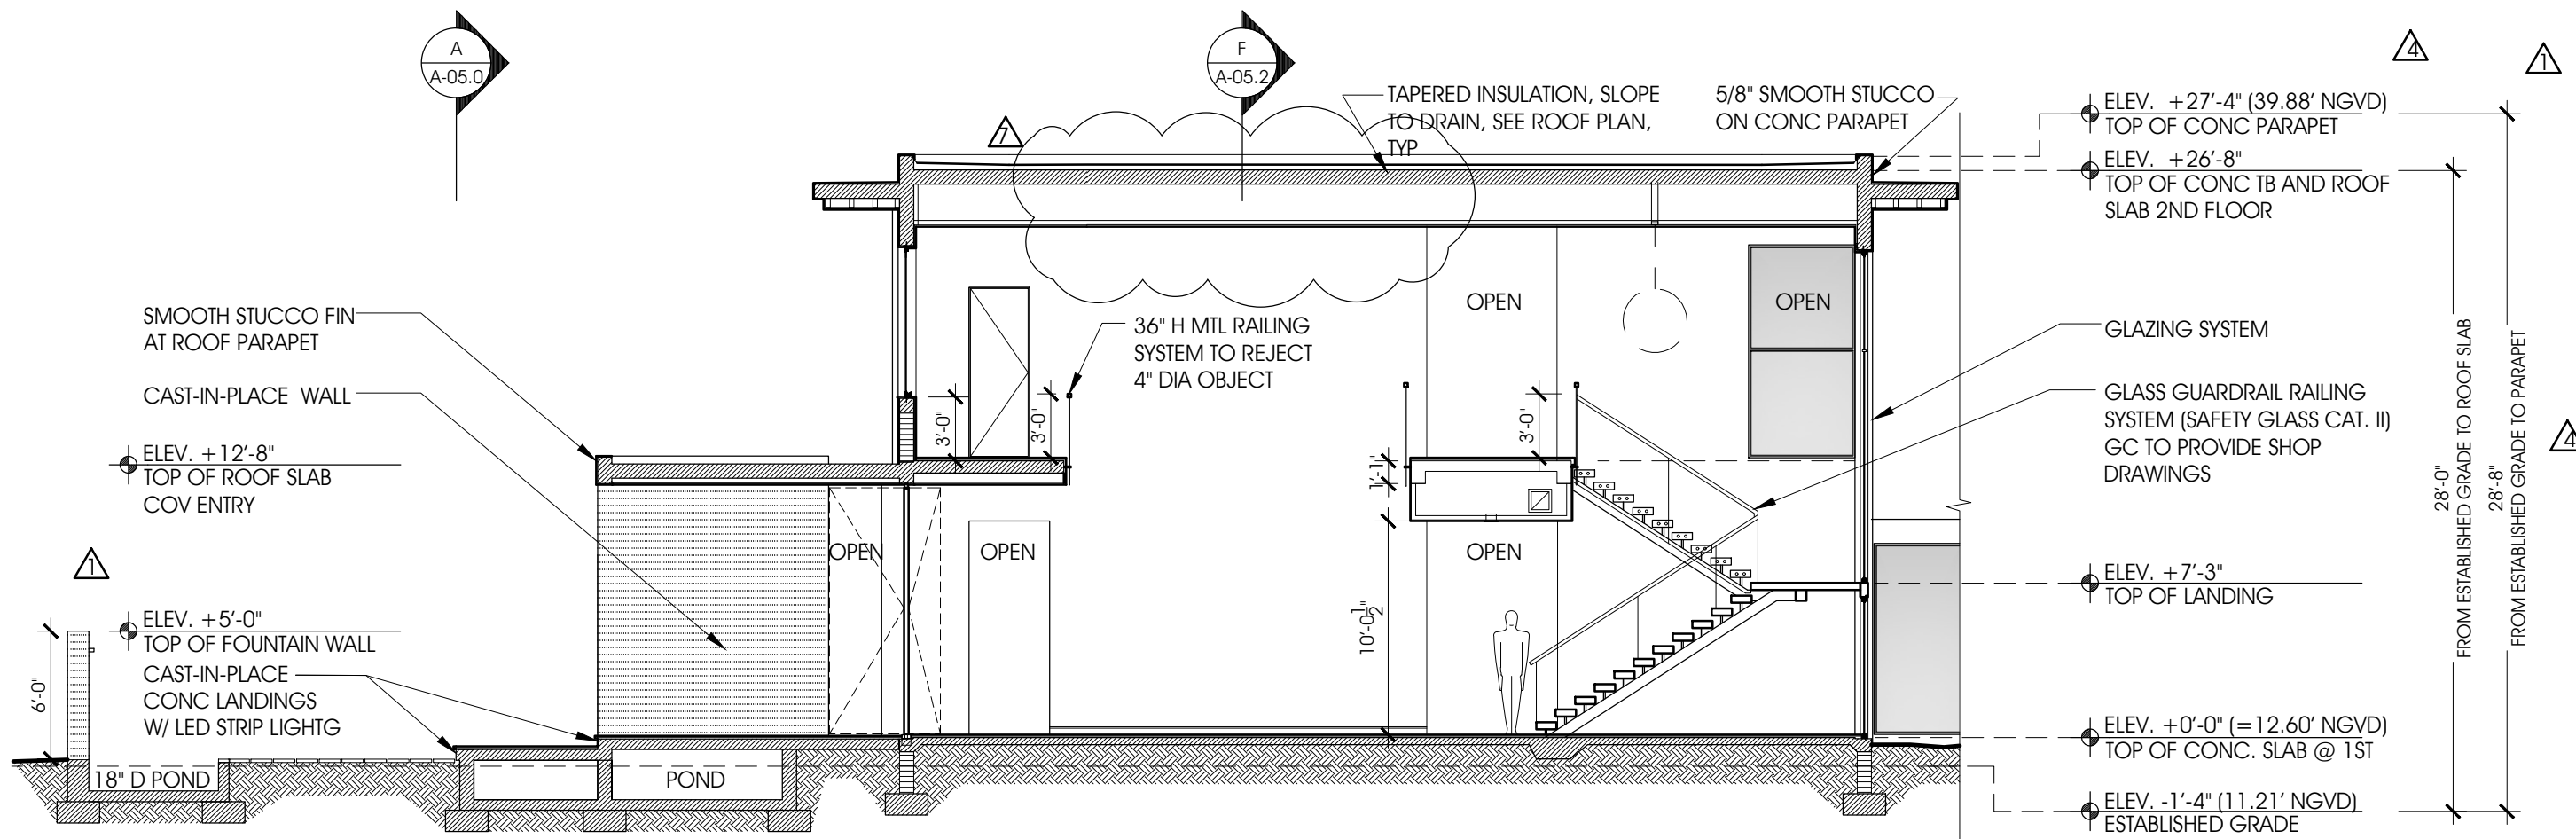


BUILDING SECTION ELEVATION: G-G

SCALE: 1/8" = 1'-0"

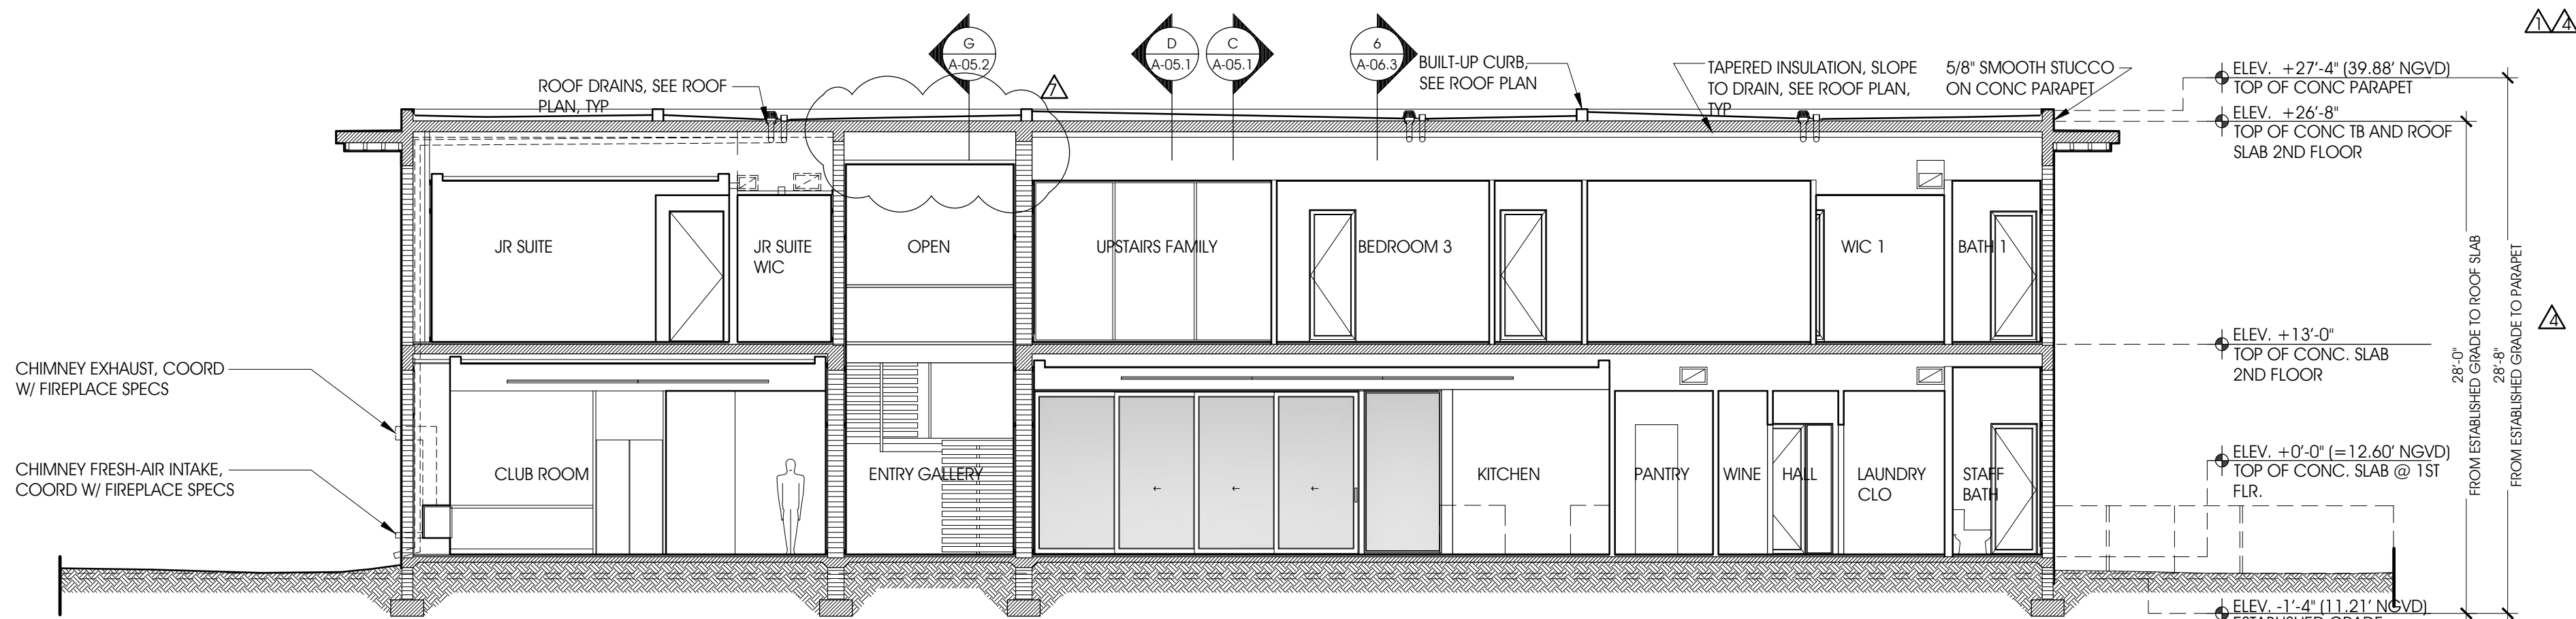

BUILDING SECTION ELEVATION: F-F

SCALE: 1/8" = 1'-0"

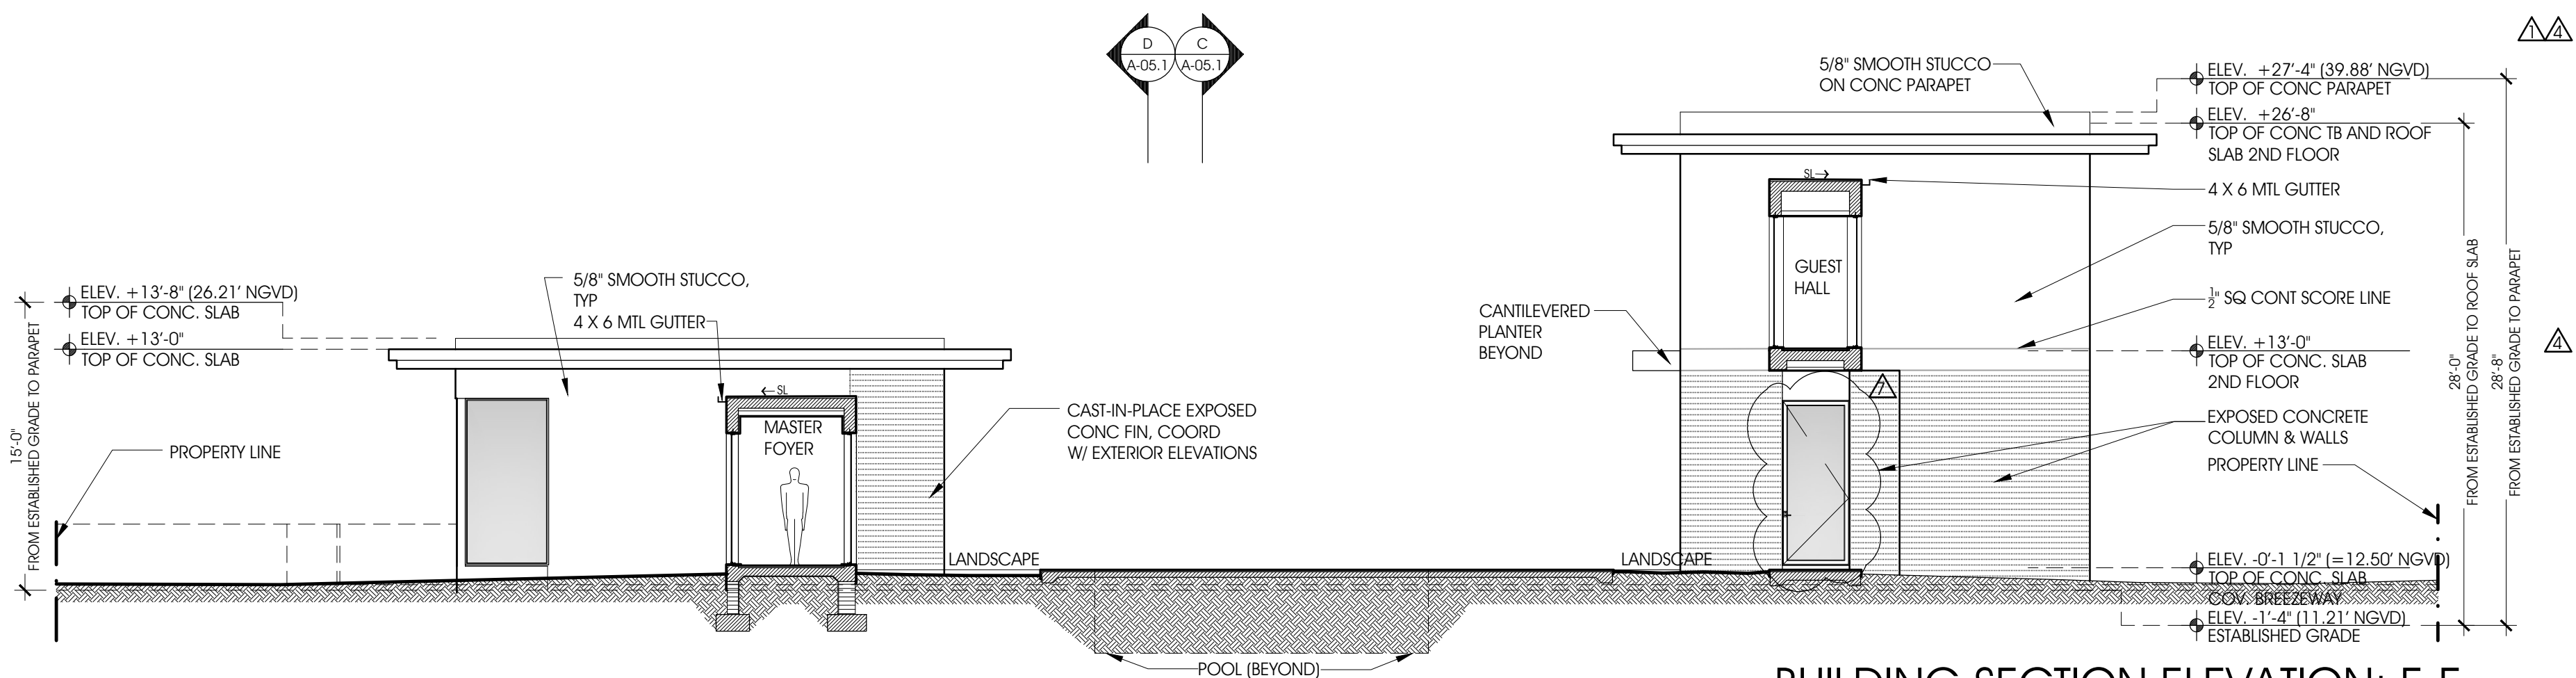

BUILDING SECTION ELEVATION: E-E

SCALE: 1/8" = 1'-0"

NOTES

LOCUS
ARCHITECTURE
INCORPORATED
500 South Dixie Highway, Suite 307
Coral Gables, Florida 33146
Tel: (305) 740-0120
Email: locus@locusarchitecture.net
License: AR 13937

CONSULTANT(S)

NO.	REVISION/SUBMISSION	DATE
	OWNER REVIEW	04-08-24
	PERMIT SUBMITTAL	06-07-24
⚠	REVIEW COMMENT	08-19-24
⚠	OWNER REVISION	08-13-25
⚠	OWNER REVISION	03-31-26

PROJECT

New 2-Story Residence:
6100 W Suburban Dr, Pinecrest, FL 33156

DRAWING

Overall Building Sect-Elevations
EE, FF and GG

SEAL



Nelson de Leon
AR 13937

SHEET NO.

A-05.2

SCALE

DRAWN

REVIEWED

NDL

PROJ. NO.

351