

ELECTRICAL LEGEND


A	LIGHT FIXTURE DESIGNATION, FLOODLIGHT. SEE LIGHTING FIXTURE SCHEDULE
⊙	LIGHT FIXTURE DESIGNATION, SEE LIGHTING FIXTURE SCHEDULE
⊙	LIGHTING FIXTURE, SURFACE MOUNTED
⊙	LIGHTING FIXTURE, RECESSED MOUNTED
⊙	LIGHTING FIXTURE, WALL MOUNTED
⊙	1 X 4 FLUORESCENT LIGHT FIXTURE
\$	TOGGLE SWITCH 120/277V, 20 AMP, (M.H. = 48" A.F.F.), 3-WAY
\$	TOGGLE SWITCH 120/277V, 20 AMP, (M.H. = 48" A.F.F.), 4-WAY
\$	TOGGLE SWITCH 120/277V, 20 AMP, (M.H. = 48" A.F.F.)
\$	TOGGLE SWITCH 120/277V, 20 AMP, KEYSWITCH, (M.H. = 48" A.F.F.)
\$	FAN SWITCH 120/277V, 20 AMP, (HORSEPOWER RATED), (M.H. = 48" A.F.F.)
\$	DOOR JAM SWITCH 120/277V, 20 AMP, (M.H. = 48" A.F.F.)
\$	TOGGLE SWITCH 120/277V, 20 AMP, WITH (M.H. = 48" A.F.F.), 3-WAY
\$	10 MIN. TIME DELAY, RELAY BY MECH. CONT. INSTALLED BY E.C.
\$	FAN AND LIGHTING SWITCH 120/277V, 20 AMP (M.H. = 48" A.F.F.), 3-WAY
\$	TOGGLE SWITCH 120/277V, 20 AMP, WITH PILOT LIGHT, (M.H.=48" A.F.F.)
\$	SPEED SWITCH 120/277V, 20 AMP, U.O.N., (M.H. = 48" A.F.F.)
\$	SINGLE PHASE MANUAL MOTOR STARTER, (M.H. = 48" A.F.F.)
\$	DIMMER SWITCH 120/277V, 20 AMP, (M.H. = 48" A.F.F.)
\$	DUPLEX RECEPTACLE, 20 AMP., 125V., (M.H. = 18" A.F.F.)
\$	DUPLEX RECEPTACLE, 20 AMP., 125V., RECESS FLOOR MOUNTED
\$	DUPLEX RECEPTACLE, 20 AMP., 125V., CEILING MOUNTED
\$	USB OUTLET, (M.H. = 18" A.F.F.)
\$	DUPLEX RECEPTACLE, 20 AMP., 125V., TOP HALF SWITCHED, M.H. = 18" A.F.F. UNLESS OTHERWISE NOTED
\$	DUPLEX RECEPTACLE, 20 AMP., 125V., ISOLATED GND. AND SURGE PROTECTED, (M.H. = 18" A.F.F.)
\$	SINGLE RECEPTACLE, 20 AMP., 125V., COORDINATE M.H. WITH DEDICATED EQUIPMENT
\$	FOUR-FLUX QUAD RECEPTACLE, 20A., 125V., (M.H. = 18" A.F.F.)
\$	SPECIAL PURPOSE OUTLET 220V e.g. RANGE OUTLET, COORD. W/ EQUIP.
\$	DUPLEX RECEPTACLE, 20 AMP., 125V., MOUNT ABOVE COUNTER
\$	30 AMP., 125V., TWIST LOCK RECEPTACLE FOR FLOOR POLISHING MACHINE
\$	JUNCTION BOX, MOUNTING AS SHOWN
\$	GARAGE DOOR PUSH BUTTON SWITCH
\$	ELECTRIC MOTOR
\$	MOTOR STARTER
\$	COMBINATION MOTOR STARTER, TYPE AS DESIGNATED
\$	ELECTRICAL PANEL, SEE PANEL SCHEDULE SHEET(S) FOR DETAILS
\$	EXISTING EQUIPMENT TO REMAIN
\$	NEW EQUIPMENT OR WORK OF THIS PROJECT
\$	SMOKE ALARM/CO SENSOR COMBINATION
\$	120V WITH BATTERY BACK UP
\$	CIRCUIT BREAKER, TYPE AND SIZE AS PER DRAWINGS.
\$	LOW VOLTAGE LIGHTING KEYPAD
\$	CLOCK
\$	BELL
\$	TELEPHONE PORT FLOOR MOUNTED
\$	DUAL TELEPHONE OUTLET MOUNTED AT 18" A.F.F. USE CAT-5 W/1" STUB UP 6" ABOVE CEILING.
\$	DUAL TELEPHONE OUTLET MOUNTED AT 54" A.F.F. USE CAT-5 W/1" STUB UP 6" ABOVE CEILING.
\$	COMPUTER/DATA/TELEPHONE OUTLET MOUNTED AT 18" A.F.F. USE CAT-5 W/1" STUB UP 6" ABOVE CEILING.
\$	TELEVISION OUTLET (M.H. = 18" A.F.F.)

ABBREVIATIONS			
A.C.	ABOVE COUNTER	E	EXISTING DEVICE TO REMAIN
A.F.	ARC FAULT	RL	EXISTING RELOCATED
A.F.F.	ABOVE FINISHED FLOOR	G.F.I.	GROUND FAULT INTERRUPTER
A.S.W.	ABOVE SHOW WINDOW ROP.T.	L.C.	LOCKABLE COVER
B.F.C.	BELOW FINISHED CEILING	M.H.	MOUNTING HEIGHT
B.F.G.	BELOW FINISHED GRADE	N	NEW DEVICE
C.B.	CIRCUIT BREAKER	N.F.	NON FUSED
CL	CENTER LINE	NL	NON FUSED
D	DEDICATED FOR COMPUTER, PROVIDE DEDICATED GROUND AND NEUTRAL	T.C.	TERMINAL CABINET
EM	PROVIDE EMERGENCY BATTERY PACK W/FIXTURE, CONNECT AHEAD OF ALL SWITCHES.	T.S.	TIME SWITCH
FLR	FLOOR	U.O.N.	UNLESS OTHERWISE NOTED
		WP.	WEATHER PROOF
		WR.	WEATHER RESISTANT
		M.S.	MOTION SENSOR
		ATS.	AUTOMATIC TRANSFER SWITCH
		CLG.	CEILING

ALL ELECTRICAL INSTALLATION SHALL COMPLY WITH NEC 110.11, 110.12, 110.28 AND 358.12.5

ELECTRICAL GENERAL NOTES

- IT SHALL BE UNDERSTOOD THAT ALL WORK PERFORMED SHALL BE BY A LICENSED ELECTRICAL CONTRACTOR IN A FIRST CLASS WORKMANLIKE MANNER. SAID CONTRACTOR SHALL MEET ALL REQUIREMENTS SET FORTH BY ANY LOCAL ORDINANCE AND GOVERNING AUTHORITIES.
- ENTIRE INSTALLATION SHALL BE IN ACCORDANCE WITH THE NATIONAL ELECTRICAL CODE, LATEST EDITION NEC 2017 AND THE LATEST EDITIONS OF ALL LOCAL CODES, RULES 2020, AND ORDINANCES HAVING JURISDICTION FBC 2020, 7TH EDITION.
- IT SHALL BE THE RESPONSIBILITY OF THE ELECTRICAL CONTRACTOR TO PROVIDE ALL LABOR, MATERIALS, AND SUPERVISION NECESSARY TO ACCOMPLISH THE WORK SHOWN AND/OR NOTED ON THE DRAWINGS AND SPECIFICATIONS.
- ALL REQUIRED INSURANCE SHALL BE PROVIDED FOR PROTECTION AGAINST PUBLIC LIABILITY AND PROPERTY DAMAGE FOR THE DURATION OF THE WORK.
- ELECTRICAL CONTRACTOR SHALL VISIT THE JOB SITE PRIOR TO BID AND VERIFY ALL CONDITIONS, LOCATIONS, DIMENSIONS AND COUNTS AS SHOWN AND/OR NOTED ON THE DRAWINGS. THIS SHALL INCLUDE ANY AND ALL FABRICATIONS REQUIRED PRIOR TO INSTALLATION.
- IT SHALL BE THE RESPONSIBILITY OF THE ELECTRICAL CONTRACTOR FOR THE ADVANCED ORDERING OF LONG LEAD ITEMS SO AS NOT TO INTERFERE WITH THE PRODUCTION OF OTHER TRADES RESULTING IN ANY DOWN OR LAG TIME.
- CONTRACTOR SHALL GUARANTEE ALL MATERIALS AND WORKMANSHIP FREE FROM DEFECTS FOR A PERIOD OF NOT LESS THAN (1) YEAR FROM DATE OF ACCEPTANCE, UNLESS INDICATED OR SPECIFIED OTHERWISE.
- CORRECTION OF ANY DEFECTS SHALL BE COMPLETED WITHOUT ADDITIONAL CHARGE AND SHALL INCLUDE REPLACEMENT OR REPAIR OF ANY OTHER PHASE OF THE INSTALLATION WHICH MAY HAVE BEEN DAMAGED THEREBY.
- THE ELECTRICAL CONTRACTOR SHALL BE RESPONSIBLE TO REPAIR TO ORIGINAL CONDITIONS ANY AND ALL DAMAGES TO BUILDING SURFACES, EQUIPMENT AND FURNISHINGS CAUSED DURING PERFORMANCE OF WORK.
- ALL ELECTRICAL EQUIPMENT, DEVICES, WIRE, ETC., SHALL BE LISTED FOR THE INTENDED USE, WITH UNDERWRITERS LABORATORIES, INC. (UL) THESE STANDARDS HAVE BEEN ESTABLISHED BY UL. AS A MINIMUM, ALL EQUIPMENT SHALL MEET APPLICABLE STANDARDS FOR THE TYPE OF EQUIPMENT AND INTENDED USE OF THE FOLLOWING:
 - AMERICAN NATIONAL STANDARDS INSTITUTE (ANSI).
 - ILLUMINATING ENGINEERS SOCIETY (IES).
 - AMERICAN SOCIETY FOR TESTING AND MATERIALS (ASTM).
 - NATIONAL ELECTRICAL MANUFACTURERS ASSOCIATION (NEMA).
- NOTE: THESE STANDARDS ARE SUBORDINATE TO CODES AND STANDARDS SET BY UL. IT SHALL NOT BE THE INTENT OF THESE PLANS AND/OR SPECIFICATIONS TO SHOW EVERY MINOR DETAIL OF CONSTRUCTION. THE CONTRACTOR SHALL BE EXPECTED TO FURNISH AND INSTALL ALL ITEMS FOR A COMPLETE ELECTRICAL SYSTEM AND PROVIDE ALL REQUIREMENTS NECESSARY FOR EQUIPMENT TO BE PLACED IN PROPER WORKING ORDER.
- ALL CONDUIT RUNS ARE SHOWN DIAGRAMMATICALLY. EXACT ROUTING SHALL BE DETERMINED IN THE FIELD. UNLESS OTHERWISE NOTED, THE ELECTRICAL CONTRACTOR SHALL PROVIDE AND INSTALL THE PROPER NUMBER OF CONDUITS IN ALL RACEWAYS AS REQUIRED TO ACCOMPLISH THE PROPER FUNCTIONING OF THE DEVICE OR EQUIPMENT AS SHOWN.
- ELECTRICAL CONTRACTOR SHALL NOT SCALE DRAWINGS. CONTRACTOR SHALL REFER TO ARCHITECTURAL PLANS AND ELEVATIONS FOR EXACT LOCATIONS OF ALL EQUIPMENT UNLESS NOTED OTHERWISE.
- THE ELECTRICAL CONTRACTOR SHALL KEEP ALL AREAS IN WHICH WORK IS BEING PERFORMED, FREE FROM DEBRIS AT ALL TIMES AND SAID AREAS SHALL BE LEFT BROOM CLEAN AT THE END OF EACH WORKING DAY.
- CONTRACTOR SHALL PAY FOR ALL PERMITS, FEES, INSPECTIONS, AND TESTING.
- ARCHITECTURAL AND/OR ENGINEERING EXPENSES THAT ARE INCURRED DUE TO REVISIONS OR SUBSTITUTIONS REQUESTED BY THE CONTRACTOR SHALL BE PAID FOR BY THAT CONTRACTOR.
- COORDINATE ALL ELECTRICAL SITE WORK WITH GENERAL CONTRACTOR PRIOR TO INSTALLATION.
- FOR ELECTRIC POWER SYSTEM:
 - COORDINATE POWER SERVICE WITH POWER COMPANY.
 - VERIFY LOCATION OF POWER SERVICE TERMINATION WITH POWER COMPANY PRIOR TO SUBMITTING BID.
- FOR TELEPHONE SYSTEM:
 - PROVIDE GROUNDING FOR ALL TELEPHONE OUTLETS AND EQUIPMENT PER REQUIREMENTS OF TELEPHONE COMPANY.
 - TELEPHONE CABLES SHALL NOT BE INSTALLED IN THE SAME TRUNK WITH POWER AND LIGHTING CONDUITS.
 - MARK TERMINATIONS OF TELEPHONE CONDUIT AS DIRECTED BY TELEPHONE COMPANY.
 - VERIFY LOCATION OF TELEPHONE SERVICE WITH TELEPHONE COMPANY, PRIOR TO SUBMITTING BID.
 - USE EXTERIOR GRADE 3/4" PLYWOOD BACKBOARDS FOR MOUNTING TELEPHONE EQUIPMENT AND TERMINAL STRIPS. PAINT BOARD ON ALL SIDES AND EDGES WITH TWO COATS OF FLAT BLACK ASPHALT PAINT.
- ALL CONDUITS SHALL BE IN CONDUITS. ALL CONDUITS SHALL BE GALVANIZED RIGID STEEL (RGS) EXCEPT THAT: (A) PVC CONDUITS MAY BE USED UNDERGROUND PROVIDED ELBOWS AND RISERS ARE RGS, WHERE SUBJECT TO PHYSICAL DAMAGE (B) ELECTRICAL METALLIC TUBING (EMT) MAY BE USED IN OR ON WALLS OR CEILING WHERE NOT SUBJECT TO PHYSICAL DAMAGE, DAMP OR CORROSIVE CONDITIONS. (C) LIQUID TIGHT FLEXIBLE CONDUIT WHERE REQUIRED, (D) FLEXIBLE METALLIC CONDUIT (MC CABLE W/GROUNDING CONDUCTOR), WHERE REQUIRED IN DRY LOCATIONS ONLY. ALL CONDUITS IN HAZARDOUS AREAS (PER NEC) SHALL MEET THE REQUIREMENTS OF NEC CHAPTER 5. CONTRACTOR MAY USE ROMEX (N) INDOOR IN DWELLING UNITS WHEN APPROVED BY E.C.
- FOR UNDERGROUND ELECTRICAL CONDUITS, PROVIDE PULL BOXES, SUCH THAT NO SINGLE CONDUIT RUN HAS BENDS IN EXCESS OF 360. PULL BOXES SHALL BE SUITABLE AND APPROVED FOR THE INTENDED USE. WHERE CONDUITS PASS UNDERNEATH PAVED AREAS THEY SHALL BE RGS. WHERE UNDERGROUND CONDUITS ARE NOT EXPOSED TO MECHANICAL DAMAGE OR ARE NOT UNDER PAVED AREAS, THEY MAY BE SCHEDULE 40 PVC, BUT ALL CONDUIT RISERS SHALL BE RGS. RGS CONDUITS SHALL EXTEND A MINIMUM 1' 6" BELOW GRADE.
- APPLY BUTYLMASTIC COATING TO ALL METALLIC CONDUITS IN SLABS OR UNDERGROUND. NIGHT LIGHT
- ALL CONDUCTORS SHALL BE COPPER U.O.N., TYPE THIN OR THIN INSULATION, RATED 75°C WET/DRY EXCEPT WHERE OTHERWISE REQUIRED BY U.L. OR CODES UNLESS OTHERWISE NOTED. MINIMUM WIRE SIZE SHALL BE #12 AWG EXCLUDING CONTROL WIRING.
- WIRE WAYS SHALL BE SIZED AS REQUIRED, PER NEC, UNLESS OTHERWISE NOTED.
- ALL ELECTRICAL EQUIPMENT SHALL BE RAIN/TIGHT (NEMA 4X) WHERE EXPOSED TO THE WEATHER. ALL FLEX CONDUITS CONNECTED TO SUCH EQUIPMENT SHALL BE LIQUID-TIGHT.
- OUTLET BOXES SHALL BE PRESSED STEEL IN DRY LOCATIONS, CAST ALLOY WITH THREADED HUBS IN WET OR DAMP LOCATIONS AND SPECIAL ENCLOSURE FOR OTHER CLASSIFIED AREAS. PROPER PLASTER RINGS SHALL BE USED WITH OUTLET BOXES. PROPER COORDINATION BETWEEN ELECTRICAL SUBCONTRACTOR AND GENERAL CONTRACTOR FOR PLASTER RING INITIATION WILL BE REQUIRED. NO "GOOF" RINGS SHALL BE ALLOWED. ALL OUTLET BOXES SHALL BE SECURELY FASTENED.
- ALL FACE PLATES SHALL BE WHITE DECORA UNLESS OTHER WISE INDICATED IN THE DRAWING.
- MOTOR STARTERS SHALL BE MANUAL OR MAGNETIC, AS INDICATED OR REQUIRED, WITH OVERLOAD PROTECTION FOR EACH PHASE. ALL MOTOR SHALL BE EQUIPPED WITH DISCONNECT MOTOR STARTER COMBINATION.
- FURNISH AND INSTALL DISCONNECT SWITCHES AND WIRING FOR AIR CONDITIONING EQUIPMENT PER MANUFACTURER RECOMMENDATIONS. CONTROLS SHALL BE PROVIDED BY DIVISION 15. ELECTRICAL CONTRACTOR SHALL VERIFY CIRCUIT PROTECTIVE DEVICE RATING FOR EQUIPMENT PROVIDED PRIOR TO INSTALLATION.
- DISCONNECT SWITCHES SHALL BE SIZED PER NEC TO ACCOMMODATE EQUIPMENT SERVED, INCLUDING REQUIRED FUSES, U.O.N. DISCONNECT SWITCHES SHALL BE HORSEPOWER RATED, HEAVY-DUTY TYPE.
 - NONTIME DELAY FUSES IN MAIN SWITCHES AND SWITCHES FEEDING PANELS.
 - TIME DELAY FUSES FOR MOTOR AND A/C CIRCUITS.
- CIRCUIT BREAKERS SHALL BE BOLT-ON U.O.N. INVERSE TIME-TYPE (THERMAL-MAGNETIC) TWO AND THREE-POLE CIRCUIT BREAKERS SHALL HAVE COMMON TRIP. ALL PANELBOARDS SHALL HAVE COPPER BUS.
- UNLESS NOTED AS EXISTING, ALL EQUIPMENT, WIRING, DEVICES, ETC. SHALL BE NEW.
- WHERE CORE DRILLING OF FLOOR/WALLS IS REQUIRED, CONTRACTOR SHALL SEAL OPENINGS WATER/TIGHT AFTER UTILITIES HAVE BEEN INSTALLED. LOCATION OF CORED HOLES SHALL BE COORDINATED WITH LOCATION OF EQUIPMENT IN A MANNER TO BE CLEAN AND FUNCTIONAL. THE CONTRACTOR SHALL INSTALL ONLY ONE CONDUIT PER HOLE AND SEAL THE OPENING AROUND THE CONDUIT AS SPECIFIED.
- PROVIDE FIRE RETARDANT U.L. APPROVED SEALANT ON ALL PENETRATIONS OF FIRE RATED PARTITIONS, WALLS AND STRUCTURAL SLABS. IT SHALL BE THE RESPONSIBILITY OF THE ELECTRICAL CONTRACTOR TO VERIFY, PRIOR TO SUBMITTING BID, LOCATIONS OF ALL SUCH FIRE RATED PARTITIONS, WALLS, AND STRUCTURAL SLABS.
- BALLASTS SHALL HAVE MIN. POWER FACTOR OF 0.90. BALLASTS FOR METAL HALIDE AND HIGH PRESSURE SODIUM FIXTURES SHALL BE CONSTANT WATGOT TYPE WITH 5% LAMP WATTS FOR 10% NOMINAL LINE VOLTAGE VARIATION.
- THE EQUIPMENT GROUNDING TERMINAL BARS OF THE NORMAL AND EMERGENCY ELECTRICAL SYSTEM PANELBOARDS SERVING THE SAME BUILDING SHALL BE BONDED TOGETHER WITH AN INSULATED, CONTINUOUS, COPPER CONDUCTOR NOT SMALLER THAN NUMBER 6.
- PROVIDE LAMPS WITH FIXTURES, SEE LUMINAIRE SCHEDULE FOR LAMP TYPE. CONTRACTOR SHALL VERIFY EACH FIXTURE VOLTAGE PRIOR TO ORDERING.
- ALL CONNECTIONS TO GROUND RODS & BUILDING STEEL SHALL BE MADE WITH U.L. APPROVED WELDED CONNECTIONS, UNLESS NOTED OTHERWISE. THE CONTRACTOR SHALL FORM A GROUNDING ELECTRODE SYSTEM AS PER NEC 250-50.
- PROVIDE MOUNTING BACKBOARDS FOR ELECTRICAL AND COMMUNICATION EQUIPMENT. BACKBOARDS SHALL BE OF TYPE "AC" PLYWOOD, PAINTED ON BOTH SIDES AND EDGES WITH TWO COATS OF LIGHT GREY PAINT.
- PROVIDE A FUSE HOLDER AND FUSE IN THE PRIMARY SIDE OF EACH UNGROUNDED CONDUCTOR FOR EACH BALLAST (BUSSMAN HBS AND ENO OR EQUAL), AT THE HAND HOLE OF EACH EXTERIOR POLE MOUNTED LIGHTING FIXTURE AND 3-BOX FOR WALL OR GROUND MOUNTED EXTERIOR FIXTURES.
- PROVIDE TEMPORARY ELECTRICAL SERVICE FOR USE BY ALL TRADES DURING CONSTRUCTION AND REMOVE SAME AT COMPLETION OF PROJECT.
- THE ELECTRICAL CONTRACTOR SHALL FURNISH A COMPLETE SET OF AS-BUILT DRAWINGS, SHOWING ALL CHANGES AND ELEVATIONS TO THE ARCHITECT/ENGINEER PRIOR TO COMPLETION OF THE PROJECT.
- PREPARE AND AFFIX A TYPEWRITTEN DIRECTORY TO THE INSIDE COVER OF EACH PANELBOARD INDICATING LOADS SERVED BY EACH CIRCUIT AND PANEL FEEDING THE BOARD.
- PROVIDE U.L. LISTED COMPOUND APPLIED TO BACK OF "BACK TO BACK" BOXES IN RATED WALLS WHERE THE BOXES ARE LESS THAN 24 INCHES APART MEASURED HORIZONTALLY.
- NOT USED.
- METER CANS, HUBS, & LUGS FOR SAME ARE TO BE FURNISHED & INSTALLED BY CONTRACTOR. CONTRACTOR TO VERIFY SPECIFIC TYPE OF METER CAN TO BE USED WITH F.P.L. PRIOR TO BID. ALL THREE PHASE METER AND COMMERCIAL USE SHALL HAVE LEVELER BY PASS AS PER FPL REQUIREMENTS.
- A. PROVIDE A PERMANENT SIGN ON THE MAIN ELECTRICAL ROOM DOOR TO THE BLDG. STATING THAT THE SERVICE DISCONNECTS ARE LOCATED INSIDE.
- B. SIGNS SHALL BE PLACED AT THE MAIN DISCONNECT EQUIPMENT INDICATING TYPE AND LOCATION OF ON-SITE EMERGENCY POWER SOURCES.
- C. VOLTAGE AND SERVICE NUMBER SHALL BE INDICATED AT EACH DISCONNECT.
- NOT USED.
- THE CONTRACTOR SHALL SUBMIT 6 COPIES OF EQUIPMENT SHOP DRAWINGS FOR ELECTRICAL EQUIPMENT TO THE ENGINEER FOR REVIEW, PRIOR TO ORDERING SUCH EQUIPMENT.
- ELECTRICAL SYSTEM COMPLIANCE WITH FBC ENERGY CONSERVATION CODE:
 - CONTRACTOR SHALL WITHIN 30 DAYS OF SYSTEM ACCEPTANCE PROVIDE RECORD DRAWINGS TO THE OWNER.
 - CONTRACTOR SHALL PROVIDE TO THE BUILDING OWNER OPERATION MANUAL AS PART OF THE SYSTEM ACCEPTANCE.
 - C. THE MAXIMUM VOLTAGE DROP FOR FEEDER SHALL NOT EXCEED 2%.
 - D. THE MAXIMUM VOLTAGE DROP FOR BRANCH CIRCUITS SHALL NOT EXCEED 3%.
 - E. CONTRACTOR SHALL PROVIDE A MEANS OF SPACE LIGHTING CONTROL FOR ALL SPACES ENCLOSED BY CEILING HEIGHT PARTITIONS VIA MOTION SENSOR SET TO A MAXIMUM OF 30MIN. OF ALL OCCUPANTS LEAVING THE SPACE.
 - F. CONTRACTOR SHALL PROVIDE FOR ALL OTHER SPACES, EACH CONTROL DEVICES SHALL BE ACTIVATED EITHER MANUALLY BY AN OCCUPANT OR AUTOMATICALLY AN OCCUPANT. EACH CONTROL DEVICE SHALL CONTROL A MAXIMUM OF 2500 SF AREA AND BE CAPABLE OF OVERRIDING ANY TIME OF DAY SCHEDULE SHUT OFF CONTROL FOR MORE THAN 4 HOURS.
- ALL EMPTY CONDUITS SHALL BE PROVIDED WITH PULL STRING MARKED AT BOTH ENDS.
- CONTRACTOR SHALL PROVIDE NEUTRAL TO ALL EQUIPMENT U.O.N.
- DOORS AND GATES CONTROL SHALL BE FURNISHED AND INSTALLED BY CONTRACTOR.
- CONTRACTOR SHALL PROVIDE TAMPER RESISTANT RECEPTACLES IN DWELLING UNITS AS REQUIRED BY NEC 406.12.
- PROVIDE ARC FAULT PROTECTION TO ALL OUTLET LOCATED AT KITCHENS, FAMILY ROOMS, DINING ROOMS, LIVING ROOMS, PORCHES, LIBRARIES, BEDS, BEDROOMS, SANITARY, RECREATION ROOMS, CLOSETS, HALLWAYS, LAUNDRY AREAS AND ALL OTHER SIMILAR ARE PER NEC 210.12.
- ELECTRICAL CONTRACTOR IS RESPONSIBLE TO VERIFY AVAILABLE FAULT CURRENT WITH UTILITY COMPANY PRIOR TO EQUIPMENT ORDERING.
- ALL OUTDOOR ILLUMINATION SHALL BE CONTROLLED VIA TIME SWITCH AND PHOTOCELL U.O.N. PROVIDE ASTRONOMIC TIME SWITCH CAPABLE OF RETAINING PROGRAMMING AND THE TIME SETTING DURING LOSS OF POWER FOR A PERIOD OF AT LEAST 10 HOURS, AS PER FLORIDA BUILDING CODE EC 405.2.4. EXTERIOR LIGHTING CONTROL.
- IN DWELLING UNITS WHEN MORE THAN 12 SMOKE ALARMS ARE TO BE CONNECTED TOGETHER, CONTRACTOR SHALL PROVIDE LOW VOLTAGE HOUSEHOLD FIRE ALARM SYSTEM AS PER NFPA72 SECTION 28.8.2.2.
- ALL EXTERIOR LIGHT FIXTURES EXPOSED TO WEATHER, SHALL BE WEATHER PROOF.
- CONTRACTOR SHALL PROVIDE J-BOX AHEAD OF EACH FIXTURE TO COMPLY WITH NEC 410.21 UNLESS FIXTURE IS RATED FOR FEED THRU.
- ALL ELECTRICAL EQUIPMENT TO BE INSTALLED 1FT. ABOVE BASE FLOOD ELEVATION.
- ALL LIGHTING ON THERMAL ENVELOPE SHALL BE IC RATED AND MEETING ASTM E 283 FOR LEAKAGE LABELED AIR TIGHT AND HOUSING SHALL BE SEALED WITH A GASKET OR CAULK TO CEILING OR WALL.
- RESIDENTIAL STAIR ILLUMINATION MUST BE MINIMUM 1FC INTERIOR AND EXTERIOR OF HOUSE. FBC R 303.7 AND FBC R 303.8.
- PROVIDE ARC FLASH HAZARD STORAGE ON ALL ELECTRICAL EQUIPMENT PER NEC 110.16.
- ALL PANEL TO BE FULLY RATED TO MATCH KATC AS LISTED ON PANELS. SYSTEM NOT DESING AS SERIES RATED PANELS.
- ELECTRICAL CONTRACTOR IS RESPONSIBLE TO PROVIDE SHOP DRAWING PRIOR TO ORDERING ELECTRICAL GEAR IN ORDER TO VERIFY AVAILABLE FAULT CURRENT.
- 90% OF ALL LIGHTING FIXTURES SHALL HAVE AN EFFICACY OF AT LEAST 45 LUMENS PER WATT (LED) OR NOT LESS THAN 65 LUMENS PER WATT AND SHALL COMPLY WITH FBC 2020 ENERGY CONSERVATION SECTION CHAPTER 1V, FBC E 8404.
- DISCONNECT INSTALLATION MUST COMPLY WITH 250.140 FRAMES OF RANGES AND CLOTHES DRYERS, FRAMES OF ELECTRIC RANGES, WALL-MOUNTED OVENS, COUNTER-MOUNTED COOKING UNITS, CLOTHES DRYERS, AND OUTLET OR JUNCTION BOXES THAT ARE PART OF THE CIRCUIT FOR THESE APPLIANCES SHALL BE CONNECTED TO THE EQUIPMENT GROUNDING CONDUCTOR IN THE MANNER SPECIFIED BY 250.134 OR 250.138.
- CONTRACTOR SHALL PROVIDE A GROUND CONDUITS (NEUTRAL) AT LIGHTING SWITCHES OUTLETS AS PER NEC 404.2(C).

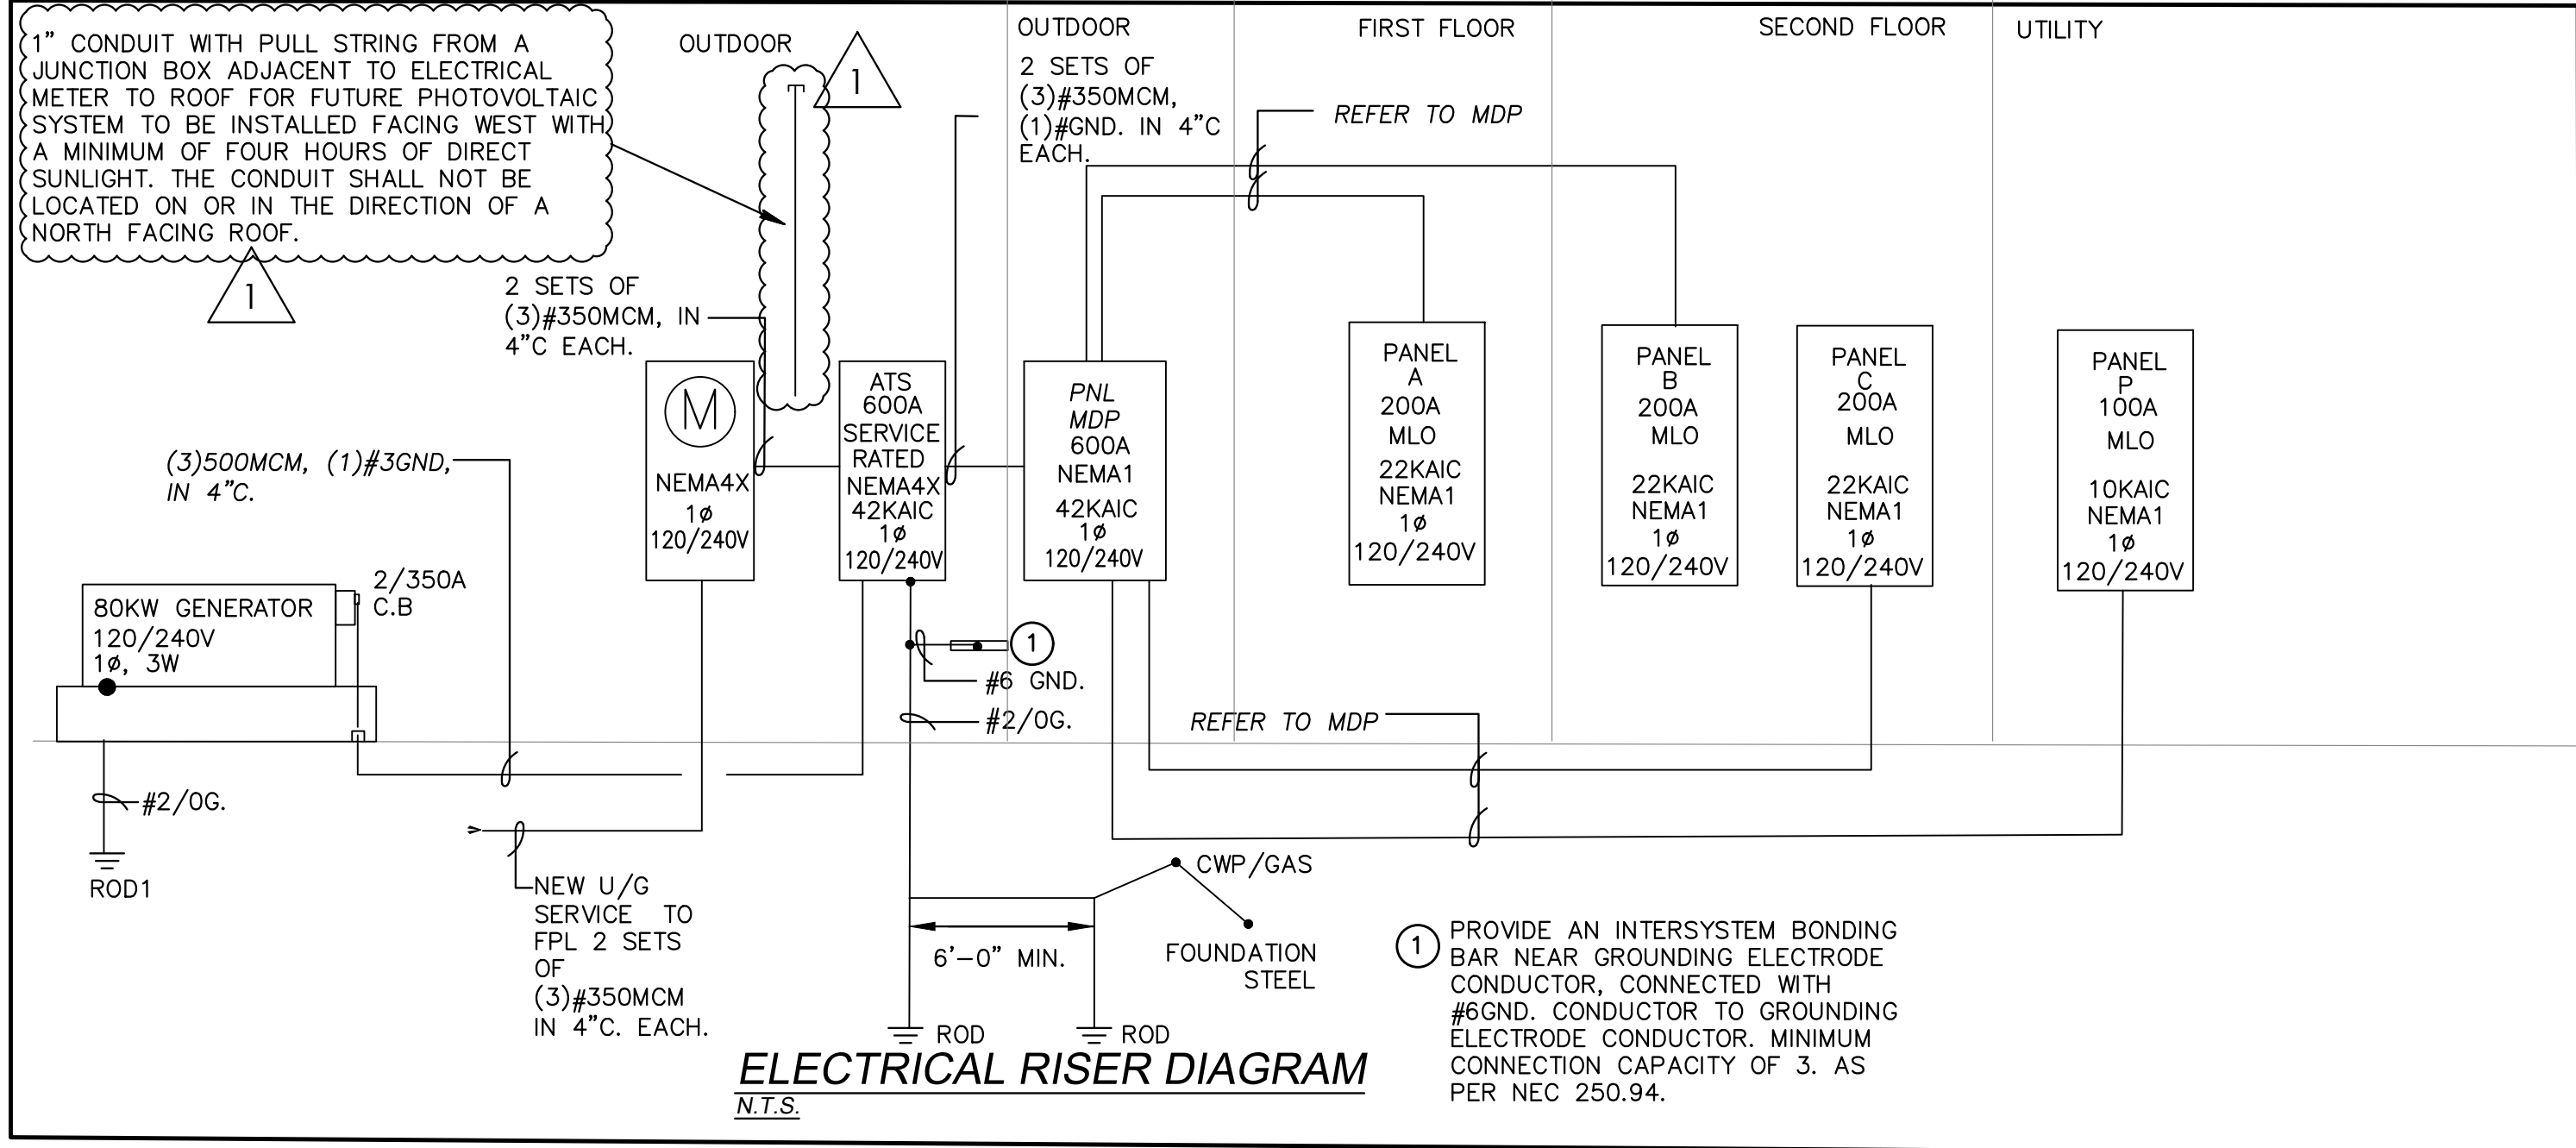

EMERGENCY GENERATOR NOTES

- SPECIFICATION:

IT IS THE INTENT OF THIS SPECIFICATION TO SECURE AN EMERGENCY GENERATOR SYSTEM THAT HAS BEEN PROTOTYPE TESTED, FACTORY BUILT, PRODUCTION TESTED, SITE TESTED, OF THE LATEST COMMERCIAL DESIGN, TOGETHER WITH ALL ACCESSORIES NECESSARY FOR A COMPLETE INSTALLATION AS SHOWN ON THE PLANS AND DRAWINGS, AND SPECIFICATIONS HEREIN. THE EQUIPMENT SUPPLIED AND INSTALLED SHALL MEET THE REQUIREMENTS OF THE NATIONAL ELECTRICAL CODE, ALONG WITH ALL APPLICABLE LOCAL CODES AND REGULATIONS. ALL EQUIPMENT SHALL BE NEW, OF CURRENT PRODUCTION OF A NATIONAL FIRM MANUFACTURER. THE GENERATOR AND CONTROLS, TRANSFER SWITCH, AND ASSEMBLES THE STANDBY GENERATOR SETS AS A MATCHED UNIT SO THAT THERE IS ONE-SOURCE RESPONSIBILITY FOR WARRANTY, PARTS, AND SERVICE THROUGH A LOCAL REPRESENTATIVE WITH FACTORY-TRAINED SERVICEMEN.
- SUBMITTAL:

SUBMITTAL SHALL INCLUDE PROTOTYPE TEST CERTIFICATION AND SPECIFICATION SHEETS SHOWING ALL STANDARD AND OPTIONAL ACCESSORIES TO BE SUPPLIED, SCHEMATIC WIRING DIAGRAMS, DIMENSION DRAWINGS, AND INTERCONNECTION DIAGRAMS IDENTIFYING EACH REQUIRED INTERCONNECTION BETWEEN GENERATOR SET, THE TRANSFER SWITCH, AND THE REMOTE ANNUNCIATOR PANEL.
- TESTING:

THERE SHALL BE THREE TEST: A DESIGN PROTOTYPE TEST, FINAL PRODUCTION TEST, AND SITE TEST. PROTOTYPE TEST PROGRAMS SHALL INCLUDE THE REQUIREMENTS OF NFPA 110 AND THE FOLLOWING: MAXIMUM KW; MAXIMUM MOTOR STARTING(KVA) AT 30% INSTANTANEOUS VOLTAGE DIP; ALTERNATOR TEMPERATURE RISE BY EMBEDDED THERMOCOUPLE AND RESISTANCE METHOD PER NEMA M01-22-40 AND 16-40; GOVERNOR SPEED REGULATION UNDER S.S. AND TRANSIENT CONDITIONS; VOLTAGE REGULATION AND GENERATOR TRANSIENT RESPONSE; FUEL CONSUMPTION AT .25, .50, .75, AND FULL LOAD; COMPLETE HARMONIC ANALYSIS; SINGLE PHASE SHORT CIRCUIT TEST; ALTERNATOR COOLING AIR FLOW; TORSIONAL ANALYSIS TESTING TO VERIFY THAT THE GENERATOR SET IS FREE OF HARMFUL TORSIONAL STRESSES; ENDURANCE TESTING; COMPLETE FINAL PRODUCTION TEST WITH VARIOUS LOADS AND EXHAUST SYSTEM IN PLACE. TEST SHALL INCLUDE: SINGLE STEP PICKUP; TRANSIENT AND STEADY STATE GOVERNING, SAFETY SHUTDOWN DEVICE TESTING; VOLTAGE REGULATION; RATED POWER, MAXIMUM POWER; SITE TEST, AN INSTALLATION CHECK, START-UP, AND BUILDING LOAD TEST SHALL BE PERFORMED BY THE MANUFACTURER'S LOCAL REPRESENTATIVE. THE ENGINEER, REGULAR OPERATORS AND THE MAINTENANCE STAFF SHALL BE NOTIFIED OF THE TIME AND DATE OF THE SITE TEST. THE TEST SHALL INCLUDE: FUEL, LUBRICATING OIL, AND ANTIFREEZE SHALL BE CHECKED FOR CONFORMITY TO THE MANUFACTURER'S RECOMMENDATIONS, UNDER THE ENVIRONMENTAL CONDITIONS PRESENT AND EXPECTED. ACCESSORIES CHECK SHALL INCLUDE: STRIP HEATERS, REMOTE ANNUNCIATOR, UNDER START-UP MODE; CHECK FOR EXHAUST LEAKS, PATH OF EXHAUST PASSES AWAY FROM THE BUILDING, COOLING AIR FLOW, MOVEMENT DURING STARTING AND STOPPING, VIBRATION DURING RUNNING, NORMAL AND EMERGENCY LINE-TO- LINE VOLTAGE, AND PHASE ROTATION. AUTOMATIC START-UP TEST BY MEANS OF SIMULATED POWER OUTAGE TO TEST REMOTE-AUTOMATIC STARTING, TRANSFER OF THE LOAD, AND AUTO- MATIC SHUTDOWN. PRIOR TO THIS TEST, ALL TRANSFER SWITCH TIMERS SHALL BE SET FOR PROPER SYSTEM COORDINATION. ENGINE COOLANT TEMPERATURE, OIL PRESSURE, AND BATTERY CHARGE LEVEL ALONG WITH GENERATOR VOLTAGE, AMPERES, AND FREQUENCY SHALL BE MONITORED THROUGHOUT THE TEST. IN EXTERNAL LOAD BANK SHALL BE CONNECTED TO THE SYSTEM IF SUFFICIENT BUILDING LOAD IS UNAVAILABLE TO LOAD THE GENERATOR TO THE NAMEPLATE KW RATING.
- WARRANTY AND MAINTENANCE:

THE EMERGENCY GENERATOR SYSTEM SHALL BE WARRANTED BY THE MANUFACTURER FOR ONE YEAR OR 2,000 HOURS, WHICHEVER COMES FIRST, FROM THE DATE OF FINAL ACCEPTANCE. OPTIONAL TWO YEAR AND FIVE YEAR WARRANTIES SHALL BE AVAILABLE UPON REQUEST. THE SERVICE CONTRACT SHALL INCLUDE THE FURNISHING OF FACTORY TRAINED PERSONNEL AND MAINTAIN A 24-HOUR PARTS AND SERVICE CAPABILITY AND SHOW AT TIME OF SUBMITTAL THAT THEY ARE REGULARLY ENGAGED IN A MAINTENANCE CONTRACT PROGRAM TO SEMI-ANNUALLY INSPECT AND TEST RUN THE ENGINE TO PERFORM MANUFACTURER'S RECOMMENDED PREVENTIVE MAINTENANCE SERVICE ON THE EQUIPMENT FURNISHED. THIS SERVICE CONTRACT SHALL INCLUDE OPERATION OF THE EQUIPMENT UNDER SIMULATED POWER FAILURE CONDITIONS, ADJUSTMENT OF GENERATOR AND TRANSFER SWITCH CONTROLS AS REQUIRED AND CERTIFICATION IN THE OWNER'S MAINTENANCE LOG OF REPAIRS MADE AND PROPER FUNCTIONING OF ALL ENGINE AND AUXILIARY SYSTEMS. THIS SERVICE CONTRACT SHALL BE PROVIDED AT NO ADDITIONAL CHARGE FOR A PERIOD OF TWO YEARS FROM THE DATE OF FINAL ACCEPTANCE. AT THE OWNER'S OPTION, THE SERVICE CONTRACT SHALL BE RENEWABLE ON A YEAR-TO-YEAR BASIS THEREAFTER WITH COSTS BEING PAID BY THE OWNER.
- ACCEPTABLE MANUFACTURERS SHALL BE LIMITED TO THE FOLLOWING:

KOHLER, KATOLIGHT, GENERAC OR ONAN.

FOR THIS PROJECT THE EMERGENCY GENERATOR SHALL BE A 80KW LP GAS GENERATOR AS SHOWN ON CUT SHEET, KOHLER K800R WITH ALTERNATOR 470X 120/240V, 19 3W STANDBY, AUTOMATIC TRANSFER SWITCH, 600A 120/240V 19, NEMA4X, KOHLER KEP, PROVIDE LP GAS CONNECTION PIPE SIZED AS PER MANUFACTURER REQUIREMENTS.

ACCESSORIES: RESIDENTIAL GRADE SILENCER EXHAUST CAP, BATTERY, BATTERY RACK AND CABLES, FULL WEATHERPROOF ENCLOSURE, EQUALIZE/FLOAT TYPE CHARGER, HEAVY DUTY AIR CLEANER, OIL DRAIN KIT, AIR CLEANER RESTRICTION INDICATOR, SPRING ISOLATORS, 1% VOLTAGE REGULATION, DECISION MONITOR, OVER- VOLTAGE PROTECTION, PRE-HIGH ENGINE TEMPERATURE SENDER AND LAMP, PRE-OIL PRESSURE SENDER AND LAMP, AND LOW WATER LEVEL SENDER AND LAMP. THE COMPLETE INSTALLATION SHALL COMPLY WITH NFPA 37. CONTRACTOR TO INSTALL EXHAUST PIPE FOR A COMPLETE INSTALLATION. INSULATE ALL EXHAUST PIPING AND MUFFLER WITH 2" OF CALCIUM SILICATE.

ELECTRICAL RISER AND NOTES SCALE: NTS

SEAL

PREPARED BY: SY

CHECKED BY: NAC

REV	DATE	DESCRIPTION
0	6/3/24	SUBMIT FOR BLDG DEPT REVIEW
1	6/10/2024	OFF CHANGES

SCALE: AS SHOWN

JOB NO.: 22-PRO-0028

SHEET NO. REV

E-3

JOB # 22-1008

Amarilis Rodriguez, P.E.
License Number 60236
CA 2659

Signature _____

Date _____