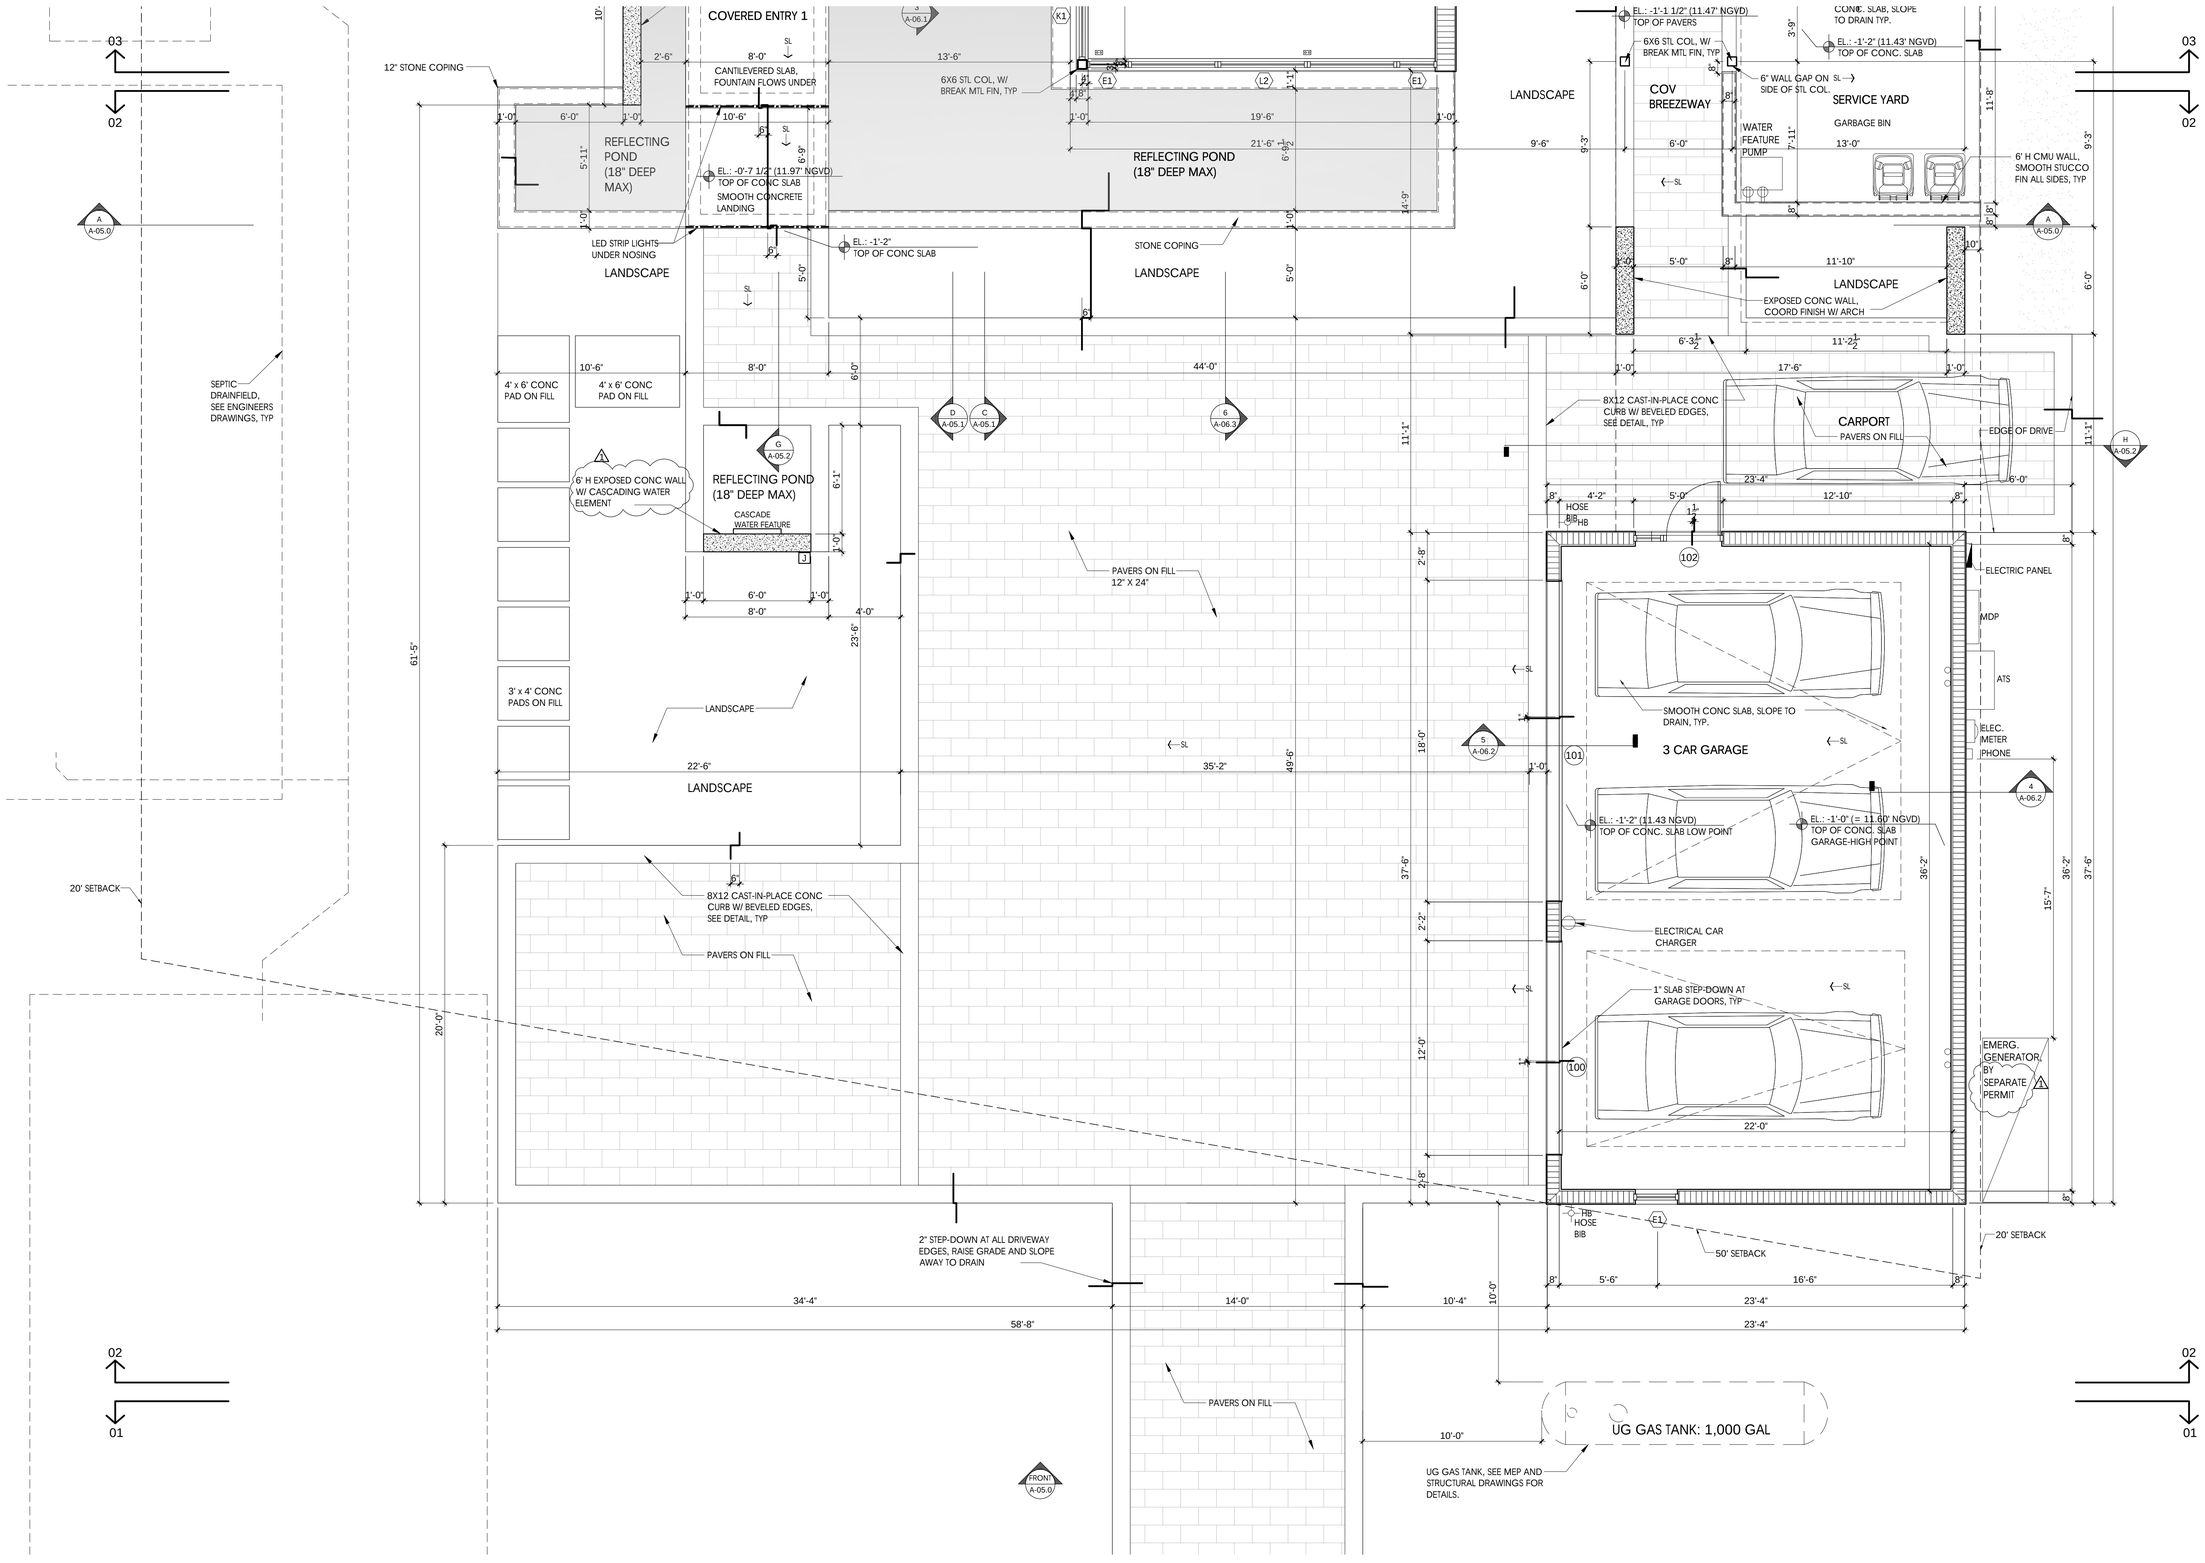

PARTIAL FIRST FLOOR PLAN: 02

SCALE: 1/4" = 1'-0"

NOTES

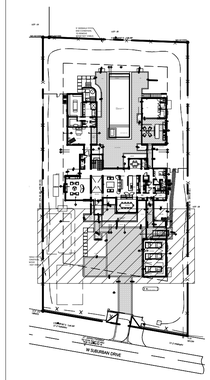

KEY PLAN

SCALE: 1/4" = 1'-0"

LOCUS ARCHITECTURE INCORPORATED
500 South Dixie Highway, Suite 307
Coral Gables, Florida 33146
Tel (305) 740-0120
Email locus@locusarchitecture.net
License AR 13937

CONSULTANT(S)

NO.	REVISION/SUBMISSION	DATE
	OWNER REVIEW	04-08-24
	PERMIT SUBMITTAL	06-07-24
1	REVIEW COMMENT	08-19-24

PROJECT

New 2-Story Residence:
6100 W Suburban Dr. Pinecrest, Fl 33156

DRAWING

Partial First Floor Plan: 02

SEAL

NELSON M DE LEON
STATE OF FLORIDA
Nelson de Leon
AR 13937
Digitally signed by NELSON M DE LEON
Date: 2024.09.24 11:37:12 -04'00'

SCALE	
DRAWN	
REVIEWED	NDL
PROJ. NO.	351

SHEET NO.

A-02.1