Tree Survey List – Exist. Trees to Remain

Num	Botanical / Commmon Name	Description DBH (ft)	HT (ft)	SPR (ft)	TPZ/CRZ 1" per 1" of DBH rad. from trunk	Condition	Notes	Disposition
#1A DR	Delonix regia / Royal Poinciana	2	40	60	12'	Good		Remain
#3 QV	Quercus virginiana / Live Oak	1.5	35	25	9'	Good		Remain
#4 QV	Quercus virginiana / Live Oak	1.8	50	30	10'	Good		Remain
#5 QV	Quercus virginiana / Live Oak	1.5	40	30	9'	Good		Remain
#8 QV	Quercus virginiana / Live Oak	2	60	40	12'	Good		Remain
#10 BS	Bursera simaruba / Gumbo Limbo	2	50	40	12'	Good		Remain
#13A BS	Bursera simaruba / Gumbo Limbo	2	40	40	12'	Good		Remain
#13B SC	Spathodea campanulata / African Tulip	1	50	30	6'	Good		Remain
#14 MI	Mangifera indica / Mango	1	30	30	N/A	Poor		Remain
#15 MI	Mangifera indica / Mango	3	45	30	N/A	Poor		Remain
#16 FA	Ficus aurea / Strangler Fig	5	60	40	30'	Good		Remain
#17 QV	Quercus virginiana / Live Oak	1.5	40	40	9'	Good		–Relocate–
#25 SC	Spathodea campanulata / African Tulip	0.7	40	10	4'	Good		Remain
#26 MZ	Manilkara zapota / Sapodilla	1	35	25	6'	Good		Remain

Plant List

QTY	KEY	Botanical / Commmon Name	Specification	Native	Category	Replacement Value
3	QV	Quercus virginiana / Live Oak	14' oa ht, 3" cal, 4' CT FG #1	Yes	*Street Trees*	
2	ED	Elaeocarpus decipiens / Japanese Blueberry	14' oa ht, 3" cal, 4' CT FG #1	No	*Street Trees*	
2	CO	Chrysophyllum oliviforme / Satinleaf	14' oa ht, 3" cal, 4' CT FG #1	Yes	*Req'd Trees*	
6	VM	Veitchia montgomeriana / Veitchia Palm	2 ea @ 14', 18',22' oa hts.	No	*Req'd Trees (Palms)*	
2	CD	Coccoloba diversifolia / Pigeon Plum	12' oa ht, 3" cal, 4' CT FG #1	Yes	*Req'd Trees*	
Req'd Shrubs:						
181	CLG	Clusia guttifera / Small Leaf Clusia	4–5' ht, 2' spr, 15 gal.	No		
15	POM	Podocarpus macrophyllus / Podocarpus	4' ht x 2' spr, 15 gal.	No		
12	POM1	Podocarpus macrophyllus / Podocarpus	7'–8' ht x 2.5' spr, 45 gal.	No		
25	MYF	Myrcianthes fragrans / Simpson Stopper	3–4' ht, 1.5' spr, 7 gal.	Yes		
49	MYF1	Myrcianthes fragrans / Simpson Stopper	5'–6' ht, 2.5' spr, 25 gal.	Yes		
20	PSN	Psychotria nervosa / Wild Coffee	2' ht, 1.5' spr, 3 gal.	Yes		
302 Prov'd Shrubs, 94 native						
Additional shrubs, accents, & groundcovers:						
1	PS	Phoenix sylvestris / Sylvester Date Palm	24' oa ht, 16' CT	No		
23	VM	Veitchia montgomeriana / Veitchia Palm	6 ea.@ 14',18',22',26' oa hts	No		
2	LL	Latania lontaroides / Red Latan Palm	8'–9' oa ht	No		
1	LJ	Ligustrum japonicum / Ligustrum	8'ht x 8' spr.	No		
3	TR	Thrinax radiata / Thatch Palm	8'–10' oa hts	Yes		
5	CHC	Chamaedorea cataractarum / Cat Palm	5' oa ht, 3' spr.	No		
3	RHE	Rhapis excelsa / Lady Palm	5' oa ht, 3' spr.	No		
3	ALZ	Alpinia zerumbet / Green Shell Ginger	3' oa ht, 2' spr.	No		
3	ALP	Alpinia purpurata / Red Ginger	3' oa ht, 2' spr.	No		
3	DIE	Dioone edule / Mexican Fern Palm	3' ht, 3' spr, 15 gal.	No		
1	PHG	Philodendron giganteum / Giganteum	3' ht, 7 gal.	No		
89	PRC	Philodendron Red Congo / Red Congo	24" ht, 24" spr, 7 gal.	No		
55	MOD	Monstera deliciosa / Monstera	24" ht, 24" spr, 7 gal.	No		
62	NEC	Neomarica caerulea / Giant Blue Apostles Iris	36" ht, 24" spr, 7 gal.	No		
102	PHB	Philodendron Burle Marx / Burle Marx	16" x 16" spr, 3 gal.	No		
58	DII	Dietes iiriodes / White African Iris	18" ht, 18" spr, 3 gal.	No		
15	SPP	Spathoglottis plicata / Purple Ground Orchids	16" x 16" spr, 3 gal.	No		
42	FAJ	Farfugium japonicum / Leopard Plant	18" ht, 18" spr, 3 gal.	No		
205	SEJ	Serrisa japonica / Cotoneaster	12" ht, 12" spr, 3 gal.	No		
465	LIM	Liriope muscarie, E.G. / Evergreen Giant Liriope	8" ht, 8" spr, 1 gal.	No		
375	ARG	Arachis glabrata / Perennial Peanut	8" spr, 1 gal.	No		

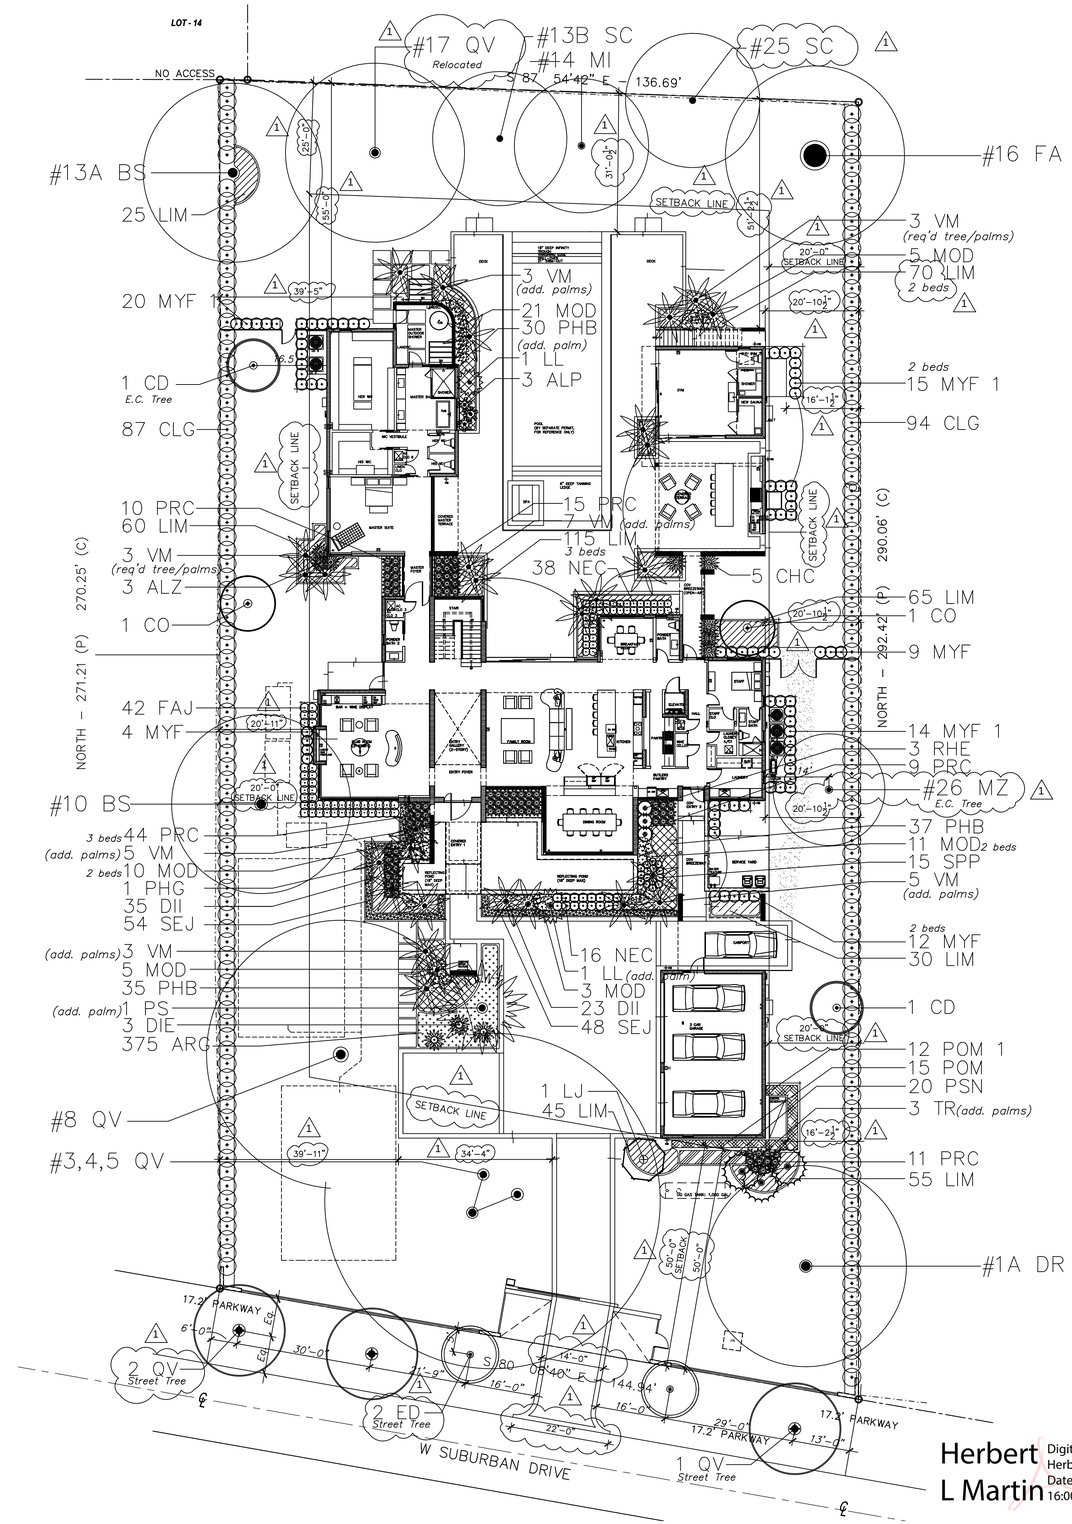

PROPOSED LANDSCAPE PLAN
SCALE:1/16"=1'-0"

NORTH

Herbert L Martin
Digitally signed by Herbert L Martin
Date: 2024.09.24 16:00:27 -04'00'

L-01.0 Landscape Plan
L-01.1 Notes, Details, Legend
L-01.2 Tree Survey /Disposition
L-01.3 Tree Protection Plan
IR-01.4 Irrigation Plan

NOTES

LOCUS ARCHITECTURE
INCORPORATED
500 South Dixie Highway, Suite 307
Coral Gables, Florida 33146
Tel (305) 740–0120
Email locus@locusarchitecture.net
License AR 13937

CONSULTANT(S)
H.L. Martin, Landscape Architect, P.A.
LC# 26000404 LA #0001722
5965 SW 38th Street, Miami, Florida 33155
305 790–4372, himartinufl@bellsouth.net
Herbert L. Martin, Landscape Architect

NO.	REVISION/SUBMISSION	DATE
	OWNER REVIEW	04–08–24
	PERMIT SUBMITTAL	06–07–24
1	Rev. Tree Survey & Review Comments	09.24.24

PROJECT
New 2–Story Residence:
6100 W Suburban Dr.
Pinecrest, Fl 33156

DRAWING
Landscape Plan

SEAL
Nelson de Leon
AR-13937

SCALE
DRAWN
REVIEWED NDL
PROJ. NO. 351

SHEET NO.
L–01.0