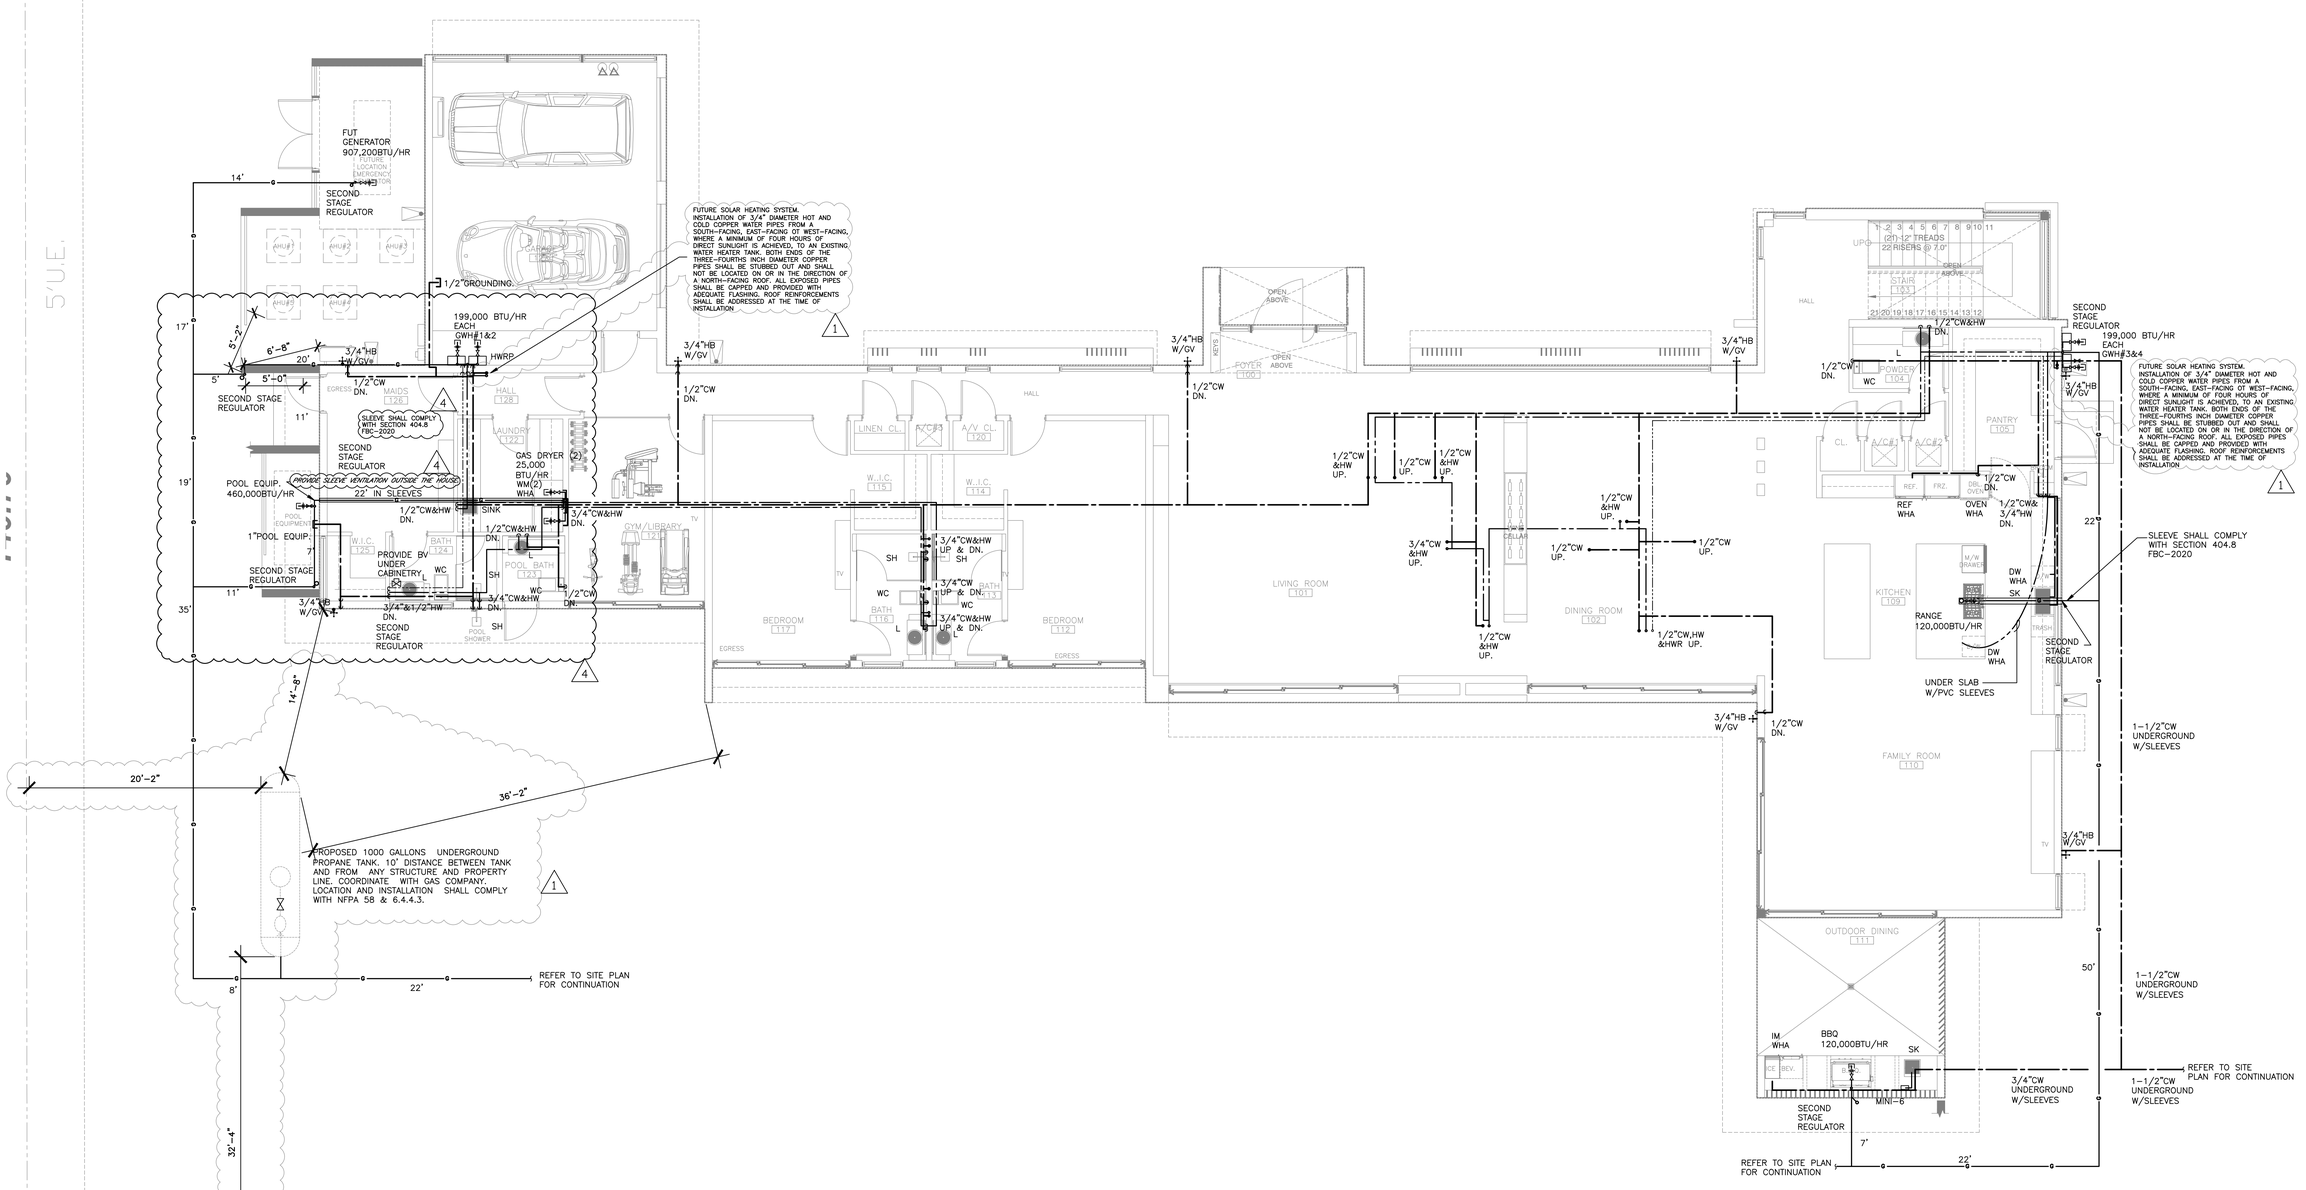



## WATER & GAS FIRST FLOOR PLAN

1 / P-101

SCALE: 3/16"=1'-0"


FAO ARCHITECTURE

407 LINCOLN ROAD
SUITE B-S
MIAMI BEACH, FLORIDA 33139
P 786.448.5630


PROJECT NO.
2308

CLIENT
RONALDO FL1, LLC
1200 BISCAYNE BLVD.
MIAMI , FLORIDA 33181

REVISIONS:
1 CITY COMMENTS 01-30-2024
2 AS BUILT COORD. 06-29-2026


CFS ENGINEERING GROUP, INC.
STRUCTURAL ENGINEER
185 NW 159TH STREET
MIAMI SHORES, FLORIDA 33168

ARPE ENGINEERING, LLC
MEP ENGINEERING
2020 PONCE DE LEON BLVD. SUITE 1002
CORAL GABLES, FLORIDA 33134

ALL LANDSCAPE DATA, INC
LANDSCAPE ARCHITECT
4450 NW 107THCOURT
DORAL, FLORIDA 33178

NEW LEAF ENVIRONMENTAL, LLC
ISA CERTIFIED ARBORIST
57 SILVER SPRINGS DRIVE
KEY LARGO, FLORIDA 33037

TERRA CIVIL ENGINEERING, LLC
CIVIL ENGINEERING
4011 WEST FLAGLER ST., SUITE 404
MIAMI, FLORIDA 33134


CASA OHAD
6200 SW 128RD TERRACE PINECREST, FLORIDA 33156

PROJECT DESCRIPTION:
SINGLE FAMILY RESIDENCE


FAO ARCHITECTURE LLC.
DRAWINGS, SPECIFICATIONS, AND OTHER DOCUMENTS, INCLUDING THOSE IN ELECTRONIC FORM, PREPARED BY FAO ARCHITECTURE LLC. AND THE CONSULTANTS ARE INSTRUMENTS OF SERVICE FOR USE SOLELY WITH RESPECT TO THIS PROJECT. THE ARCHITECT AND THE CONSULTANTS SHALL BE DEEMED THE AUTHORS AND OWNERS OF THEIR RESPECTIVE INSTRUMENTS OF SERVICE AND SHALL RETAIN ALL COMMON LAW, STATUTORY AND OTHER RESERVED RIGHTS, INCLUDING COPYRIGHTS.


SEAL:

FELIPE ALVARADO AR 91841

PHASE:
CONSTRUCTION DOCUMENTS

ISSUE DATE:
DECEMBER 12, 2023

SHEET TITLE:
PLUMBING FIRST FLOOR PLAN

SHEET:
P-101.1

This item has been digitally signed and sealed by Amarilis Rodriguez, P.E on the date adjacent to the seal. Printed copies of this document are not considered signed and sealed and the signature must be verified on any electronic copies.

JOB # 23-0822


arpe engineering inc
2020 Ponce de Leon Blvd., Suite 1002
Coral Gables, Florida 33134
Phone > 305 444 9809
Fax > 305 444 9827
Engineering Design:
> Mechanical > Electrical
> Plumbing > Fire Protection
www.arpe-eng.com
Amarilis Rodriguez, P.E.
License Number 60236
C.A. 26359


Signature _____

Date _____